

WR-W-4
4-66

State Office Building
ANNAPOLIS, MARYLAND 21401

STATE OF MARYLAND

DEPARTMENT OF
WATER RESOURCES

THIS REPORT
MUST BE SUBMITTED
WITHIN 30 DAYS
AFTER COMPLETION
OF THE WELL

George Elmer WELL COMPLETION REPORT **A09289**

WELL DESCRIPTION

Permit Number Ho67 W/260
Owner George Elmer
Address 2112 Parker Av,
Subdivision Beaufort, Park
Section _____ Lot 1

WELL LOG

State the kind of formations penetrated, their color, their depth, their thickness, and if water-bearing

CASING AND SCREEN RECORD

State the kind and size and position of casing, liner, shoe, screen, and other accessories (if no casing used, give diameter of well).

45 ft of dirt and sand
55 ft of gray rock

FEET
from _____ to _____

DIAM.
(inches)
6

FEET
from _____ to _____
45 ft

PUMPING TEST

Hours Pumped 4
Type of Pump Used sand
Pumping Rate 16
Gallons per Minute 25

WATER LEVEL

(Distance from land surface to water)

Before Pumping 35 ft Ft.
When Pumping 35 ft Ft.

APPEARANCE OF WATER

Clear Cloudy _____

Taste ok

Odor non

Height of Casing Above Land

Surface 3 ft Ft.

PUMP INSTALLED

Type non

Capacity _____


Gallons per Minute _____

Gallons per Hour _____

Pump Column Length _____ Ft.

LOCATION OF WELL ON LOT

Show permanent structures such as building(s), septic tank, and other landmarks and indicate not less than 2 distances (measurements) to well.

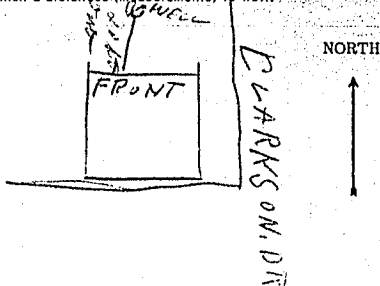

DATE
WELL WAS
COMPLETED

I hereby affirm that this report contains no willful misrepresentations or falsifications and that information given in this report is true, accurate and complete to the best of my knowledge and belief.

Mar 27 30, 1967

George Elmer, Well Driller

Well Driller License No.: 317