

PERMIT

SEWAGE DISPOSAL SYSTEM

DEPARTMENT OF HEALTH AND MENTAL HYGIENE

P 513369-A

A 513199-E

DISTRICT _____

DATE 4/04/2000

DATE SYSTEM APPROVED 10/05/2001

INSPECTOR _____

INDEXED

03-33191

HOWARD COUNTY HEALTH DEPARTMENT
BUREAU OF ENVIRONMENTAL HEALTH
461-9933

South Carroll Backhoe, Inc. IS PERMITTED TO INSTALL ALTER _____

ADDRESS 4410 Salem Bottom Road PHONE 410-875-4197

SUBDIVISION Brantwood 2/2 LOT 5 ROAD 3125 Argent Path

PROPERTY OWNER NVHomes

ADDRESS _____

NUMBER OF BEDROOMS: _____

- House is served by a shared community septic system. As part of the general permit for the community system, items previously installed or under construction include grinder pump installation, connection from grinder pump to common effluent line and house and shared disposal fields.

- This permit is limited to installation of the individual house sewer line and grinder pump installation only as per the signed building permit site plan. Copy Attached. *OK AW*

BUILDING PERMIT SIGNED

AND RETURNED 10-9-02

B00138811 - DECK W/STEPS

P 513369-A

PLANS APPROVED BY _____ DATE _____

1 of 5 Shared Connections 1 PM

ISSUE DATE:

4/4/2000

PERMIT

P 513369

APPROVAL DATE:

10/5/01

A 513199-E

ON-SITE SEWAGE DISPOSAL SYSTEM HOWARD COUNTY HEALTH DEPARTMENT BUREAU OF ENVIRONMENTAL HEALTH

INDEXED

South Carroll Backhoe, Inc IS PERMITTED TO INSTALL ALTER

ADDRESS: 4410 Salem Bottom Road PHONE NUMBER: 410-875-4197

SUBDIVISION: Brantwood 2/2 LOT NUMBER: 5

ADDRESS: 3125 Argent Path PROPERTY OWNER: NVHomes

~~SEPTIC TANK CAPACITY (GALLONS):~~ 1250

SHARED SEPTIC SYSTEM

~~PUMP CHAMBER CAPACITY (GALLONS):~~ N/A

~~NUMBER OF BEDROOMS:~~ 4

~~SQUARE FEET PER BEDROOM:~~ 180

~~LINEAR FEET OF TRENCH REQUIRED:~~ 240

TRENCHES:	Trench to be 3.0 feet wide. Inlet 3.0 feet below original grade. Bottom maximum depth 5.0 feet below original grade. Effective area begins at 3.0 feet below original grade. 2.0 feet of stone below distribution pipe.
LOCATION:	Sewer house connection should be made at the point shown on the approved building permit plan.
NOTES:	This house utilizes the shared septic system, first floor gravity service to the sewer main only. The Health Department should be notified at least 24 hours in advance for the sewer house connection, inspection and approval of same required for Interim Certificate of Potability issuance.

PLANS APPROVED: Amy Mc Millen 10/5/01 OK (BB) DATE: 4-28-01

- NOTE: PERMIT VOID AFTER 2 YEARS
- NOTE: CONTRACTOR RESPONSIBLE FOR SCHEDULING A PRE-CONSTRUCTION INSPECTION FOR ALL INSTALLATIONS
- NOTE: WATERTIGHT SEPTIC TANKS REQUIRED
- NOTE: ALL PARTS OF SEPTIC SYSTEM SHALL BE 100 FEET FROM ANY WATER WELL
- NOTE: MANHOLE RISERS REQUIRED ON ALL SEPTIC TANKS AND PUMP CHAMBERS


NEITHER THE HOWARD COUNTY COUNCIL NOR THE HEALTH DEPARTMENT IS RESPONSIBLE FOR THE SUCCESSFUL OPERATION OF ANY SYSTEM PERMITTEE RESPONSIBLE FOR OBTAINING FINAL APPROVAL ON THIS PERMIT CALL 410-313-2640 FOR INSPECTION OF SEPTIC SYSTEM

3125 ARGENT PATH

SHARED SEPTIC SYSTEM

NOT TO SCALE

H0-94-2992

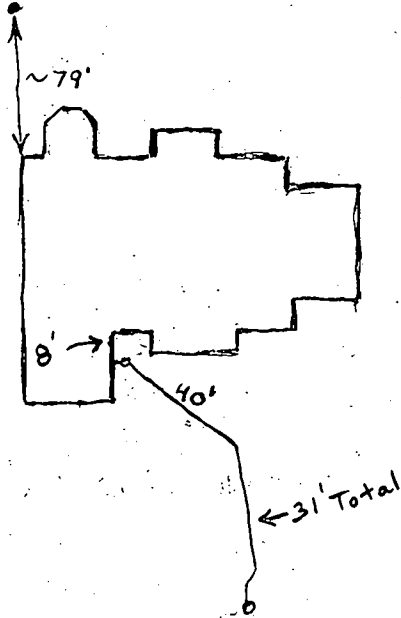

TRENCH DATA

TRENCH WIDTH _____
 TRENCH INLET DEPTH _____
 TRENCH BOTTOM DEPTH _____
 DEPTH OF STONE _____
 NUMBER OF TRENCHES _____
 TOTAL TRENCH LENGTH _____
 ABSORBENT AREA _____
 DISTRIBUTION BOX LEVEL _____
 BAFFLE IN DISTRIBUTION BOX _____

SEPTIC TANK DATA

SEPTIC TANK _____ GALLONS
 MANHOLE RISER _____
 6 INCH INSPECTION PORT _____

PUMP CHAMBER DATA

PUMP CHAMBER GALLONS _____
 MANHOLE RISER _____
 ALARM _____
 PUMP PERFORMANCE TEST _____


PRE-CONSTRUCTION INSPECTION: _____

INSPECTION COMMENTS: 10/5/01 WPI OK. Connection made to shared system. (BB)


INSPECTOR B. Baker DATE SYSTEM APPROVED 10/5/01

NOTE: This lot appears to lie in an area classified as Zone C, area of minimal flooding, as shown on FIRM MAP of Howard County, Maryland, Community Panel Numbers 2400440016B & 22B, Panels 16 & 22 of 45, dated December 4, 1985.

Wall Check: 7-16-01
Top of Wall Elev.: 490.5

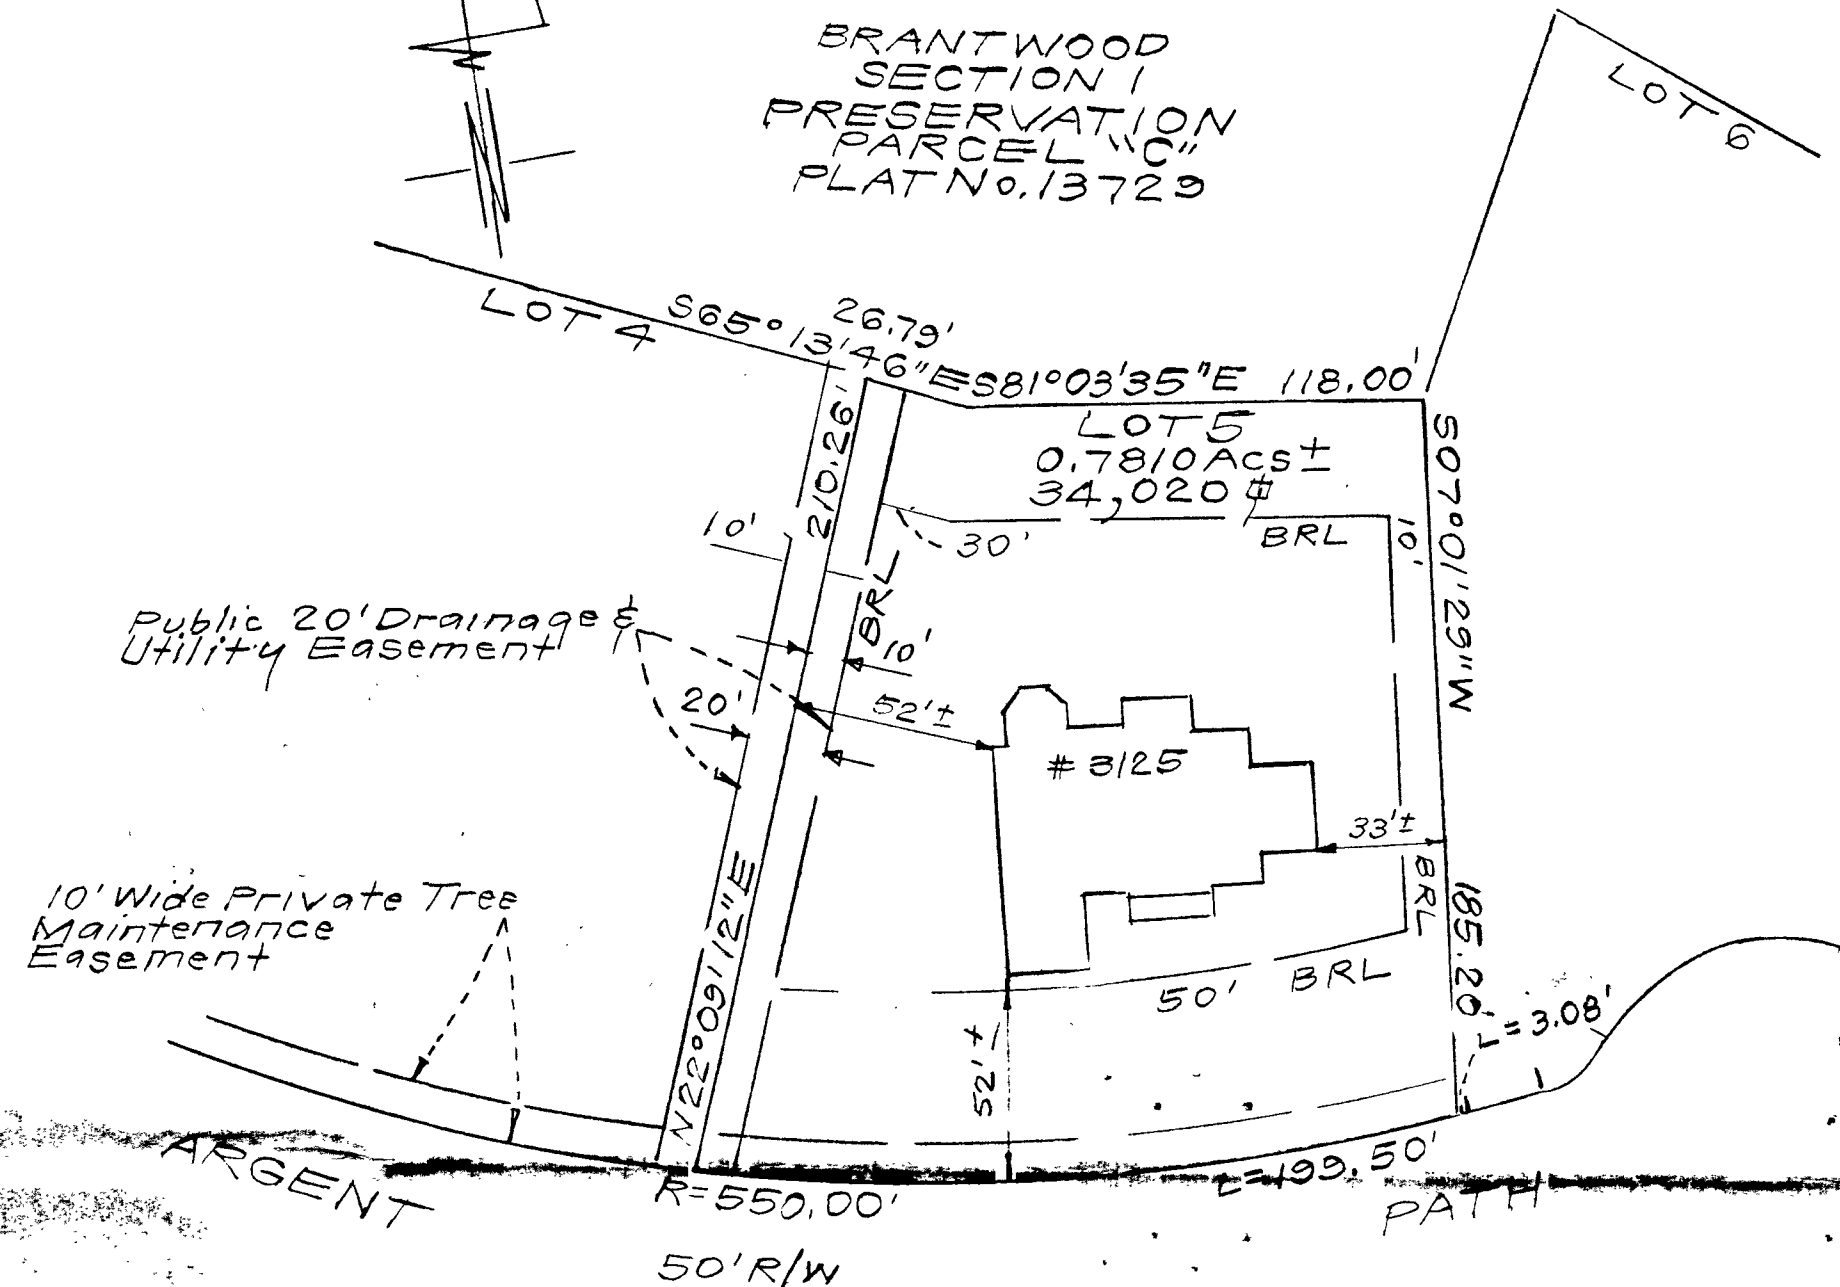

8/2/01 - Wall Check OK
SRW

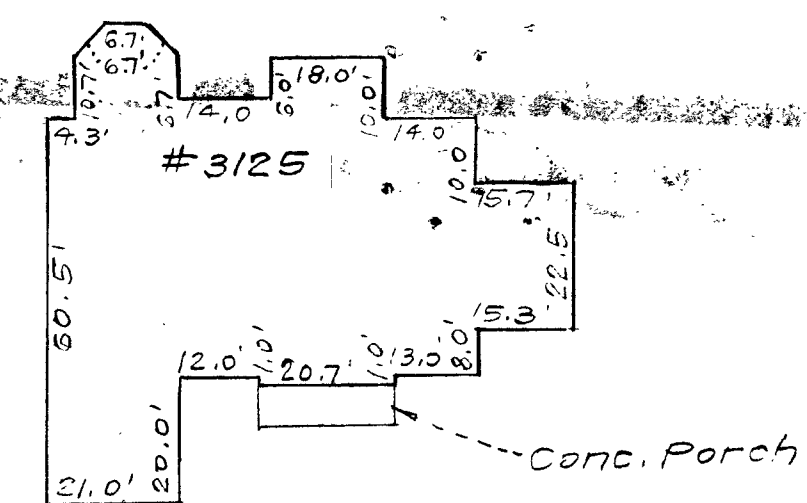

SCALE: 1" = 30'

CONSUMER INFORMATION

1. This plat is of benefit to the consumer only insofar as it is required by a lender of a title insurance company or its agent in connection with contemplated transfer, financing or refinancing purposes;
2. This plat is not to be relied upon for the establishment or location of fences, garages, buildings or other existing or future structures;
3. This plat does not provide for the accurate identification of property boundary lines, but such identification may not be required for the transfer of title or for securing financing or refinancing.

SURVEYOR'S CERTIFICATE

I hereby certify that a field survey of this property has been made under my supervision for the purpose of locating the improvements shown hereon, and they are located as shown.

7-17-01
DATE
[Signature]
STATE OF MARYLAND
PAUL ADOLPHUS SEE, JR.
REGISTERED
PROPERTY LINE SURVEYOR

- NOTES:
1. The ± setback distance accuracy = 1'.

Plat Reference: PLAT NUMBER 14181

		CLARK • FINEFROCK & SACKETT, INC. ENGINEERS • PLANNERS • SURVEYORS 7135 MINSTREL WAY • COLUMBIA, MD 21045 • (410) 381-7500 BALT. • (301) 621-8100 WASH.	
		DESIGNED DRAWN CHECKED DATE	LOCATION DRAWING 3125 ARGENT PATH LOTS BRANTWOOD SECTION TWO AREA TWO LOTS 1 THRU 16 AND PRESERVATION PARCEL 'G' A RESUBDIVISION OF PART OF "BRANTWOOD-SECTION ONE NON-BUILDABLE BULK PARCEL 'E'" THIRD ELECTION DISTRICT HOWARD COUNTY, MARYLAND
7-17-01	PAS	KWC	7-17-01