

PRELIMINARY

# APPLICATION

A 26477

P \_\_\_\_\_

7/25/77  
2:00 p.m.

SEWAGE DISPOSAL TESTING

STATE OF MARYLAND - DEPARTMENT OF HEALTH AND MENTAL HYGIENE

DISTRICT 5th

HOWARD COUNTY HEALTH DEPARTMENT  
ENVIRONMENTAL HEALTH SERVICES

DATE 7/22/77

P. O. BOX 476, ELLICOTT CITY, MARYLAND 21043  
TELEPHONE: 465-5000, EXT. 356

*Frederick Glassberg*  
*10908 Battusa Lane*  
*Col., Md. 21044*

TO: THE COUNTY HEALTH OFFICER  
ELLICOTT CITY, MARYLAND

I, HEREBY, APPLY FOR THE NECESSARY TEST IN ORDER TO CONSTRUCT (OR RECONSTRUCT) A SEWAGE DISPOSAL SYSTEM.

PROPERTY OWNER Leonard J. Vetick

Any questions call Dennis Rush:

ADDRESS 11733 Clarksville Pike, Clarksville, Md. 21029

PHONE 465-7777

PROPERTY LOCATION:

*Vetick 5315096*

SUBDIVISION \_\_\_\_\_

LOT NO. ? 3

ROAD AND DESCRIPTION Route 108

SIZE OF LOT ?

TYPE BLDG. 3 or 4 bedrooms

NUMBER OF BEDROOMS

IF NOT SINGLE RESIDENCE DESCRIBE \_\_\_\_\_

THE SYSTEM INSTALLED UNDER THIS APPLICATION IS ACCEPTABLE ONLY UNTIL PUBLIC FACILITIES BECOME AVAILABLE.

SIGNATURE OF APPLICANT /s/ Dennis Rush

APPROVED BY DJO

FOR \_\_\_\_\_

DATE \_\_\_\_\_

(KIND OF SYSTEM)

REJECTED BY \_\_\_\_\_

FOR \_\_\_\_\_

DATE \_\_\_\_\_

(KIND OF SYSTEM)

HOLD PENDING FURTHER TESTS

DJO

DATE 7/29/77


REASONS FOR REJECTION OR HOLDING Hold for Plat.

BLDG. PERMIT SIGNED

AND RETURNED 4/25/78

serial # 35399

# THIS IS NOT A PERMIT

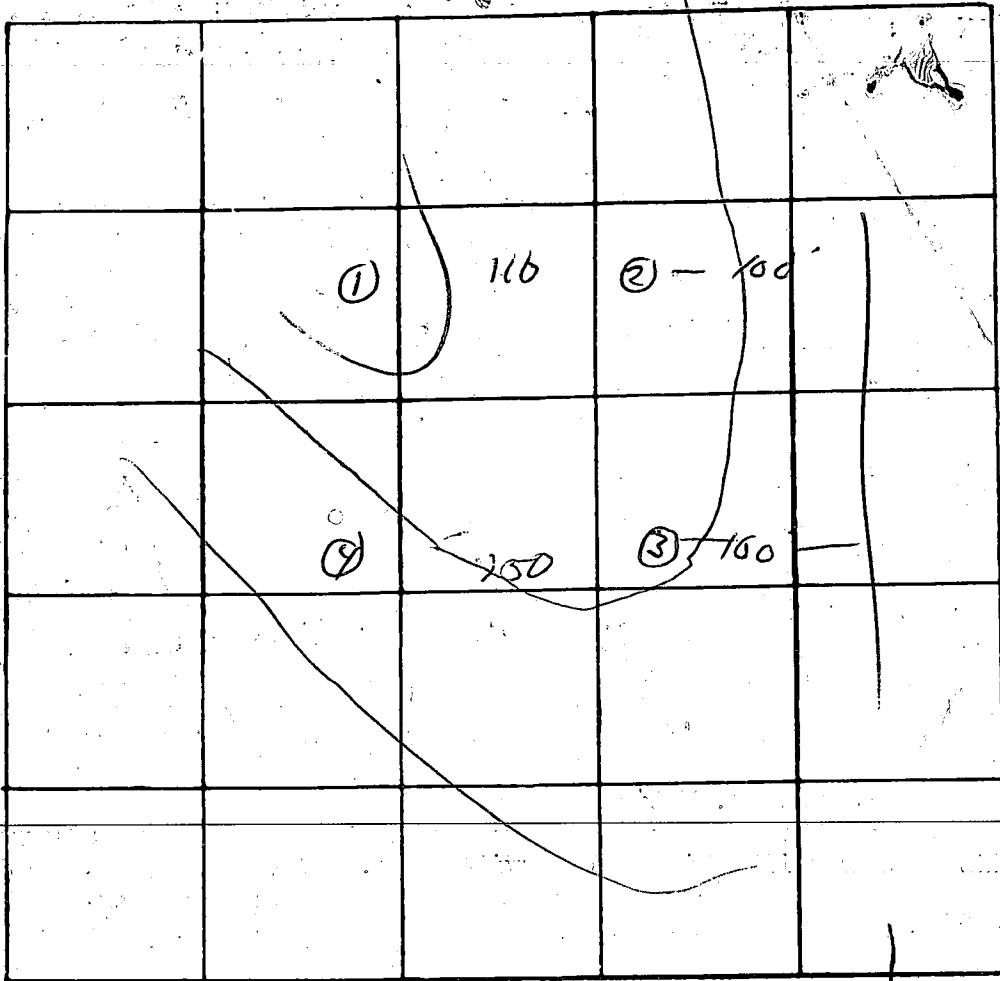

INDICATE NORTH. - NAME ADJOINING ROADWAY AS BASE LINE

VROW

9/25/47

DATE	TEST NO.	DEPTH	PRE-WET		TEST - 1" DROP		TIME
			START	STOP	START	STOP	
4/5		2 1/2	2:15	<del>2:11</del>		2:19	3
d		1 1/2	2:15	2:29	2:19	2:26	7
3/5	3'S	3'	2:18	2:23	2:25	2:28	5
4	12' d	12'	2:18	2:20	2:20	2:39	<del>5</del> 13
1/5	15	4'	2:25	2:30	2:30	2:35	5
9	19	17'	2:40	2:43	2:45	2:49	4
	2. vis vol.	04 3-18'					

REMARKS \_\_\_\_\_

TYPE OF SOIL \_\_\_\_\_

TESTED BY RFJ

ALSO PRESENT: Vet. Fred Rusk