

9/27/83
P.M.

Approved
9-27-83

PERMIT

P 33155

SEWAGE DISPOSAL SYSTEM

A REPAIR

MARYLAND STATE DEPARTMENT OF HEALTH*

HOWARD COUNTY
BUREAU OF ENVIRONMENTAL HEALTH
992-2330

02-249764

ELLICOTT CITY

DISTRICT _____

INDEX

DATE 9/23/83

Jack Fyock, Jr.

IS PERMITTED TO INSTALL _____ ALTER X

ADDRESS 13775 Triadelphia Road, Glenelg, MD 21737 PHONE 988-9270

SUBDIVISION _____ ROAD 4350 Columbia Pike LOT _____

PROPERTY OWNER Mr. Bauer

ADDRESS 4350 Columbia Pike, Clarksville, MD Phone: 465-0160

IF GARBAGE GRINDER IS USED INCREASE SEPTIC TANK CAPACITY BY 50% AND ABSORPTION AREA BY 22%.

GARBAGE GRINDER? YES _____ NO _____

SEPTIC TANK CAPACITY _____ GALLONS NUMBER OF BEDROOMS _____

REPAIR - CALL FOR INSPECTION WHEN GROUND IS OPENED UP SO SANITARIAN CAN RECOMMEND REPAIR.

INSTALL LEACHING BED 86' x 7' INLET AT 3' 1 1/2 FT GRAVEL

602 SQ FT ABS. AREA

9-27-83 C. Williams

PLANS APPROVED BY Frank Skinner DATE September 23, 1983

COVER NO WORK UNTIL INSPECTED AND APPROVED.

NEITHER THE HOWARD COUNTY COUNCIL NOR THE HEALTH DEPARTMENT IS RESPONSIBLE FOR THE SUCCESSFUL OPERATION OF ANY SYSTEM.

NOTE: IF TRENCH IS USED CALL FOR INSPECTION BEFORE AND AFTER PLACING GRAVEL IN TRENCH.

NOTE: NO DRY WELL SHALL EXCEED 15 FOOT IN DIAMETER. NO ABSORPTION TRENCH TO EXCEED 100 FEET IN LENGTH.

NOTE: ALL PIPE FROM HOUSE TO SEPTIC TANK MUST BE CAST IRON OR SCHEDULE 40 PVC OR ABS.

PERMIT VOID AFTER THREE YEARS.


NOTE: INSTALL STAND PIPE ON SEPTIC TANK AND DRY WELL. STAND PIPES MUST BE 6 INCHES IN DIAMETER. CAST IRON, CONCRETE OR TERRA COTTA, OR PVC OR ABS ACCEPTED. IF TOP OF SEPTIC TANK IS DEEPER THAN 3 FEET MANHOLE TO GRADE REQUIRED.

***INSTALLER IS RESPONSIBLE FOR OBTAINING FINAL APROVAL ON THIS PERMIT**

*CALL 992-2330 FOR INSPECTION OF SEPTIC SYSTEMS.

EH - 2-1082

P 33155

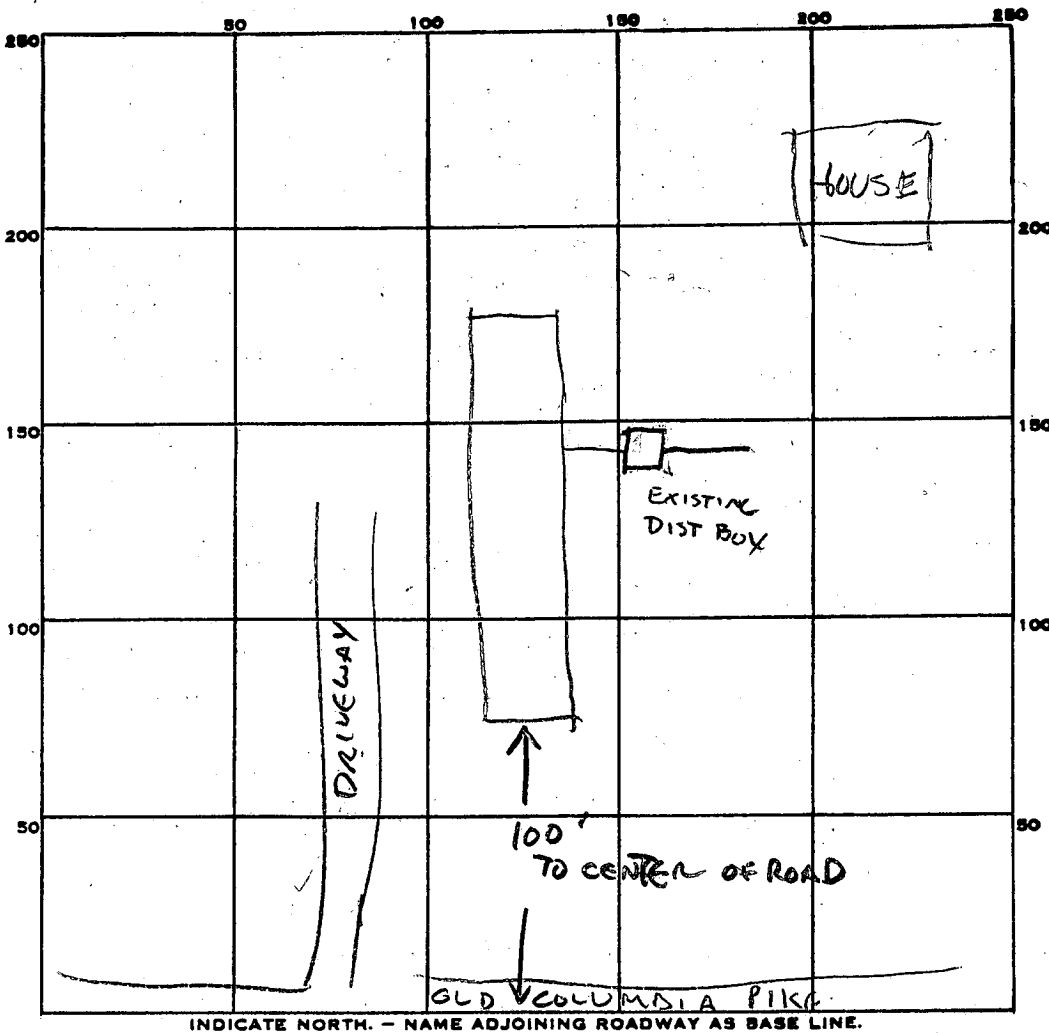

PERMIT CARD

SEPTIC TANK, LEVEL EXISTING

CLEANOUTS _____

DISTRIBUTION BOX, LEVEL EXISTING

TILE FIELD, DEPTH _____ FT. TRENCH WIDTH _____ FT.

GRAVEL DEPTH N/A IN. TOTAL LENGTH _____ FT.

NUMBER OF TRENCHES _____ TOTAL BOTTOM AREA _____

LEACHING BED
SEEPAGE PITS, INSIDE DIAMETER 86 X 7 FT. DEPTH BELOW INLET 3 FT.

ABSORBENT AREA 602 SQ. FT.

4
86
7
602

REMARKS

LEACHING BED INLET AT 3' 86 X 7 = 602 SQ FT

GROUND IS HARD SAND.

DATE SYSTEM APPROVED 9-27-83

INSPECTOR C. Williams

4/20/65

PERMIT

P 10034

SEWAGE DISPOSAL SYSTEM

A 10028

MARYLAND STATE DEPARTMENT OF HEALTH

HOWARD COUNTY

INDEXED

ELLICOTT CITY

DISTRICT 2

DATE 4/20/65

Roland Barth IS PERMITTED TO INSTALL X ALTER

ADDRESS Ellicott City, Maryland PHONE HO 5-3495

A SEWAGE DISPOSAL-SYSTEM LOCATED AT _____

SUBDIVISION _____ ROAD 432 Old Columbia Rd. LOT _____

PROPERTY OWNER Leonard Vitick

ADDRESS _____

SPECIFICATIONS -

DRAIN FIELD _____ DEPTH _____ FEET, BOTTOM AREA _____ SQ. FT.

SEEPAGE PITS _____ ABSORBENT SIDE-WALL AREA _____ SQ. FT.

SEPTIC TANK CAPACITY _____ GALLONS

REPAIR

FOR GARBAGE GRINDER, INCREASE DISPOSAL AREA 22% & TANK CAPACITY 50%.


OTHER Tile field with 300 sq. ft. of bottom area in front of house in area
tested. Keep trenches at least 10 ft. from all trees.

PLANS APPROVED BY J. Hennigan DATE 4/20/65

FILL SEPTIC TANK AND DISTRIBUTION BOX WITH WATER BEFORE CALLING FOR AN INSPECTION. COVER NO WORK UNTIL INSPECTED AND APPROVED.

NEITHER THE HOWARD COUNTY COMMISSIONERS NOR THE HEALTH DEPARTMENT IS RESPONSIBLE FOR THE SUCCESSFUL OPERATION OF ANY SYSTEM.

A 10028

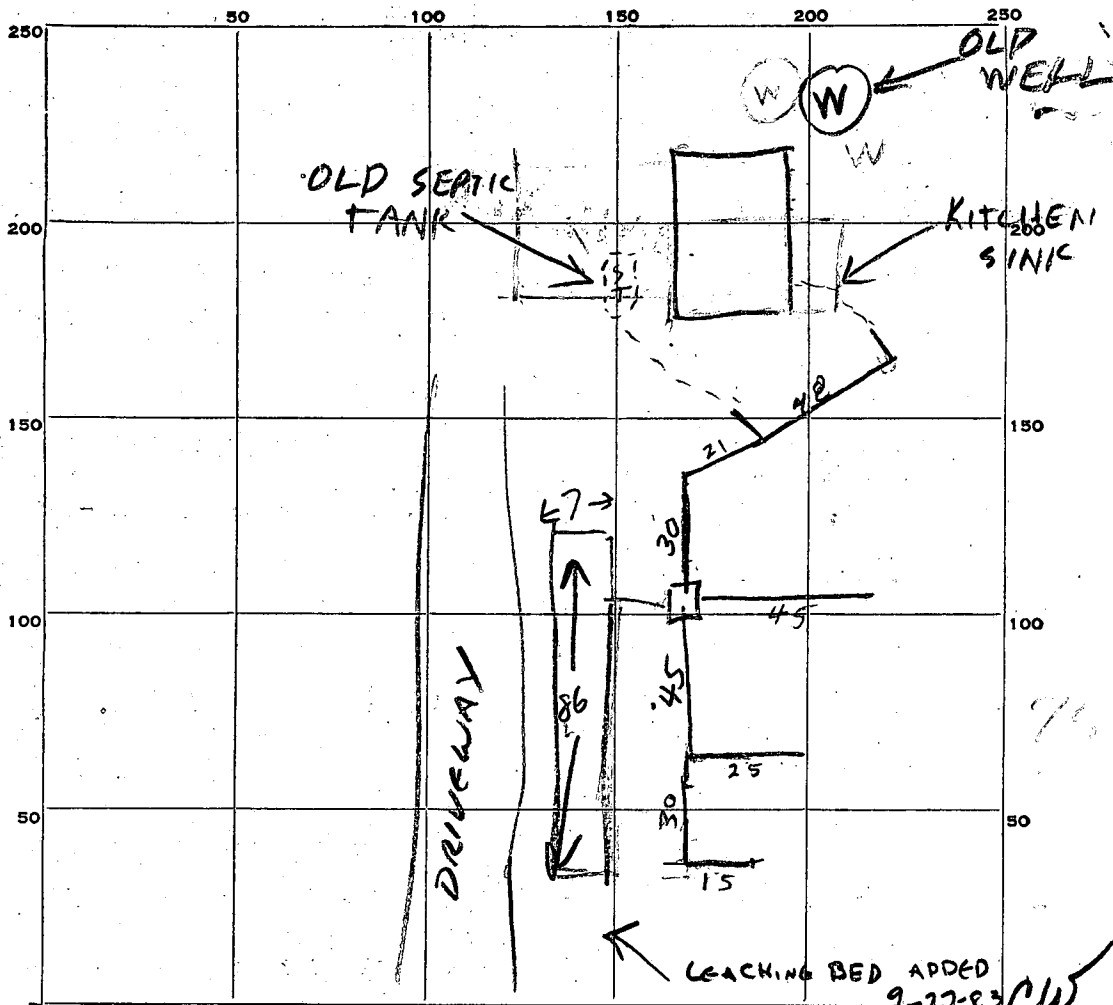

INDICATE NORTH. - NAME ADJOINING ROADWAY AS BASE LINE.

LEACHING BED ADDED
 9-27-83 CW
 600 SQ FT
 ADDITIONAL
 AREA

15
 25
 30
 45
 45
 160
 2.5
 800
 320
 400

45
 032
 2/25
 17/3

PERMIT CARD _____

SEPTIC TANK, LEVEL _____

CLEANOUTS _____

DISTRIBUTION BOX, LEVEL _____

TILE FIELD, DEPTH 3 FT. TRENCH WIDTH 2 1/2 FT.

GRAVEL DEPTH 12 IN. TOTAL LENGTH 160 FT.

NUMBER OF TRENCHES _____ TOTAL BOTTOM AREA 400

SEEPAGE PITS, INSIDE DIAMETER _____ FT. DEPTH BELOW INLET _____ FT.

ABSORBENT AREA _____ SQ. FT.

REMARKS _____

DATE SYSTEM APPROVED

4/22/65

INSPECTOR

Raymond Hodges

REPAIR

APPLICATION

A 10028

SEWAGE DISPOSAL TESTING

P _____

MARYLAND STATE DEPARTMENT OF HEALTH

HOWARD COUNTY

ELLICOTT CITY

DISTRICT 2

DATE 4/20/65

*Tile field with 300 sq. FT. of bottoms
area in front of house in area tested.
Keep trenches at least 10 ft. from all trees.*

TO: THE COUNTY HEALTH OFFICER
ELLICOTT CITY, MARYLAND

I, HEREBY, APPLY FOR THE NECESSARY TESTS IN ORDER TO CONSTRUCT (OR RECONSTRUCT) A SEWAGE DISPOSAL SYSTEM.

PROPERTY OWNER Leonard Vitick *(Ramsberg Property)*

ADDRESS 432 Old Columbia Rd., E. C. PHONE HO 5-2783

PROPERTY LOCATION:

SUBDIVISION _____ LOT NO. _____

ROAD AND DESCRIPTION 432 Old Columbia Rd.

OCCUPANT _____ PHONE _____

PERSON TO CONSTRUCT SYSTEM _____

ADDRESS _____ PHONE _____

SIZE OF LOT _____ TYPE BLDG. ? residence
NUMBER OF BEDROOMS

IF NOT SINGLE RESIDENCE DESCRIBE _____

SIGNATURE OF APPLICANT _____


APPROVED BY *J. Hennigan* FOR Tile field DATE 4-20-65
(KIND OF SYSTEM)

REJECTED BY _____ FOR _____ DATE _____
(KIND OF SYSTEM)

HOLD PENDING FURTHER TESTS _____ DATE _____

REASONS FOR REJECTION OR HOLDING _____

THIS IS NOT A PERMIT

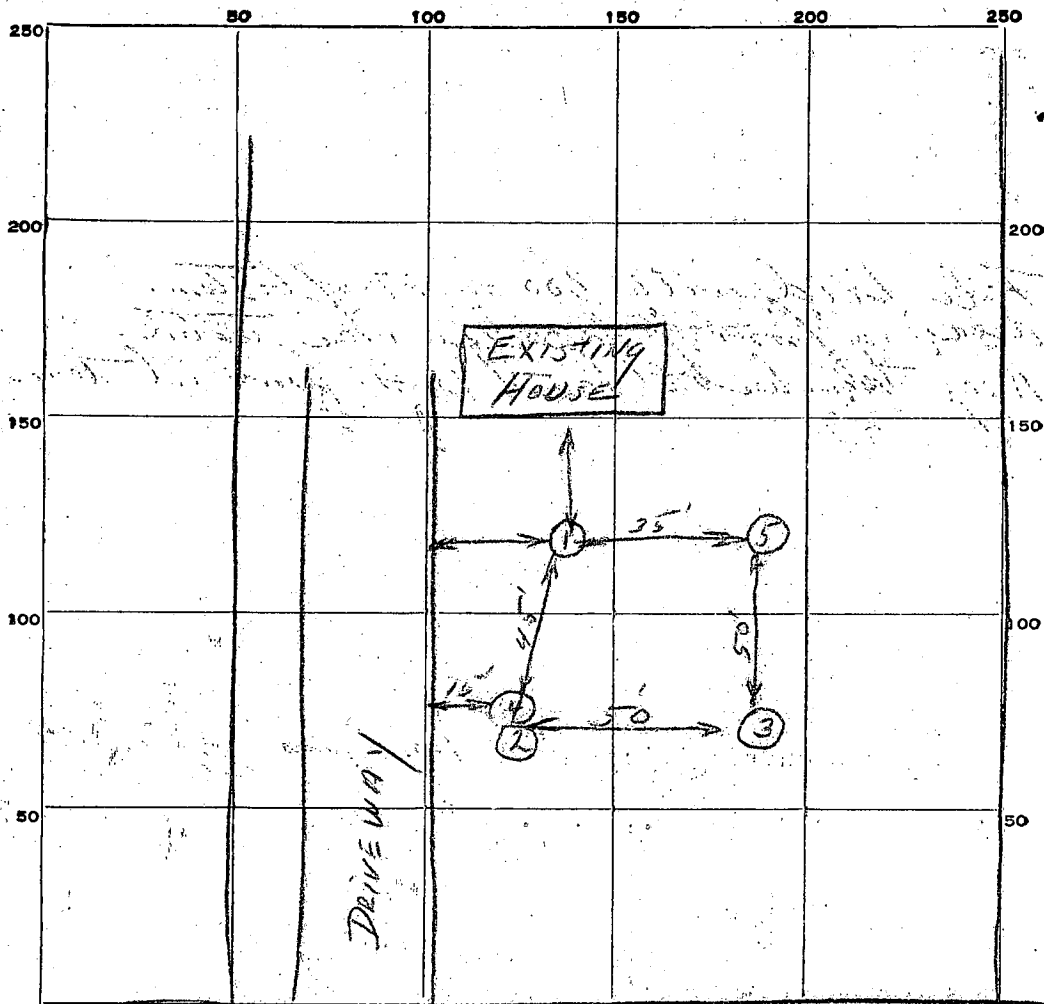

INDICATE NORTH. - NAME ADJOINING ROADWAY AS BASE LINE.

old Columbia Road.

DATE	TEST NO.	DEPTH	PRE-WET		TEST - 1" DROP		TIME
			START	STOP	START	STOP	
4-20-65	1	9'	1:19	1:36	slow - 1/2"	water came in bottom	
	2	3'	1:39	1:44	1:44	1:51	7 min
	3	4'	1:54	2:00	2:00	2:10	10 min
	4	8'	2:18	2:32	2:32	2:50	18 min
	5	3'	2:15	2:16	2:16	2:19	3 min

SOIL AUGER FINDING

TESTED BY *JH*

REMARKS

4-20-65

ALSO PRESENT

W. Lee Rumburg

LOT NO.

REPAIR

APPLICATION

A 10028

SEWAGE DISPOSAL TESTING

P _____

MARYLAND STATE DEPARTMENT OF HEALTH

HOWARD COUNTY

ELLICOTT CITY

DISTRICT 2

DATE 4/20/65

Tile field with 300 sq. FT. of bottom area in front of house in area tested. Keep trench at least 10 ft. from all trees.

TO: THE COUNTY HEALTH OFFICER
ELLICOTT CITY, MARYLAND

I, HEREBY, APPLY FOR THE NECESSARY TESTS IN ORDER TO CONSTRUCT (OR RECONSTRUCT) A SEWAGE DISPOSAL SYSTEM.

PROPERTY OWNER Leonard Vitick

ADDRESS 432 Old Columbia Rd., E. C. PHONE HO 5-2783

PROPERTY LOCATION:

SUBDIVISION _____ LOT NO. _____

ROAD AND DESCRIPTION 432 Old Columbia Rd.

OCCUPANT _____ PHONE _____

PERSON TO CONSTRUCT SYSTEM _____

ADDRESS _____ PHONE _____

SIZE OF LOT _____ TYPE BLDG. ? NUMBER OF BEDROOMS _____

IF NOT SINGLE RESIDENCE DESCRIBE _____

SIGNATURE OF APPLICANT _____


APPROVED BY J. Herwig FOR Tile field DATE 4-20-65
(KIND OF SYSTEM)

REJECTED BY _____ FOR _____ DATE _____
(KIND OF SYSTEM)

HOLD PENDING FURTHER TESTS _____ DATE _____

REASONS FOR REJECTION OR HOLDING _____

THIS IS NOT A PERMIT

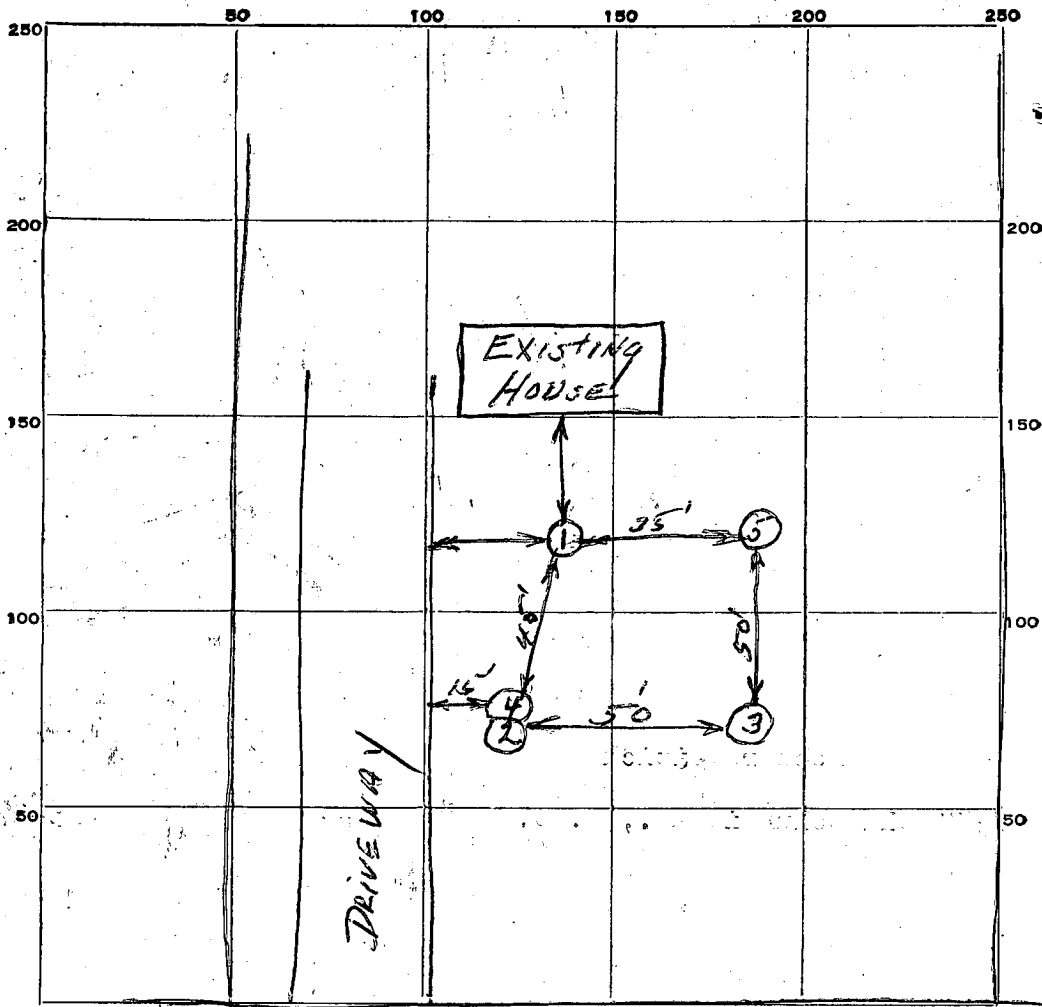

INDICATE NORTH. - NAME ADJOINING ROADWAY AS BASE LINE.

old Columbia Road.

DATE	TEST NO.	DEPTH	PRE-WET		TEST - 1" DROP		TIME
			START	STOP	START	STOP	
4-20-65	1	9'	1:19	1:36	Slow - 1/2"	water came in bottom	
	2	3'	1:39	1:44	1:44	1:51	7 min.
	3	4'	1:54	2:00	2:00	2:10	10 min.
	4	8'	2:18	2:32	2:32	2:50	18 min.
	5	3'	2:15	2:16	2:16	2:19	3 min.

SOIL AUGER FINDING _____

TESTED BY *JH*

REMARKS

4-20-65

ALSO PRESENT

W. Lee Paul Lewis

LOT NO. _____