

11/3/83  
~~11/3/83~~  
as soon as possible

approved  
11-3-83  
C. Walker

# PERMIT

P 33279

SEWAGE DISPOSAL SYSTEM

A Repair

MARYLAND STATE DEPARTMENT OF HEALTH

HOWARD COUNTY  
BUREAU OF ENVIRONMENTAL HEALTH  
992-2330

05-349230

ELLICOTT CITY  
DISTRICT 5a

**INDEX**

DATE Nov. 2, 1983

Jack Eyoock, Jr. IS PERMITTED TO INSTALL \_\_\_\_\_ ALTER X

ADDRESS 13775 Triadelphia Road, Glenelg, MD 21737 PHONE 988-9270

SUBDIVISION \_\_\_\_\_ ROAD 10834 Braeburn Road LOT 21

PROPERTY OWNER Mr. Fisele

ADDRESS 10834 Braeburn Road, Columbia, MD Phone: 531-5495

IF GARBAGE GRINDER IS USED INCREASE SEPTIC TANK CAPACITY BY 50% AND ABSORPTION AREA BY 22%.

GARBAGE GRINDER? YES \_\_\_\_\_ NO \_\_\_\_\_

SEPTIC TANK CAPACITY \_\_\_\_\_ GALLONS NUMBER OF BEDROOMS \_\_\_\_\_

REPAIR - CALL FOR INSPECTION WHEN GROUND IS OPENED UP SO SANITARIAN CAN RECOMMEND REPAIR.

SOIL SAND LOAM - WATER AT 12'  
INSTALL LEACHING BED 7' X 60' = 420 SQ FT, 11-3-83 C. Walker

PLANS APPROVED BY Frank Skinner DATE November 2, 1983

COVER NO WORK UNTIL INSPECTED AND APPROVED.

NEITHER THE HOWARD COUNTY COUNCIL NOR THE HEALTH DEPARTMENT IS RESPONSIBLE FOR THE SUCCESSFUL OPERATION OF ANY SYSTEM.

NOTE: IF TRENCH IS USED CALL FOR INSPECTION BEFORE AND AFTER PLACING GRAVEL IN TRENCH.

NOTE: NO DRY WELL SHALL EXCEED 15 FOOT IN DIAMETER. NO ABSORPTION TRENCH TO EXCEED 100 FEET IN LENGTH.

NOTE: ALL PIPE FROM HOUSE TO SEPTIC TANK MUST BE CAST IRON OR SCHEDULE 40 PVC OR ABS.

PERMIT VOID AFTER THREE YEARS.


NOTE: INSTALL STAND PIPE ON SEPTIC TANK AND DRY WELL. STAND PIPES MUST BE 6 INCHES IN DIAMETER. CAST IRON, CONCRETE OR TERRA COTTA, OR PVC OR ABS ACCEPTED. IF TOP OF SEPTIC TANK IS DEEPER THAN 3 FEET MANHOLE TO GRADE REQUIRED.

**\*INSTALLER IS RESPONSIBLE FOR OBTAINING FINAL APROVAL ON THIS PERMIT**

\*CALL 992-2330 FOR INSPECTION OF SEPTIC SYSTEMS.

EH - 2-1082

X 33279

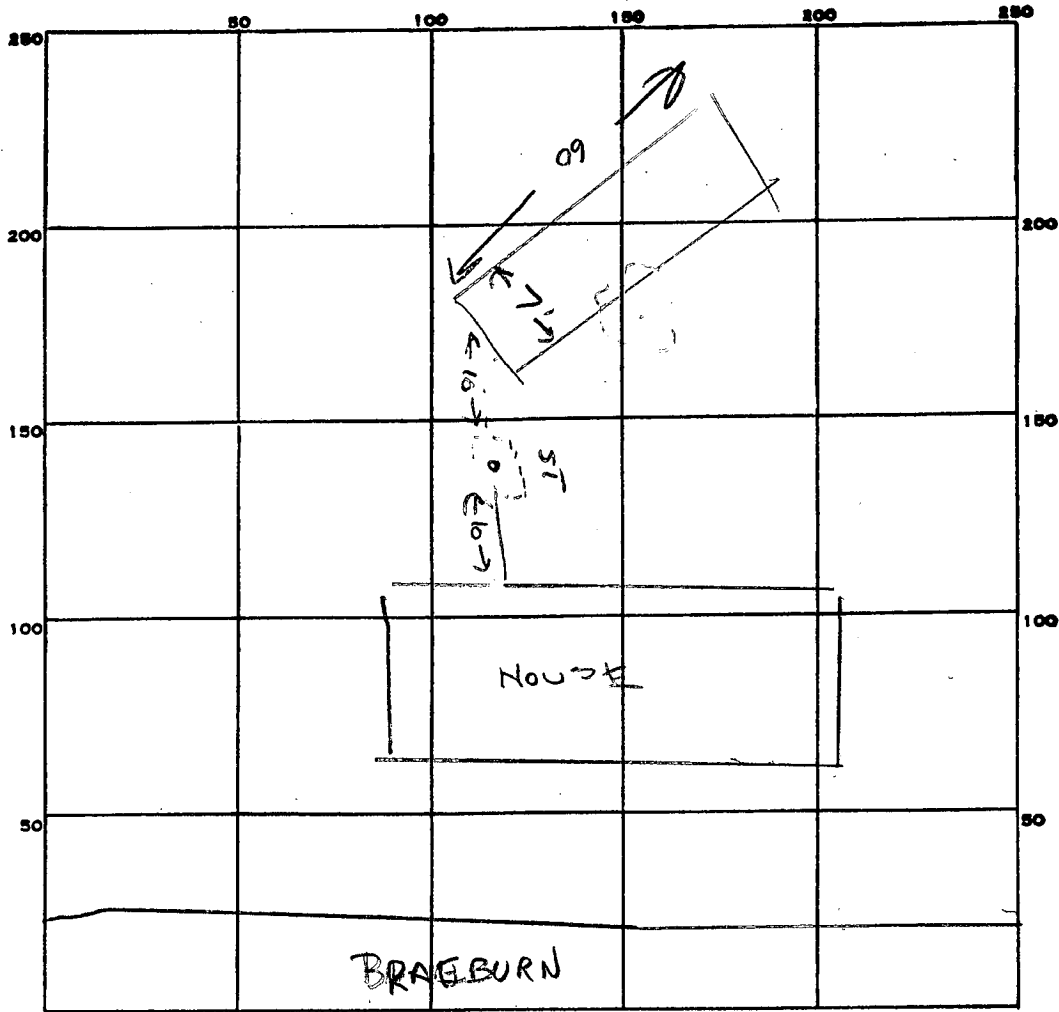

PERMIT CARD \_\_\_\_\_

SEPTIC TANK, LEVEL EXISTING

CLEANOUTS EXISTING

DISTRIBUTION BOX, LEVEL \_\_\_\_\_

TILE FIELD, DEPTH 4 FT. TRENCH WIDTH 7 FT.

GRAVEL DEPTH 18 IN. TOTAL LENGTH 60 FT.

NUMBER OF TRENCHES 1 TOTAL BOTTOM AREA 720 SQ FT

SEEPAGE PITS, INSIDE DIAMETER \_\_\_\_\_ FT. DEPTH BELOW INLET \_\_\_\_\_ FT.

ABSORBENT AREA 420 SQ. FT.

REMARKS \_\_\_\_\_

\_\_\_\_\_  
 \_\_\_\_\_  
 \_\_\_\_\_  
 \_\_\_\_\_

DATE SYSTEM APPROVED 11-3-83

INSPECTOR C. Williams

8/13/63  
8/16/63  
in compliance

# PERMIT

approved  
8/19/63  
JDM

P. # 07213  
06437  
A. 06437  
~~06437~~

SEWAGE DISPOSAL SYSTEM

MARYLAND STATE DEPARTMENT OF HEALTH

HOWARD COUNTY

ELLICOTT CITY

DISTRICT 5

DATE 7/29/63

**INDEXED**

**INDEXED**

Elwood Scaggs IS PERMITTED TO  INSTALL  ALTER

ADDRESS \_\_\_\_\_ PHONE \_\_\_\_\_

A SEWAGE DISPOSAL SYSTEM LOCATED AT \_\_\_\_\_

SUBDIVISION Braeburn ROAD Cedar Lane LOT 21

PROPERTY OWNER A. H. Young

ADDRESS \_\_\_\_\_

**SPECIFICATIONS**

DRAIN FIELD  DEPTH \_\_\_\_\_ FEET, BOTTOM AREA 800 SQ. FT.

SEEPAGE PITS \_\_\_\_\_ ABSORBENT SIDE-WALL AREA \_\_\_\_\_ SQ. FT.

SEPTIC TANK CAPACITY 1,000 GALLONS

FOR GARBAGE GRINDER, INCREASE DISPOSAL AREA 22% & TANK CAPACITY 50%.


OTHER place field 110 to 175 ft. from front lot line and 25 to 180 ft. from left side of lot as seen when facing lot from Braeburn Dr.

PLANS APPROVED BY Raymond Hodges DATE 4/10/63

FILL SEPTIC TANK AND DISTRIBUTION BOX WITH WATER BEFORE CALLING FOR AN INSPECTION. COVER NO WORK UNTIL INSPECTED AND APPROVED.

NEITHER THE HOWARD COUNTY COMMISSIONERS NOR THE HEALTH DEPARTMENT IS RESPONSIBLE FOR THE SUCCESSFUL OPERATION OF ANY SYSTEM.

A 06437

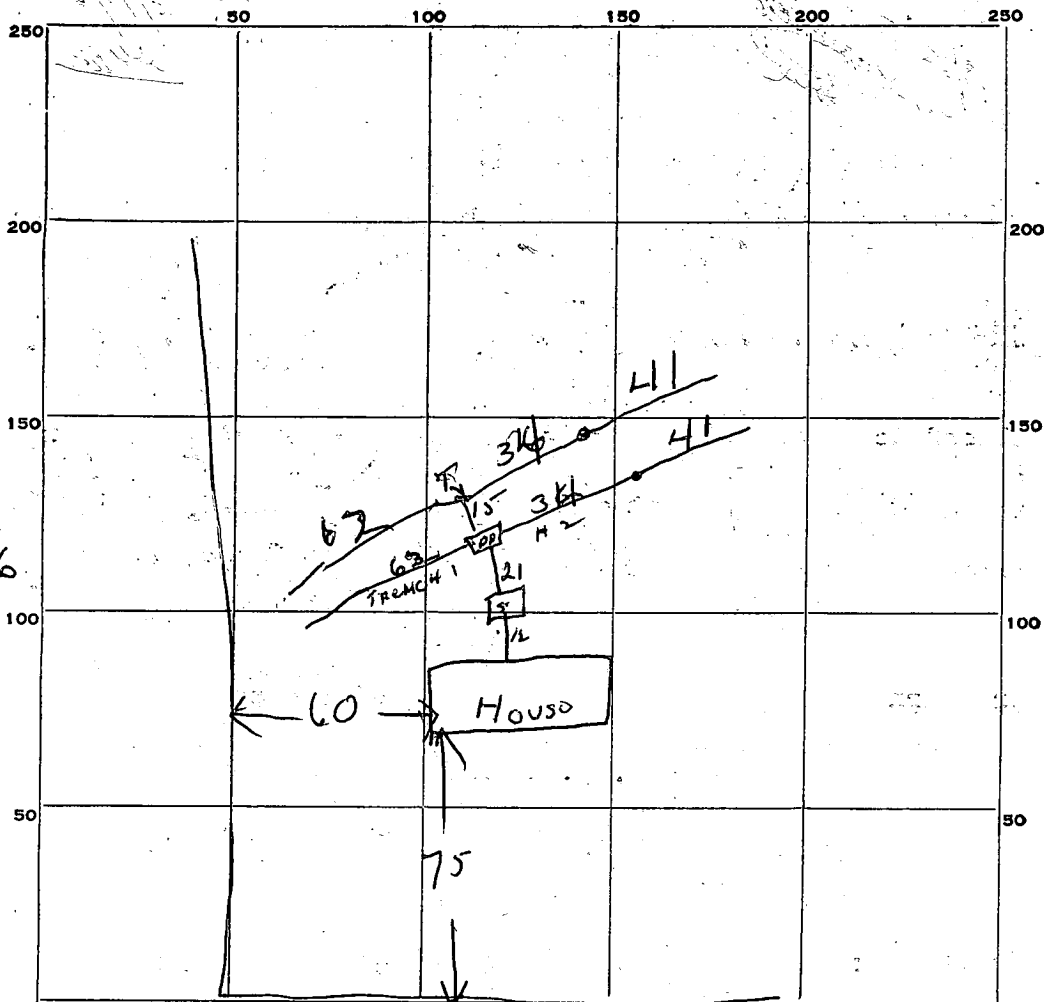

$$\begin{array}{r} 75 \\ 54 \\ \hline H \end{array}$$

$$\begin{array}{r} 62 \\ 62 \\ \hline \end{array}$$

$$\begin{array}{r} 96 \\ 96 \\ 192 \\ \hline 576 \end{array}$$

$$\begin{array}{r} 65 \\ 800 \\ 576 \\ \hline 224 \end{array}$$

$$\begin{array}{r} 62 \\ 15 \\ \hline 137 \\ 137 \\ \hline 274 \\ 2 \\ \hline 822 \end{array}$$

INDICATE NORTH. - NAME ADJOINING ROADWAY AS BASE LINE.

Braeburn Road

PERMIT CARD OK

SEPTIC TANK, LEVEL OK

CLEANOUTS OK

DISTRIBUTION BOX, LEVEL OK

TILE FIELD, DEPTH 2 & 5 1/2 FT. TRENCH WIDTH 3 FT.

GRAVEL DEPTH 12 IN. TOTAL LENGTH 218 FT.

NUMBER OF TRENCHES 4 TOTAL BOTTOM AREA 822 ~~497~~

SEEPAGE PITS, INSIDE DIAMETER \_\_\_\_\_ FT. DEPTH BELOW INLET \_\_\_\_\_ FT.

ABSORBENT AREA \_\_\_\_\_ SQ. FT.

REMARKS 8/13/63 - system needs additional <sup>224</sup> sq ft trench area. area trenches not connected separately to dist. box. Location of trenches need to be checked.

DATE SYSTEM APPROVED 8/19/63

INSPECTOR W. Moranhan

# APPLICATION

SEWAGE DISPOSAL TESTING

A 06437  
P 07213

MARYLAND STATE DEPARTMENT OF HEALTH

HOWARD COUNTY

ELLICOTT CITY

*1000 gallon tank*  
Tide Field *800 sq ft bottom area*

DISTRICT 5

DATE 3-22-63

*Place the tide field in the area 110 ft to 175 ft from the front lot line and 25 ft to 100 ft from the left side of the lot as shown when facing the lot from Braeburn Drive*

TO: THE COUNTY HEALTH OFFICER  
ELLICOTT CITY, MARYLAND

I, HEREBY, APPLY FOR THE NECESSARY TESTS IN ORDER TO CONSTRUCT (OR RECONSTRUCT) A SEWAGE DISPOSAL SYSTEM.

PROPERTY OWNER

*A. H. Young*

ADDRESS

*Ashton*

PHONE

PROPERTY LOCATION:

SUBDIVISION

*Braeburn*

LOT NO.

*21*

ROAD AND DESCRIPTION

*Cedar Lane*

OCCUPANT

PHONE

PERSON TO CONSTRUCT SYSTEM

ADDRESS

PHONE

SIZE OF LOT

*1 acre*

TYPE BLDG.

*4*

NUMBER OF BEDROOMS

IF NOT SINGLE RESIDENCE DESCRIBE

SIGNATURE OF APPLICANT

*Thomas V. Lacey*

APPROVED BY

*Raymond Hodges*

FOR

*Tide Field*

(KIND OF SYSTEM)

DATE

*10 APRIL 63*

REJECTED BY

FOR

(KIND OF SYSTEM)

DATE

*RH*

HOLD PENDING FURTHER TESTS


DATE

REASONS FOR REJECTION OR HOLDING

*27 MAR 63 Possibility of*

*Underground water in 8 FT hole*

# THIS IS NOT A PERMIT

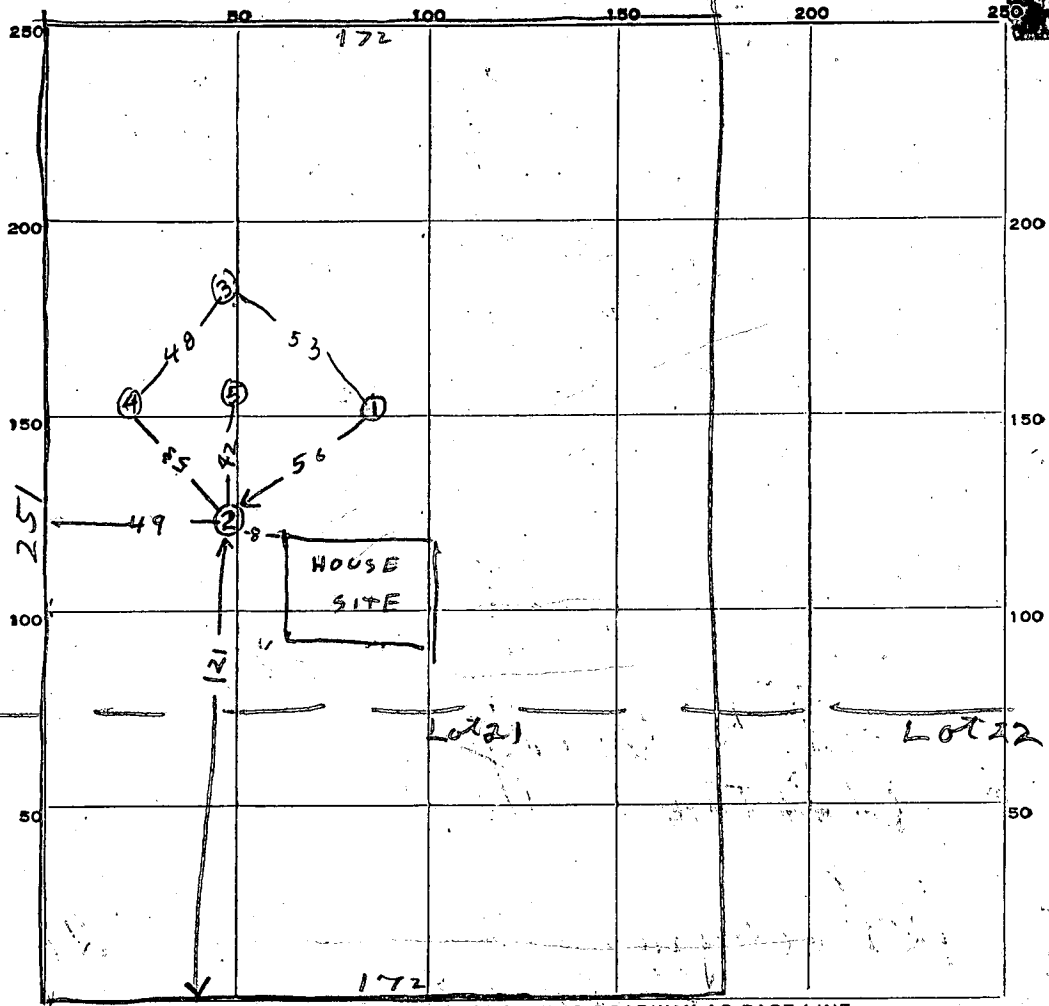

INDICATE NORTH. - NAME ADJOINING ROADWAY AS BASE LINE.

BRAEBURN RD TO CEDAR LANE →

DATE	TEST NO.	DEPTH	PRE-WET		TEST - 1" DROP		TIME	
			START	STOP	START	STOP		
3-27-63	1	4	1 10	1 20	1 20	1 28	8 min	
" "	2	4	1 14	1 42	1 42	2 06	24	
" "	3	4	1 15	1 18	1 18	1 17	1	
" "	4	4	1 22	2 10	little perc			
" "	5	4	1 29	2 10	little perc			
" "	6	7	WATER UP TO		6 FT LEVEL. COULD			
			BE EITHER RAIN WATER, OR UNDERGROUND WATER					

NEXT TO HOLE #5 TOP 3FT MICA BOTTOM 4FT CLAY

SOIL AUGER FINDING Thomas Kersey  
 TESTED BY Raymond Hodges  
 REMARKS 10 APRIL 63 Deep hole was dry  
 ALSO PRESENT \_\_\_\_\_ LOT NO. \_\_\_\_\_

7/30/63

# APPLICATION

Retest

A 07211

SEWAGE DISPOSAL TESTING

P \_\_\_\_\_

MARYLAND STATE DEPARTMENT OF HEALTH

HOWARD COUNTY

ELLICOTT CITY

*Install system according to old specifications B/H*

DISTRICT 5

DATE 7-29-63

Retest

TO: THE COUNTY HEALTH OFFICER  
ELLICOTT CITY, MARYLAND

I, HEREBY, APPLY FOR THE NECESSARY TESTS IN ORDER TO CONSTRUCT (OR RECONSTRUCT) A SEWAGE DISPOSAL SYSTEM.

PROPERTY OWNER A. H. Young  
ADDRESS \_\_\_\_\_ PHONE \_\_\_\_\_

PROPERTY LOCATION:  
SUBDIVISION ~~Moore~~ Buckhorn LOT NO. 21  
ROAD AND DESCRIPTION Cedar Lane

OCCUPANT \_\_\_\_\_ PHONE \_\_\_\_\_

PERSON TO CONSTRUCT SYSTEM \_\_\_\_\_  
ADDRESS \_\_\_\_\_ PHONE \_\_\_\_\_

SIZE OF LOT 1 acre TYPE BLDG. 4  
NUMBER OF BEDROOMS

IF NOT SINGLE RESIDENCE DESCRIBE \_\_\_\_\_

SIGNATURE OF APPLICANT Edward Sepp

APPROVED BY \_\_\_\_\_ FOR \_\_\_\_\_ DATE \_\_\_\_\_  
(KIND OF SYSTEM)

REJECTED BY B/H FOR \_\_\_\_\_ DATE \_\_\_\_\_  
(KIND OF SYSTEM)

HOLD PENDING FURTHER TESTS \_\_\_\_\_ DATE \_\_\_\_\_

REASONS FOR REJECTION OR HOLDING 3 July 63 Retest unsatisfactory  
Keep system same as before B/H

# THIS IS NOT A PERMIT

