


A# 06139

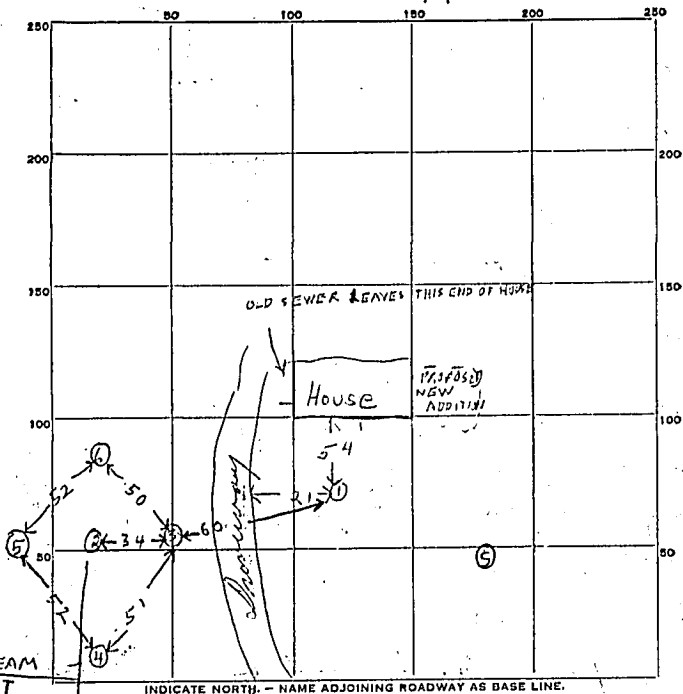

DATE	TEST NO.	DEPTH	PRE-WET		TEST - 1" DROP		TIME
			START	STOP	START	STOP	
11/29/62	1	9	939	very poor perc, about 1/8"			
12/5/62	2	9 1/2	934	938	938	953	15 min
"	3	4	937	1031	little perc		
"	4	4	941				
"	5	3	945				
"	6	2	951				

SOIL AUGER FINDING: 1st 3 1/2 clay Hole 2) Top 6 ft (cegs) bottom 3 1/2 ft sand

TESTED BY: DWM 11/29/62 12/5/62 Raymond Hodges

REMARKS: 12/5/62 10 7/8 in

ALSO PRESENT: M. & J. Maiden LOT NO. _____