

APPLICATION

A. 15668

SEWAGE DISPOSAL TESTING

P. _____

MARYLAND STATE DEPARTMENT OF HEALTH

HOWARD COUNTY

*leach pit - 1,000 gals.
Trench - 40 ft Long 10 ft
deep with 7 ft. of
stone beneath pipes.*

ELLICOTT CITY

DISTRICT 5

DATE 12/28/70

TO: THE COUNTY HEALTH OFFICER
ELLICOTT CITY, MARYLAND

I, HEREBY, APPLY FOR THE NECESSARY TESTS IN ORDER TO CONSTRUCT (OR RECONSTRUCT) A SEWAGE DISPOSAL SYSTEM.

PROPERTY OWNER Louis Naecker

ADDRESS Clarksville, Maryland

PHONE 286-2467

PROPERTY LOCATION:

SUBDIVISION _____

LOT NO. _____

ROAD AND DESCRIPTION leave Clarksville going toward Highland - foot of hill before
creek - long lane on right - 1/4 mile in - name on mail box

OCCUPANT _____

PHONE _____

PERSON TO CONSTRUCT SYSTEM _____

ADDRESS _____

PHONE _____

SIZE OF LOT 52 acres

TYPE BLDG. _____

Trailer

2

NUMBER OF BEDROOMS

IF NOT SINGLE RESIDENCE DESCRIBE _____

SIGNATURE OF APPLICANT Jack Jones

APPROVED BY Robert V. Tane

FOR

Deep Trench
(KIND OF SYSTEM)

DATE

1/7/71

REJECTED BY _____

FOR

(KIND OF SYSTEM)

DATE


HOLD PENDING FURTHER TESTS _____

DATE

REASONS FOR REJECTION OR HOLDING _____

THIS IS NOT A PERMIT

88881 A

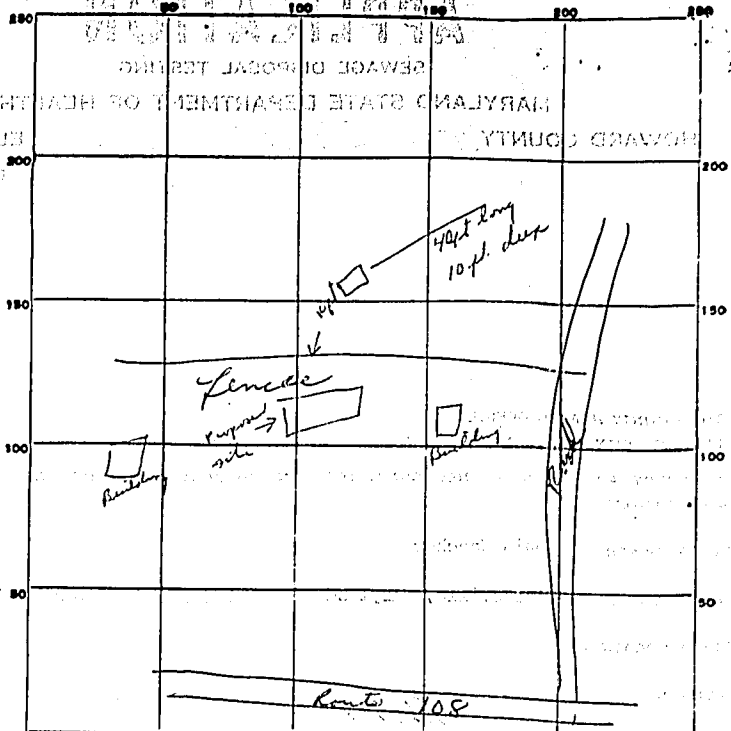

INDICATE NORTH. - NAME ADJOINING ROADWAY AS BASE LINE.

DATE	TEST NO.	DEPTH	PRE-WET		TEST - 1" DROP		TIME
			START	STOP	START	STOP	
11/2/71	1	Sandy	mic	shale			
	2			"			

SOIL AUGER FINDING _____

TESTED BY C. Toner

REMARKS _____

TIMBERLY A. TOM C. CITY