

6-17-63

~~6-13-63~~
~~not approved~~

PERMIT

Route 13 June 63
P 06567
OK H A 06139

SEWAGE DISPOSAL SYSTEM

MARYLAND STATE DEPARTMENT OF HEALTH

HOWARD COUNTY

ELLICOTT CITY

DISTRICT 5

DATE 4-10-63

INDEXED

INDEXED

Charles H. Shew

IS PERMITTED TO INSTALL ALTER

ADDRESS _____ PHONE _____

A SEWAGE DISPOSAL SYSTEM LOCATED AT Rt 108 - 1/2 mile south of Rt. 32
intersection on right

SUBDIVISION _____ ROAD _____ LOT _____

PROPERTY OWNER Trucker, Lewis

ADDRESS _____

SPECIFICATIONS

DRAIN FIELD _____ DEPTH _____ FEET, BOTTOM AREA _____ SQ. FT.

SEEPAGE PITS _____ ABSORBENT SIDE-WALL AREA *570 SQ. FT.

SEPTIC TANK CAPACITY 4,000 GALLONS

below top 6ft of clay

FOR GARBAGE GRINDER, INCREASE DISPOSAL AREA 22% & TANK CAPACITY 50%.

OTHER *3 4" pipes may be laid back 10' x 12' below grade

Place dry well in the area 120 to 160 ft from edge of stream and 15 to 55 ft from edge of road.


PLANS APPROVED BY Raymond Hodges DATE 12-5-62

FILL SEPTIC TANK AND DISTRIBUTION BOX WITH WATER BEFORE CALLING FOR AN INSPECTION. COVER NO WORK UNTIL INSPECTED AND APPROVED.

Use cast iron pipe under the driveway
NEITHER THE HOWARD COUNTY COMMISSIONERS NOR THE HEALTH DEPARTMENT IS RESPONSIBLE FOR THE SUCCESSFUL OPERATION OF ANY SYSTEM.

IMAY63 - Underground water in dry well test area at 7 ft to 9 ft
change system to Leaching Bed - 300 sq ft bottom area
installed at a depth of 3 ft to 9 ft
Place the bed 135 ft in the area 135 ft to 155 ft
from the edge of the bridge and 15 ft to 60 ft
from the edge of the dry driveway R/H

06139

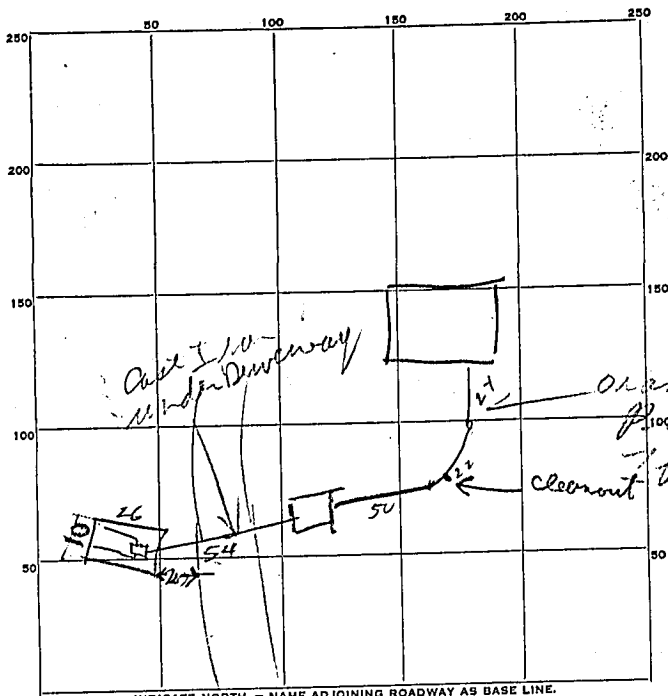

INDICATE NORTH - NAME ADJOINING ROADWAY AS BASE LINE.

10.3
9
11.3
Orangeburg
Pipe
12' below
grade

PERMIT CARD YES

SEPTIC TANK, LEVEL 1000 OK concrete
 TOP 1 ft. below grade
 DISTRIBUTION BOX, LEVEL _____

CLEANOUTS OK

26.5
10
265
sq

TILE FIELD, DEPTH 7 1/2 FT. TRENCH WIDTH 10 FT.

GRAVEL DEPTH 4 FT. TOTAL LENGTH 26 1/2 FT.

NUMBER OF TRENCHES _____ TOTAL BOTTOM AREA 265

SEEPAGE PITS, INSIDE DIAMETER _____ FT. DEPTH BELOW INLET _____ FT.

ABSORBENT AREA _____ SQ. FT.

REMARKS 11 Jan 63 126 ft. from edge of bridge to Leaching Bed and 20 ft. from edge of Driveway to Leaching Bed

17 Jan 63 Cleanouts needed on lines exposed and cast man pipe needed under driveway. OK to cover rest of system 17 Jan OK completed

DATE SYSTEM APPROVED 17 Jan 63 INSPECTOR Raymond Hodge