

initials **PHG**

Postcard 1/27/71 C. T. T. T.

PERMIT

SEWAGE DISPOSAL SYSTEM

MARYLAND STATE DEPARTMENT OF HEALTH.

HOWARD COUNTY

ELLCOTT CITY

DISTRICT 5

INDEXED

DATE 12/28/70

P. 15670

A. 15668

Jack Fyock

IS PERMITTED TO INSTALL ALTER

ADDRESS Ten Oaks Road, Glenelg, Maryland

PHONE 286-2939

A SEWAGE DISPOSAL SYSTEM LOCATED AT _____

SUBDIVISION _____

12702 Rt. 108

ROAD see application for LOT _____

better directions

PROPERTY OWNER Louis Naecker

ADDRESS _____

SPECIFICATIONS

DRAIN FIELD _____ DEPTH _____ FEET, BOTTOM AREA _____ SQ. FT.

SEEPAGE PITS _____ ABSORBENT SIDE-WALL AREA _____ SQ. FT.

SEPTIC TANK CAPACITY _____ GALLONS

FOR GARBAGE GRINDER, INCREASE DISPOSAL AREA 22% & TANK CAPACITY 50%.
SYSTEM WILL BE RECOMMENDED WHEN PERC TEST IS RUN.

OTHER trench - 40 ft long - 10 ft deep 7 ft of stone
beneath pipe

PLANS APPROVED BY Palmer F. Wine

DATE 12/28/70

FILL SEPTIC TANK AND DISTRIBUTION BOX WITH WATER BEFORE CALLING FOR AN INSPECTION. COVER NO WORK UNTIL INSPECTED AND APPROVED.

THE SYSTEM MUST BE INSTALLED AND APPROVED BEFORE ANY TRAILER PERMIT WILL BE SIGNED. NEITHER THE HOWARD COUNTY COMMISSIONERS NOR THE HEALTH DEPARTMENT IS RESPONSIBLE FOR THE SUCCESSFUL OPERATION OF ANY SYSTEM.


NOTE: ALL PIPE FROM TRAILER TO SEPTIC TANK MUST BE CAST IRON.
PERMIT VOID AFTER THREE YEARS.

BLDG. PERMIT SIGNED

AND RETURNED SM/LEZ

Serial #13839-Prod

A15668

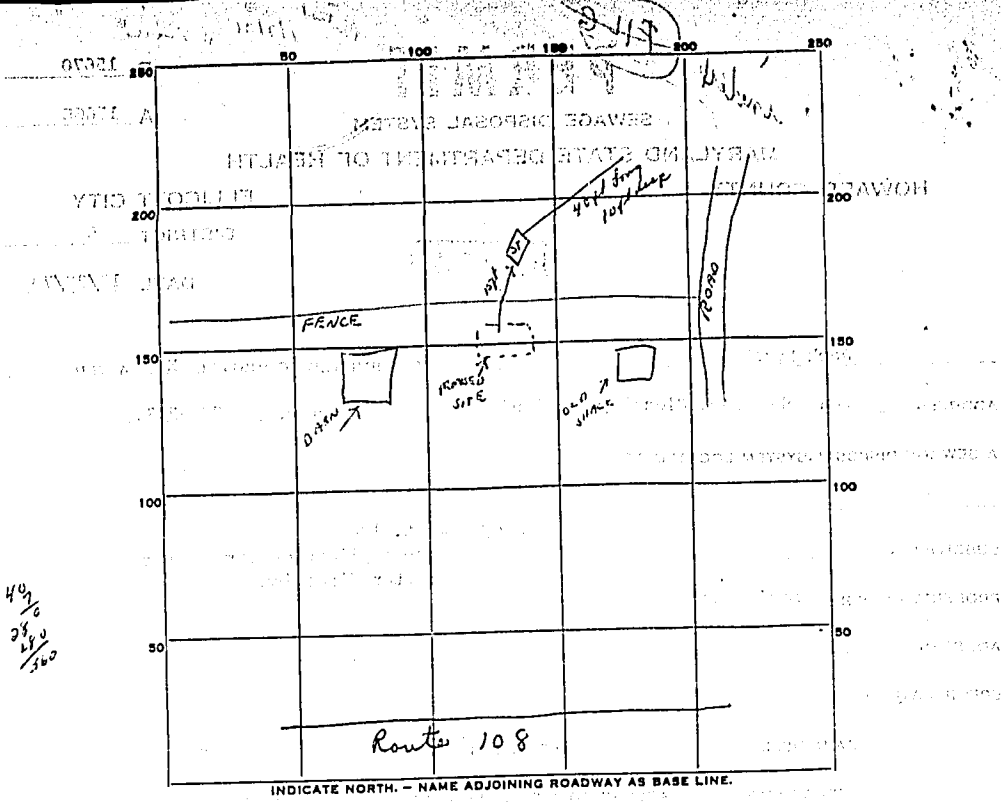

PERMIT CARD _____

SEPTIC TANK, LEVEL _____ CLEANOUTS OK

DISTRIBUTION BOX, LEVEL _____

TRENCH
 TILE FIELD, DEPTH 10 FT. TRENCH WIDTH 1 1/2 FT.

GRAVEL DEPTH 7 ft. IN. TOTAL LENGTH 40 FT.

NUMBER OF TRENCHES 1 Subwell
 TOTAL BOTTOM AREA 560 sq. ft.

SEEPAGE PITS, INSIDE DIAMETER _____ FT. DEPTH BELOW INLET _____ FT.

ABSORBENT AREA _____ SQ. FT.

REMARKS 1/7/71 - Have approval to cover system, but to
call for final when trailer is connected.
R. Torne

DATE SYSTEM APPROVED _____ INSPECTOR _____

49 1/2
 28 1/2
 360

12198