

6/2/84  
9-30 AM  
4/27/87  
4/28/87  
ASAP.

04-312627

4/27/84  
septic  
6203  
4  
2

# PERMIT

P 33944

A REPAIR

SEWAGE DISPOSAL SYSTEM

MARYLAND STATE DEPARTMENT OF HEALTH\*

HOWARD COUNTY  
BUREAU OF ENVIRONMENTAL HEALTH  
992-2330

3)  $\frac{.211}{632}$

ELLICOTT CITY  
DISTRICT \_\_\_\_\_

INDEXED

DATE 6/4/84

Fogle Septic Cleaning IS PERMITTED TO INSTALL \_\_\_\_\_ ALTER X

ADDRESS 6430 Woodbine Road, Woodbine, MD 21797 PHONE 795-3448

SUBDIVISION \_\_\_\_\_ ROAD 675 Ridge Road LOT \_\_\_\_\_

PROPERTY OWNER Mattie B. Cuthbutson PHONE: 829-0484

ADDRESS 675 Ridge Road  
Mt. Airy, Maryland 21771

IF GARBAGE GRINDER IS USED INCREASE SEPTIC TANK CAPACITY BY 50% AND ABSORPTION AREA BY 22%.

GARBAGE GRINDER? YES \_\_\_\_\_ NO X

SEPTIC TANK CAPACITY 1250 GALLONS NUMBER OF BEDROOMS 4

REPAIR - CALL FOR INSPECTION WHEN GROUND IS OPENED UP SO SANITARIAN CAN RECOMMEND REPAIR.

DEEP DITCH 140 FT LONG 3 FT WIDE 8 FT DEEP  
INLET 4 1/2 FT + 0.5 FT 3 FT STONE PLACE  
TRENCHES 70 FT TO 80 FT BEHIND THE  
HOUSE KEEP DITCHES 10 FT APART ASH  
4-20-87 Check above to INLET 4.5' BOTTOM 6.5' 2' STONE BELOW PIPE,  
1250 GAL TANK; TRENCH 70x140' LONG. SKH

PLANS APPROVED BY Frank Skinner DATE 6/4/84

COVER NO WORK UNTIL INSPECTED AND APPROVED.

NEITHER THE HOWARD COUNTY COUNCIL NOR THE HEALTH DEPARTMENT IS RESPONSIBLE FOR THE SUCCESSFUL OPERATION OF ANY SYSTEM.

NOTE: IF TRENCH IS USED CALL FOR INSPECTION BEFORE AND AFTER PLACING GRAVEL IN TRENCH.

NOTE: NO DRY WELL SHALL EXCEED 15 FOOT IN DIAMETER. NO ABSORPTION TRENCH TO EXCEED 100 FEET IN LENGTH.

NOTE: ALL PIPE FROM HOUSE TO SEPTIC TANK MUST BE CAST IRON OR SCHEDULE 40 PVC OR ABS.

PERMIT VOID AFTER THREE YEARS.

NOTE: INSTALL STAND PIPE ON SEPTIC TANK AND DRY WELL. STAND PIPES MUST BE 6 INCHES IN DIAMETER. CAST IRON, CONCRETE OR TERRA COTTA, OR PVC OR ABS ACCEPTED. IF TOP OF SEPTIC TANK IS DEEPER THAN 3 FEET MANHOLE TO GRADE REQUIRED.

**\*INSTALLER IS RESPONSIBLE FOR OBTAINING FINAL APPROVAL ON THIS PERMIT**


\*CALL 992-2330 FOR INSPECTION OF SEPTIC SYSTEMS.

EH - 2-1082

P 33944

(1)

BROWN CLAY  
 3 CLAYEY SHALEY  
 6 SANDY SHALEY  
 10 1/2 HARD

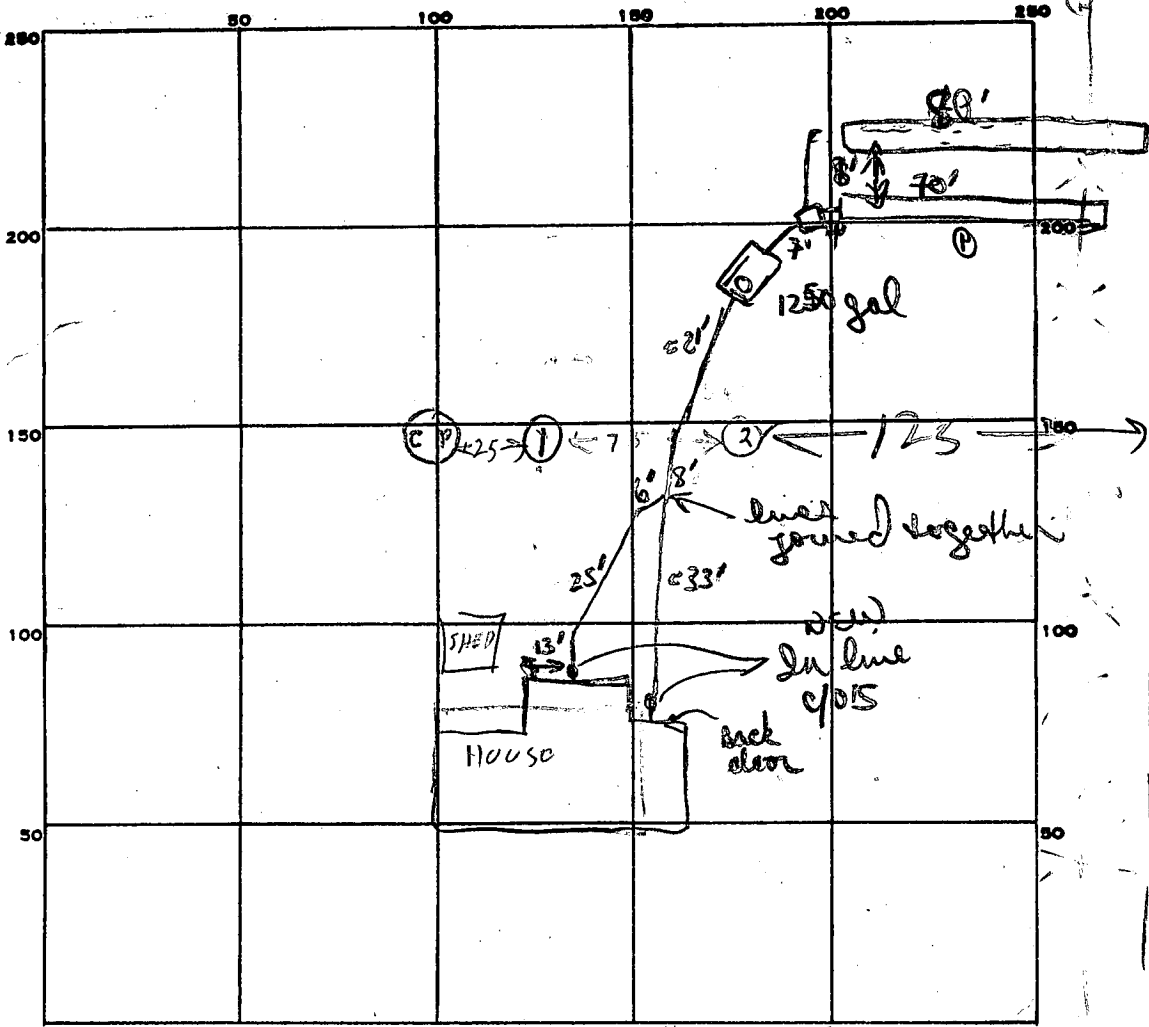

CP = CESS POLL  
 78' from house to hole #1

fence (prop) line

(2)  
 BROWN CLAY  
 5 SANDY SHALEY  
 11 HARD

INDICATE NORTH - NAME ADJOINING ROADWAY AS BASE LINE.

← (TO RTE 70) RIDGE RD (RTE 27)  
 Cat fork w/ Ridge & Frontier Rd

PERMIT CARD Final

SEPTIC TANK, LEVEL 1250 gal CLEANOUTS 2 In lines, 1 S.T. (man hole) AND

DISTRIBUTION BOX, LEVEL Cw/capped

TILE FIELD, DEPTH 6 1/2 FT. TRENCH WIDTH 3-4 + 3 FT.

GRAVEL DEPTH 2' 2' IN. TOTAL LENGTH 70 + 80 FT.

NUMBER OF TRENCHES 2 TOTAL BOTTOM AREA 210 + 240

SEEPAGE PITS, INSIDE DIAMETER \_\_\_\_\_ FT. DEPTH BELOW INLET \_\_\_\_\_ FT.

ABSORBENT AREA 450 SQ. FT.

125  
 3 or 4?  
 500

REMARKS  
 6/12/84 (1) 4 1/2 1051-1115 little pipe  
 6/12/84 2 5 1/2 1118 1121 1111 1125 4 Per OK for paper  
 4/27/87 OK to finish adding stone pipe paper to trench #1. OK to start trench #2 + finish cementing all lines  
 4/27/86 OK to cover trench #2. cementing done OK to cover from house to trenches OK to finish trench #2 + cover

DATE SYSTEM APPROVED 4/27/87 INSPECTOR B Nixon