

6/26/84
6/27/84
A.M.
6/28/84
A.M.

approved 6/28/84

Stayer

P 33990

A REPAIR

PERMIT

SEWAGE DISPOSAL SYSTEM

MARYLAND STATE DEPARTMENT OF HEALTH

ELLICOTT CITY

DISTRICT _____

DATE 6/12/84

HOWARD COUNTY
BUREAU OF ENVIRONMENTAL HEALTH
992-2330

02-2217473
INDEX

Charles Custer IS PERMITTED TO INSTALL _____ ALTER X

ADDRESS 8579 Old Frederick Road PHONE 465-3726

SUBDIVISION _____ ROAD 8579 Old Frederick Road OT _____

PROPERTY OWNER Charles Custer

ADDRESS _____

IF GARBAGE GRINDER IS USED INCREASE SEPTIC TANK CAPACITY BY 50% AND ABSORPTION AREA BY 22%.

GARBAGE GRINDER? YES _____ NO _____

SEPTIC TANK CAPACITY _____ GALLONS NUMBER OF BEDROOMS _____

REPAIR - CALL FOR INSPECTION WHEN GROUND IS OPENED UP SO SANITARIAN CAN RECOMMEND REPAIR.

13' VISUAL HOLE W BACK YARD - SANDY BEDS

RECOMMEND - INSTALL 80 FT OF TRENCH IN RET AT 5' - BOTTOM AT 10'

REPLACE ORANEBURG HOUSE SEWER LINE WITH SCHEDULE 40 PVC.

6/27/84 CW

PLANS APPROVED BY Frank Skinner DATE 6/12/84

COVER NO WORK UNTIL INSPECTED AND APPROVED.

NEITHER THE HOWARD COUNTY COUNCIL NOR THE HEALTH DEPARTMENT IS RESPONSIBLE FOR THE SUCCESSFUL OPERATION OF ANY SYSTEM.

NOTE: IF TRENCH IS USED CALL FOR INSPECTION BEFORE AND AFTER PLACING GRAVEL IN TRENCH.

NOTE: NO DRY WELL SHALL EXCEED 15 FOOT IN DIAMETER. NO ABSORPTION TRENCH TO EXCEED 100 FEET IN LENGTH.

NOTE: ALL PIPE FROM HOUSE TO SEPTIC TANK MUST BE CAST IRON OR SCHEDULE 40 PVC OR ABS.

PERMIT VOID AFTER THREE YEARS.

NOTE: INSTALL STAND PIPE ON SEPTIC TANK AND DRY WELL. STAND PIPES MUST BE 6 INCHES IN DIAMETER. CAST IRON, CONCRETE OR TERRA COTTA, OR PVC OR ABS ACCEPTED. IF TOP OF SEPTIC TANK IS DEEPER THAN 3 FEET MANHOLE TO GRADE REQUIRED.


BLDG. PERMIT SIGNED
AND RETURNED 6/28/84
for B.R. Balk & family add.
59684

***INSTALLER IS RESPONSIBLE FOR OBTAINING FINAL APPROVAL ON THIS PERMIT**

*CALL 992-2330 FOR INSPECTION OF SEPTIC SYSTEMS.

EH - 2-1082

33990

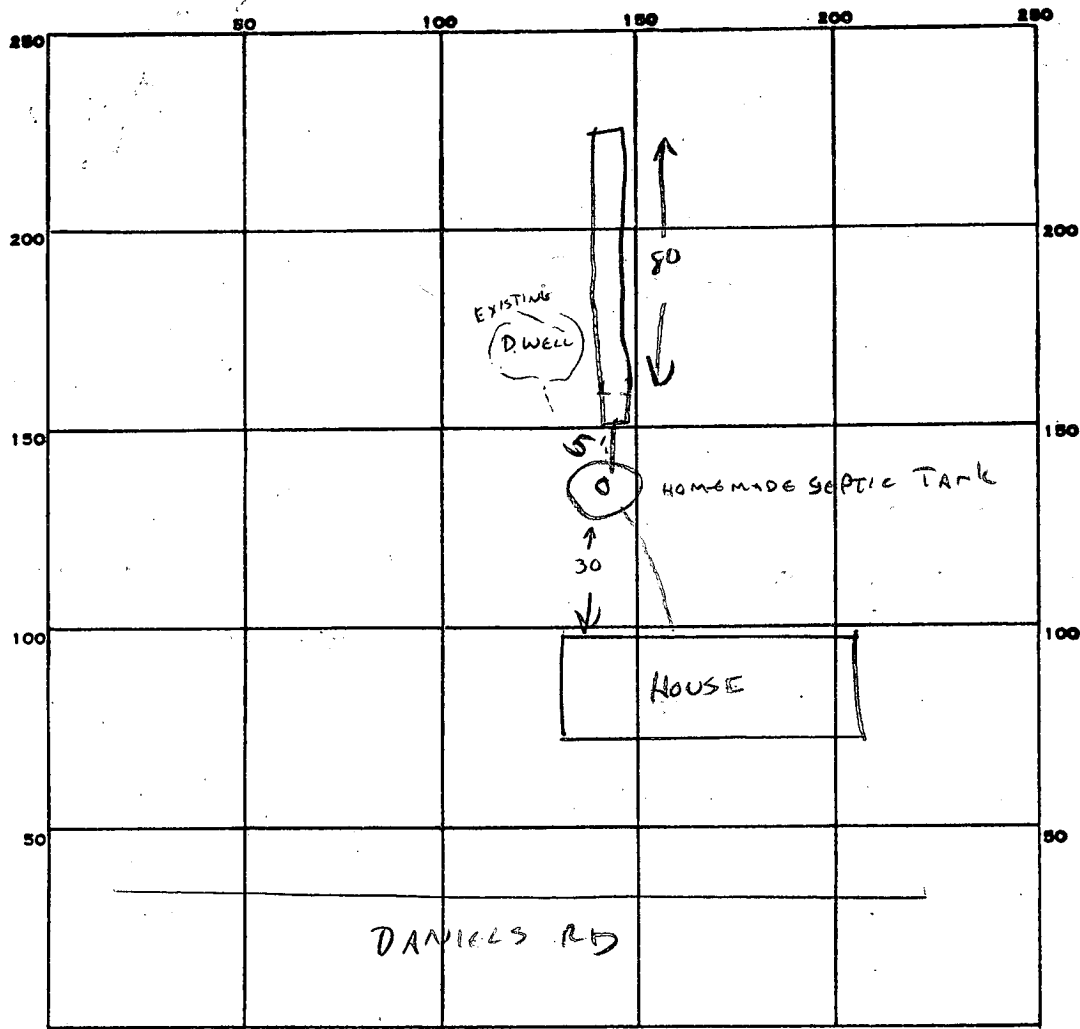

INDICATE NORTH. - NAME ADJOINING ROADWAY AS BASE LINE.

PERMIT CARD

SEPTIC TANK, LEVEL EXISTING

CLEANOUTS ST

DISTRIBUTION BOX, LEVEL N/A

TILE FIELD, DEPTH 10 FT. TRENCH WIDTH 2 FT.

GRAVEL DEPTH 6 IN. TOTAL LENGTH 80 FT.

NUMBER OF TRENCHES 1 TOTAL BOTTOM AREA 480

SEEPAGE PITS, INSIDE DIAMETER _____ FT. DEPTH BELOW INLET _____ FT.

ABSORBENT AREA 480 SQ. FT.


REMARKS _____

OK TO ADD GRAVEL TO TRENCH. MUST RUN NEW PIPING + ADD CLEANOUT 6/27/84 CW
6/28/84 OK to cover all work. J

DATE SYSTEM APPROVED 6/28/84

INSPECTOR Stone

PLOT PLAN FOR ADDITION:
 CHARLES & LINDA CUSTER
 8579 OLD FREDERICK RD.
 ELLICOTT CITY, MD. 21043

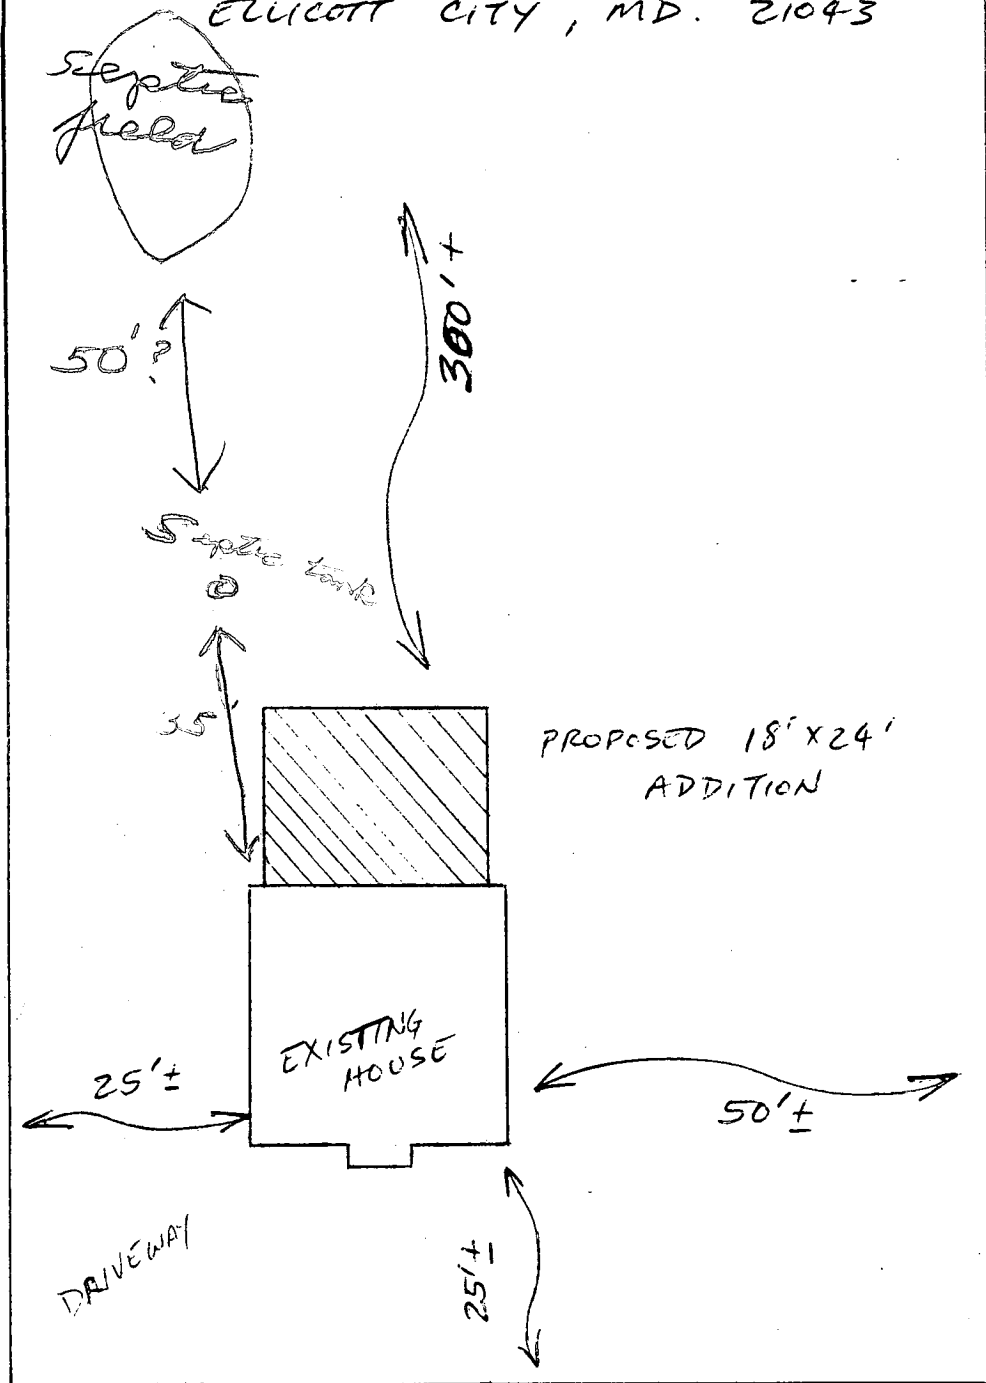

6/25/84

Talked with Mrs. Custer. Septic tank is partially uncovered, some made with concrete. DRAWN BY JOE MOINEAU
 top. No visible sewage problems. JUNE 1984-
 plenty of repair area. I told Mrs. Custer we would probably need to see one hole dug for repair area. J