

8/24/82
13

PERMIT 01-158201

P 32104

SEWAGE DISPOSAL SYSTEM

A Repair

MARYLAND STATE DEPARTMENT OF HEALTH NOT APPROVED 9/20/82 (CW)

HOWARD COUNTY

INDEXED

ELLICOTT CITY

799 5537

DISTRICT 1st

DATE 8/16/82

COVEY CONSTRUCTION CO BACKHOE

David Baker IS PERMITTED TO INSTALL ALTER X

ADDRESS 2 Hillside Ave., P. O. Box 566, Mapleville, R.I. 02389 PHONE

SUBDIVISION ROAD 6109 Hunt Club Road LOT

PROPERTY OWNER David Baker - has tenants living in this house

ADDRESS

SPECIFICATIONS

- SEPTIC TANK CAPACITY _____ GALLONS
- DRAIN FIELD _____ DEPTH _____ FEET, BOTTOM AREA _____ SQ. FT.
- DEEP TRENCH _____ DEPTH _____ FEET, BOTTOM AREA _____ SQ. FT.
- SEEPAGE PITS _____ ABSORBENT SIDE-WALL AREA _____ SQ. FT.
- INLET PIPE _____ FT. BELOW ORIGINAL GRADE. MAXIMUM DEPTH _____ FT. BELOW ORIGINAL GRADE
- EFFECTIVE DEPTH AT _____ FT. BELOW ORIGINAL GRADE.
- LOCATE DISPOSAL AREA _____ FT. FROM _____ LOT LINE AND _____ FT. FROM _____ LOT LINE AS SEEN WHEN FACING LOT FROM

NOT CLEAN IF WORK EVER PERFORMED AS OF 7/17/95 INDEX AS NOT APPROVED (CW)

REPAIR - Call for an appointment when ground is opened up and Sanitarian will

recommend the repair system. → 8/26/82 1,500 gallon sealed tank with alarm

device and a maintenance contract with a licesensed scavenger, 7.6,

9/20/82 O.K. to dig up top of old tank to see if it is water tight & properly sealed to be used as a sealed tank 7.5.

PLANS APPROVED BY Palmer F. Wine DATE 8/16/82

COVER NO WORK UNTIL INSPECTED AND APPROVED.

NEITHER THE HOWARD COUNTY COUNCIL NOR THE HEALTH DEPARTMENT IS RESPONSIBLE FOR THE SUCCESSFUL OPERATION OF ANY SYSTEM.

NOTE: IF TRENCH IS USED CALL FOR INSPECTION BEFORE PLACING GRAVEL IN TRENCH.

NOTE: NO DRY WELL SHALL EXCEED 15 FOOT IN DIAMETER.

NOTE: ALL PIPE FROM HOUSE TO DISPOSAL AREA MUST BE CAST IRON.


PERMIT VOID AFTER THREE YEARS.

NOTE: INSTALL STAND PIPE ON SEPTIC TANK AND DRY WELL. STAND PIPES MUST BE 6 INCHES IN DIAMETER. CAST IRON, CONCRETE OR TERRA COTTA ACCEPTED.

*INSTALLER IS RESPONSIBLE FOR OBTAINING FINAL APPROVAL ON THIS PERMIT.

P 32104

- ①
RED & GRAY CLAY
- ②
BROWN CLAY
RED & GRAY CLAY
- ③
BROWN CLAY
RED CLAY SAND
WHITE CLAY SAND MIX

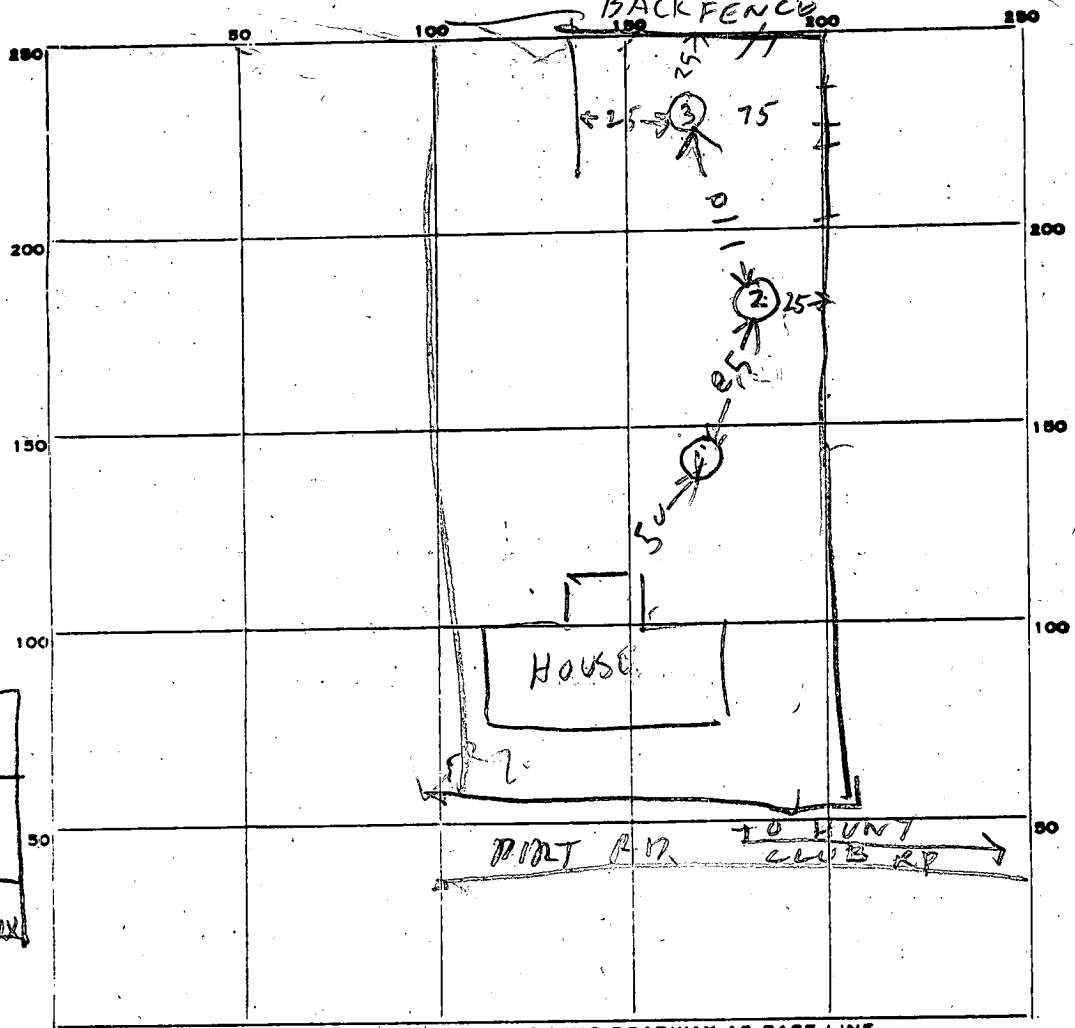

INDICATE NORTH. - NAME ADJOINING ROADWAY AS BASE LINE.

PERMIT CARD _____

SEPTIC TANK, LEVEL _____ CLEANOUTS _____

DISTRIBUTION BOX, LEVEL _____

TILE FIELD, DEPTH _____ FT. TRENCH WIDTH _____ FT.

GRAVEL DEPTH _____ IN. TOTAL LENGTH _____ FT.

NUMBER OF TRENCHES _____ TOTAL BOTTOM AREA _____

SEEPAGE PITS, INSIDE DIAMETER _____ FT. DEPTH BELOW INLET _____ FT.

ABSORBENT AREA _____ SQ. FT.

REMARKS 9/11/02 3 VISUAL HOLES & ALL CLAY & BACKHOE BROKE ON ③
SEALED TANK ONLY SOLATION NOW RH

DATE SYSTEM APPROVED _____ INSPECTOR _____

Covey Construction Co.

1896 MONTEVIDEO ROAD · JESSUP, MARYLAND 20794 · (301) 799-5537

August 25, 1982

Mr. David Baker, Sr.
2 Hillside Avenue
Mapleville, Rhode Island 02839

Dear Mr. Baker:

In regard to the property located at 6109 Hunt Club Road, Elkridge, Maryland. The perc tests have been completed and show that the ground is not suitable for a perc, according to Howard County requirements.

In talking with Mr. Skinner of Howard County, they require a sealed, 1500 gallon tank system with an alarm system. Also, a one year contract with a licensed scavenger (pumping contractor), for a period of one year or longer. This is to keep the system pumped off.

It could be a year or more before city sewerage will be available to your property.

Please advise as to whether you want to go ahead with this system, and if you want us to do the work. A ballpark estimate for this system, could run somewhere in the neighborhood of \$1500.00.

Very truly yours,


Robert L. Covey

RLC/bc