

Repair Perce
9/3/82
9:30 AM
9/10/82
As approved possible

PERMIT

SEWAGE DISPOSAL SYSTEM

MARYLAND STATE DEPARTMENT OF HEALTH

HOWARD COUNTY

Approved
9-16-82
C. Williams

P 32145
A REPAIR

ELLICOTT CITY

DISTRICT _____

DATE Sept 3, 1982

INDEX

Sadler Plumbing & Heating IS PERMITTED TO INSTALL _____ ALTER X

ADDRESS 4012 Benson Ave., Baltimore, Md. 21227 PHONE 242-2622

SUBDIVISION Ever Green Valley ESTATES ROAD 3102 Ever Green Way LOT 5, Sec. 4

PROPERTY OWNER McLaughlin

ADDRESS Same as above

SPECIFICATIONS

- SEPTIC TANK CAPACITY _____ GALLONS
- DRAIN FIELD _____ DEPTH _____ FEET, BOTTOM AREA _____ SQ. FT.
- DEEP TRENCH _____ DEPTH _____ FEET, BOTTOM AREA _____ SQ. FT.
- SEEPAGE PITS _____ ABSORBENT SIDE-WALL AREA _____ SQ. FT.
- INLET PIPE _____ FT. BELOW ORIGINAL GRADE. MAXIMUM DEPTH _____ FT. BELOW ORIGINAL GRADE
- EFFECTIVE DEPTH AT _____ FT. BELOW ORIGINAL GRADE.
- LOCATE DISPOSAL AREA _____ FT. FROM _____ LOT LINE AND _____ FT. FROM _____ LOT LINE AS SEEN WHEN FACING LOT FROM

REPAIR - CALL FOR INSPECTION WHEN GROUND IS OPENED UP SO SANITARIAN CAN RECOMMEND REPAIR.

Dug 12' vertical hole - all sandy loam, some sand stone at 12'
Recommend trench off of dry well 10 ft deep with 7 ft
stone. Trench to be at least 70 ft long. (see drawing)


PLANS APPROVED BY Palmer E. Wine DATE September 3, 1982

- COVER NO WORK UNTIL INSPECTED AND APPROVED.
- NEITHER THE HOWARD COUNTY COUNCIL NOR THE HEALTH DEPARTMENT IS RESPONSIBLE FOR THE SUCCESSFUL OPERATION OF ANY SYSTEM.
- NOTE: IF TRENCH IS USED CALL FOR INSPECTION BEFORE PLACING GRAVEL IN TRENCH.
- NOTE: NO DRY WELL SHALL EXCEED 15 FOOT IN DIAMETER.
- NOTE: ALL PIPE FROM HOUSE TO DISPOSAL AREA MUST BE CAST IRON.
- PERMIT VOID AFTER THREE YEARS.
- NOTE: INSTALL STAND PIPE ON SEPTIC TANK AND DRY WELL. STAND PIPES MUST BE 6 INCHES IN DIAMETER. CAST IRON, CONCRETE OR TERRA COTTA ACCEPTED.

***INSTALLER IS RESPONSIBLE FOR OBTAINING FINAL APPROVAL ON THIS PERMIT.**

BLDG. PERMIT SIGNED
AND RETURNED 9/14/82
Sadler #50499

P32145

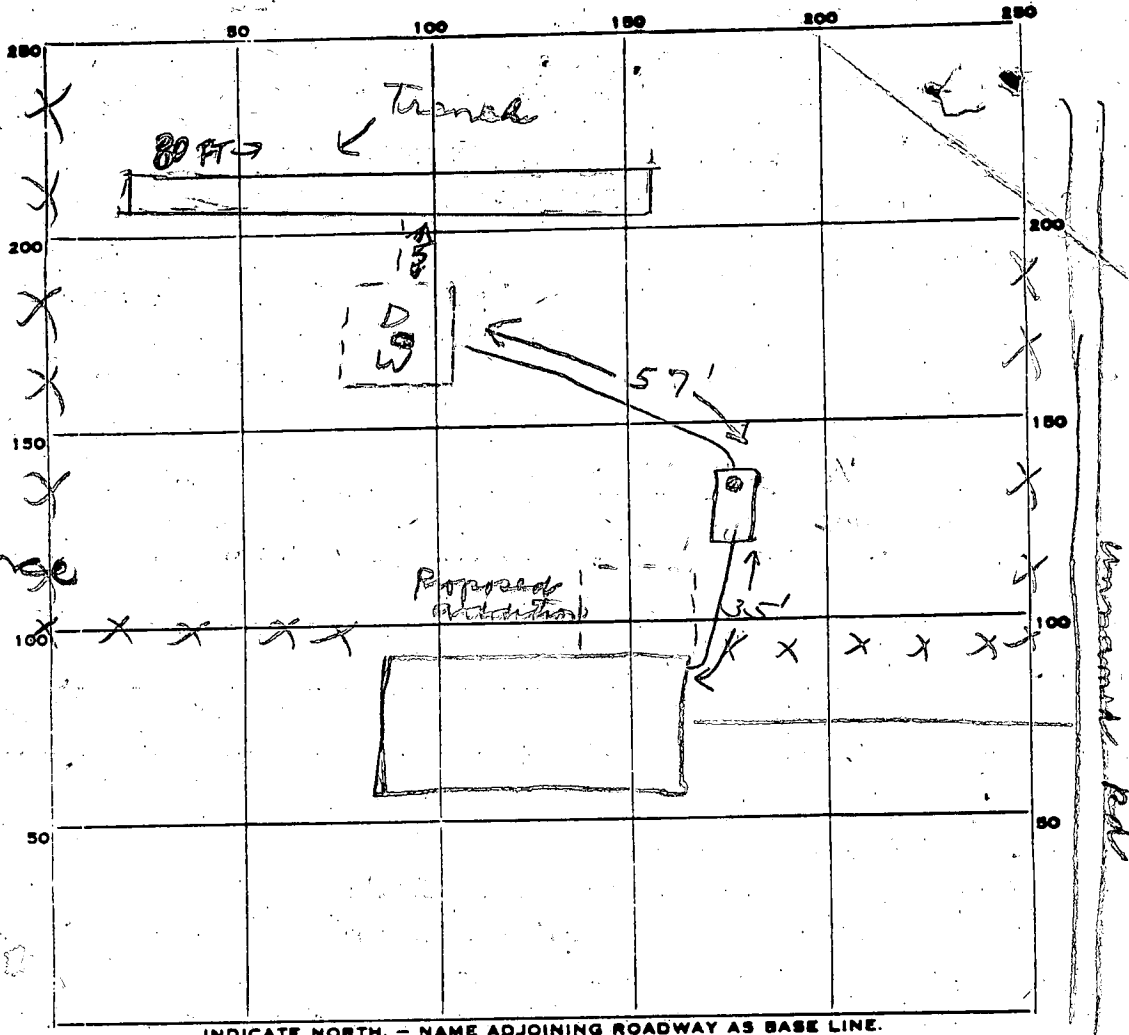

PERMIT CARD _____

SEPTIC TANK, LEVEL 2000 gal

CLEANOUTS ST

DISTRIBUTION BOX, LEVEL _____

TRENCH TILE FIELD, DEPTH 9 1/2 FT. TRENCH WIDTH 2 FT.

GRAVEL DEPTH 7 FT IN. TOTAL LENGTH 80 FT.

NUMBER OF TRENCHES 1 TOTAL BOTTOM AREA 760

DW SEEPAGE PITS, INSIDE DIAMETER EXISTING FT. DEPTH BELOW INLET _____ FT.

ABSORBENT AREA _____ SQ. FT.

REMARKS 9/3/82 Talked with Mr. McLaughlin, no garbage grinders to be used. Going to install 2000 gal. septic tank.
9/10/82 OK to cover, all work to dry well.
Call when trench ready.
9-16-82 TRENCH OK. - GRAVEL OK. COVER ALL WORK. CW

DATE SYSTEM APPROVED 9-16-82

INSPECTOR C. Williams

August 25, 1982

Mr. & Mrs. Thomas McLaughlin
3102 Evergreen Way
Ellicott City, Maryland 21043

RE: Building Permit Serial
50499, Evergreen Valley
Estates, Lot 5, Sec. 4

Dear Mr. & Mrs. McLaughlin,

We are in receipt of the above referenced building permit application for a 1,200 sq. ft. addition to your present dwelling. The present septic tank location, however, interferes with the placement of the proposed addition, and the size of the existing septic tank and drywell is insufficient to properly handle and dispose of sewage generated by the combination of the existing and proposed use.

Therefore, it is required that your septic system be renovated prior to approval of the building permit.

If you have any questions regarding this matter please call me at 992-2330.

Very truly yours,



Frank Skinner, Director
Water and Sewerage Program

FS:ag

7/1-7/66 After
Hof/66

PERMIT

SEWAGE DISPOSAL SYSTEM

MARYLAND STATE DEPARTMENT OF HEALTH

HOWARD COUNTY

INDEXED

P 11643

A 09637

ELLICOTT CITY

DISTRICT 3

DATE 3/30/66

Hudson Construction Co. IS PERMITTED TO INSTALL ALTER

ADDRESS 363 Chapel Avenue, Ellicott City, Md. PHONE HO 5-2205

A SEWAGE DISPOSAL SYSTEM LOCATED AT _____

SUBDIVISION Evergreen Valley Est. ROAD Evergreen Way & Alter Rd. LOT 5, Sec. 4

PROPERTY OWNER McLaughlin
Hudson Construction Co. *tax map 16, par. 241*

ADDRESS _____ *lot 5*

SPECIFICATIONS - 4 bedrooms

DRAIN FIELD _____ DEPTH _____ FEET, BOTTOM AREA _____ SQ. FT.

SEEPAGE PITS _____ ABSORBENT SIDE-WALL AREA _____ SQ. FT.

SEPTIC TANK CAPACITY 1,000 GALLONS

FOR GARBAGE GRINDER, INCREASE DISPOSAL AREA 22% & TANK CAPACITY 50%.

OTHER Dry well - 100 sq. ft. sidewall area below inlet pipe per bedroom.
Inlet pipe 4 ft. below grade.
Place dry well 180 ft. from front lot line and 69 ft. from right side line
as seen when facing lot from Evergreen Way.


PLANS APPROVED BY D. W. Monaghan DATE 6/2/65

FILL SEPTIC TANK AND DISTRIBUTION BOX WITH WATER BEFORE CALLING FOR AN INSPECTION. COVER NO WORK UNTIL INSPECTED AND APPROVED.

NEITHER THE HOWARD COUNTY COMMISSIONERS NOR THE HEALTH DEPARTMENT IS RESPONSIBLE FOR THE SUCCESSFUL OPERATION OF ANY SYSTEM.

BLDG. PERMIT SIGNED
AND RETURNED *4/5/66*
Serial # 43326
Pool.

A 09637

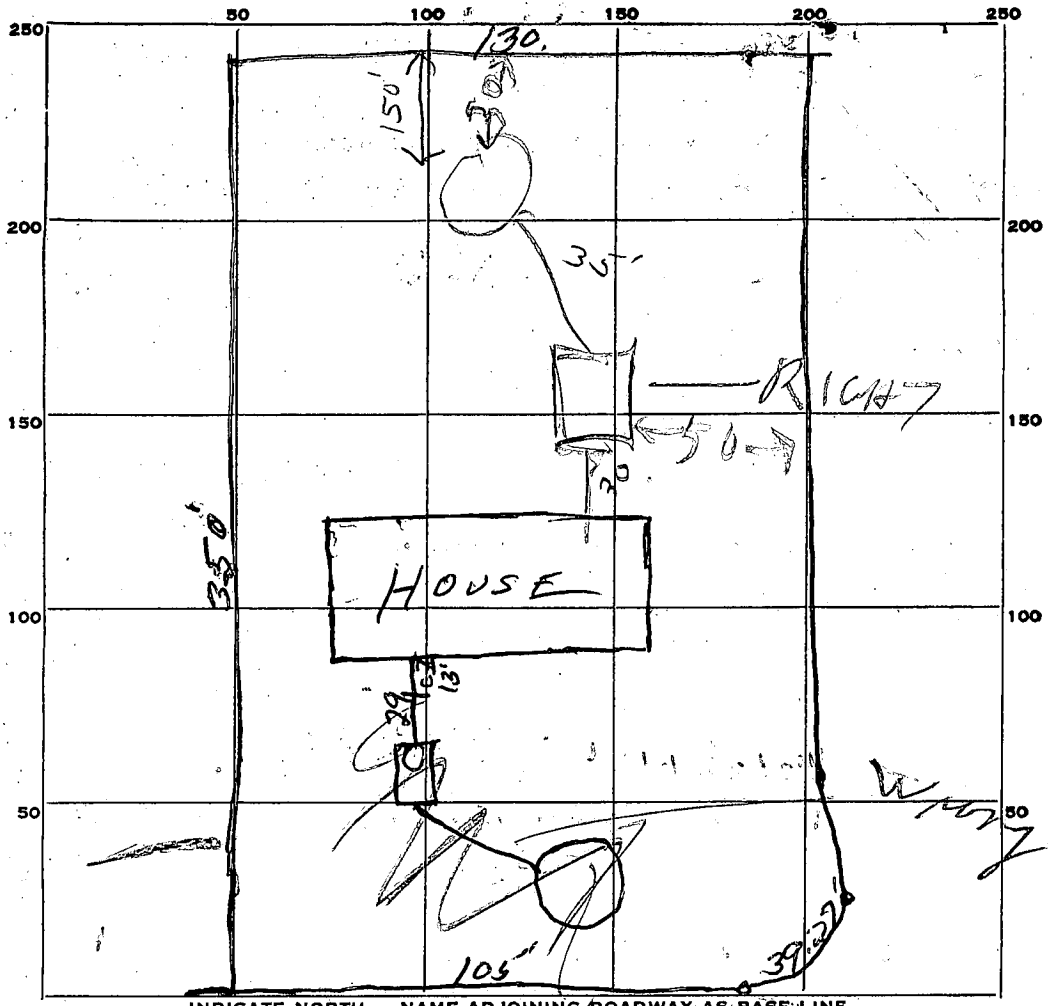

INDICATE NORTH - NAME ADJOINING ROADWAY AS BASE LINE.

EVERGREEN WAY

PERMIT CARD None Seen

SEPTIC TANK, LEVEL 100 gal tank CLEANOUTS 8" stand pipe

DISTRIBUTION BOX, LEVEL _____

TILE FIELD, DEPTH _____ FT. TRENCH WIDTH _____ FT.

GRAVEL DEPTH _____ IN. TOTAL LENGTH _____ FT.

NUMBER OF TRENCHES _____ TOTAL BOTTOM AREA _____

SEEPAGE PITS, INSIDE DIAMETER 16 FT. DEPTH BELOW INLET 10 FT.

ABSORBENT AREA OK SQ. FT.

REMARKS 7-8-66 Not ready. JH.

6/3/80 - LOCATION BY JH WRONG
CORRECTED LOCATION SHOWN. DW NOT YET
OVERFLOWING. BUT IT IS ALMOST FULL R/H

*7/8/83
 2,000 gal tank
 made in law dept.
 54 B.A. #2
 to be installed
 get approval permit
 11/1/83*

DATE SYSTEM APPROVED July 13, 1966 INSPECTOR J. Hennigan

APPLICATION

A 09637

SEWAGE DISPOSAL TESTING

P _____

MARYLAND STATE DEPARTMENT OF HEALTH

HOWARD COUNTY

ELLICOTT CITY

Septic Tank - 3 bedrooms - 750 gal.
1000 gal.

DISTRICT 3

DATE 2/17/65

Dry Well - 100 sq ft sidewalk area below inlet pipe per bedroom Inlet pipe 4 ft below grade.

Place Dry Well 180 ft from front lot line and 69 ft from right side line as seen when facing lot from Evergreen Way.

TO: THE COUNTY HEALTH OFFICER
ELLICOTT CITY, MARYLAND

I, HEREBY, APPLY FOR THE NECESSARY TESTS IN ORDER TO CONSTRUCT (OR RECONSTRUCT) A SEWAGE DISPOSAL SYSTEM.

PROPERTY OWNER Hudson Construction Company, Inc.

ADDRESS 363 Chapel Avenue, Ellicott City, Md. PHONE HO 5-2205

PROPERTY LOCATION:

SUBDIVISION Evergreen Valley Estates LOT NO. 5 Sec. 4

ROAD AND DESCRIPTION Evergreen Way & Alter Rd.

OCCUPANT _____ PHONE _____

PERSON TO CONSTRUCT SYSTEM _____

ADDRESS _____ PHONE _____

SIZE OF LOT 45,366 sq. ft. TYPE BLDG. 3 or 4
NUMBER OF BEDROOMS

IF NOT SINGLE RESIDENCE DESCRIBE _____

SIGNATURE OF APPLICANT /s/ Madeline Leonardi


APPROVED BY DW Monaghan FOR Dry Well DATE 6-2-65
(KIND OF SYSTEM)

REJECTED BY _____ FOR _____ DATE _____
(KIND OF SYSTEM)

HOLD PENDING FURTHER TESTS _____ DATE _____

REASONS FOR REJECTION OR HOLDING _____

THIS IS NOT A PERMIT

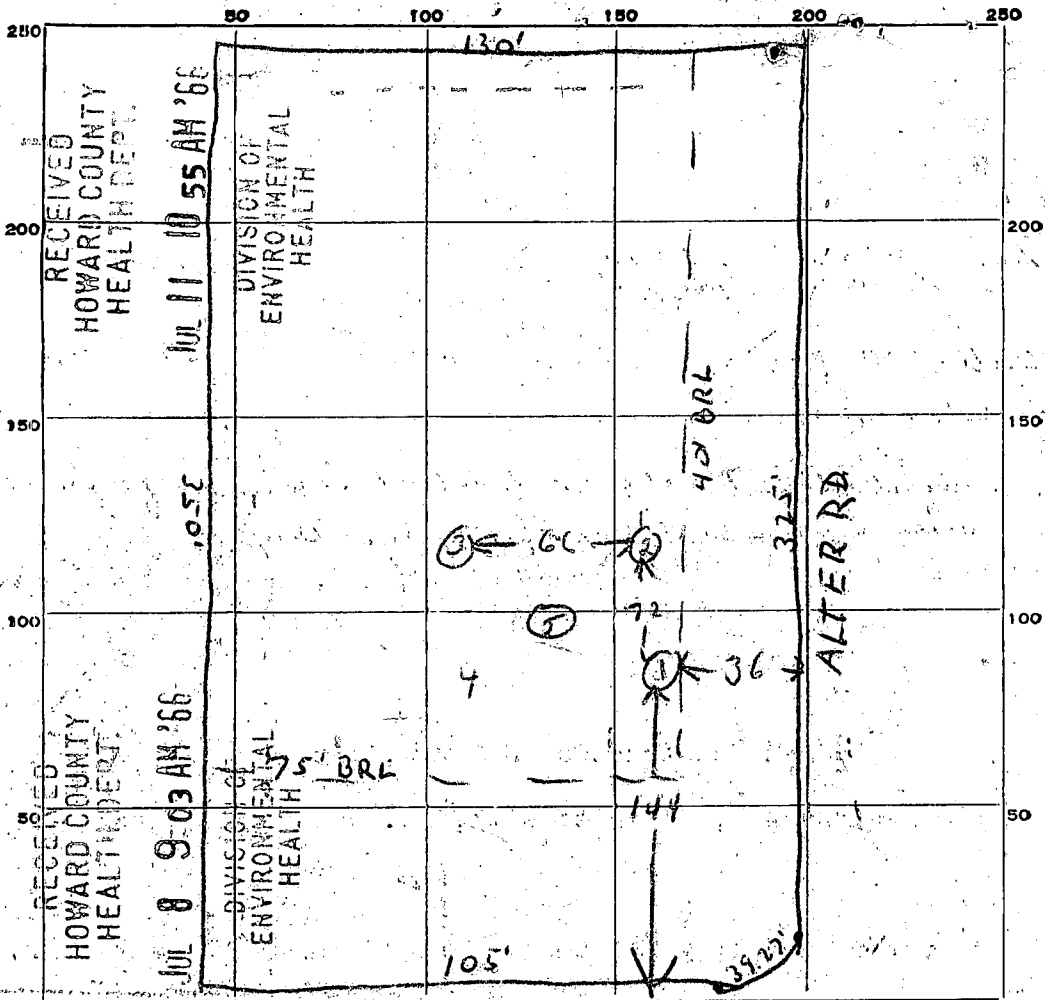

INDICATE NORTH. - NAME ADJOINING ROADWAY AS BASE LINE.

EVERGREEN WAY

DATE	TEST NO.	DEPTH	PRE-WET		TEST - 1" DROP		TIME
			START	STOP	START	STOP	
2/11/67	1	5 ft	1029	1030	1030	1033	3 min
	2	5 ft	1030	1032	1032	1035	3 min
	3	5 ft	1032	1034	1034	1036	2 min
	4	5 ft	1034	1036	1036	1039	3 min
	5	10 ft	1039	1040	1040	1042	2 min

SOIL AUGER FINDING

2/11/67

TESTED BY

D. J. ...

REMARKS

ALSO PRESENT

D. J. ...

LOT NO. 5

APPLICATION MUST BE SUBMITTED AND PERMIT RECEIVED BEFORE DRILLING IS STARTED.

APPLICATION FOR PERMIT TO DRILL WELL

No. 649
A09637

Owner Hudson Construction Co
Street or R. F. D. 31128
Post Office Ellicott City

Driller Ed. Brown License Number 288
Street or R. F. D. P. 3 Mt. Airy
Post Office P. 3 Mt. Airy
Date 4/18/66

Quantity of Water to be Produced 3 G.P.M.
Total Quantity Needed For Use 300 G.P.D.
Use for Water Home
Approximate Depth of Well (feet) 125
Method of Drilling to be used Rotary

Location of Well
Subdivision Evergreen Valley Estates
Section 3 Lot 5
County MONTGOMERY
Nearest Town MDYFIELD
Distance from Town 3/10 mile
Direction from Town South East

Is this a Replacement Well? Yes - No
If YES, indicate date abandoned well is to be sealed: _____
and by whom: _____

Description of Location of Well
(This information should be definite enough to permit locating well on a county map).
Near what road Triadelphia Rd.
On which side of road S. East
(North, East, South, West)

PERMIT TO DRILL WELL
(Not To Be Filled In By Driller)

Well Permit No. Ho-66-W-323

Samples of Cuttings Required by Department: Yes No
Owner Requires Permit to Appropriate Water: Yes No
Owner Has Permit to Appropriate Water: Yes No


Appropriation Permit No. _____
The applicant is herewith granted a permit to drill this well subject to the conditions stipulated.
Baul W. Meehan Dir. 5-19-66 Date

THIS PERMIT IS NOT TRANSFERABLE
WITHOUT WRITTEN PERMISSION FROM THE DEPARTMENT
Special conditions that must be observed:

Health Department Approval of Application
Howard County Department of Health
or State Department of Health
Approved by Palmer F. Wine
Title Director
Date 5/18/66

Distance from road 50ft
Draw a sketch below showing location of well in relation to nearby towns, roads and streams with north in the direction of the arrow, and give distance from well to nearest road junction or stream crossing shown on the sketch.

NORTH

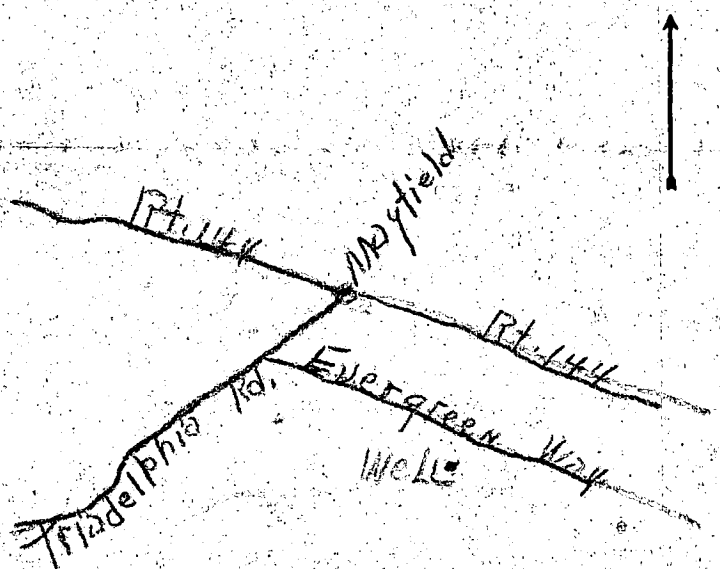

**THIS REPORT
 MUST BE SUBMITTED
 WITHIN 30 DAYS
 AFTER COMPLETION
 OF THE WELL**

WELL COMPLETION REPORT

WELL DESCRIPTION

WELL LOG

State the kind of formations penetrated, their color, their depth, their thickness, and if water-bearing

CASING AND SCREEN RECORD

State the kind and size and position of casing, liner, shoe, screen, and other accessories (if no casing used, give diameter of well).

	FEET from ___ to ___		DIAM. (inches)	FEET from ___ to ___
	clay 15 sand		6 1/4"	22
	34 Shale Rock 7.0 micaceous 101 granite Rock		Pipe	
20 gal at 224 ft				
WELL	227			

Permit Number Ho-664-323
 Owner Hudson Contr. Co.
 Address Ellicott City
 Subdivision Evergreen No. 2 State
 Section 3 Lot 5

PUMPING TEST

Hours Pumped 2
 Type of Pump Used OUH
 Pumping Rate _____
 Gallons per Minute 20

WATER LEVEL

(Distance from land surface to water)
 Before Pumping 38 Ft.
 When Pumping _____ Ft.

APPEARANCE OF WATER

Clear Cloudy _____
 Taste _____
 Odor None

Height of Casing Above Land
 Surface 2 Ft.

PUMP INSTALLED

Type _____
 Capacity _____
 Gallons per Minute _____
 Gallons per Hour _____
 Pump Column Length _____ Ft.

LOCATION OF WELL ON LOT

Show permanent structures such as building(s), septic tank, and/or other landmarks and indicate not less than 2 distances (measurements) to well.

NORTH




DATE
 WELL WAS
 COMPLETED

I hereby affirm that this report contains no willful misrepresentations or falsifications and that information given in this report is true, accurate and complete to the best of my knowledge and belief.

Ed. Brown, Well Driller

Well Driller License No.: 81

10/10/66

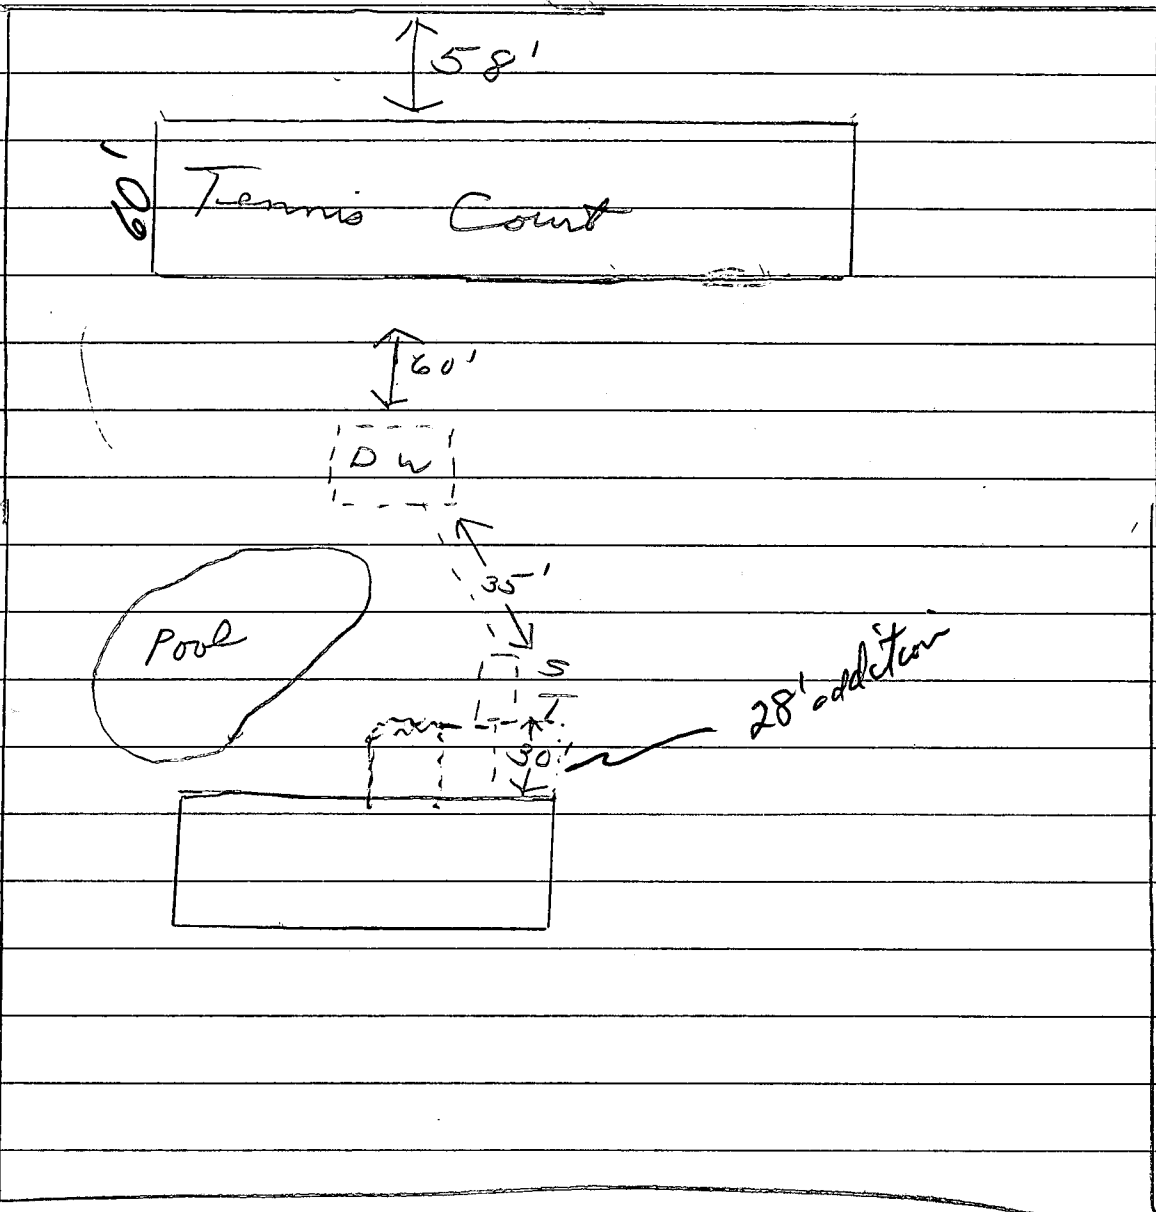

$$\begin{array}{r} 28 \\ 24 \\ \hline 112 \\ 56 \\ \hline 672 \end{array}$$


Evergreen way

3102 Evergreen way
McLaughlin Property

8/6/82 - Talked with Mrs. Mc L. Explained where new system should go. Suggest trench to be installed & connect to Present drywell. JS



ALTAR ROAD

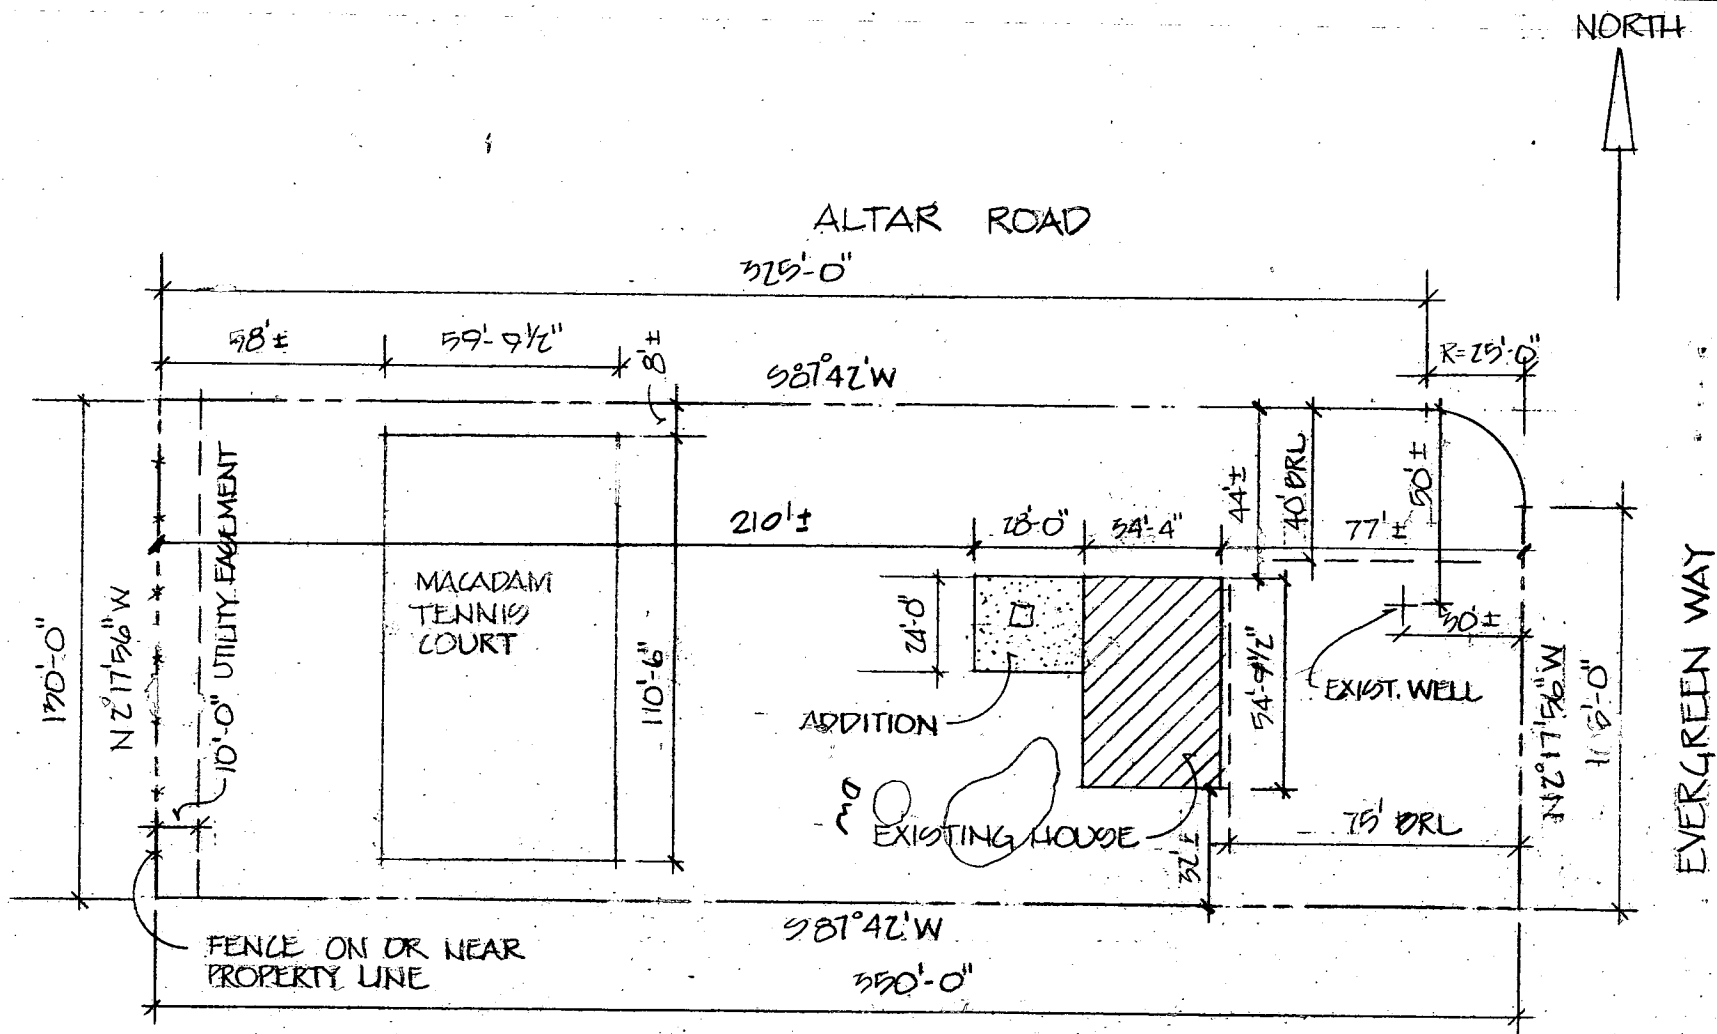

LOT 5 SECT. 4
EVERGREEN VALLEY ESTATES, 3RD ELECT. DIST.
BUILDING LOCATION MAP
SCALE: 1"=50'-0"