

9/28/82  
as early as possible

6/28/82 App'd F.S.

# PERMIT

P 32202

A Repair

SEWAGE DISPOSAL SYSTEM

MARYLAND STATE DEPARTMENT OF HEALTH

HOWARD COUNTY

ELLICOTT CITY

DISTRICT 3rd

## INDEX

DATE 9/27/82

Jack Fyock IS PERMITTED TO INSTALL ALTER X

ADDRESS 13775 Triadelphia Road, Glenelg, Md. 21737 PHONE 988-9270

SUBDIVISION \_\_\_\_\_ ROAD 13277 Folly Quarter Road LOT \_\_\_\_\_

PROPERTY OWNER Royden A. Blunt

ADDRESS 13277 Folly Quarter Road, Ellicott City, Md. 21043 Phone: 988-9343

**SPECIFICATIONS**

SEPTIC TANK CAPACITY \_\_\_\_\_ GALLONS

DRAIN FIELD \_\_\_\_\_ DEPTH \_\_\_\_\_ FEET, BOTTOM AREA \_\_\_\_\_ SQ. FT.

DEEP TRENCH \_\_\_\_\_ DEPTH \_\_\_\_\_ FEET, BOTTOM AREA \_\_\_\_\_ SQ. FT.

SEEPAGE PITS \_\_\_\_\_ ABSORBENT SIDE-WALL AREA \_\_\_\_\_ SQ. FT.

INLET PIPE \_\_\_\_\_ FT. BELOW ORIGINAL GRADE. MAXIMUM DEPTH \_\_\_\_\_ FT. BELOW ORIGINAL GRADE

EFFECTIVE DEPTH AT \_\_\_\_\_ FT. BELOW ORIGINAL GRADE.

LOCATE DISPOSAL AREA \_\_\_\_\_ FT. FROM \_\_\_\_\_ LOT LINE AND \_\_\_\_\_ FT. FROM \_\_\_\_\_ LOT LINE AS SEEN WHEN FACING LOT FROM

REPAIR - Call for an appointment when ground is opened up and Sanitarian will recommend the repair system.

PLANS APPROVED BY Palmer F. Wine DATE 9/27/82

COVER NO WORK UNTIL INSPECTED AND APPROVED.

NEITHER THE HOWARD COUNTY COUNCIL NOR THE HEALTH DEPARTMENT IS RESPONSIBLE FOR THE SUCCESSFUL OPERATION OF ANY SYSTEM.

NOTE: IF TRENCH IS USED CALL FOR INSPECTION BEFORE PLACING GRAVEL IN TRENCH.

NOTE: NO DRY WELL SHALL EXCEED 15 FOOT IN DIAMETER.


NOTE: ALL PIPE FROM HOUSE TO DISPOSAL AREA MUST BE CAST IRON.

PERMIT VOID AFTER THREE YEARS.

NOTE: INSTALL STAND PIPE ON SEPTIC TANK AND DRY WELL. STAND PIPES MUST BE 6 INCHES IN DIAMETER. CAST IRON, CONCRETE OR TERRA COTTA ACCEPTED.

**\*INSTALLER IS RESPONSIBLE FOR OBTAINING FINAL APPROVAL ON THIS PERMIT.**

XP 32202

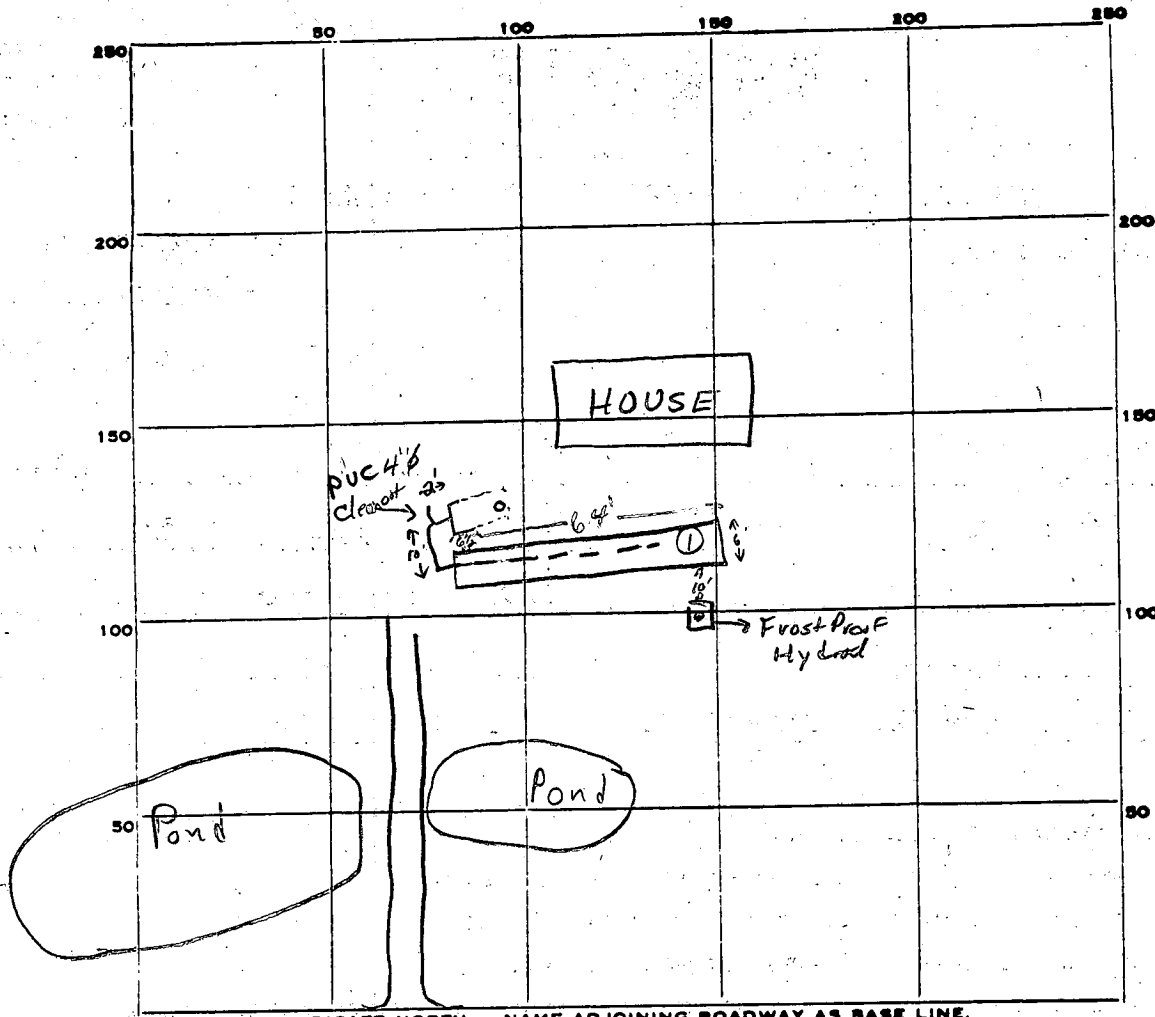

① 9' deep  
clayey to 3-4'  
sandy loam below

INDICATE NORTH. - NAME ADJOINING ROADWAY AS BASE LINE.

Folly Quarter Road

PERMIT CARD ✓ signed OK final F.S.

SEPTIC TANK, LEVEL existing CLEANOUTS S.T. existing | in-line 4" Ø PVC 2' from tank add'l before 90° bend

DISTRIBUTION BOX, LEVEL n.a.

TILE FIELD, DEPTH 4-6 FT. TRENCH WIDTH 6 FT.

GRAVEL DEPTH 18 IN. TOTAL LENGTH 64 FT. 64  
5  
384

NUMBER OF TRENCHES 1 TOTAL BOTTOM AREA 384

SEEPAGE PITS, INSIDE DIAMETER - FT. DEPTH BELOW INLET 1 1/2 FT.

Total Bottom ABSORBENT AREA ± 384 SQ. FT.

REMARKS 9/28/82 18" below distribution pipe, trench dug out to 50' length O.K. to proceed F.S.  
9/28/82 O.K. to cover all work F.S.

DATE SYSTEM APPROVED 9/28/82 INSPECTOR F. Skinner