

05-353858

APPROVED
3/23/83
RH
P 32576

PERMIT

SEWAGE DISPOSAL SYSTEM

MARYLAND STATE DEPARTMENT OF HEALTH*

A REPAIR

HOWARD COUNTY
BUREAU OF ENVIRONMENTAL HEALTH
992-2330

3/23/83
11:00 if possible

ELLICOTT CITY

DISTRICT _____

INDEX

DATE 3/22/83

Jenkins Bros.

IS PERMITTED TO INSTALL ALTER _____

ADDRESS Route 144, Ellicott City, Md. 21043 PHONE 465-6646

SUBDIVISION _____ ROAD 6519 Freetown Rd. LOT _____

PROPERTY OWNER Mr. Richard L. Jones & Wife

ADDRESS 6519 Freetown Rd., Columbia, Md.

IF GARBAGE GRINDER IS USED INCREASE SEPTIC TANK CAPACITY BY 50% AND ABSORPTION AREA BY 22%.

GARBAGE GRINDER? YES _____ NO

SEPTIC TANK CAPACITY 1000 GALLONS NUMBER OF BEDROOMS _____

REPAIR-CALL FOR INSPECTION WHEN GROUND IS OPENED UP SO SANITARIAN CAN

RECOMMEND REPAIR. SEPTIC TANK REPLACEMENT ONLY

PLANS APPROVED BY Palmer F. Wine DATE March 22, 1983

COVER NO WORK UNTIL INSPECTED AND APPROVED.

NEITHER THE HOWARD COUNTY COUNCIL NOR THE HEALTH DEPARTMENT IS RESPONSIBLE FOR THE SUCCESSFUL OPERATION OF ANY SYSTEM.

NOTE: IF TRENCH IS USED CALL FOR INSPECTION BEFORE AND AFTER PLACING GRAVEL IN TRENCH.

NOTE: NO DRY WELL SHALL EXCEED 15 FOOT IN DIAMETER. NO ABSORPTION TRENCH TO EXCEED 100 FEET IN LENGTH.

NOTE: ALL PIPE FROM HOUSE TO SEPTIC TANK MUST BE CAST IRON OR SCHEDULE 40 PVC OR ABS.

PERMIT VOID AFTER THREE YEARS.


NOTE: INSTALL STAND PIPE ON SEPTIC TANK AND DRY WELL. STAND PIPES MUST BE 6 INCHES IN DIAMETER. CAST IRON, CONCRETE OR TERRA COTTA, OR PVC OR ABS ACCEPTED. IF TOP OF SEPTIC TANK IS DEEPER THAN 3 FEET MANHOLE TO GRADE REQUIRED.

***INSTALLER IS RESPONSIBLE FOR OBTAINING FINAL APROVAL ON THIS PERMIT**

*CALL 992-2330 FOR INSPECTION OF SEPTIC SYSTEMS.

EH - 2-1082

Handwritten signature/initials and number 32576.

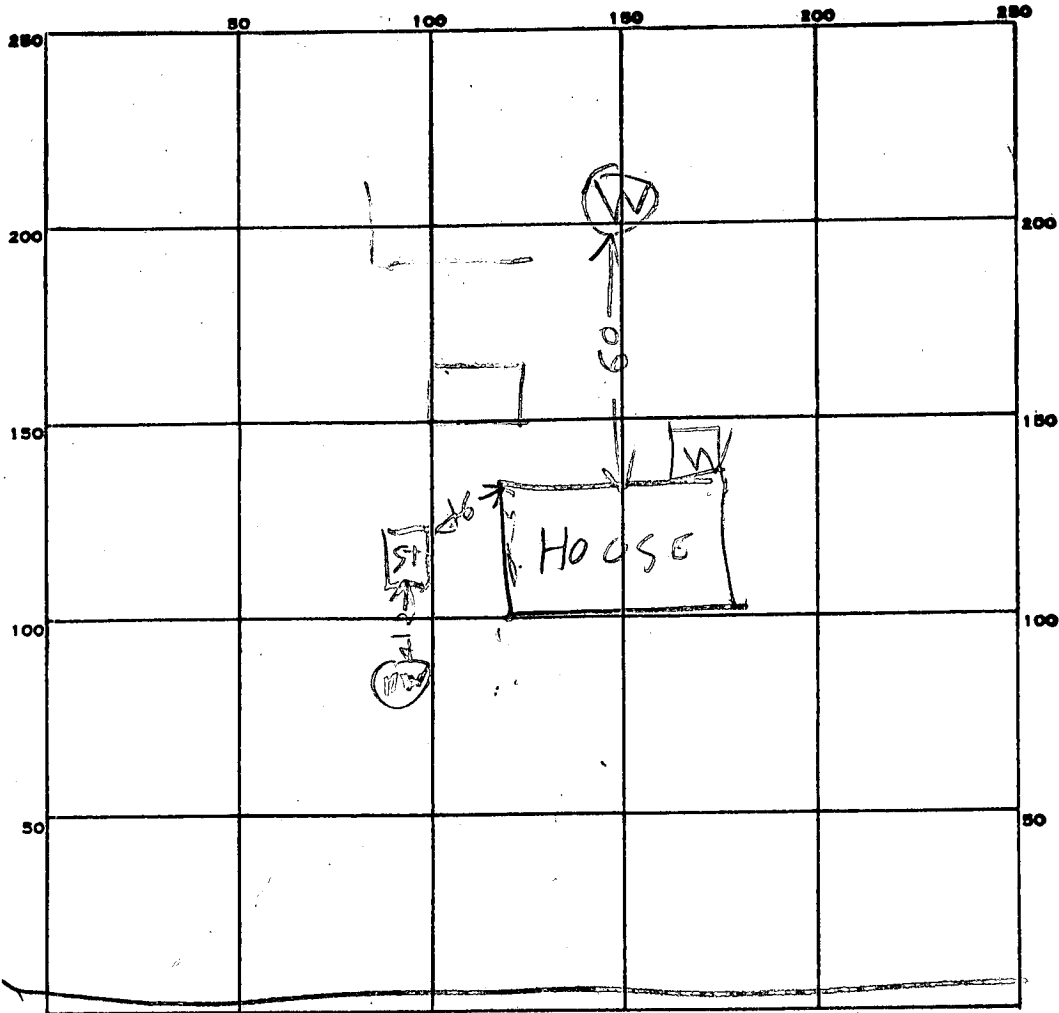

INDICATE NORTH - NAME ADJOINING ROADWAY AS BASE LINE.
 FREE TOWN RD

PERMIT CARD

SEPTIC TANK, LEVEL OK 1000 CEMENT CLEANOUTS OK

DISTRIBUTION BOX, LEVEL TOP 1 FT BELOW GRADE

TILE FIELD, DEPTH _____ FT. TRENCH WIDTH _____ FT.

GRAVEL DEPTH _____ IN. TOTAL LENGTH _____ FT.

NUMBER OF TRENCHES _____ TOTAL BOTTOM AREA _____

SEEPAGE PITS, INSIDE DIAMETER _____ FT. DEPTH BELOW INLET _____ FT.

ABSORBENT AREA _____ SQ. FT.

REMARKS 3/23/83 1100pm NEW TANK NOT YET ARRIVED RH

3/23/83 ^{100 FT} NEW TANK OK RH

DATE SYSTEM APPROVED 3/23/83

INSPECTOR Raymond Hodge