

APPROVED
4/12/83 RH
P 32645
A Repair

4/12/83
Around noon please

PERMIT

SEWAGE DISPOSAL SYSTEM

MARYLAND STATE DEPARTMENT OF HEALTH

HOWARD COUNTY

BUREAU OF ENVIRONMENTAL HEALTH
992-2330

ELLICOTT CITY

DISTRICT 3rd

DATE 4/11/83

INDEX

Jack Fyock IS PERMITTED TO INSTALL _____ ALTER X

ADDRESS 13775 ~~XXXXXX~~ Triadelphia Road, Glenelg, Md. 21737 PHONE 988-9270

SUBDIVISION Breezewood Farms ROAD 10631 Breezewood Drive LOT 6, Sec. 1

PROPERTY OWNER Jan Jewby

ADDRESS 10631 Breezewood Drive, Woodstock, Maryland 21163 Phone: 461-2209

IF GARBAGE GRINDER IS USED INCREASE SEPTIC TANK CAPACITY BY 50% AND ABSORPTION AREA BY 22%.

GARBAGE GRINDER? YES _____ NO ✓

SEPTIC TANK CAPACITY _____ GALLONS NUMBER OF BEDROOMS 3

REPAIR - Call for an appointment when ground is opened up and Sanitarian will recommend the repair system.

DEEP DITCH 70 FT LONG 2 FT WIDE
13 FT FT DEEP 5.5 FT STONE. DITCH
PUT DITCH IN FRONT YARD OFF
OLD DITCH OF 1970
360 SQ FT SIDEWALL AREA 1 SIDE
OK TO ADD STONE TO DITCH
BE CAUSE OF DANGER OF CAVE IN

PLANS APPROVED BY Palmer F. Wine DATE 4/4/83

COVER NO WORK UNTIL INSPECTED AND APPROVED.

NEITHER THE HOWARD COUNTY COUNCIL NOR THE HEALTH DEPARTMENT IS RESPONSIBLE FOR THE SUCCESSFUL OPERATION OF ANY SYSTEM.

NOTE: IF TRENCH IS USED CALL FOR INSPECTION BEFORE AND AFTER PLACING GRAVEL IN TRENCH.

NOTE: NO DRY WELL SHALL EXCEED 15 FOOT IN DIAMETER. NO ABSORPTION TRENCH TO EXCEED 100 FEET IN LENGTH.

NOTE: ALL PIPE FROM HOUSE TO SEPTIC TANK MUST BE CAST IRON OR SCHEDULE 40 PVC OR ABS.

PERMIT VOID AFTER THREE YEARS.

NOTE: INSTALL STAND PIPE ON SEPTIC TANK AND DRY WELL. STAND PIPES MUST BE 6 INCHES IN DIAMETER. CAST IRON, CONCRETE OR TERRA COTTA, OR PVC OR ABS ACCEPTED. IF TOP OF SEPTIC TANK IS DEEPER THAN 3 FEET MANHOLE TO GRADE REQUIRED.



BLDG. PERMIT SIGNED
AND RETURNED 5/20/83
Smith # 53870 -
addition 1 Bedroom
full basement.

*INSTALLER IS RESPONSIBLE FOR OBTAINING FINAL APPROVAL ON THIS PERMIT

*CALL 992-2330 FOR INSPECTION OF SEPTIC SYSTEMS. BLDG. PERMIT SIGNED

AND RETURNED 7/17/84
for pad # 60016

RH
32645

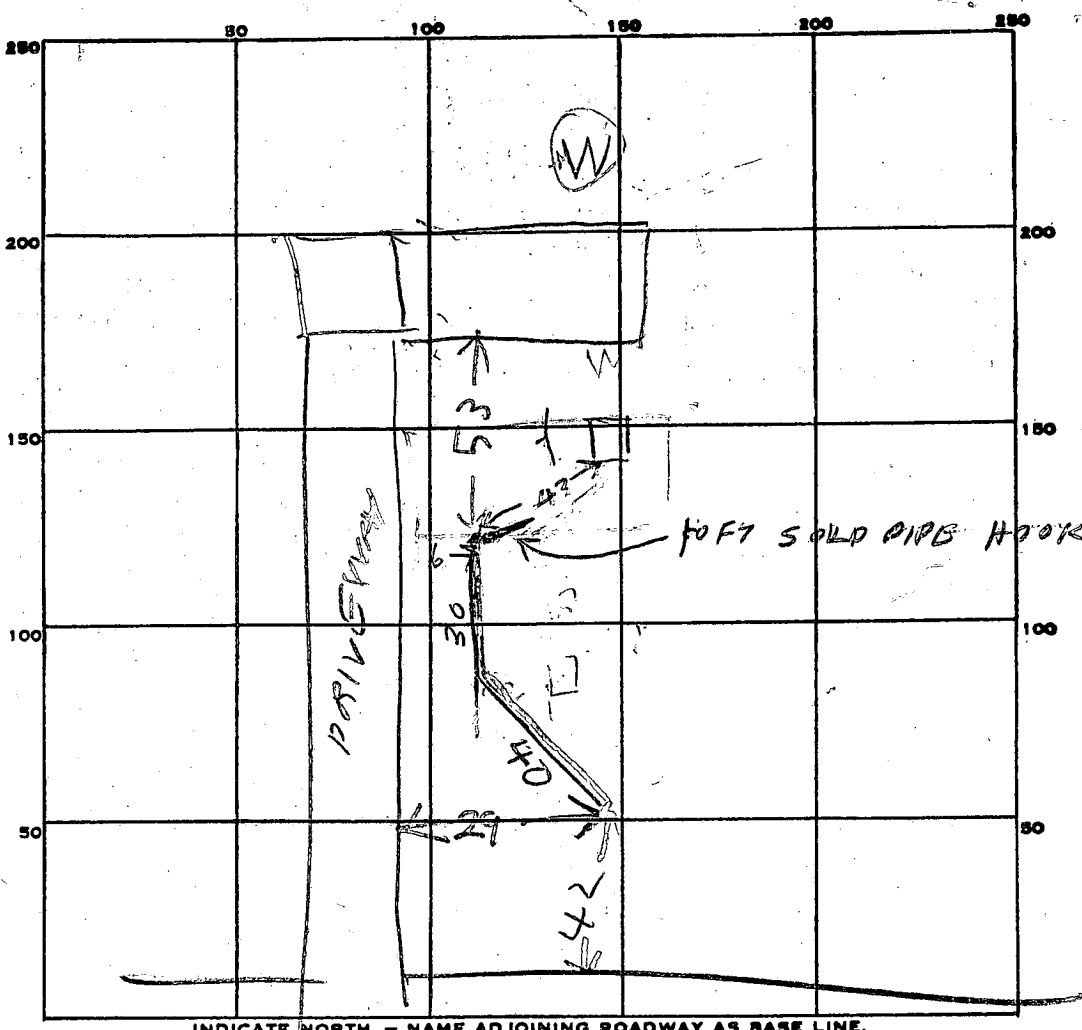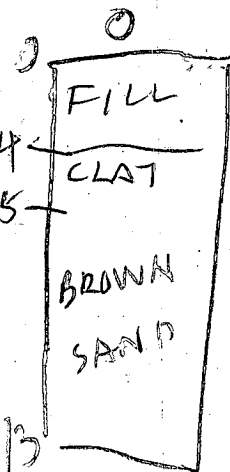

INDICATE NORTH. - NAME ADJOINING ROADWAY AS BASE LINE.
Breezewood Drive

PERMIT CARD _____

SEPTIC TANK, LEVEL _____ CLEANOUTS _____

DISTRIBUTION BOX, LEVEL _____

TILE FIELD, DEPTH 13 FT. TRENCH WIDTH 2 FT.

GRAVEL DEPTH 5 1/2 IN. TOTAL LENGTH 90 FT.

NUMBER OF TRENCHES 1 TOTAL BOTTOM AREA 385 ONE SIDE 10

SEEPAGE PITS, INSIDE DIAMETER _____ FT. DEPTH BELOW INLET _____ FT.

ABSORBENT AREA _____ SQ. FT.

REMARKS 4/12/83 AM - 40 FT 7 OF DITCH DUG 13 FT
DEEP SOME STONE ADDED. FINISH DITCH
@ ADD STONE
4/12/83 PM - DITCH FINISHED BR

DATE SYSTEM APPROVED 4/13/83 INSPECTOR Raymond Huber

PERMIT

P 10081

A 09390

SEWAGE DISPOSAL SYSTEM

MARYLAND STATE DEPARTMENT OF HEALTH

HOWARD COUNTY

ELLICOTT CITY

DISTRICT 3

DATE 4/26/65

INDEXED

*Partial
4/28/65
4/28/65
9/3/65
Check P.M.*

Hudson Construction Co. IS PERMITTED TO INSTALL ALTER

ADDRESS 363 Chapel Avenue, E. C. PHONE HO 5-2205

A SEWAGE DISPOSAL-SYSTEM LOCATED AT _____

SUBDIVISION Breezewood Farms ROAD Breezewood Dr. LOT 6, Sec. 1

PROPERTY OWNER Russell V. Beckett MRS. JUBY

ADDRESS _____

SPECIFICATIONS - 3 bedrooms

DRAIN FIELD _____ DEPTH _____ FEET, BOTTOM AREA _____ SQ. FT.

SEEPAGE PITS _____ ABSORBENT SIDE-WALL AREA _____ SQ. FT.

SEPTIC TANK CAPACITY 750 GALLONS

FOR GARBAGE GRINDER, INCREASE DISPOSAL AREA 22% & TANK CAPACITY 50%.

OTHER Leaching bed - 300 sq. ft. bottom area installed at a depth not exceeding 6 to 7 ft. including gravel (bottom of gravel). Place center of leaching bed 66 ft. from front lot line and 64 ft. from left side line as seen when facing lot from Breezewood Drive.

NOTE: CALL FOR INSPECTION OF LEACHING BED EXCAVATION BEFORE ANY GRAVEL IS INSTALLED.


PLANS APPROVED BY D. W. Monaghan DATE 11/21/64

FILL SEPTIC TANK AND DISTRIBUTION BOX WITH WATER BEFORE CALLING FOR AN INSPECTION. COVER NO WORK UNTIL INSPECTED AND APPROVED.

NEITHER THE HOWARD COUNTY COMMISSIONERS NOR THE HEALTH DEPARTMENT IS RESPONSIBLE FOR THE SUCCESSFUL OPERATION OF ANY SYSTEM.

*repair:
length 30'
depth 9'
stone 5' deep*

A 09390

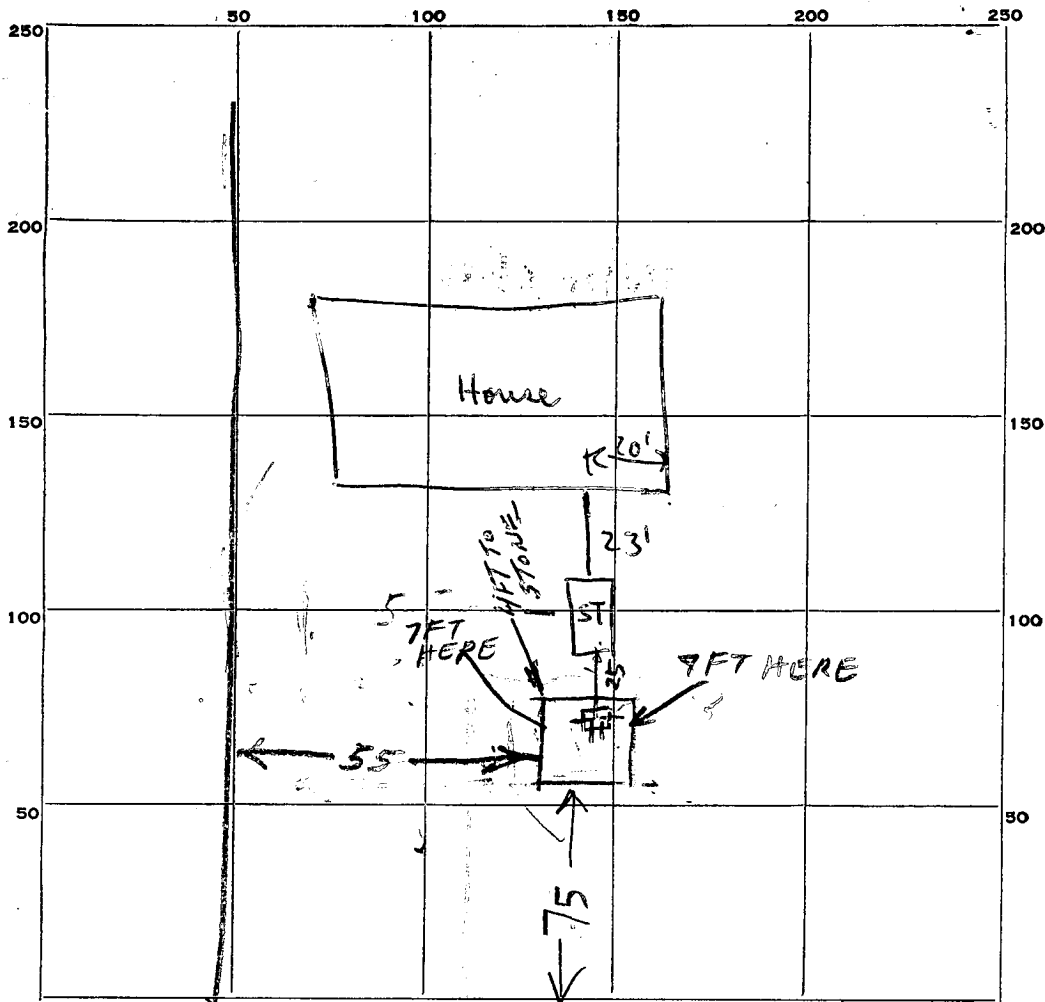

PERMIT CARD None Seen

SEPTIC TANK, LEVEL Concrete 100 gal CLEANOUTS 6" Sand pipe

DISTRIBUTION BOX, LEVEL Concrete - 4 outlets

bed TRENCH FIELD, DEPTH To Stone 4 FT. TRENCH WIDTH 16 FT.

GRAVEL DEPTH _____ IN. bed TOTAL LENGTH 23 1/2 FT.

NUMBER OF TRENCHES _____ bed TOTAL BOTTOM AREA OK

SEEPAGE PITS, INSIDE DIAMETER _____ FT. DEPTH BELOW INLET _____ FT.

ABSORBENT AREA _____ SQ. FT.

REMARKS 4/28/65 Partial - OK to cover ^{pipe} from home to septic tank
and half of septic tank - R. Fletcher

4/30/65

5-3-65 - Three ft. of stone in bed

DATE SYSTEM APPROVED 5-3-65

INSPECTOR J. Hennigan

4/30/70
before

File

PERMIT

Final OK
4/30/70
R. Turner
P 15171
A

SEWAGE DISPOSAL SYSTEM

MARYLAND STATE DEPARTMENT OF HEALTH

HOWARD COUNTY

INDEXED

ELLICOTT CITY

DISTRICT 3

DATE 4/20/70

William Jewby IS PERMITTED TO INSTALL _____ ALTER

ADDRESS Breezewood Drive, Woodstock, Maryland PHONE 328-2411

A SEWAGE DISPOSAL-SYSTEM LOCATED AT _____

SUBDIVISION Breezewood Farms ROAD Breezewood Dr. LOT 6, Sec. 1

10631
last house on left - dead end

PROPERTY OWNER same as above

ADDRESS Jan Jewby 461-2209

SPECIFICATIONS

DRAIN FIELD _____ DEPTH _____ FEET, BOTTOM AREA _____ SQ. FT.

SEEPAGE PITS _____ ABSORBENT SIDE-WALL AREA _____ SQ. FT.

SEPTIC TANK CAPACITY _____ GALLONS

FOR GARBAGE GRINDER, INCREASE DISPOSAL AREA 22% & TANK CAPACITY 50%.

OTHER REPAIR - 300 sq. ft. - trench - 30 ft. long, 9 ft. deep - stone 5 ft. deep.

bucket width. Located 25 ft. from left side toward center of lot and between tank and bed.


CALL FOR INSPECTION WHEN TRENCH IS DUG BEFORE ANY GRAVEL IS INSTALLED.

PLANS APPROVED BY F. Frommelt DATE 4/20/70

FILL SEPTIC TANK AND DISTRIBUTION BOX WITH WATER BEFORE CALLING FOR AN INSPECTION. COVER NO WORK UNTIL INSPECTED AND APPROVED.

NEITHER THE HOWARD COUNTY COMMISSIONERS NOR THE HEALTH DEPARTMENT IS RESPONSIBLE FOR THE SUCCESSFUL OPERATION OF ANY SYSTEM.

15171

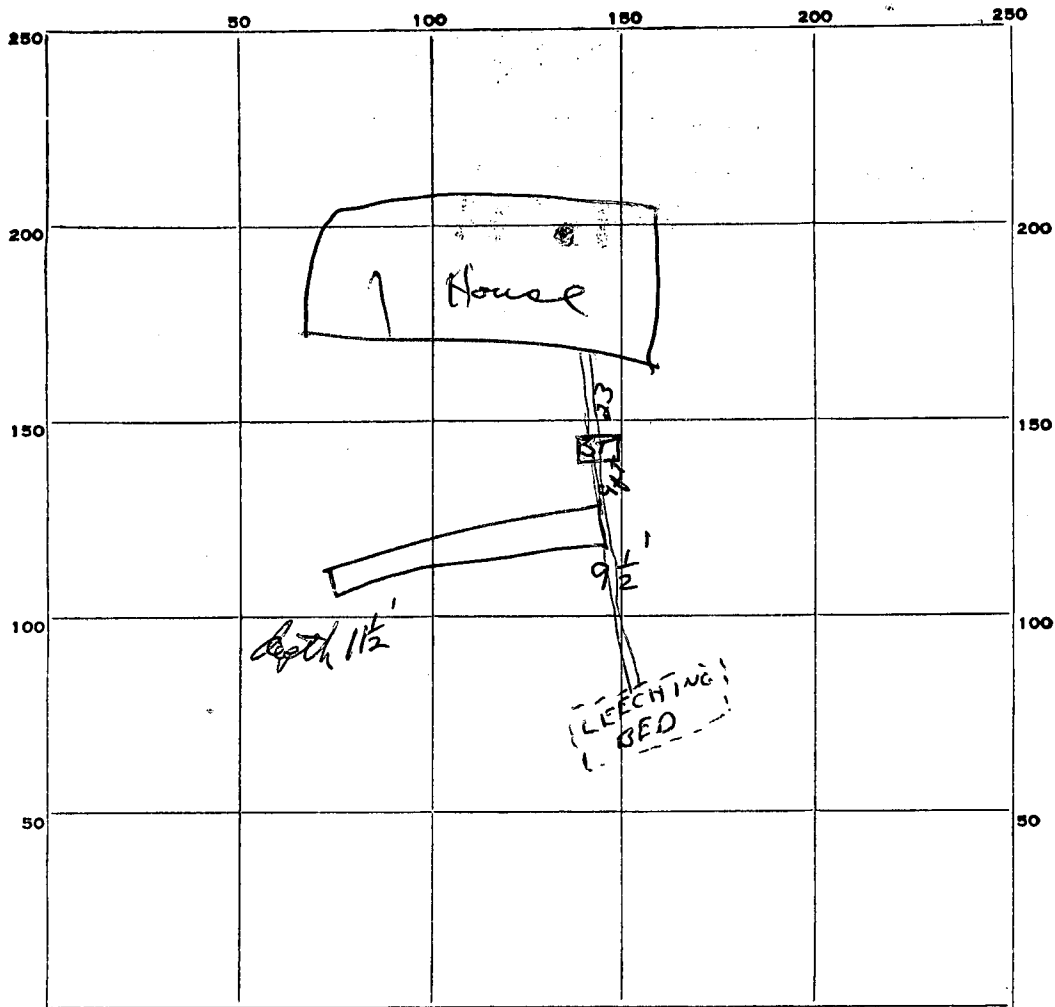

INDICATE NORTH. - NAME ADJOINING ROADWAY AS BASE LINE.

20
5 1/2
150
103
165
2
330

PERMIT CARD Signed

SEPTIC TANK, LEVEL _____ CLEANOUTS ok

DISTRIBUTION BOX, LEVEL _____

TILE FIELD, DEPTH 9 1/2 - 11 1/2 FT. TRENCH WIDTH 2 FT.

GRAVEL DEPTH 5 - 5 1/2 FT. TOTAL LENGTH 30 FT.

NUMBER OF TRENCHES 1 TOTAL Side wall BOTTOM AREA

SEEPAGE PITS, INSIDE DIAMETER _____ FT. DEPTH BELOW INLET _____ FT.

ABSORBENT AREA _____ SQ. FT.

REMARKS 4-30-70 partial ok, to install gravel

RECEIVED
HAWAII COUNTY
APR 30 10 33 AM '70
ENVIRONMENTAL
HEALTH DEPT.

DATE SYSTEM APPROVED 4/30/70 INSPECTOR R. Tane

APPLICATION

A 09888

SEWAGE DISPOSAL TESTING

P _____

MARYLAND STATE DEPARTMENT OF HEALTH

HOWARD COUNTY

ELLICOTT CITY

DISTRICT 3

DATE 3/31/65

TO: THE COUNTY HEALTH OFFICER
ELLICOTT CITY, MARYLAND

I, HEREBY, APPLY FOR THE NECESSARY TESTS IN ORDER TO CONSTRUCT (OR RECONSTRUCT) A SEWAGE DISPOSAL SYSTEM.

PROPERTY OWNER Russell V. Beckett

ADDRESS Woodstock, Maryland PHONE 328-2184

PROPERTY LOCATION:

SUBDIVISION Breezewood Farms LOT NO. 6, Sec. 1

ROAD AND DESCRIPTION Breezewood Drive off Woodstock Rd.

OCCUPANT _____ PHONE _____

PERSON TO CONSTRUCT SYSTEM _____

ADDRESS _____ PHONE _____

SIZE OF LOT 44,087 sq. ft. TYPE BLDG. 3
NUMBER OF BEDROOMS

IF NOT SINGLE RESIDENCE DESCRIBE _____

SIGNATURE OF APPLICANT Walter Leonard

APPROVED BY _____ FOR _____ DATE _____
(KIND OF SYSTEM)

REJECTED BY _____ FOR _____ DATE _____
(KIND OF SYSTEM)

HOLD PENDING FURTHER TESTS _____ DATE _____

REASONS FOR REJECTION OR HOLDING _____

THIS IS NOT A PERMIT

APPLICATION

A 09390

SEWAGE DISPOSAL TESTING

P _____

MARYLAND STATE DEPARTMENT OF HEALTH

HOWARD COUNTY

ELLICOTT CITY

Septic Tank - 750 gal.

DISTRICT 3

Leaching Bed. 300 sq ft bottom area

DATE 11/16/64

installed at a depth not exceeding 6 to 7 ft including gravel (bottom of gravel).

Place center of Leaching Bed 66 ft from front lot line and 64 ft from left sideline has seen culch facing east from Breezewood Drive

TO: THE COUNTY HEALTH OFFICER
ELLICOTT CITY, MARYLAND

I, HEREBY, APPLY FOR THE NECESSARY TESTS IN ORDER TO CONSTRUCT (OR RECONSTRUCT) A SEWAGE DISPOSAL SYSTEM.

PROPERTY OWNER Russell V. Beckett

ADDRESS Woodstock, Maryland PHONE 328-2184

PROPERTY LOCATION:

SUBDIVISION Breezewood Farms LOT NO. 6, Sec. 1

ROAD AND DESCRIPTION Breezewood Drive

OCCUPANT _____ PHONE _____

PERSON TO CONSTRUCT SYSTEM _____

ADDRESS _____ PHONE _____

SIZE OF LOT 44,087 sq. ft. TYPE BLDG. 3
NUMBER OF BEDROOMS

IF NOT SINGLE RESIDENCE DESCRIBE _____

SIGNATURE OF APPLICANT Madeline Leonard


APPROVED BY Rev. Monaghan FOR Leaching Bed DATE 11/24/64
(KIND OF SYSTEM)

REJECTED BY _____ FOR _____ DATE _____
(KIND OF SYSTEM)

HOLD PENDING FURTHER TESTS _____ DATE _____

REASONS FOR REJECTION OR HOLDING _____

THIS IS NOT A PERMIT

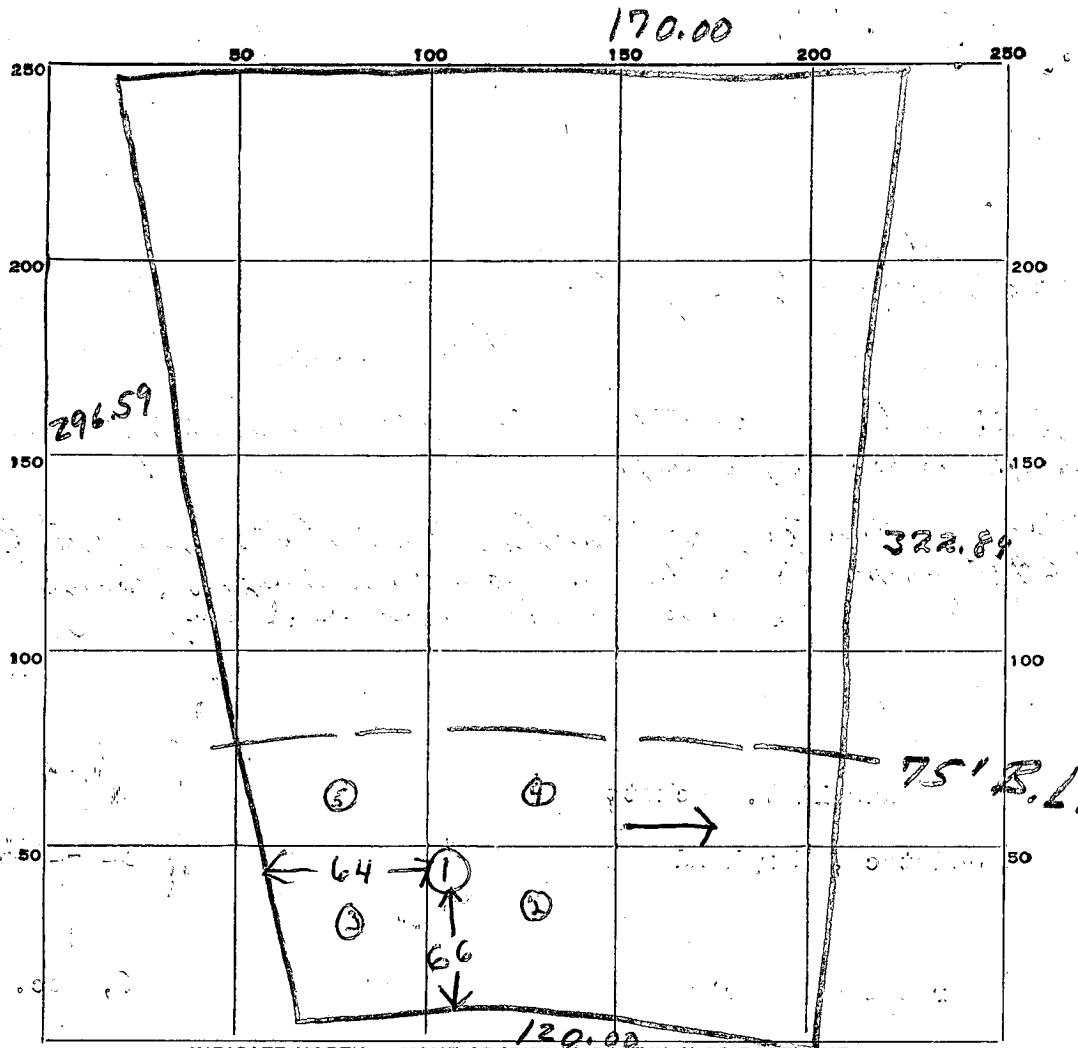

INDICATE NORTH. - NAME ADJOINING ROADWAY AS BASE LINE.

Breezewood Drive 130'

DATE	TEST NO.	DEPTH	PRE-WET		TEST - 1" DROP		TIME
			START	STOP	START	STOP	
11/24/64	1	11ft	1004	1006	1006	1010	4 min
	2	4ft	1010	1020	1020	1040	20 min
	3	3ft	1010	1012	1012	1017	5 min
	4	4ft	1013	1014	1014	1017	3 min
	5	4ft	1013	1016	1016	1022	6 min

SOIL AUGER FINDING

TESTED BY DWM - 11/24/64

REMARKS

ALSO PRESENT J. L. ... LOT NO. 6, Sec. 1

A 09390

APPLICATION MUST BE SUBMITTED AND PERMIT RECEIVED BEFORE DRILLING IS STARTED.

APPLICATION FOR PERMIT TO DRILL WELL

No. 251

Owner Hudson Construction Co.
Street or R. F. D. _____
Post Office Elliott City

Driller Ed. Brown License Number 177
Street or R. F. D. _____
Post Office R3 Mt. Airy
Date 4/26/65

Quantity of Water to be Produced 3 G.P.M.
Total Quantity Needed For Use 300 G.P.D.
Use for Water HOME
Approximate Depth of Well (feet) 100
Method of Drilling to be used Rotary

Location of Well
Subdivision Breeze Wind Sub.
Section _____ Lpt 6
County Howard
Nearest Town Woodstock
Distance from Town 1 mile
Direction from Town West

Is this a Replacement Well? Yes - No
If YES, indicate date abandoned well is to be sealed: _____
and by whom: _____

Description of Location of Well
(This information should be definite enough to permit locating well on a county map).
Near what road Breeze Wind Drive
On which side of road South
(North, East, South, West)
Distance from road 75 ft.

PERMIT TO DRILL WELL
(Not To Be Filled In By Driller)


Well Permit No. HO-65-W-419
Samples of Cuttings Required by Department: Yes No
Owner Requires Permit to Appropriate Water: Yes No
Owner Has Permit to Appropriate Water: Yes No

Appropriation Permit No. _____
The applicant is herewith granted a permit to drill this well subject to the conditions stipulated.
Paul W. McKee Director 4-28-65 Date

THIS PERMIT IS NOT TRANSFERRABLE
WITHOUT WRITTEN PERMISSION FROM THE DEPARTMENT
Special conditions that must be observed:

Health Department Approval of Application
Howard County Department of Health
or State Department of Health
Approved by _____
Title _____
Date 4/27/65

Draw a sketch below showing location of well in relation to nearby towns, roads and streams with north in the direction of the arrow, and give distance from well to nearest road junction or stream crossing shown on the sketch.

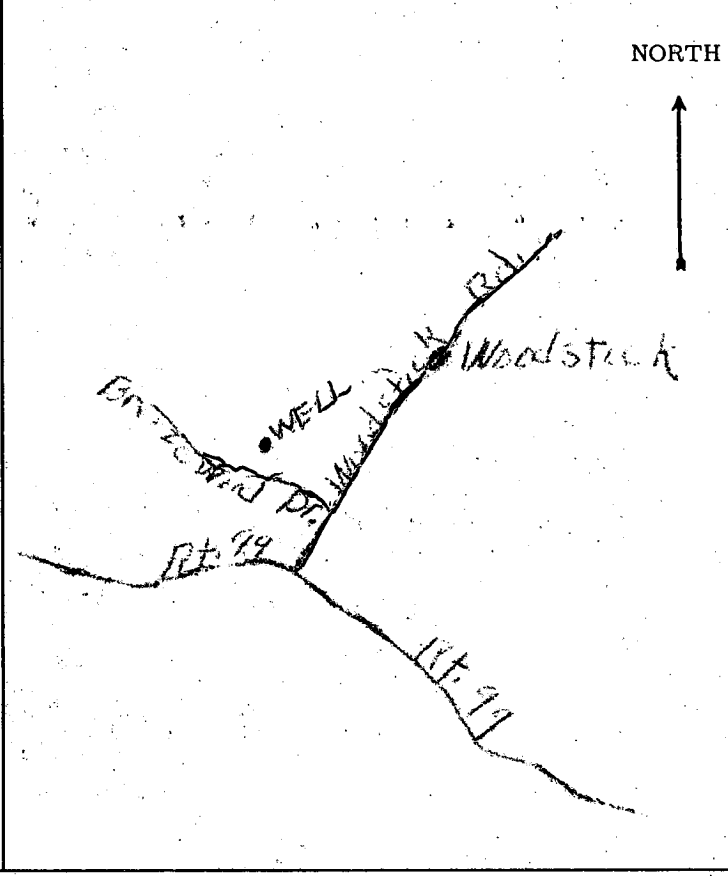

HOWARD COUNTY
MARYLAND STATE DEPARTMENT OF HEALTH
8 Church Road
ELLCOTT CITY, MARYLAND
WELL COMPLETION REPORT

This report must be submitted within 10 days after completion of the well.

This is to certify that the well which has been completed on the below property has been constructed and disinfected in compliance with the regulations and specifications of the State Board of Health.

The following construction and performance characteristics were noted:

1. Type, diameter and length of casing 6" o. D. Well Casing 31 ft.
2. Total depth of well 80 ft.
3. Type, diameter and length of strainer none. Size of screen openings _____
4. Method of sealing top and bottom of screen _____
5. Method of grouting Cement. Quantity, cement used 188 lbs.
Gals. water 10.
6. Standing water level (depth below ground surface when not pumping) 38 ft.
7. Yield of well in gallons per minute 4; elevation of water surface when pumped at the designated rate. _____
8. Number of hours pump operated at stipulated rate during pumping test 2.
9. Record of any other pumping performance none.
10. Log of materials encountered during drilling 4 ft. Clay 21 ft. Sand
+ gravel 49 ft. Mica Rock
11. Physical appearance of water at end of final pumping test clear
12. Variation in vertical alignment (how much the well casing varies from a truly plumb line) throughout its depth x
13. Disinfected by 2 ounces of Quarts % Chlorine (Brand name Clorox)

Property Owner Hudson Construction Co. Address Ellicott City Md.
Location of property Breezewood Sub. Woodstock Rd.

Health Department Number _____ Dept. of Water Resources Permit No. Ho-65-W-418


Date: 5/12/65, 1965. Ed. Brown
Signature of Well Driller

INSTRUCTIONS: This form is to be completed in duplicate and certified by the well driller upon completion of each drilled well. One copy will be forwarded to the property owner by the Health Department along with the final approval of the well.

GL ELEVATION:

DIRECTIONS:

I-695 (North)
TO STOP SIGN AT
A RIGHT ON BREZEWOOD DR.

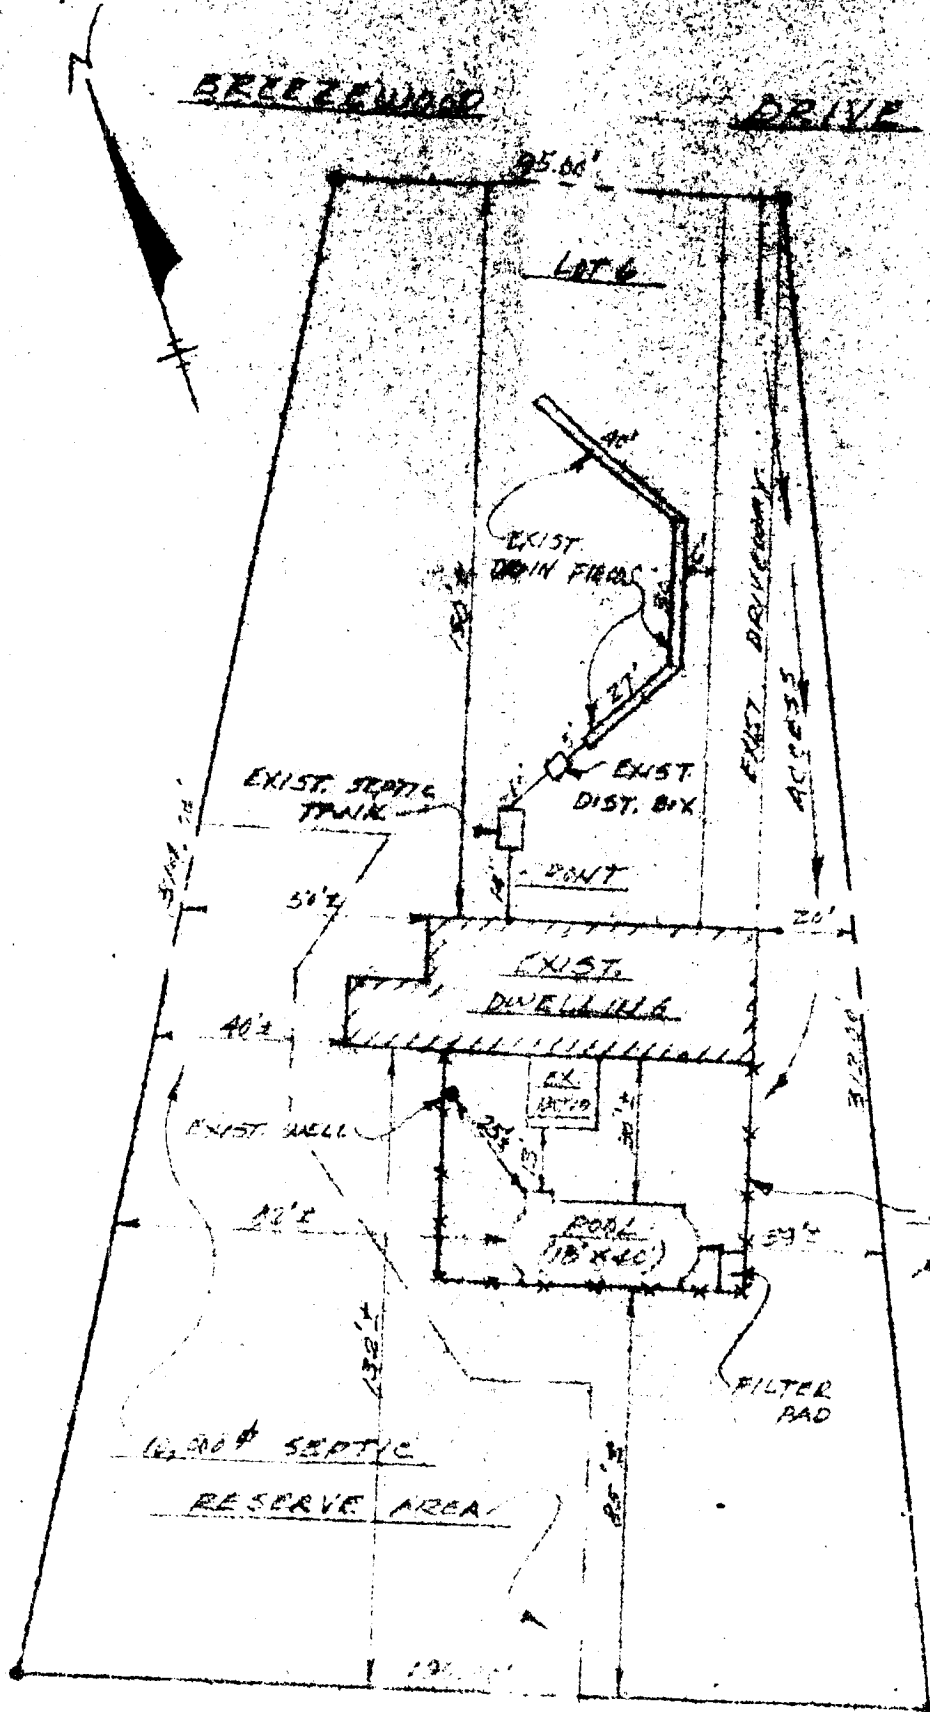

*7/17/84
sketch - OK to the Point
F.S.*

FENCE DATA:
4" HIGH POST AND RAIL FENCE
AS PER CODE (BY AREA)

NOTE: