

approved 6/7/83  
Stayed

6/7/83  
Around noon  
please

# PERMIT

P 32824

SEWAGE DISPOSAL SYSTEM

A REPAIR

MARYLAND STATE DEPARTMENT OF HEALTH\*

HOWARD COUNTY  
BUREAU OF ENVIRONMENTAL HEALTH  
992-2330

03-282708

ELLICOTT CITY

## INDEX

DISTRICT 3rd.

DATE 6/2/83  
5/26/83

Jack Fyock IS PERMITTED TO INSTALL \_\_\_\_\_ ALTER X

ADDRESS 13775 Triadelphia Road, Glenelg, Maryland 21737 PHONE 988-9270

SUBDIVISION Evergreen Valley ROAD 3114 Evergreen Way LOT 8, Sec 4

PROPERTY OWNER Herbert ~~Cross~~ Cross PHONE: 988-9349  
ADDRESS 3114 Evergreen Way

IF GARBAGE GRINDER IS USED INCREASE SEPTIC TANK CAPACITY BY 50% AND ABSORPTION AREA BY 22%.

GARBAGE GRINDER? YES \_\_\_\_\_ NO \_\_\_\_\_

SEPTIC TANK CAPACITY \_\_\_\_\_ GALLONS NUMBER OF BEDROOMS \_\_\_\_\_

REPAIR - CALL FOR INSPECTION WHEN GROUND IS OPENED UP SO SANITARIAN CAN RECOMMEND REPAIR.

6/6/83 ~~A09640~~ A09640 not in file 5.5.

PLANS APPROVED BY Frank Skinner DATE 5/26/83

COVER NO WORK UNTIL INSPECTED AND APPROVED.

NEITHER THE HOWARD COUNTY COUNCIL NOR THE HEALTH DEPARTMENT IS RESPONSIBLE FOR THE SUCCESSFUL OPERATION OF ANY SYSTEM.

NOTE: IF TRENCH IS USED CALL FOR INSPECTION BEFORE AND AFTER PLACING GRAVEL IN TRENCH.

NOTE: NO DRY WELL SHALL EXCEED 15 FOOT IN DIAMETER. NO ABSORPTION TRENCH TO EXCEED 100 FEET IN LENGTH.

NOTE: ALL PIPE FROM HOUSE TO SEPTIC TANK MUST BE CAST IRON OR SCHEDULE 40 PVC OR ABS.

PERMIT VOID AFTER THREE YEARS.

NOTE: INSTALL STAND PIPE ON SEPTIC TANK AND DRY WELL. STAND PIPES MUST BE 6 INCHES IN DIAMETER. CAST IRON, CONCRETE OR TERRA COTTA, OR PVC OR ABS ACCEPTED. IF TOP OF SEPTIC TANK IS DEEPER THAN 3 FEET MANHOLE TO GRADE REQUIRED.

**\*INSTALLER IS RESPONSIBLE FOR OBTAINING FINAL APPROVAL ON THIS PERMIT**

\*CALL 992-2330 FOR INSPECTION OF SEPTIC SYSTEMS.

EH - 2-1082

\* P32824



9/14/67  
LSD

P 12594  
A 09640

# PERMIT

SEWAGE DISPOSAL SYSTEM

MARYLAND STATE DEPARTMENT OF HEALTH

HOWARD COUNTY

ELLICOTT CITY

DISTRICT 3

## INDEXED

DATE 4/18/67

9/14/67  
Leady

Hudson Construction Company IS PERMITTED TO INSTALL X ALTER

ADDRESS 363 Chapel Avenue, Ellicott City, Md. PHONE HO 5-2205

A SEWAGE DISPOSAL SYSTEM LOCATED AT \_\_\_\_\_

SUBDIVISION Evergreen Valley Estates ROAD Evergreen Way LOT 8, Sec. 4

PROPERTY OWNER same as above

ADDRESS \_\_\_\_\_

SPECIFICATIONS - 4 bedrooms

DRAIN FIELD \_\_\_\_\_ DEPTH \_\_\_\_\_ FEET, BOTTOM AREA \_\_\_\_\_ SQ. FT.

SEEPAGE PITS \_\_\_\_\_ ABSORBENT SIDE-WALL AREA \_\_\_\_\_ SQ. FT.

SEPTIC TANK CAPACITY 1,000 GALLONS

FOR GARBAGE GRINDER, INCREASE DISPOSAL AREA 22% & TANK CAPACITY 50%.

OTHER 400 sq. ft. tile field.

Place tile field 166 ft. from front lot line and 45 ft. from right side line  
as seen when facing lot from Evergreen Way.

MAXIMUM DEPTH PERMITTED 4' below original grade.

PERMIT VOID AFTER THREE YEARS.


PLANS APPROVED BY J. Kilmore DATE 6/2/65

FILL SEPTIC TANK AND DISTRIBUTION BOX WITH WATER BEFORE CALLING FOR AN INSPECTION. COVER NO WORK UNTIL INSPECTED AND APPROVED.

NEITHER THE HOWARD COUNTY COMMISSIONERS NOR THE HEALTH DEPARTMENT IS RESPONSIBLE FOR THE SUCCESSFUL OPERATION OF ANY SYSTEM.

### NOTIFY THE HEALTH DEPARTMENT 48 HOURS BEFORE EXCAVATIONS ARE TO BE BACK FILLED.

09640

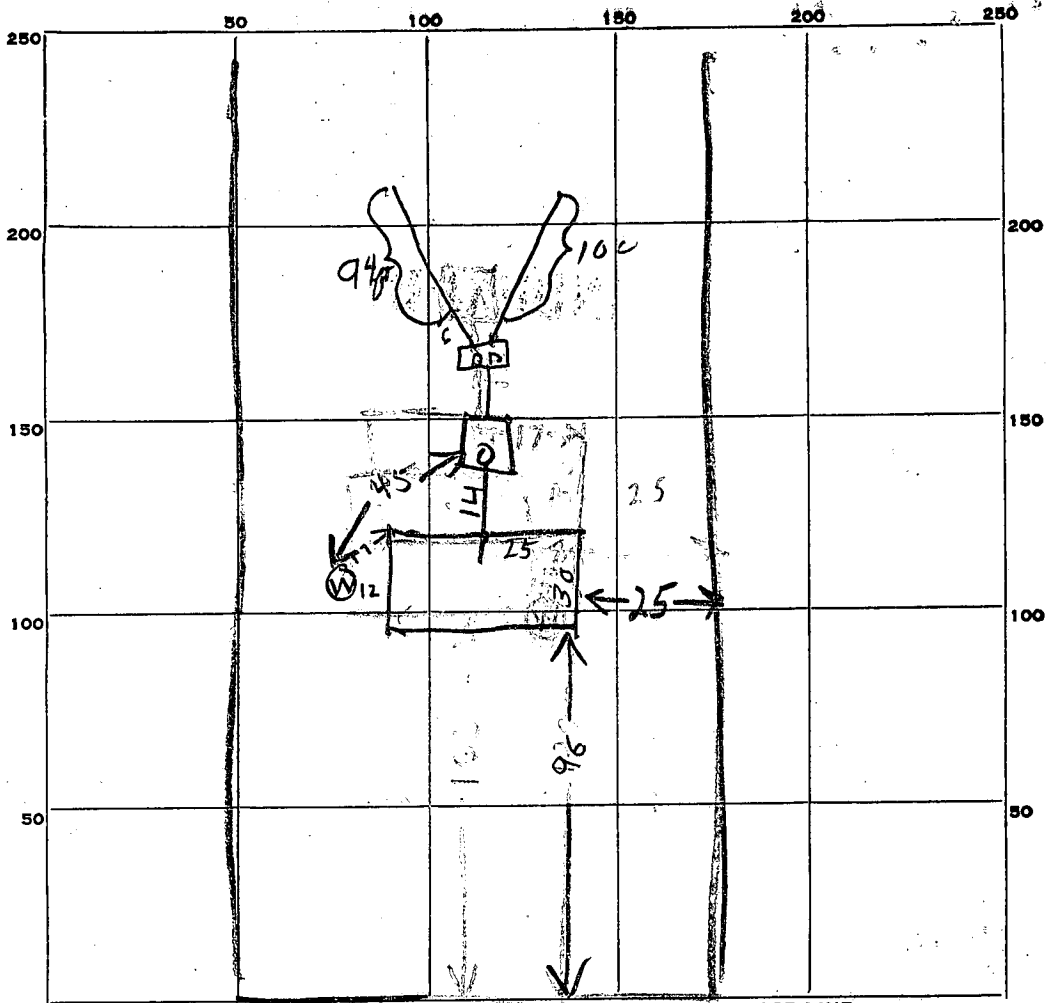

INDICATE NORTH. - NAME ADJOINING ROADWAY AS BASE LINE.

PERMIT CARD not

SEPTIC TANK, LEVEL OK 100 concrete CLEANOUTS OK  
Top 2 FT below grade  
 DISTRIBUTION BOX, LEVEL \_\_\_\_\_

TILE FIELD, DEPTH 4 FT. TRENCH WIDTH 2 FT.

GRAVEL DEPTH 18 IN. TOTAL LENGTH 200 FT.

NUMBER OF TRENCHES 2 TOTAL BOTTOM AREA 400

SEEPAGE PITS, INSIDE DIAMETER \_\_\_\_\_ FT. DEPTH BELOW INLET \_\_\_\_\_ FT.

ABSORBENT AREA \_\_\_\_\_ SQ. FT.

REMARKS 22 AUG 67 - Tank is OK & can be covered

DATE SYSTEM APPROVED 9/14/67 INSPECTOR W. J. [Signature]

# APPLICATION

A 09640  
P \_\_\_\_\_

SEWAGE DISPOSAL TESTING

MARYLAND STATE DEPARTMENT OF HEALTH

HOWARD COUNTY

ELLICOTT CITY

Septic Tank - 3 Bedrooms - 450 gal  
" " " " - 1000 gal

DISTRICT 3

DATE 2/17/65

Day well - 400 sq ft tile field below ~~in lot~~ per bedroom  
~~located 4 ft below grade~~

Place tile field 166 ft from front lot line and 45 ft from right  
sideline as seen when flying lot from Evergreen Way

TO: THE COUNTY HEALTH OFFICER  
ELLICOTT CITY, MARYLAND

*All charges P. J. W. - 4/18/67*

I, HEREBY, APPLY FOR THE NECESSARY TESTS IN ORDER TO CONSTRUCT (OR RECONSTRUCT) A SEWAGE DISPOSAL SYSTEM.

PROPERTY OWNER Hudson Construction Company, Inc.  
ADDRESS 363 Chapel Avenue, Ellicott City, Md. PHONE HO 5-2205

PROPERTY LOCATION:  
SUBDIVISION Evergreen Valley Estates LOT NO. 8 Sec. 4  
ROAD AND DESCRIPTION Evergreen Way

OCCUPANT \_\_\_\_\_ PHONE \_\_\_\_\_  
PERSON TO CONSTRUCT SYSTEM \_\_\_\_\_  
ADDRESS \_\_\_\_\_ PHONE \_\_\_\_\_

SIZE OF LOT 43,750 sq. ft. TYPE BLDG. 3 or 4  
NUMBER OF BEDROOMS

IF NOT SINGLE RESIDENCE DESCRIBE \_\_\_\_\_


SIGNATURE OF APPLICANT /s/ Madeline Leonardi

APPROVED BY J. Kilmore FOR Day Well DATE 6-2-65  
(KIND OF SYSTEM)  
REJECTED BY \_\_\_\_\_ FOR \_\_\_\_\_ DATE \_\_\_\_\_  
(KIND OF SYSTEM)

HOLD PENDING FURTHER TESTS \_\_\_\_\_ DATE \_\_\_\_\_

REASONS FOR REJECTION OR HOLDING \_\_\_\_\_

# THIS IS NOT A PERMIT

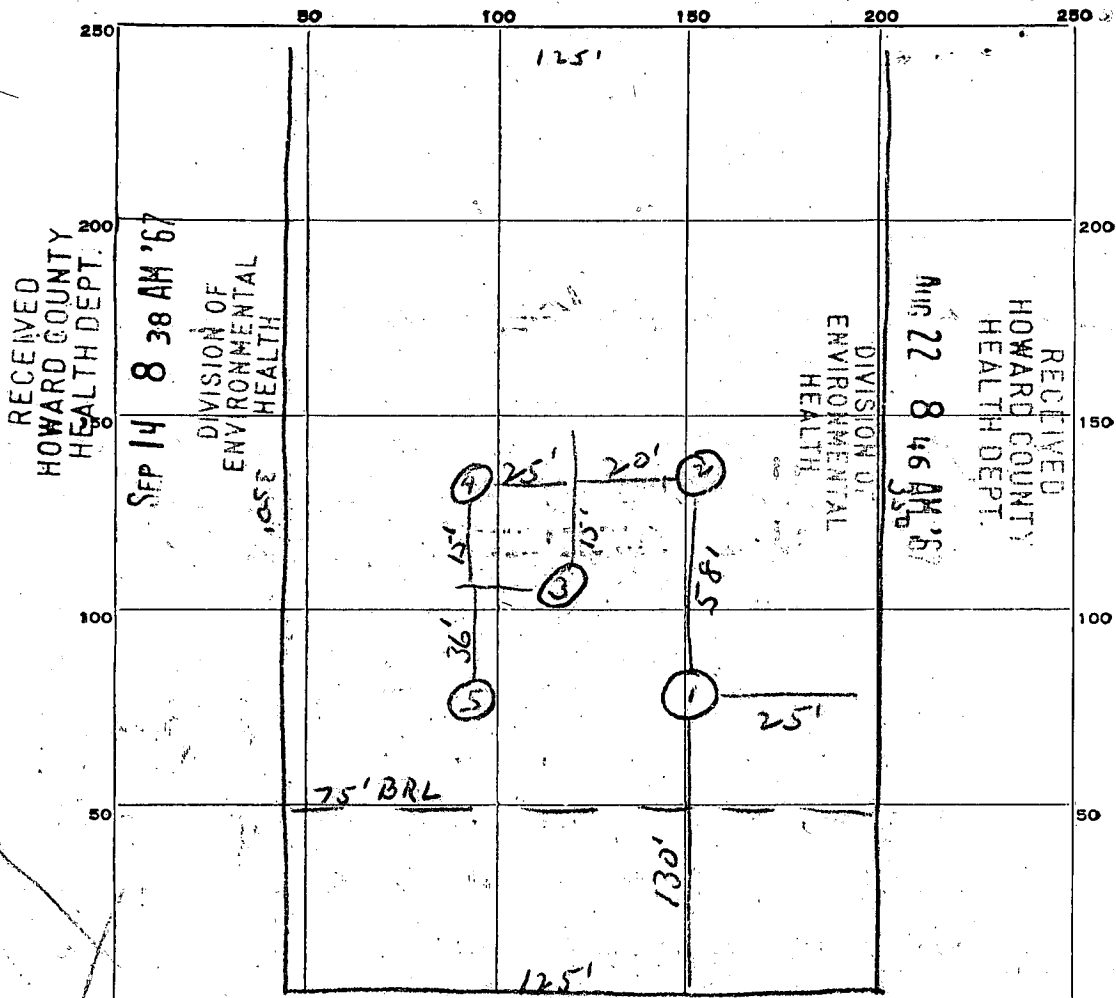

INDICATE NORTH. - NAME ADJOINING ROADWAY AS BASE LINE.

EVERGREEN WAY

DATE	TEST NO.	DEPTH	PRE-WET		TEST - 1" DROP		TIME
			START	STOP	START	STOP	
2/19/65	1	5'	11:17	11:25	11:25	11:34	9
"	2	5'	11:20	11:22	11:22	11:24	2
"	3	11'	11:32	11:33	11:33	11:35	2
"	4	5'	11:25	11:26	11:26	11:27	1
"	5	5'	11:27	11:30	11:30	11:34	4

SOIL AUGER FINDING \_\_\_\_\_

TESTED BY JHR

REMARKS \_\_\_\_\_

ALSO PRESENT D. Leonard

LOT NO. 8

10/5/79  
9:30 a.m.

FILE Repair Inspection (Septic) DATE REPORTED 10/2/79

PROPERTY OWNER Herbert Cross

P.O. ADDRESS 3114 Evergreen Way TELEPHONE h-988-9349

DIRECTIONS TO PROPERTY off-234-6363

Evergreen Valley Estates - Lot 8, Sec. 4

INFORMANT \_\_\_\_\_

recommend repair of septic system

CONDITION FOUND 10/5/79 - no sewage overflow seen - ground saturated.

odor of sewage in area - fill had been put over trenches due to dark green grass & wetness.

Recommend -

1. 2 trenches each 18" or 2' wide

" 60' long - 8' deep - with 4 ft

of stone

ACTION TAKEN or 2 trenches 100 ft long 18" or 2' wide - 9 ft deep

with 5 ft of stone; if no ground water at 12'

trenches to follow contour of ground - to be inspected before gravel is installed. - to call for inspection of 12' hole of dug.

To come off dirt bank with trench on line between bank & dirt bank

FINAL DISPOSITION \_\_\_\_\_