

APPLICATION

A 19535

SEWAGE DISPOSAL TESTING

P _____

STATE OF MARYLAND - DEPARTMENT OF HEALTH AND MENTAL HYGIENE

HOWARD COUNTY HEALTH DEPARTMENT
ENVIRONMENTAL HEALTH SERVICES
P. O. BOX 476, ELLICOTT CITY, MARYLAND 21043
TELEPHONE: 465-5000, EXT. 356

DISTRICT 5th

DATE 2/11/74

TO: THE COUNTY HEALTH OFFICER
ELLICOTT CITY, MARYLAND

I, HEREBY, APPLY FOR THE NECESSARY TEST IN ORDER TO CONSTRUCT (OR RECONSTRUCT) A SEWAGE DISPOSAL SYSTEM.

PROPERTY OWNER Frank F. Willson and Wife, Et Al

Any questions call Mr. Johnson:

ADDRESS c/o Ashton Realty Co., Ashton, Md. 20702

PHONE 924-4811

PROPERTY LOCATION:

SUBDIVISION Linden Chapel Hills

LOT NO. new 19 C
21, Blk. C, Sec. 4

ROAD AND DESCRIPTION argo Drive

SIZE OF LOT 67,680 sq. ft. ±

TYPE BLDG. 3 or 4 bedrooms

NUMBER OF BEDROOMS

IF NOT SINGLE RESIDENCE DESCRIBE _____

THE SYSTEM INSTALLED UNDER THIS APPLICATION IS ACCEPTABLE ONLY UNTIL PUBLIC FACILITIES BECOME AVAILABLE.

SIGNATURE OF APPLICANT /s/ Robert Johnson


✓ APPROVED BY Raymond Hodges FOR DRY WELL DATE 10/21/75
(KIND OF SYSTEM)

REJECTED BY _____ FOR _____ DATE _____
(KIND OF SYSTEM)

HOLD PENDING FURTHER TESTS _____ DATE _____

REASONS FOR REJECTION OR HOLDING _____

2911
THIS IS NOT A PERMIT

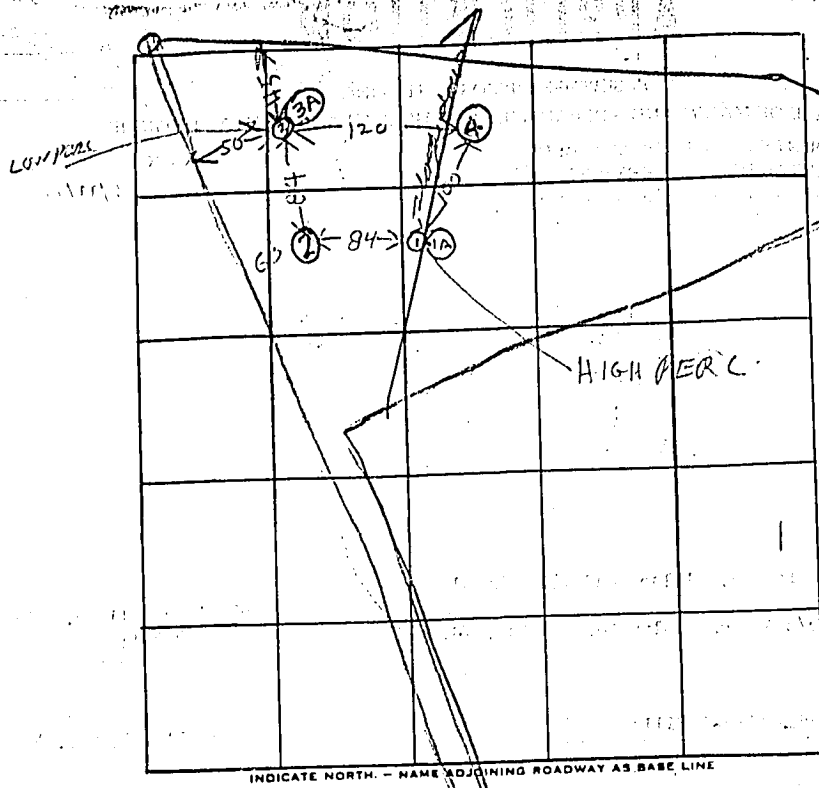

lot 21C
lot 19C

DATE	TEST NO.	DEPTH	PRE-WET		TEST - 1" DROP		TIME
			START	STOP	START	STOP	
	1	11"	1212	1213	1213	1215	2
	1A	3'	1212	1215	1215	1218	3
	2	11"	6000 SOIL				
	3	11"	1220	1222	1221	1225	3
	3A	3'	1220	1222	1222	1224	4
	4	11"	6000 SOIL				

no time
3 min
max depth
35'

REMARKS _____

TYPE OF SOIL _____

TESTED BY BRH-8/11/2 ALSO PRESENT: Exp. No. 1001.004