

INDEXED

A 31403 B

Click here for a plain text ADA compliant screen.

	Maryland Department of Assessments and Taxation HOWARD COUNTY Real Property Data Search	Go Back View Map New Search
---	--	---

Account Identifier: District - 04 Account Number - 308832

Owner Information

Owner Name:	VON BERG CHRISTIAN TRUSTEE VON BERG ODA TRUSTEE	Use:	RESIDENTIAL
Mailing Address:	14380 FREDERICK RD COOKSVILLE MD 21723-9514	Principal Residence:	NO
		Deed Reference:	1) / 4947/ 190 2)

Location & Structure Information

Premises Address	Zoning	Legal Description
14330 N FREDERICK RD COOKSVILLE 21723	RCDEO	.9375 A 14330 FREDERICK RD COOKSVILLE

Map	Grid	Parcel	Sub District	Subdivision	Section	Block	Lot	Group	Plat No:
8	23	178						81	Plat Ref:

Special Tax Areas	Town Ad Valorem Tax Class	NO A/V, NO M/P, RURAL FIRE TAX
--------------------------	---------------------------	--------------------------------

Primary Structure Built	Enclosed Area	Property Land Area	County Use
1940	946 SF	40,815.00 SF	

Stories	Basement	Type	Exterior
1 1/2	YES	STANDARD UNIT	ASBESTOS SHINGLE

Value Information

	Base Value	Value		
		As Of 01/01/2002	As Of 07/01/2002	As Of 07/01/2003
Land:	77,940	107,350		
Improvements:	44,210	48,890		
Total:	122,150	156,240	133,513	144,876
Preferential Land:	0	0	0	0

Transfer Information

Seller: 05411661CHRISTIAN	Date: 11/22/1999	Price: \$0
Type: NOT ARMS-LENGTH	Deed1: / 4947/ 190	Deed2:
Seller: ARTER E E ET AL	Date: 10/21/1996	Price: \$67,000
Type: NOT ARMS-LENGTH	Deed1: / 3838/ 303	Deed2:
Seller:	Date:	Price:
Type:	Deed1:	Deed2:

Exemption Information

Partial Exempt Assessments	Class	07/01/2002	07/01/2003
County	000	0	0
State	000	0	0
Municipal	000	0	0

Tax Exempt: NO	Special Tax Recapture:
Exempt Class:	* NONE *

A 31403 B

Date Received (WRA use only) _____ DATE WELL COMPLETED **12-1-98** MAP & PARCEL **178** PERMIT NO. FROM "PERMIT TO DRILL WELL" **410-73-3955**
 Depth of Well **85** (TO NEAREST FOOT)

OWNER **Arter** last name **E. E.** first name
 STREET OR RFD **14330 Fredrick Rd.** TOWN **Cooksville**
 SUBDIVISION _____ SECTION _____ LOT _____

WELL LOG
 Not required for driven wells
 STATE THE KIND OF FORMATIONS PENETRATED, THEIR COLOR, DEPTH, THICKNESS AND IF WATER BEARING

DESCRIPTION (Use additional sheets if needed)	FEET		Check if water bearing
	FROM	TO	
Brown Shale	0	23	
Gray granite	23	85	✓

GROUTING RECORD
 WELL HAS BEEN GROUTED YES NO
 TYPE OF GROUTING MATERIAL
 CEMENT BENTONITE CLAY
 NO. OF BAGS **5** NO. OF POUNDS **47**
 GALLONS OF WATER **30**
 DEPTH OF GROUT SEAL (to nearest foot) from **0** ft. to **21** ft.
 (enter 0 if from surface)

CASING RECORD
 casing types insert appropriate code below
 ST STEEL CO CONCRETE
 PL PLASTIC OT OTHER
 MAIN CASING TYPE **SH** Nominal diameter top (main) casing (nearest inch) **6** Total depth of main casing (nearest foot) **26**

OTHER CASING (if used)
 diameter inch _____ depth (feet) from _____ to _____

SCREEN RECORD
 screen type or openhole insert appropriate code below
 ST STEEL BR BRASS BRONZE HO OPEN HOLE
 PL PLASTIC OT OTHER


C2 (seq. no.)
 DEPTH (nearest ft.)
 1 **HO** **24** **85**
 2 _____
 3 _____
 SLOT SIZE _____
 DIAMETER OF SCREEN _____ (NEAREST INCH)
 from _____ to _____

GRAVEL PACK _____
 IF WELL DRILLED WAS FLOWING WELL CIRCLE BOX

WRA USE ONLY (NOT TO BE FILLED IN BY DRILLER)
 T (E.R.O.S.) _____ W Q _____
 TELESCOPE CASING _____ LOG INDICATOR _____ OTHER DATA _____

C3 (seq. no.)
PUMPING TEST
 HOURS PUMPED (nearest hour) **2**
 PUMPING RATE (gal. per min. to nearest gal.) **10**
 METHOD USED TO MEASURE PUMPING RATE **Alt**
 WATER LEVEL (distance from land surface) BEFORE PUMPING **20** WHEN PUMPING **40**
 TYPE OF PUMP USED (for test)
 A air P piston T turbine
 C centrifugal R rotary O other (describe below)
 J jet S submersible

PUMP INSTALLED YES NO
 DRILLER WILL INSTALL PUMP (CIRCLE APPROPRIATE BOX) YES NO
 IF DRILLER INSTALLS PUMP, THIS SECTION MUST BE COMPLETED FOR ALL WELLS EXCEPT HOME USE
 TYPE OF PUMP (WRITE APPROPRIATE LETTER IN BOX - SEE ABOVE: (A, C, J, P, R, S, T, O))
 CAPACITY: GALLONS PER MINUTE (to nearest gallon) _____
 PUMP HORSE POWER _____
 PUMP COLUMN LENGTH (nearest ft.) _____
 CASING HEIGHT (circle appropriate box and enter casing height)
 above LAND SURFACE
 below **2** (nearest foot)

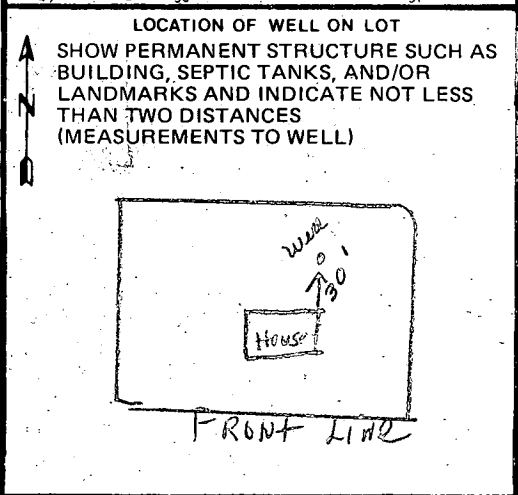

- CIRCLE APPROPRIATE BOX
 A A WELL WAS ABANDONED AND SEALED WHEN THIS WELL WAS COMPLETED
 E ELECTRIC LOG OBTAINED
 P TEST WELL CONVERTED TO PRODUCTION WELL

I HEREBY CERTIFY THAT I HAVE COMPLIED WITH ALL CONDITIONS STATED ON THE ABOVE-CAPTIONED "PERMIT TO DRILL WELL", AND THAT INFORMATION CONTAINED IN THIS REPORT IS TRUE, ACCURATE, AND COMPLETE TO THE BEST OF MY KNOWLEDGE, INFORMATION AND BELIEF.
 DRILLERS IDENT. NO. **238**
 DRILLERS SIGNATURE **Joseph R. Maize**
 SITE SUPERVISOR (sign. of driller or journeyman responsible for sitework if different from permittee) _____

B 1 **11831** SEQUENCE NO. WRA USE ONLY
(THIS NUMBER IS TO BE PUNCHED IN COLS. 3-6 ON ALL CARDS)


STATE OF MARYLAND
APPLICATION FOR PERMIT TO DRILL WELL

WRA PERMIT NUMBER
HO-73-3955
fill in this form completely

DATE RECEIVED 5/27/81
8 (WRA USE ONLY) 13
OWNER INFORMATION
Arter E. E.
LAST NAME OWNER FIRST NAME
14330 Frederick Rd.
36 STREET OR RFD 55
Cooksville Md.
TOWN 57 STATE 76 ZIP


B 3 85 LOCATION OF WELL
1 2 3 100
COUNTY Howard
SUBDIVISION _____
SECTION 44 LOT 46
NEAREST TOWN Cooksville
MILES FROM TOWN (enter 0 if in town) 0 **MI**

B 1 CONTINUED **DRILLER INFORMATION**
Joseph L. Mayne 238
DRILLER'S NAME 77 LICENSE NO. 80
Joseph L. Mayne May 27, 81
SIGNATURE DATE

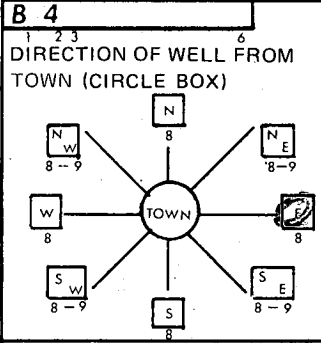

MD. 144
11 NEAR WHAT ROAD 30
ON WHICH SIDE OF ROAD (CIRCLE APPROPRIATE BOX) NORTH WEST EAST SOUTH
75
34 DISTANCE FROM ROAD (CIRCLE APPROPRIATE BOX) 37 **FT**
38 39

B 2 **WELL INFORMATION**
1 2 3 100
APPROX. PUMPING RATE (GAL. PER MIN) 5
AVERAGE DAILY QUANTITY NEEDED (GAL. PER DAY) 750

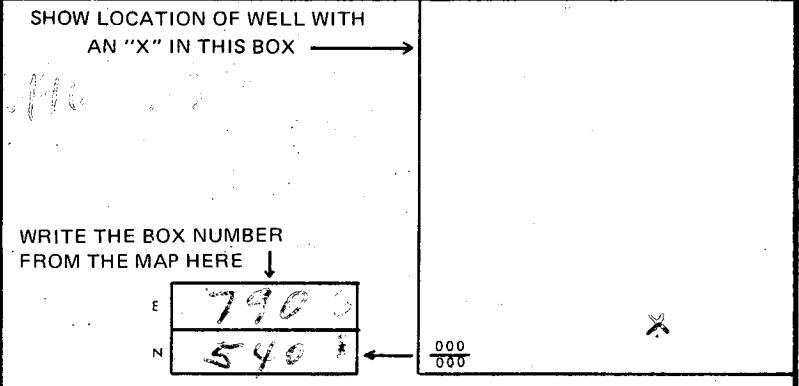


USE FOR WATER (CIRCLE APPROPRIATE BOX)
 HOME (SINGLE OR DOUBLE HOUSEHOLD UNIT ONLY)
 FARMING (LIVESTOCK WATERING & AGRICULTURAL IRRIGATION)
 INDUSTRIAL, COMMERCIAL, STATE AND FEDERAL GOV. OTHER (REQUIRES APPROPRIATION PERMIT)
 PUBLIC OR PRIVATE WATER COMPANY (REQUIRES APPROPRIATION PERMIT AND STATE HEALTH DEPARTMENT APPROVAL)
 TEST, OBSERVATION, MONITORING (MAY REQUIRE APPROPRIATION PERMIT)

APPROXIMATE DEPTH OF WELL 120 FEET
APPROXIMATE DIAMETER OF WELL 6 INCH

Method of Drilling (circle one)
 BORED (OR AUGERED) JETTED JETTED & DRIVEN
 AIR ROTARY AIR PERCUSSION ROTARY (HYDRAULIC)
 CABLE REVERSE ROTARY DRIVE POINT ROTARY
other _____

REPLACEMENT OR DEEPEMED WELLS
(Circle Appropriate Box)
 THIS WELL WILL NOT REPLACE AN EXISTING WELL
 THIS WELL WILL REPLACE A WELL THAT WILL BE ABANDONED AND SEALED
 THIS WELL WILL REPLACE A WELL THAT WILL BE USED AS A STANDBY
 THIS WELL WILL DEEPEM AN EXISTING WELL
PERMIT NUMBER OF WELL TO BE REPLACED OR DEEPEMED (IF AVAILABLE) 41 _____ 52

Not to be filled in by driller (WRA USE ONLY)
APPROX. PERMIT NUMBER GAP
FORCE INITIALS IN BOX ES CONDITIONS HO-73-3955
A E N S G W Q C L U
70 71 72 73 74 75 76 77 78 79

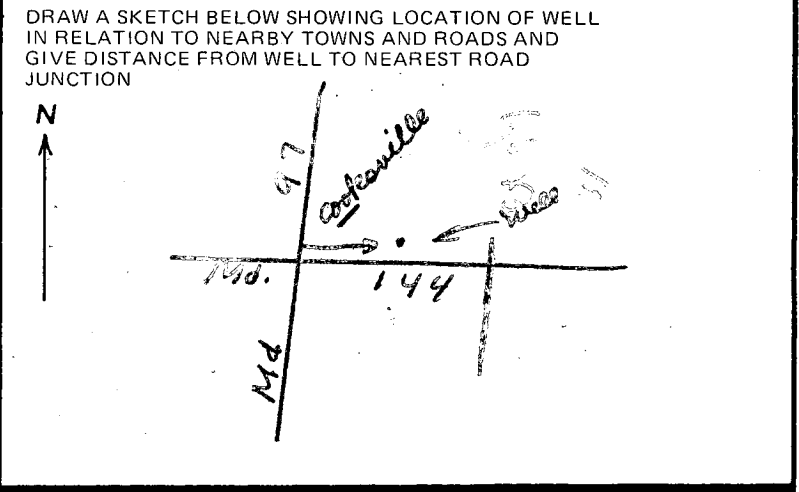

B 4 NOT TO BE FILLED IN BY DRILLER HEALTH DEPARTMENT APPROVAL
COUNTY NAME Howard COUNTY NO. A31403
EHA SIGNATURE _____ STATE HEALTH CIRCLE BOX
MO DAY YR 05 25 81 Frank Skinner, Sanitarian
CO SIGNATURE Joseph L. Mayne DATE _____
NORTH 541 EAST 0796 ELEV. (FT.) _____
GRID 50 55 GRID 57 63 65 68

B 5 SPECIAL CONDITIONS (WRA USE ONLY)
1 2 3 100

6/1/81 9:30 A.M.

Keep in file

FILE Emergency Well Site

DATE REPORTED 5/25/81

PROPERTY OWNER Edward Arter

P.O. ADDRESS 14330 Fredrick Rd


TELEPHONE 489-4043

DIRECTIONS TO PROPERTY 2nd house past Full Gospel Tabernacle Church on left side of road heading west EAST.

INFORMANT Mr. Arter requests a well site, his present well is running out of water

CONDITION FOUND Talked with Rev. Arter - hand dug well going dry. HO-73-3955

5/25/81 JS & SK

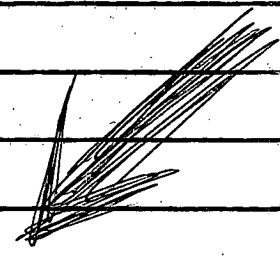


ACTION TAKEN Well site location:

20 32

5 2 3

RT 144

septic system

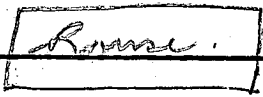

old well

septic



new well location

6/1/81

5 Bags of Cement

26" Well casing

21' Well shaft

FINAL DISPOSITION

(1) rock @ 12'-18' per LARRY MAYNE

(2) EMERGENCY SITUATION WELL YIELD 10 GAL/MIN

[2 1/2' casing above ground @ ground]

[Well in area called]