

APPLICATION

PERCOLATION TESTING

A 39250

P _____

HOWARD COUNTY HEALTH DEPARTMENT
BUREAU OF ENVIRONMENTAL HEALTH
P.O. BOX 476 ELLICOTT CITY, MARYLAND 21043
TELEPHONE 461-9933

DISTRICT 5

DATE 4-16-87

TO: THE COUNTY HEALTH OFFICER
ELLICOTT CITY, MARYLAND

I, HEREBY, APPLY FOR THE NECESSARY TEST IN ORDER TO CONSTRUCT (OR RECONSTRUCT) A SEWAGE DISPOSAL SYSTEM.

PROPERTY OWNER RAO GROUP Inc L.R. Nimmagadda - 301-461-1763

ADDRESS 6570 Rt 32 Clarksville, MD PHONE 854-0809

PROSPECTIVE BUYER RAO GROUP Inc

ADDRESS 6570 Rt 32 Clarksville MD PHONE 854-0809

PROPERTY LOCATION: _____

SUBDIVISION CLOVENGER PROPERTY LOT NO. 15 P-8712
16

ROAD AND DESCRIPTION C 5909 Ten Oaks Rd Clarksville
5912 Clifton Oak Drive

TAX MAP 34 PARCEL # 3

SIZE OF LOT 3.0 AC TYPE BLDG Single Family
(SINGLE FAMILY DWELLING OR COMMERCIAL)

THE SYSTEM INSTALLED UNDER THIS APPLICATION IS ACCEPTABLE ONLY UNTIL PUBLIC FACILITIES BECOME AVAILABLE. I FULLY UNDERSTAND THE FEE CONNECTED WITH THE FILING OF THIS PERC TEST APPLICATION IS NON-REFUNDABLE UNDER ANY CIRCUMSTANCES. I ALSO AGREE TO COMPLY WITH ALL M.O.S.H.A. REQUIREMENTS IN TESTING THIS LOT.

(Signature)

(SIGNATURE OF APPLICANT)

APPROVED BY _____ FOR _____ DATE _____

REJECTED BY _____ FOR _____ DATE _____

HOLD PENDING FURTHER TESTS _____ DATE _____


REASONS FOR REJECTION OR HOLDING 6-26-87 Perc Satisfactory; 1600 for subdivision plat, check

House + well size carefully; SAW

BLDG. PERMIT SIGNED
AND RETURNED 5/4/89
Serial # 27879
SFD - 4 Bedrooms

THIS IS NOT A PERMIT

LOT 15

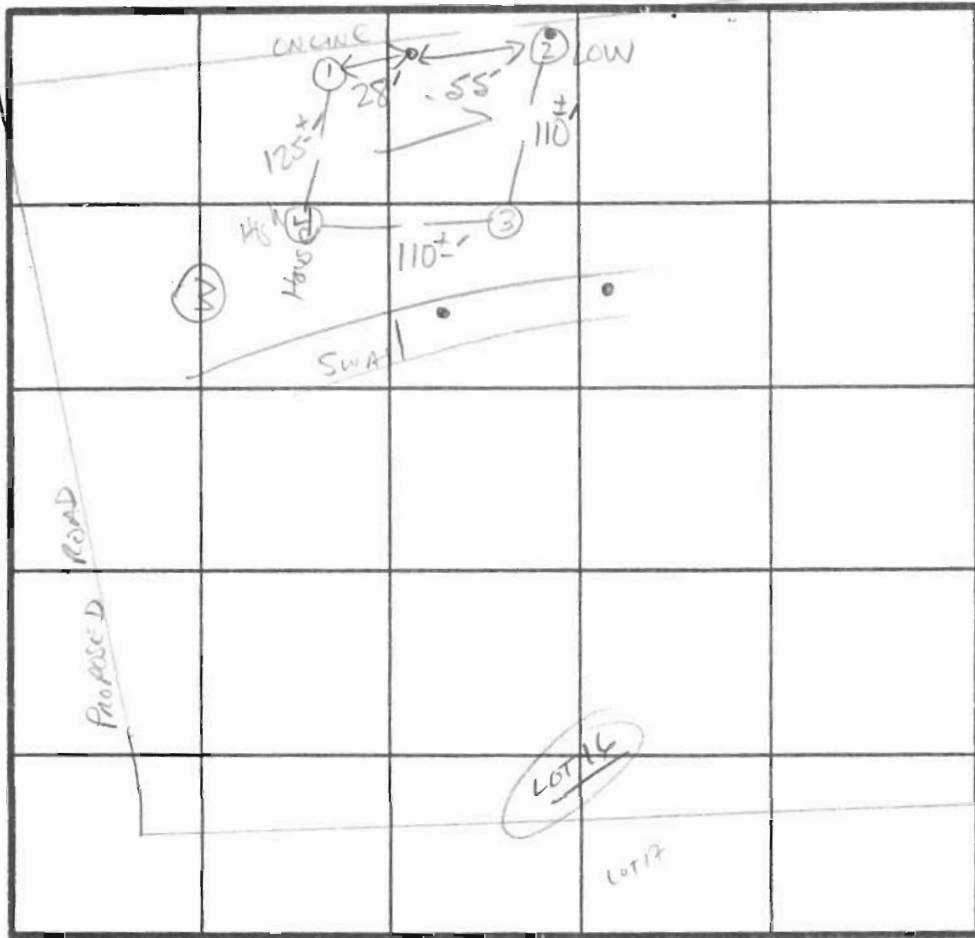

APPROX 5 MIN
180' DIA
INLET BOTTOM
3.5
L.O. S.S

① → ④
SOIL PROFILE

0'
AP HW
SM-SANDS

10'
Yellow CLAY
SILT CLAY
10-15% FINE

2.0-3.5-4'
Yellow BA
TO yellow
RD SH
WANT
Highly
micaceous

12.5-13'

INDICATE NORTH - NAME ADJOINING ROADWAY AS BASE LINE.

TENOAKS Rd.

DATE	TEST NO.	DEPTH	PRE-WET		TEST - 1" DROP		TIME
			START	STOP	START	STOP	
6/24/67	1V	12.5'	Uniform Soil below 3.5'				
	2S	2.5'	10:27	10:29	10:29	10:33	4 min
	2V	13.0'	Uniform Soil below 2.0'				
	3S	6"	10:28	10:30	10:30	10:34	4 min
	3V	13.0'	Uniform Soil below 5.0'				
	4S	6"	10:30	10:34	10:34	10:37	3 min
	4M	8"	10:34	10:39	10:39	10:48	9 min
	4V	13'	Uniform Soil below 6.0'				

REMARKS HOLES DIFF THAN PLAN - MINOR WHITE - Shallow Syst. only

TYPE OF SOIL MAND

TESTED BY S. Abel ALSO PRESENT SKIP, STEWART

EH-12-1079