

Approved: 12/31/80
Stephen Kiel
P 31090

PERMIT

A REPAIR

SEWAGE DISPOSAL SYSTEM

MARYLAND STATE DEPARTMENT OF HEALTH*

HOWARD COUNTY

05-366594

ELLICOTT CITY

DISTRICT 5th.

INDEXED

DATE 12/23/80

Jack Fyock

IS PERMITTED TO INSTALL ALTER

ADDRESS _____ PHONE _____

SUBDIVISION _____ ROAD 6702 Montell Drive LOT _____

PROPERTY OWNER Hollis Shenk

ADDRESS 6702 Montell Drive, Highland, Maryland

SPECIFICATIONS

SEPTIC TANK CAPACITY _____ GALLONS
DRAIN FIELD _____ DEPTH _____ FEET. BOTTOM AREA _____ SQ. FT.
DEEP TRENCH _____ DEPTH _____ FEET. BOTTOM AREA _____ SQ. FT.
SEEPAGE PITS _____ ABSORBENT SIDE-WALL AREA _____ SQ. FT.
INLET PIPE _____ FT. BELOW ORIGINAL GRADE. MAXIMUM DEPTH _____ FT. BELOW ORIGINAL GRADE
EFFECTIVE DEPTH AT _____ FT. BELOW ORIGINAL GRADE.
LOCATE DISPOSAL AREA _____ FT. FROM _____ LOT LINE AND _____ FT. FROM _____ LOT LINE AS SEEN WHEN
FACING LOT FROM

REPAIR - CALL FOR INSPECTION WHEN GROUND IS OPENED UP SO SANITARIAN CAN RECOMMEND


REPAIR. 10' trench, 10' deep, inlet 3', 9' stone below pipe, connect to existing dry well, SIR 12/31/80

PLANS APPROVED BY Palmer F. Wine DATE 12/23/80

- COVER NO WORK UNTIL INSPECTED AND APPROVED.
- NEITHER THE HOWARD COUNTY COUNCIL NOR THE HEALTH DEPARTMENT IS RESPONSIBLE FOR THE SUCCESSFUL OPERATION OF ANY SYSTEM.
- NOTE: IF TRENCH IS USED CALL FOR INSPECTION BEFORE PLACING GRAVEL IN TRENCH.
- NOTE: NO DRY WELL SHALL EXCEED 15 FOOT IN DIAMETER.
- NOTE: ALL PIPE FROM HOUSE TO DISPOSAL AREA MUST BE CAST IRON.
- PERMIT VOID AFTER THREE YEARS.
- NOTE: INSTALL STAND PIPE ON SEPTIC TANK AND DRY WELL. STAND. PIPES MUST BE 6 INCHES IN DIAMETER. CAST IRON, CONCRETE OR TERRA COTTA ACCEPTED.

*INSTALLER IS RESPONSIBLE FOR OBTAINING FINAL APPROVAL ON THIS PERMIT.

P 31090

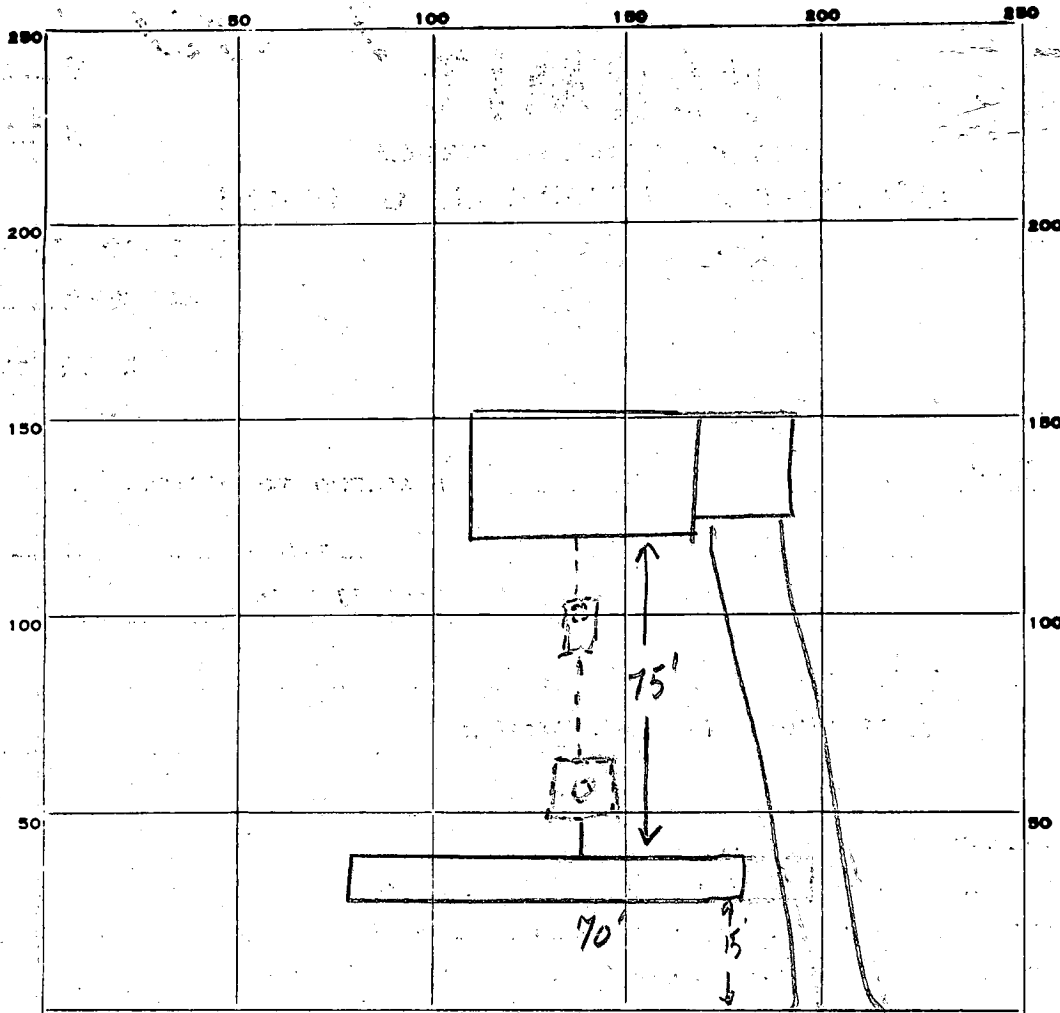

INDICATE NORTH. - NAME ADJOINING ROADWAY AS BASE LINE.

Montell Rd

PERMIT CARD

SEPTIC TANK, LEVEL _____

CLEANOUTS _____

DISTRIBUTION BOX, LEVEL _____

TILE FIELD, DEPTH 10' FT. TRENCH WIDTH 2' FT.

GRAVEL DEPTH 7 IN. TOTAL LENGTH 70' FT.

NUMBER OF TRENCHES 1 TOTAL BOTTOM AREA one sidewall 490 sq ft

SEEPAGE PITS, INSIDE DIAMETER _____ FT. DEPTH BELOW INLET _____ FT.

ABSORBENT AREA _____ SQ. FT.

REMARKS 12/31/80 012th add stone To Trench - SK - 12/31/80
love all work - SK -

Comments: Existing D. W. seems to be on lowest part of lot
 Future repair should be a D. W. to conserve space, and
 must be uphill from existing B. W. 12/31/80 SK

DATE SYSTEM APPROVED 12/31/80 INSPECTOR Stephen Keel