

5/14/81 1:30
15/81
Recall
For C. Bd.
DYE TEST
POSSIBLY

4/1/81 FILE
APPROVED
C.B.S.

PERMIT

SEWAGE DISPOSAL SYSTEM

MARYLAND STATE DEPARTMENT OF HEALTH

HOWARD COUNTY

ELLICOTT CITY

DISTRICT 5th. IR

DATE 3/31/81

INDEXED

Jenkins Bros.

IS PERMITTED TO INSTALL X ALTER

ADDRESS 10439 Frederick Road, Ellicott City, Md. 21043 PHONE 465-6646

SUBDIVISION _____ ROAD 8042 Guilford Road LOT _____

PROPERTY OWNER Beatrice Myers (466-8920)

ADDRESS 3820 Barrington Road, Baltimore, Md. 21215

SPECIFICATIONS

SEPTIC TANK CAPACITY _____ GALLONS

DRAIN FIELD _____ DEPTH _____ FEET, BOTTOM AREA _____ SQ. FT.

DEEP TRENCH _____ DEPTH _____ FEET, BOTTOM AREA _____ SQ. FT.

SEEPAGE PITS _____ ABSORBENT SIDE-WALL AREA _____ SQ. FT.

INLET PIPE _____ FT. BELOW ORIGINAL GRADE. MAXIMUM DEPTH _____ FT. BELOW ORIGINAL GRADE

EFFECTIVE DEPTH AT _____ FT. BELOW ORIGINAL GRADE.

LOCATE DISPOSAL AREA _____ FT. FROM _____ LOT LINE AND _____ FT. FROM _____ LOT LINE AS SEEN WHEN FACING LOT FROM

REPAIR - Sealed unit - 2000 gallons (2) Mechanical and/or electrical alarm float.
(3) Location - 45 feet more or less from left rear corner of existing building when facing lot from Route 32; in area of perc hold (3&4) and 25 feet to left of existing septic system which is overflowing.

PLANS APPROVED BY C. B. Streaker DATE 3/30/81

COVER NO WORK UNTIL INSPECTED AND APPROVED.

NEITHER THE HOWARD COUNTY COUNCIL NOR THE HEALTH DEPARTMENT IS RESPONSIBLE FOR THE SUCCESSFUL OPERATION OF ANY SYSTEM.

NOTE: IF TRENCH IS USED CALL FOR INSPECTION BEFORE PLACING GRAVEL IN TRENCH.

NOTE: NO DRY WELL SHALL EXCEED 15 FOOT IN DIAMETER.


NOTE: ALL PIPE FROM HOUSE TO DISPOSAL AREA MUST BE CAST IRON.

PERMIT VOID AFTER THREE YEARS.

NOTE: INSTALL STAND PIPE ON SEPTIC TANK AND DRY WELL. STAND PIPES MUST BE 6 INCHES IN DIAMETER. CAST IRON, CONCRETE OR TERRA COTTA ACCEPTED.

***INSTALLER IS RESPONSIBLE FOR OBTAINING FINAL APPROVAL ON THIS PERMIT.**

31286

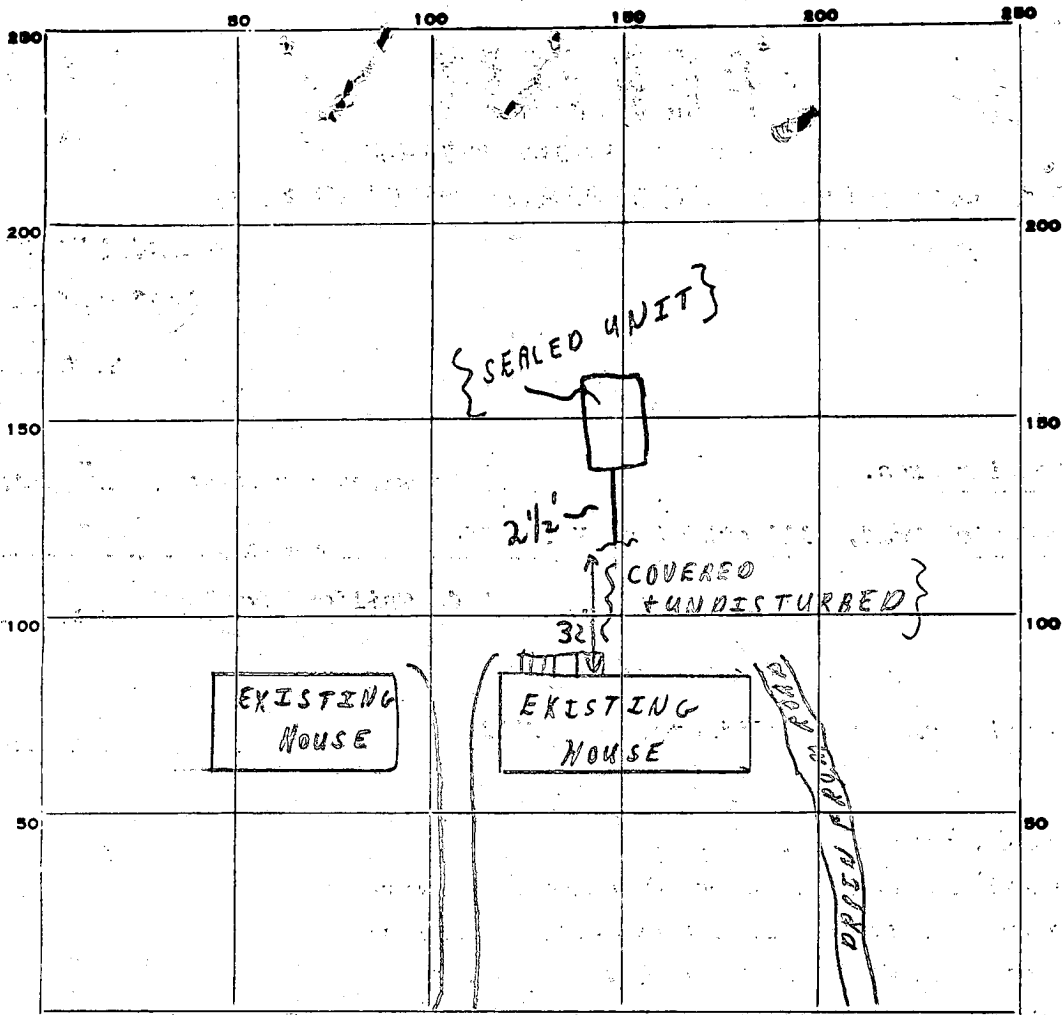

INDICATE NORTH. - NAME ADJOINING ROADWAY AS BASE LINE.

RT. 32

PERMIT CARD

SEPTIC TANK, LEVEL

BRD. OF EP. CLEANOUTS S.T.

DISTRIBUTION BOX, LEVEL _____

TILE FIELD, DEPTH _____ FT. TRENCH WIDTH _____ FT.

GRAVEL DEPTH _____ IN. TOTAL LENGTH _____ FT.

NUMBER OF TRENCHES _____ TOTAL BOTTOM AREA _____

SEEPAGE PITS, INSIDE DIAMETER _____ FT. DEPTH BELOW INLET _____ FT.

ABSORBENT AREA _____ SQ. FT.

REMARKS 4/1/81 (1) CHECKED - SEALED UNIT NOT AT SITE 10:52. C.B.C.
 (2) SYSTEM IN. 5/14/81

DATE SYSTEM APPROVED 4/1/81 INSPECTOR C. B. Stecker

3/27/81
 1:30 P.M.
 3/30/81
 (4) Hold permit
 did contract with a
 sewerage brought in!

APPLICATION

SEWAGE DISPOSAL TESTING

A Repair

STATE OF MARYLAND - DEPARTMENT OF HEALTH AND MENTAL HYGIENE

P _____

HOWARD COUNTY HEALTH DEPARTMENT
 ENVIRONMENTAL HEALTH SERVICES

P. O. BOX 473 ELLICOTT CITY, MARYLAND 21043
 TELEPHONE: 992-2330

(1) Sealed unit - 2000 gallons
 DISTRICT 5th.
 (2) Mechanical + for electrical alarm
 float
 DATE 3/26/81



(3) Location 45' + from left rear corner of existing building when facing lot from Rt. 32; In area of open hole (3) and 25' ± to left of existing septic system which is overflowing.

TO: THE COUNTY HEALTH OFFICER
 ELLICOTT CITY, MARYLAND

I HEREBY APPLY FOR THE NECESSARY TEST IN ORDER TO CONSTRUCT (OR RECONSTRUCT) A SEWAGE DISPOSAL SYSTEM.

PROPERTY OWNER BEATRICE Myers - Repair perc - Jenkins Bros.

ADDRESS Route 32 PHONE 8044 RT 32

PROPERTY LOCATION:

SUBDIVISION N LOT NO. _____

ROAD AND DESCRIPTION Across from B.I. of Educ. - White Stucco House.

SIZE OF LOT _____ TYPE BLDG. DUPLEX 1

3 Bedrooms per Mr. Jenkins
 (NUMBER OF BEDROOMS)

THE SYSTEM INSTALLED UNDER THIS APPLICATION IS ACCEPTABLE ONLY UNTIL PUBLIC FACILITIES BECOME AVAILABLE. I FULLY UNDERSTAND THE

FEE CONNECTED WITH THE FILING OF THIS PERC TEST APPLICATION IS NON-REFUNDABLE UNDER ANY CIRCUMSTANCES. I ALSO AGREE TO COMPLY

WITH ALL M.O.S.H.A. REQUIREMENTS IN TESTING THIS LOT.

Tentative APPROVED BY C.B. Sheehan FOR Sealed unit only (SIGNATURE OF APPLICANT) DATE 3/30/81

REJECTED BY _____ FOR _____ DATE _____

HOLD PENDING FURTHER TESTS _____ DATE _____

REASONS FOR REJECTION OR HOLDING 3/27/81 PLUMBING IN HOUSE; PUBLIC WATER PER MR. W. TAYLOR.


RENTER. 3/30/81 discussed - sealed unit 2,000 gallon tank (alarm device) + contract with sewerage
mechanical float + for electric before permit released F.F. & C.B.

THIS IS NOT A PERMIT

7

SOIL PROFILE

SEE EACH HOLE BELOW

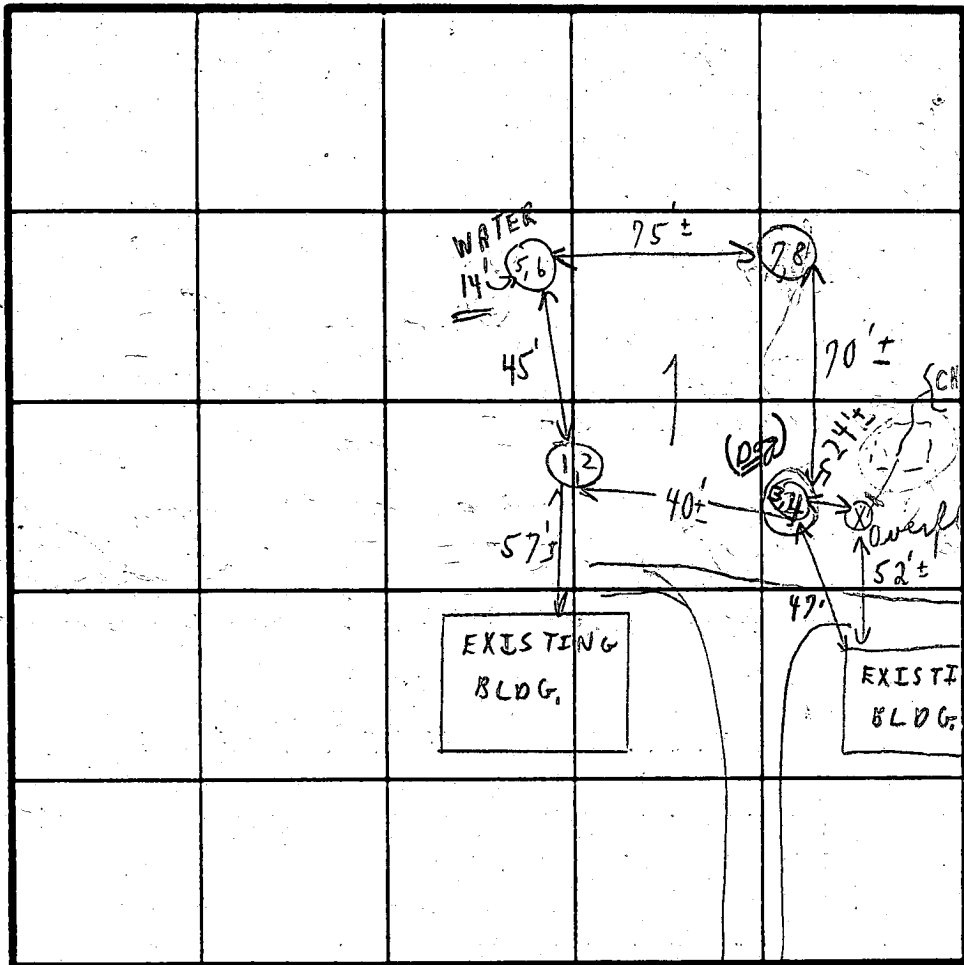

FIELD SHEET

INDICATE NORTH - NAME ADJOINING ROADWAY AS BASE LINE.

RT. 32

RRD. OF EDUCATION

SOIL PROFILE	DATE	TEST NO.	DEPTH	EXISTING PRE-WET		TEST - 1" DROP		TIME
				START	HOUSE STOP	START	STOP	
1' - 15' CLAY SOME SANDY MICA LOAM TO IS	3/29/81	1	4'	1:54	2:06	2:06	@ 2:36	1/2" @ moist
		2	(15')	: SIMILAR TO 4'				
1' - 15" CLAY + SOME MICA LOAM TO IS		3 A	5'-6"	1:52	:	@ 2:22	little perc to Naiger	XXX
		4	15'	:	:	:	:	XXX
1' - 5" CLAY + SANDY SANDY LOAM TO WATER		5	5'	:	SANDY-LOAM-BE	LOW CLAY		
		6	14'-10"	:	WATER FROM 14'-	14' 10" XXX		
		3 B	6'	2:13	:	@ 2:43	1/8" @ moist NO PER	XXXX
1' - 4" CLAY 6' MICA SAND		7	6'	:			4' chd old drain field	
		8	'					

REMARKS

[EXISTING HOUSE + PLUMBING] } HOLD + CHECK
TESTS BEHIND HOUSES } PROPERTY OWNER
HOLD - POSSIBLY SEALED UNIT + PLAT'S
SOIL DAMP IN ALL (ALLEN'S - KEN ALLEN)

TYPE OF SOIL

TESTED BY

C.B.D.

HOLES

ALSO PRESENT

+ BACKHOE
ZMR JENKINS

EH-12-1079

Proposal

Page No. 1of 3

Pages

JENKINS BROS.

Septic Service & General Contractors
 Old Fredrick Road Route 144
 ELLICOTT CITY, MARYLAND 21043
 Phone 465-6646

*H.W.
 Seall Sept.*

PROPOSAL SUBMITTED TO <i>Beatrice Myers</i>	PHONE <i>Rental Property</i>	DATE
STREET <i>3820 Barrington Rd.</i>	JOB NAME <i>sewage repair</i>	
CITY, STATE AND ZIP CODE <i>Balt. Md. 21215</i>	JOB LOCATION <i>8042 Sulford Rd.</i>	
ARCHITECT	DATE OF PLANS <i>3-30-81</i>	JOB PHONE
	<i>Columbia, Md.</i>	

We hereby submit specifications and estimates for:

Installing 2000 gal. holding tank with float type device, when device indicates such time to be pumped it will be pumped by Jenkins Bros at such time of notice. You forty dollars per 2000 gal. to be paid in full when pumping is done. Contract good for one year from date stated above. Contract can only be terminated by poor service on our part with proof of such, and or lack of payment on Owners part.

We Propose hereby to furnish material and labor — complete in accordance with above specifications, for the sum of:

Forty + 00 _____ dollars (\$ *40.00*)

Payment to be made as follows:

Forty dollars per 2000 gal. to be paid in full when pumping is done.

All material is guaranteed to be as specified. All work to be completed in a workmanlike manner according to standard practices. Any alteration or deviation from above specifications involving extra costs will be executed only upon written orders, and will become an extra charge over and above the estimate. All agreements contingent upon strikes, accidents or delays beyond our control. Owner to carry fire, tornado and other necessary insurance. Our workers are fully covered by Workmen's Compensation Insurance.

Authorized Signature *Houis E. Jenkins*

Note: This proposal may be withdrawn by us if not accepted within *Three* days.

Acceptance of Proposal — The above prices, specifications and conditions are satisfactory and are hereby accepted. You are authorized to do the work as specified. Payment will be made as outlined above.

Date of Acceptance: *3-31-81*

Signature *Jenkins Bros.*

Signature *Beatrice Myers*