

# PERMIT

5/25/81 FILE APPROVED  
P 31376 C.B.S.

~~5/11/81~~ 5/19/81  
~~9:30 A.M.~~ 9:30 A.M.  
CANCELLED - NO SHOW

SEWAGE DISPOSAL SYSTEM  
MARYLAND STATE DEPARTMENT OF HEALTH

A Repair

HOWARD COUNTY

α-172867

ELLICOTT CITY

DISTRICT 2nd

5/25/81 A.M.  
9:30

INDEXED

DATE 5/13/81

Jack Fyock

IS PERMITTED TO INSTALL ALTER X

ADDRESS 13775 Triadelphia Road, Glenelg, Md. 21737 PHONE 988-9270

SUBDIVISION \_\_\_\_\_ ROAD 5525 Montgomery Road LOT \_\_\_\_\_

PROPERTY OWNER Bob Marsh  
7th house on left face Kerger Road

ADDRESS 5525 Montgomery Road, Ellicott City, Md. Phone: 465-5673

SPECIFICATIONS (EXISTING HOUSE - 3 BEDROOMS)

SEPTIC TANK CAPACITY \_\_\_\_\_ GALLONS

DRAIN FIELD \_\_\_\_\_ DEPTH \_\_\_\_\_ FEET, BOTTOM AREA \_\_\_\_\_ SQ. FT.

SHALLOW

DEEP TRENCH { 50' DEPTH 7 1/2' FEET, BOTTOM AREA \_\_\_\_\_ SQ. FT.

SEEPAGE PITS { 12' ABSORBENT SIDE-WALL AREA 3" SQ. FT. +

INLET PIPE 1 1/2-3' FT. BELOW ORIGINAL GRADE. MAXIMUM DEPTH 7 1/2-9' FT. BELOW ORIGINAL GRADE FOR SYSTEM  
EFFECTIVE DEPTH AT 2 1/2-3' FT. BELOW ORIGINAL GRADE. (5' OF STONE IN TRENCH)

LOCATE DISPOSAL AREA \_\_\_\_\_ FT. FROM \_\_\_\_\_ LOT LINE AND \_\_\_\_\_ FT. FROM \_\_\_\_\_ LOT LINE AS SEEN WHEN  
FACING LOT FROM OFF EXISTING DISTRIBUTION BOX - 11" and RUN TRENCH TO RIGHT REAR PROPERTY LINE, STAYING 10' OFF ANY PROPERTY LINE

REPAIR - Call for an appointment when ground is opened up and Sanitarian will recommend the repair system. NOTE: OVERFLOW IN REAR YARD 5/19/81 C.B.S.

5/25/81 TRENCH 60'+L. depth 2 1/2' - Effective as per 2 1/2' - 7 1/2' +  
SEE ABOVE FOR LOCATION.


C.B. M. for NOTE TRENCH CAVING - DUE TO SANDY LOAM SOIL

PLANS APPROVED BY Palmer F. Wine DATE 5/8/81

- COVER NO WORK UNTIL INSPECTED AND APPROVED.
- NEITHER THE HOWARD COUNTY COUNCIL NOR THE HEALTH DEPARTMENT IS RESPONSIBLE FOR THE SUCCESSFUL OPERATION OF ANY SYSTEM.
- NOTE: IF TRENCH IS USED CALL FOR INSPECTION BEFORE PLACING GRAVEL IN TRENCH.
- NOTE: NO DRY WELL SHALL EXCEED 15 FOOT IN DIAMETER.
- NOTE: ALL PIPE FROM HOUSE TO DISPOSAL AREA MUST BE CAST IRON.
- PERMIT VOID AFTER THREE YEARS.
- NOTE: INSTALL STAND PIPE ON SEPTIC TANK AND DRY WELL. STAND PIPES MUST BE 6 INCHES IN DIAMETER. CAST IRON, CONCRETE OR TERRA COTTA ACCEPTED.

\*INSTALLER IS RESPONSIBLE FOR OBTAINING FINAL APPROVAL ON THIS PERMIT.

31376

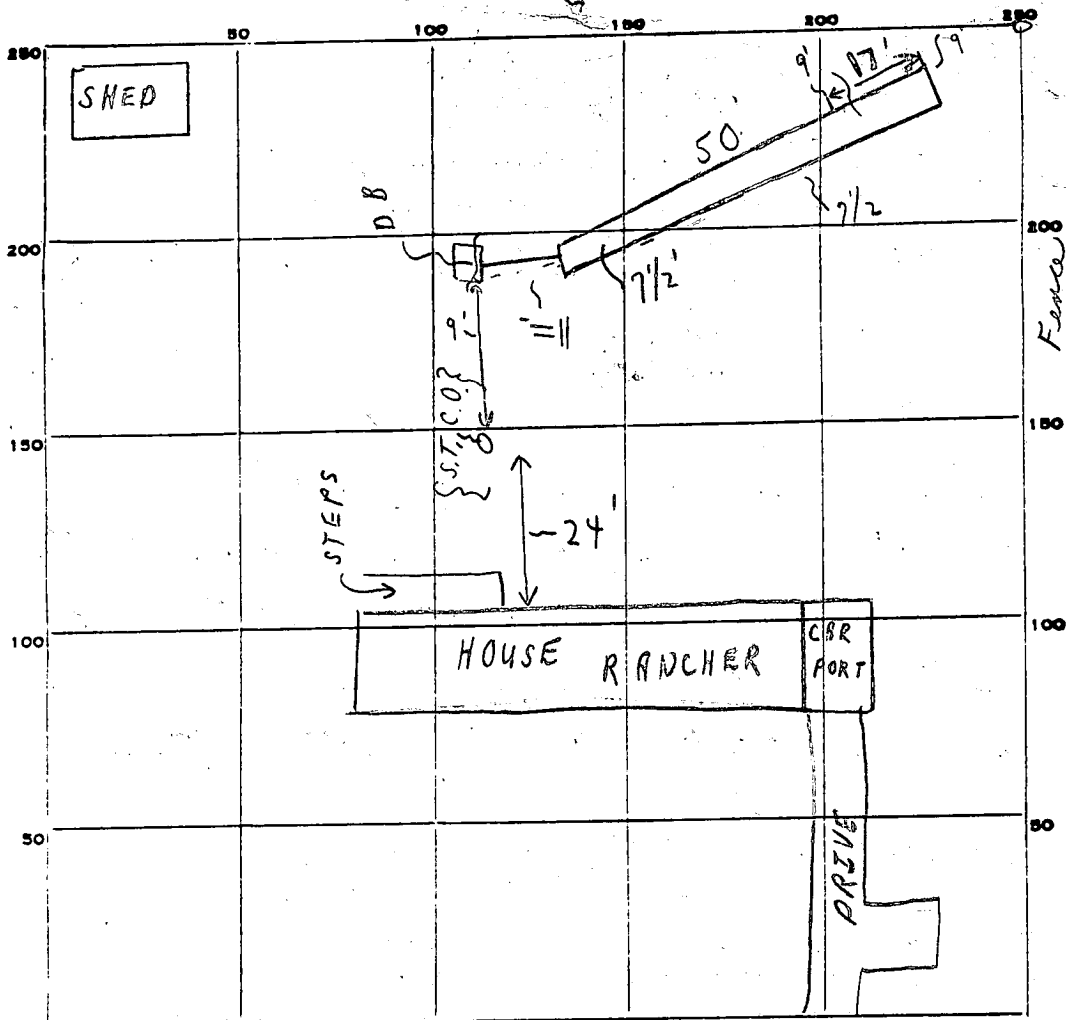

INDICATE NORTH. - NAME ADJOINING ROADWAY AS BASE LINE.  
MONT GOMERY ROAD.

PERMIT CARD

SEPTIC TANK, LEVEL \_\_\_\_\_

CLEANOUTS N/A

DISTRIBUTION BOX, LEVEL \_\_\_\_\_

TRENCH TILE FIELD, DEPTH 7 1/2' - 50' FT. TRENCH WIDTH 2' + FT.

GRAVEL DEPTH 9' - 17' IN. TOTAL LENGTH 69 } 250 # FT. 119 #

NUMBER OF TRENCHES 1 TOTAL BOTTOM AREA \_\_\_\_\_

SEEPAGE PITS, INSIDE DIAMETER \_\_\_\_\_ FT. DEPTH BELOW INLET \_\_\_\_\_ FT.

ABSORBENT AREA 369<sup>+</sup> SQ. FT.

REMARKS 5/19/81 PUBLIC WATER-PRIVATE SEWERAGE. NO EQUIPMENT AT  
SITE, HOLD FOR ANOTHER APPT. 5/25/81 OK FOR STONE IN TRENCH  
OK TO COVER SYSTEM.

DATE SYSTEM APPROVED 5/25/81 INSPECTOR C.B. ✓ Trecker