

7/16/81
AM

7/15/81 RH APPROVED RH

PERMIT

P 31483
A Repair

SEWAGE DISPOSAL SYSTEM
MARYLAND STATE DEPARTMENT OF HEALTH

HOWARD COUNTY

05-369681

ELLICOTT CITY

DISTRICT 5th

INDEX!

DATE 7/13/81

Jack Fyock

IS PERMITTED TO INSTALL ALTER X

ADDRESS 13775 Triadelphia Road, Glenelg, Md. 21737 PHONE 988-9270

SUBDIVISION Green Hill Manor ROAD 6705 Montell Drive LOT _____

PROPERTY OWNER Richard E. Tobias

ADDRESS 6705 Montell Drive, Highland, Maryland 20777 Phone: 854-0113

SPECIFICATIONS 3 BR

SEPTIC TANK CAPACITY _____ GALLONS

DRAIN FIELD _____ DEPTH _____ FEET, BOTTOM AREA _____ SQ. FT.

DEEP TRENCH _____ DEPTH _____ FEET, BOTTOM AREA _____ SQ. FT.

SEEPAGE PITS _____ ABSORBENT SIDE-WALL AREA _____ SQ. FT.

INLET PIPE _____ FT. BELOW ORIGINAL GRADE. MAXIMUM DEPTH _____ FT. BELOW ORIGINAL GRADE

EFFECTIVE DEPTH AT _____ FT. BELOW ORIGINAL GRADE.

LOCATE DISPOSAL AREA _____ FT. FROM _____ LOT LINE AND _____ FT. FROM _____ LOT LINE AS SEEN WHEN
FACING LOT FROM

REPAIR - Call for an appointment when ground is opened up and Sanitarian

will recommend the repair system.

7/16/81 RH

DEEP DITCH 50 FT LONG 7 1/2 FT STORM

IN FRONT YARD OFF OLD DRY WELL

PLANS APPROVED BY Palmer F. Wine DATE 7/13/81

COVER NO WORK UNTIL INSPECTED AND APPROVED.

NEITHER THE HOWARD COUNTY COUNCIL NOR THE HEALTH DEPARTMENT IS RESPONSIBLE FOR THE SUCCESSFUL OPERATION OF ANY SYSTEM.

NOTE: IF TRENCH IS USED CALL FOR INSPECTION BEFORE PLACING GRAVEL IN TRENCH.

NOTE: NO DRY WELL SHALL EXCEED 15 FOOT IN DIAMETER.


NOTE: ALL PIPE FROM HOUSE TO DISPOSAL AREA MUST BE CAST IRON.

PERMIT VOID AFTER THREE YEARS.

NOTE: INSTALL STAND PIPE ON SEPTIC TANK AND DRY WELL. STAND PIPES MUST BE 6 INCHES IN DIAMETER. CAST IRON, CONCRETE OR TERRA
COTTA ACCEPTED.

*INSTALLER IS RESPONSIBLE FOR OBTAINING FINAL APPROVAL ON THIS PERMIT.

31483

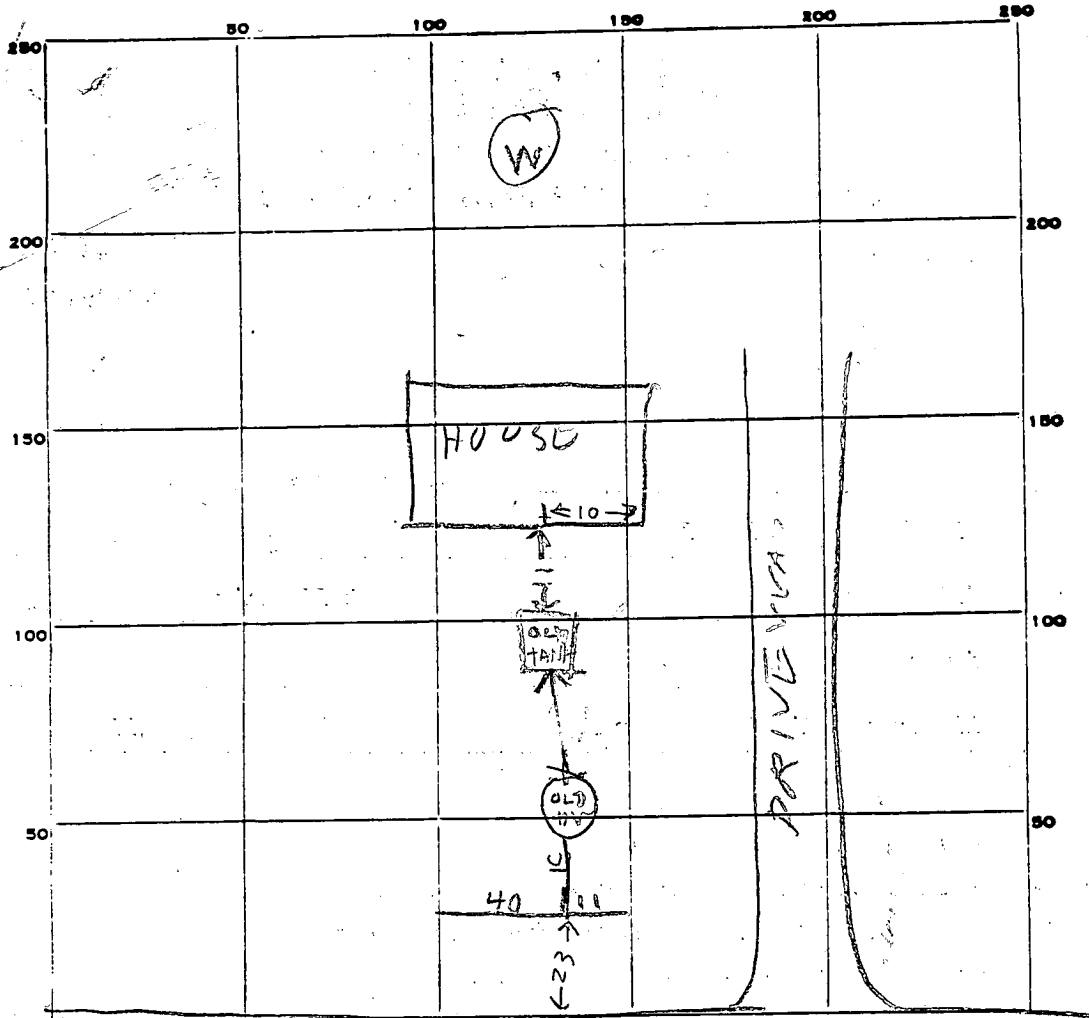

INDICATE NORTH - NAME ADJOINING ROADWAY AS BASE LINE.
 MONTELL DR

PERMIT CARD _____

SEPTIC TANK, LEVEL N/A

CLEANOUTS _____

DISTRIBUTION BOX, LEVEL _____

TILE FIELD, DEPTH 12 1/2 FT. TRENCH WIDTH, 2 FT.

GRAVEL DEPTH 7 1/2 FT. TOTAL LENGTH 51 FT.

NUMBER OF TRENCHES 1 TOTAL ^{ONE SIDE} BOTTOM AREA 382

SEEPAGE PITS, INSIDE DIAMETER _____ FT. DEPTH BELOW INLET _____ FT.

ABSORBENT AREA _____ SQ. FT.

REMARKS 7/16/81 DITCH 12 1/2 FT DEEP TOP 5 1/2 CLAY BOT
7 1/2 SANDY OLD SYSTEM IN USE 10 YEARS

DATE SYSTEM APPROVED 7/16/81

INSPECTOR Raymond Hodges