

7/23/81

7/24/81 noon time around

PERMIT

Approved: 7/24/81 31507
S. Kil

SEWAGE DISPOSAL SYSTEM

A Repair

MARYLAND STATE DEPARTMENT OF HEALTH

HOWARD COUNTY

06-407552

ELLICOTT CITY

DISTRICT 5th

INDEX

DATE 7/23/81

Olen Ketterman IS PERMITTED TO INSTALL _____ ALTER X

ADDRESS 14960 Frederick Road, Woodbine, Maryland 21797 PHONE 442-1336

SUBDIVISION _____ ROAD 9824 Owen Brown Road LOT _____

PROPERTY OWNER Gustav Huber

ADDRESS 9824 Owen Brown Road, Columbia, Md. 21044

SPECIFICATIONS 3 bedrooms

SEPTIC TANK CAPACITY 1000 GALLONS

DRAIN FIELD _____ DEPTH _____ FEET, BOTTOM AREA _____ SQ. FT.

DEEP TRENCH _____ DEPTH _____ FEET, BOTTOM AREA _____ SQ. FT.

SEEPAGE PITS _____ ABSORBENT SIDE-WALL AREA _____ SQ. FT.

INLET PIPE _____ FT. BELOW ORIGINAL GRADE. MAXIMUM DEPTH _____ FT. BELOW ORIGINAL GRADE

EFFECTIVE DEPTH AT _____ FT. BELOW ORIGINAL GRADE.

LOCATE DISPOSAL AREA _____ FT. FROM _____ LOT LINE AND _____ FT. FROM _____ LOT LINE AS SEEN WHEN

FACING LOT FROM

REPAIR - Call for an appointment when ground is opened up so Sanitarian can

recommend the repair system.

one trench 50'-60' long inlet 4-4 1/2" max depth

11' ft SK 7/23/81 locate trench 60'-65' from Rt front House corner

PLANS APPROVED BY Palmer F. Wine DATE 7/23/81

COVER NO WORK UNTIL INSPECTED AND APPROVED.

NEITHER THE HOWARD COUNTY COUNCIL NOR THE HEALTH DEPARTMENT IS RESPONSIBLE FOR THE SUCCESSFUL OPERATION OF ANY SYSTEM.

NOTE: IF TRENCH IS USED CALL FOR INSPECTION BEFORE PLACING GRAVEL IN TRENCH.

NOTE: NO DRY WELL SHALL EXCEED 15 FOOT IN DIAMETER.


NOTE: ALL PIPE FROM HOUSE TO DISPOSAL AREA MUST BE CAST IRON.

PERMIT VOID AFTER THREE YEARS.

NOTE: INSTALL STAND PIPE ON SEPTIC TANK AND DRY WELL. STAND PIPES MUST BE 6 INCHES IN DIAMETER. CAST IRON, CONCRETE OR TERRA COTTA ACCEPTED.

*INSTALLER IS RESPONSIBLE FOR OBTAINING FINAL APPROVAL ON THIS PERMIT.

AP 3/507

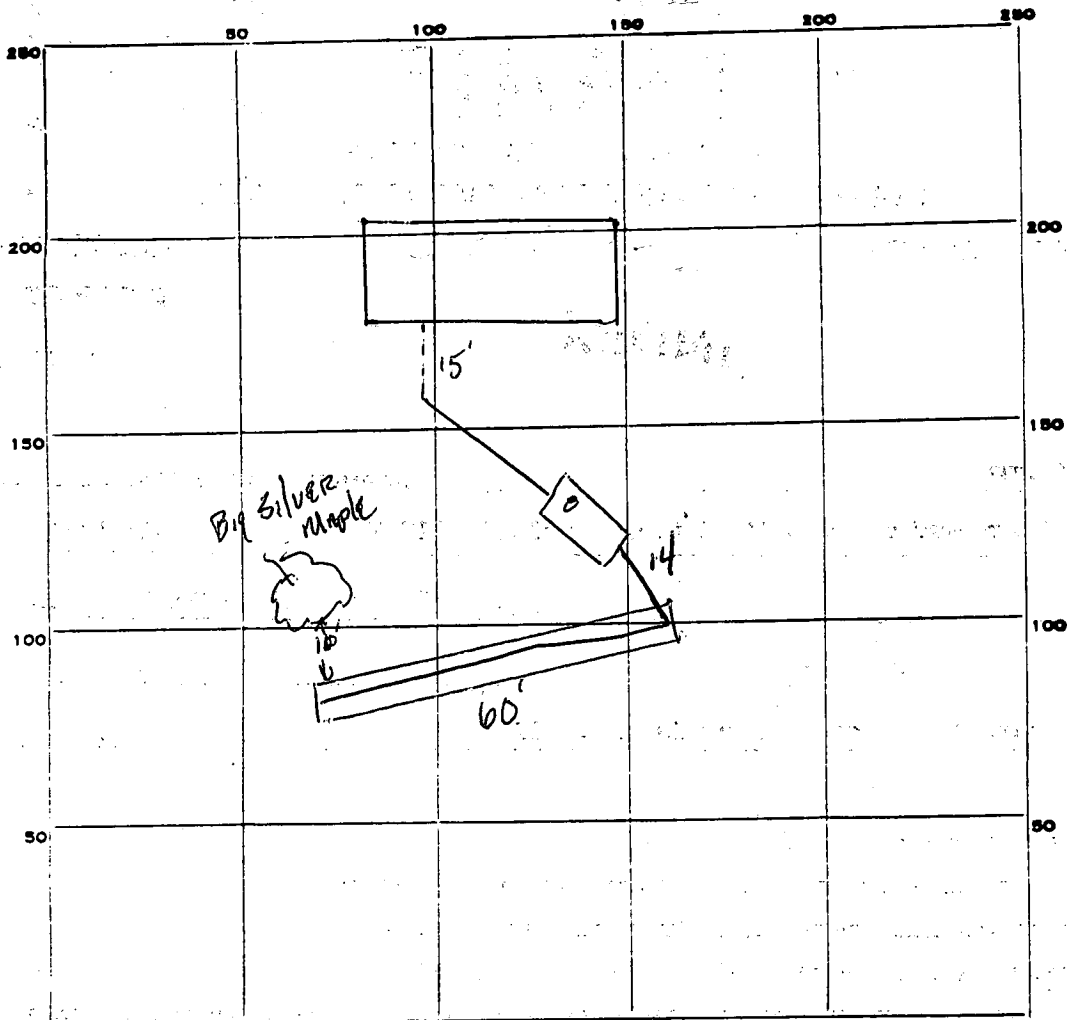

PERMIT CARD

SEPTIC TANK, LEVEL

CLEANOUTS

DISTRIBUTION BOX, LEVEL _____

TILE FIELD, DEPTH ~~11~~ 11 FT. TRENCH WIDTH 2 FT.

INLET 4 1/2' EFFECTIVE AREA 6' IN. TOTAL LENGTH 60' FT.
GRAVEL DEPTH

NUMBER OF TRENCHES 1 TOTAL SIDEWALK 360' 4
TOTAL BOTTOM AREA

SEEPAGE PITS, INSIDE DIAMETER _____ FT. DEPTH BELOW INLET _____ FT.

ABSORBENT AREA _____ SQ. FT.

REMARKS 1/23/81 OK to cover Tank + House sewer SK-/
1/24/81 OK to add gravel to inlet SK 7/24/81 OK to cover all
work

DATE SYSTEM APPROVED 7/24/81

INSPECTOR Stephen G. Keil