

7/24/81
9:30 A.M.

PERMIT

Approved: 7/24/81 P 31508
S.G. Kiel

SEWAGE DISPOSAL SYSTEM

A Repair

MARYLAND STATE DEPARTMENT OF HEALTH

HOWARD COUNTY

02-246027

ELLICOTT CITY

DISTRICT _____

INDEX

DATE 7/22/81

Jenkins Brothers

IS PERMITTED TO INSTALL _____ ALTER X

ADDRESS Route 144 PHONE 465-6646

SUBDIVISION _____ ROAD 10032 Fox Den Court LOT _____

PROPERTY OWNER Joe Healy

ADDRESS 10032 Fox Den Court, Bethany lane

SPECIFICATIONS

SEPTIC TANK CAPACITY _____ GALLONS

DRAIN FIELD _____ DEPTH _____ FEET, BOTTOM AREA _____ SQ. FT.

DEEP TRENCH _____ DEPTH _____ FEET, BOTTOM AREA _____ SQ. FT.

SEEPAGE PITS _____ ABSORBENT SIDE-WALL AREA _____ SQ. FT.

INLET PIPE _____ FT. BELOW ORIGINAL GRADE, MAXIMUM DEPTH _____ FT. BELOW ORIGINAL GRADE

EFFECTIVE DEPTH AT _____ FT. BELOW ORIGINAL GRADE.

LOCATE DISPOSAL AREA _____ FT. FROM _____ LOT LINE AND _____ FT. FROM _____ LOT LINE AS SEEN WHEN FACING LOT FROM

REPAIR-call for inspection when ground is opened up so sanitarian can recommend repair.

7/24/81 1 Trench 40-45' long, inlet 2', max depth 10-10 1/2'
8-8 1/2' stone under pipe ~~3K~~, cast iron pipe removal
from tanks to trench 3K

PLANS APPROVED BY Palmer Wine DATE July 22, 1981

COVER NO WORK UNTIL INSPECTED AND APPROVED.

NEITHER THE HOWARD COUNTY COUNCIL NOR THE HEALTH DEPARTMENT IS RESPONSIBLE FOR THE SUCCESSFUL OPERATION OF ANY SYSTEM.

NOTE: IF TRENCH IS USED CALL FOR INSPECTION BEFORE PLACING GRAVEL IN TRENCH.

NOTE: NO DRY WELL SHALL EXCEED 15 FOOT IN DIAMETER.

NOTE: ALL PIPE FROM HOUSE TO DISPOSAL AREA MUST BE CAST IRON.


PERMIT VOID AFTER THREE YEARS.

NOTE: INSTALL STAND PIPE ON SEPTIC TANK AND DRY WELL. STAND PIPES MUST BE 6 INCHES IN DIAMETER. CAST IRON, CONCRETE OR TERRA COTTA ACCEPTED.

*INSTALLER IS RESPONSIBLE FOR OBTAINING FINAL APPROVAL ON THIS PERMIT.

*Sewer in 84
Cap Proj # 6051*

AP 31508

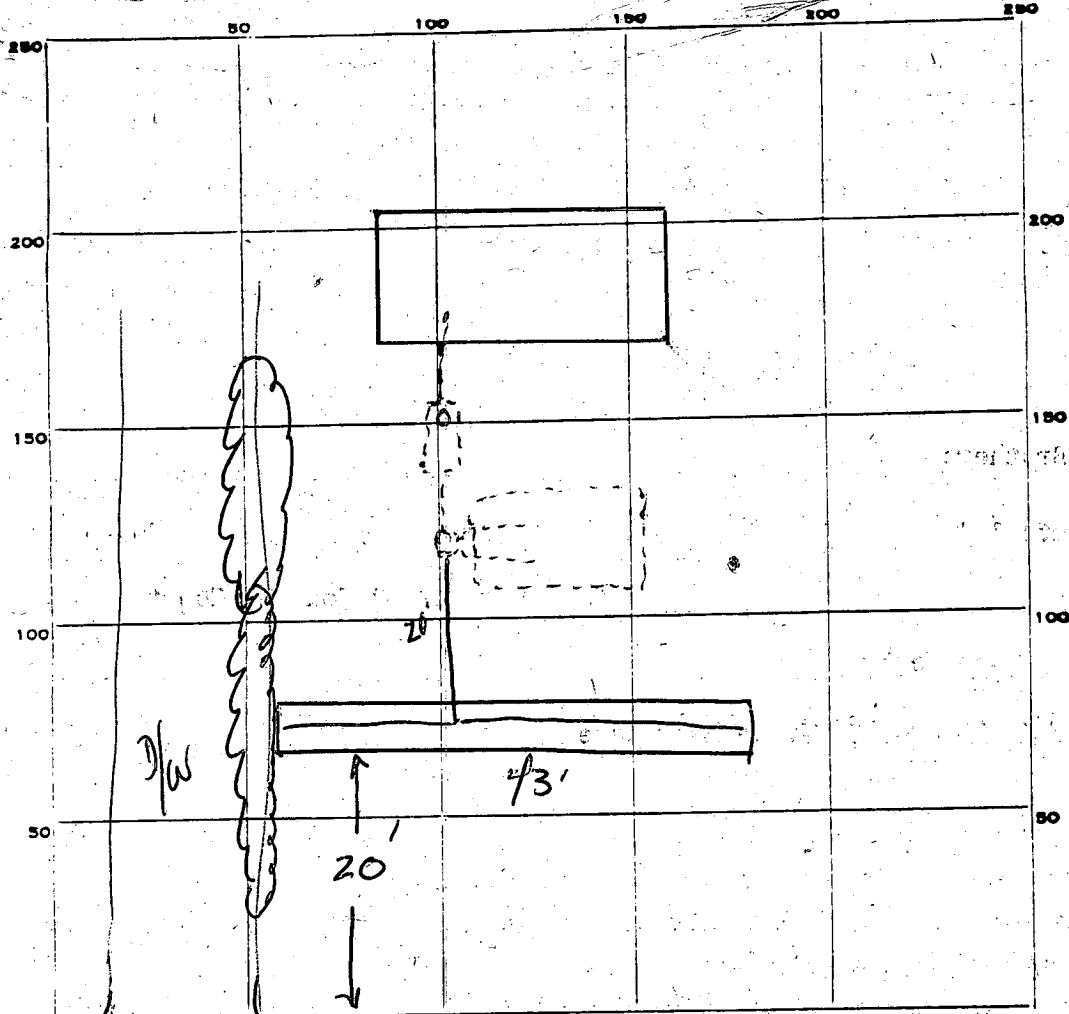

INDICATE NORTH - NAME ADJOINING ROADWAY AS BASE LINE.
 Fox Den Ct

PERMIT CARD

SEPTIC TANK, LEVEL _____ CLEANOUTS _____

DISTRIBUTION BOX, LEVEL _____

TILE FIELD, DEPTH 10' FT. TRENCH WIDTH 2 FT.

GRAVEL DEPTH 8 1/2 IN. TOTAL LENGTH 13' FT.

NUMBER OF TRENCHES 1 TOTAL BOTTOM AREA 3600 #

SEEPAGE PITS, INSIDE DIAMETER _____ FT. DEPTH BELOW INLET _____ FT.

ABSORBENT AREA _____ SQ. FT.

REMARKS 1/21/81 ^{Brown + Gray Brack} Dig 14' hole, Dry very sandy loam, gas, water, and electric run upright side of property, made 10' depth get 3600 # area
7/24/81 OK to add gravel to ditch 3K ^{1/24/81} cover all work 5K

DATE SYSTEM APPROVED

7/24/81

INSPECTOR

Stephen G. Kiel