

APPLICATION

A 08114

SEWAGE DISPOSAL TESTING

P _____

MARYLAND STATE DEPARTMENT OF HEALTH

HOWARD COUNTY

ELLCOTT CITY

*Siglec Test - 1000 gal.
Dry Well - 13 Heliummeter (not including 7 inch) and
11 ft deep Nelson inlet pipe.*

DISTRICT 2

DATE 3/6/64

*Place Dry Well about 30 ft from barbed wire fence on
the left side of lot as you face RT 29 and about 126 ft
from barbed wire fence which runs parallel to RT 29.*

TO: THE COUNTY HEALTH OFFICER
ELLCOTT CITY, MARYLAND

I, HEREBY, APPLY FOR THE NECESSARY TESTS IN ORDER TO CONSTRUCT (OR RECONSTRUCT) A SEWAGE
DISPOSAL SYSTEM.

PROPERTY OWNER Leon E. Wilhide, Sr.

ADDRESS 421 Cook's Lane, E. C. PHONE 465-3434

PROPERTY LOCATION:

SUBDIVISION _____ LOT NO. _____

ROAD AND DESCRIPTION Cook's Lane off Columbia Rd.

OCCUPANT _____ PHONE _____

PERSON TO CONSTRUCT SYSTEM _____

ADDRESS _____ PHONE _____

SIZE OF LOT 1 acre TYPE BLDG. 4 NUMBER OF BEDROOMS 3

IF NOT SINGLE RESIDENCE DESCRIBE _____

SIGNATURE OF APPLICANT Leon E. Wilhide, Sr.

APPROVED BY D.W. Morgan FOR 3/18/64 Dry Well DATE 3/18/64


REJECTED BY D.W. Morgan FOR 5/1/64 DATE 5/1/64

HOLD PENDING FURTHER TESTS RT 29 DATE 3/10/64

REASONS FOR REJECTION OR HOLDING Prohibition too strict in the small area tested to allow

that an on-site sewage system could be installed

THIS IS NOT A PERMIT

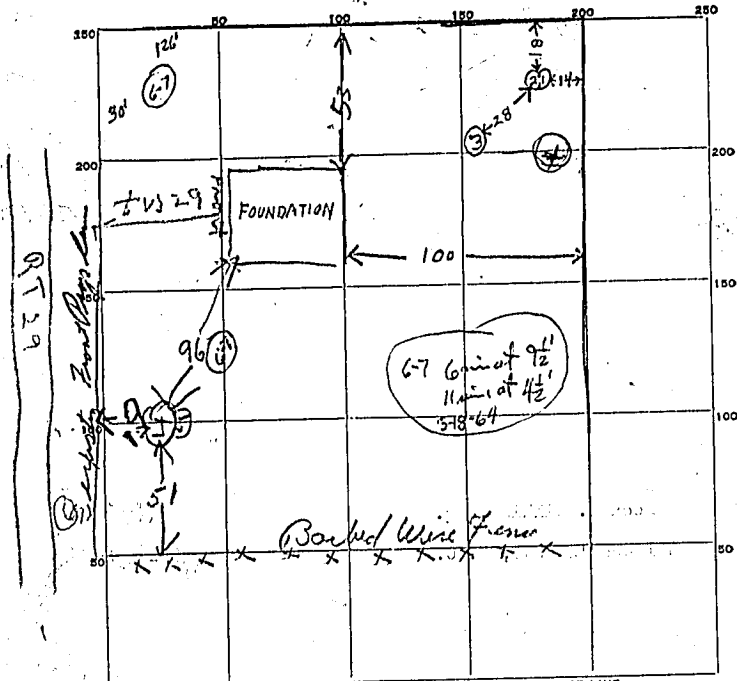

INDICATE NORTH. - NAME ADJOINING ROADWAY AS BASE LINE.

DATE	TEST NO.	DEPTH	PRE-WET		TEST - 1" DROP		TIME
			START	STOP	START	STOP	
3/10/64	1	10	959	1017	1017	1052	35 minutes almost penetration
"	2	5	1001	1039	1039	1052	13 minutes some perc but some runoff
"	3	4	1005	1052	little perc	Rain Runoff	lost
SAME PLACE AS (3)	3A	9	WATER UP TO RAIN WATER		8 FT	PROBABLY	
"	1		Rain stopped suddenly Droplets like come for water		1017	1129	58 inches = 44 mm per inch
"	2	5			1039	1137	50
"	3	4	1005	1129	little perc	1 hr 24 min	
3/12/64	4	8 1/2	952	1008	1008	1046	38 min
	5	4	953	1055	runoff on first and 1 hour 2 min		
	4A	11 ft	1121	little perc	scat yellow		

SOIL AUGER FINDING: 3/12/64 - good soil at bottom of hole #4

TESTED BY: Raymond Hedges / BWM 3/12/64

REMARKS:

ALSO PRESENT: John W. Alder LOT NO. _____