

# PERMIT

Approved: 11/3/81  
S. Skill

P 31654  
A Repair

SEWAGE DISPOSAL SYSTEM

MARYLAND STATE DEPARTMENT OF HEALTH

HOWARD COUNTY

ELLICOTT CITY

DISTRICT \_\_\_\_\_

INDEX

DATE 10/9/81

Mr. Norman Dick

IS PERMITTED TO INSTALL \_\_\_\_\_ ALTER

ADDRESS 2555 Greening Chapel Rd, Woodbine, Md PHONE 489-4724

SUBDIVISION \_\_\_\_\_ ROAD 2129 Daisy Rd LOT \_\_\_\_\_

PROPERTY OWNER Mr. William Perkins

ADDRESS 2129 Daisy Rd, Woodbine, Md

SPECIFICATIONS

- SEPTIC TANK CAPACITY \_\_\_\_\_ GALLONS
- DRAIN FIELD \_\_\_\_\_ DEPTH \_\_\_\_\_ FEET, BOTTOM AREA \_\_\_\_\_ SQ. FT.
- DEEP TRENCH \_\_\_\_\_ DEPTH \_\_\_\_\_ FEET, BOTTOM AREA \_\_\_\_\_ SQ. FT.
- SEEPAGE PITS \_\_\_\_\_ ABSORBENT SIDE-WALL AREA \_\_\_\_\_ SQ. FT.
- INLET PIPE \_\_\_\_\_ FT. BELOW ORIGINAL GRADE. MAXIMUM DEPTH \_\_\_\_\_ FT. BELOW ORIGINAL GRADE
- EFFECTIVE DEPTH AT \_\_\_\_\_ FT. BELOW ORIGINAL GRADE.
- LOCATE DISPOSAL AREA \_\_\_\_\_ FT. FROM \_\_\_\_\_ LOT LINE AND \_\_\_\_\_ FT. FROM \_\_\_\_\_ LOT LINE AS SEEN WHEN FACING LOT FROM

Repair - Call for inspection when ground is opened up as  
sanitation is used for commercial repair


10/16 2 DW. 15x15' inlet at 3'-4' <sup>MAX DEPTH 12'-12 1/2'</sup> use DB box for feet all 4 wells  
cement across outlets to old wells to insure new wells are feet \*

PLANS APPROVED BY Mr. Palmer J. Wine DATE October 9, 1981

- COVER NO WORK UNTIL INSPECTED AND APPROVED.
- NEITHER THE HOWARD COUNTY COUNCIL NOR THE HEALTH DEPARTMENT IS RESPONSIBLE FOR THE SUCCESSFUL OPERATION OF ANY SYSTEM.
- NOTE: IF TRENCH IS USED CALL FOR INSPECTION BEFORE PLACING GRAVEL IN TRENCH.
- NOTE: NO DRY WELL SHALL EXCEED 15 FOOT IN DIAMETER.
- NOTE: ALL PIPE FROM HOUSE TO DISPOSAL AREA MUST BE CAST IRON.
- PERMIT VOID AFTER THREE YEARS.
- NOTE: INSTALL STAND PIPE ON SEPTIC TANK AND DRY WELL. STAND PIPES MUST BE 6 INCHES IN DIAMETER. CAST IRON, CONCRETE OR TERRA COTTA ACCEPTED.


\*INSTALLER IS RESPONSIBLE FOR OBTAINING FINAL APPROVAL ON THIS PERMIT.  
\*first good ground starts at 9-10' rest of ground clay  
SK

P31654

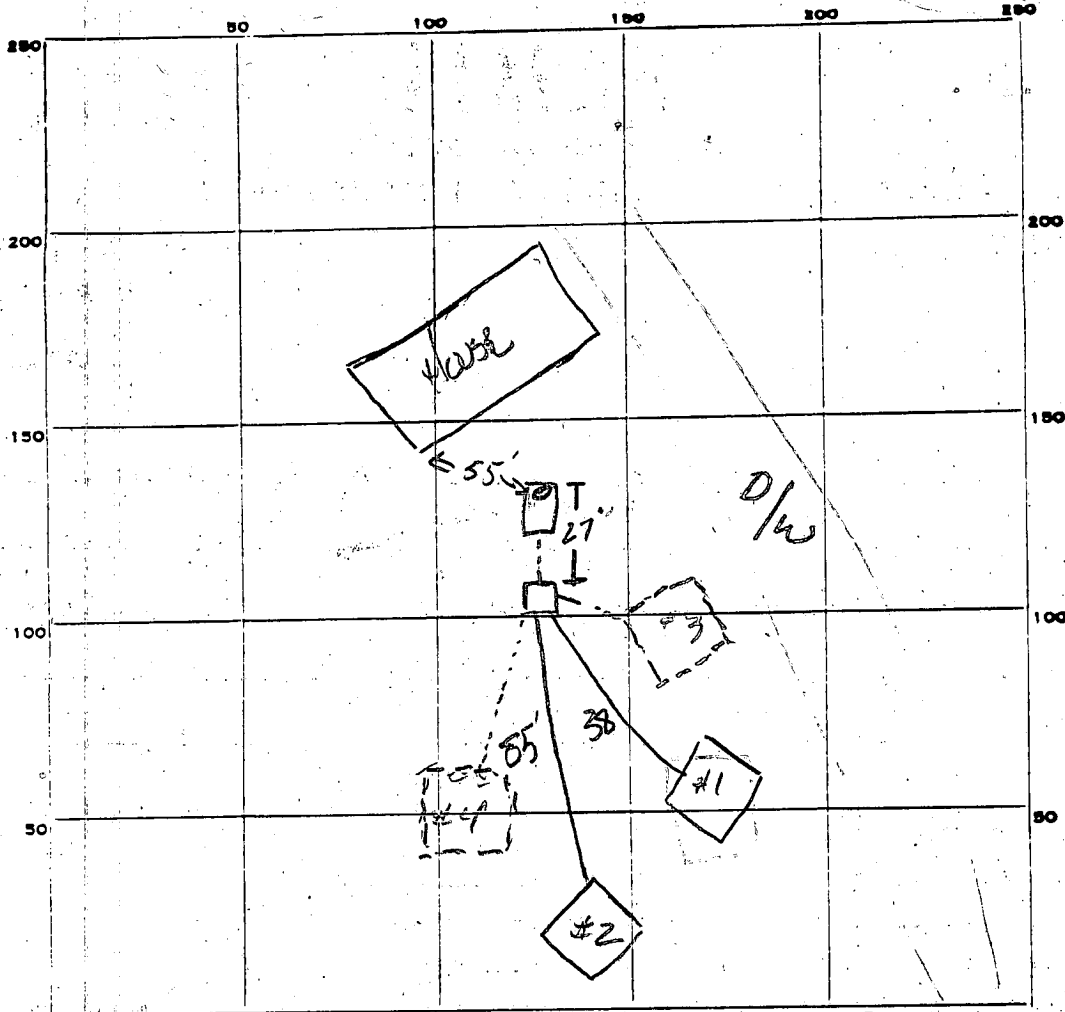

INDICATE NORTH - NAME ADJOINING ROADWAY AS BASE LINE.

FLORENCE

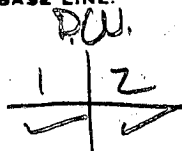

PERMIT CARD

SEPTIC TANK, LEVEL \_\_\_\_\_

CLEANOUTS

DISTRIBUTION BOX, LEVEL

TILE FIELD, DEPTH \_\_\_\_\_ FT. TRENCH WIDTH \_\_\_\_\_ FT.

GRAVEL DEPTH \_\_\_\_\_ IN. TOTAL LENGTH \_\_\_\_\_ FT.

NUMBER OF TRENCHES \_\_\_\_\_ TOTAL BOTTOM AREA \_\_\_\_\_

SEEPAGE PITS, INSIDE DIAMETER 

60'	60'
1	2

 FT. DEPTH BELOW INLET 

8'	8'
1	2

 FT.

ABSORBENT AREA 

120	300
1	2

 SQ. FT.

420  $\phi$  Total

REMARKS 11/2/61 effective area #1 is 2'-3', #2 is 4'-5'. D/W will feed DW #1 & #2 first. Lines for #1 & #2 are 2'-3" higher than lines for #3 & #4

DATE SYSTEM APPROVED

11/2/81

INSPECTOR

Stephen A. Reid