

10/20/81  
pm  
10/21/81  
11:00 AM

Approved: 10/21/81  
S.G. Kill

# PERMIT

P 31674  
A Repair

SEWAGE DISPOSAL SYSTEM  
MARYLAND STATE DEPARTMENT OF HEALTH

HOWARD COUNTY

ELLICOTT CITY

INDEX

DISTRICT 5th

05-342066

DATE 10/20/81

Olen Ketterman IS PERMITTED TO INSTALL \_\_\_\_\_ ALTER X

ADDRESS 14960 Frederick Road, Woodbine, Md. 21797 PHONE 442-1336

SUBDIVISION \_\_\_\_\_ ROAD 10460 Owen Brown Road LOT \_\_\_\_\_

PROPERTY OWNER Mr. F. E. Heinz JEKRY'S DRIVE +

ADDRESS 10460 Owen Brown Road, Columbia, Maryland 21044 Phone: 730-0860

SPECIFICATIONS

SEPTIC TANK CAPACITY \_\_\_\_\_ GALLONS  
DRAIN FIELD \_\_\_\_\_ DEPTH \_\_\_\_\_ FEET, BOTTOM AREA \_\_\_\_\_ SQ. FT.  
DEEP TRENCH 11 DEPTH 60' FEET, BOTTOM AREA \_\_\_\_\_ SQ. FT.  
SEEPAGE PITS \_\_\_\_\_ ABSORBENT SIDE-WALL AREA 360' SQ. FT.  
INLET PIPE 5 FT. BELOW ORIGINAL GRADE. MAXIMUM DEPTH 5 FT. BELOW ORIGINAL GRADE  
EFFECTIVE DEPTH AT 5'-11 FT. BELOW ORIGINAL GRADE.  
LOCATE DISPOSAL AREA \_\_\_\_\_ FT. FROM \_\_\_\_\_ LOT LINE AND \_\_\_\_\_ FT. FROM \_\_\_\_\_ LOT LINE AS SEEN WHEN  
FACING LOT FROM 5' OFF OLD DRY WELL


REPAIR - Call for an appointment when ground is opened up and Sanitarian will  
recommend the repair system.

PLANS APPROVED BY Palmer F. Wine DATE 10/16/81

- COVER NO WORK UNTIL INSPECTED AND APPROVED.
- NEITHER THE HOWARD COUNTY COUNCIL NOR THE HEALTH DEPARTMENT IS RESPONSIBLE FOR THE SUCCESSFUL OPERATION OF ANY SYSTEM.
- NOTE: IF TRENCH IS USED CALL FOR INSPECTION BEFORE PLACING GRAVEL IN TRENCH.
- NOTE: NO DRY WELL SHALL EXCEED 15 FOOT IN DIAMETER.
- NOTE: ALL PIPE FROM HOUSE TO DISPOSAL AREA MUST BE CAST IRON.
- PERMIT VOID AFTER THREE YEARS.
- NOTE: INSTALL STAND PIPE ON SEPTIC TANK AND DRY WELL. STAND PIPES MUST BE 6 INCHES IN DIAMETER. CAST IRON, CONCRETE OR TERRA COTTA ACCEPTED.

\*INSTALLER IS RESPONSIBLE FOR OBTAINING FINAL APPROVAL ON THIS PERMIT.

31674

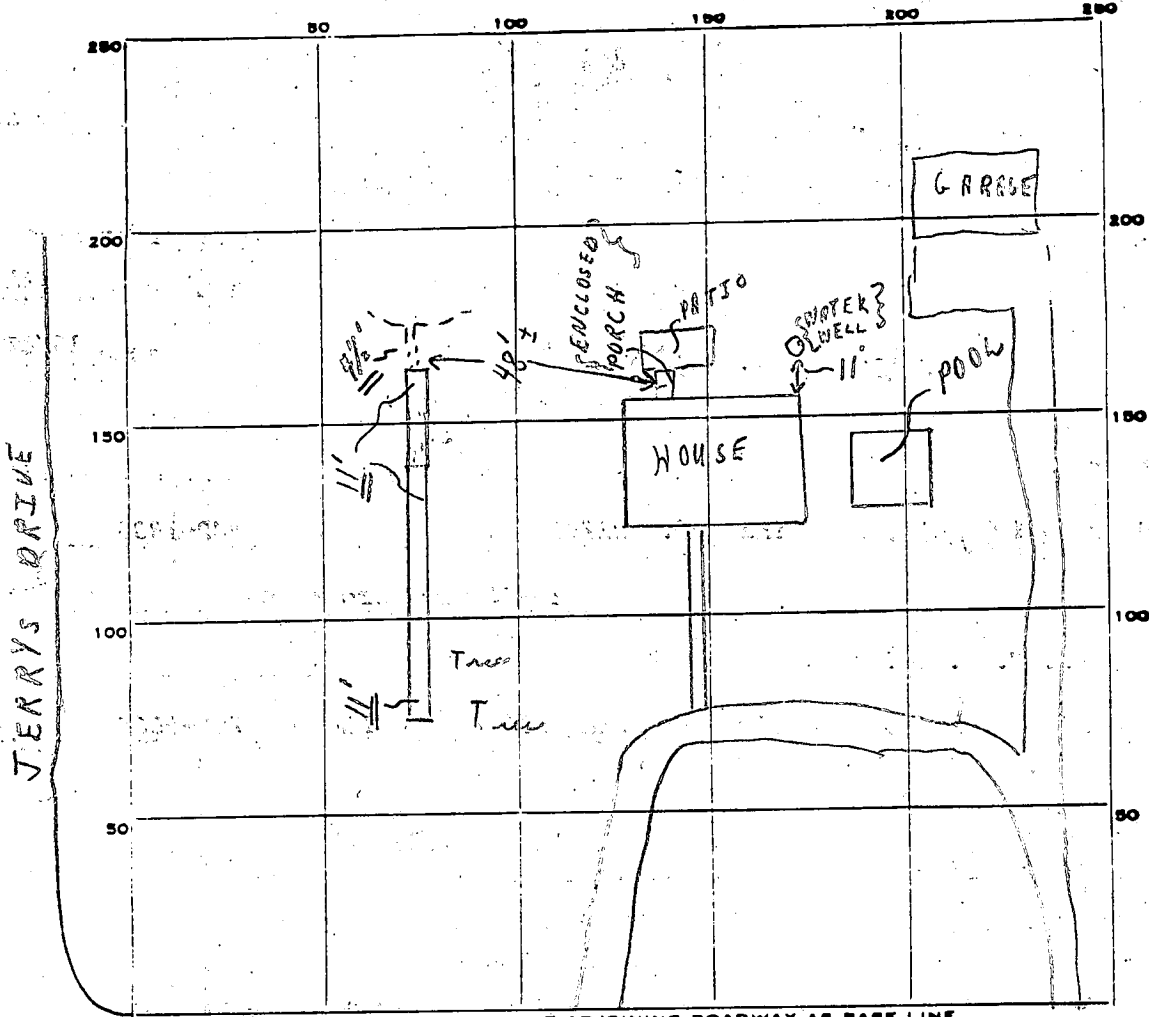

INDICATE NORTH. - NAME ADJOINING ROADWAY AS BASE LINE.

OWEN BROWN ROAD

PERMIT CARD

SEPTIC TANK, LEVEL N/A

CLEANOUTS N/A

DISTRIBUTION BOX, LEVEL N/A

TILE FIELD, DEPTH 11 AVG. FT. TRENCH WIDTH 2 FT.

GRAVEL DEPTH 6 IN. TOTAL LENGTH 63 FT.

NUMBER OF TRENCHES 1 TOTAL BOTTOM AREA 378  $\phi$

SEEPAGE PITS, INSIDE DIAMETER \_\_\_\_\_ FT. DEPTH BELOW INLET \_\_\_\_\_ FT.

ABSORBENT AREA \_\_\_\_\_ SQ. FT.

REMARKS 10/20/81 TRENCH OK FOR STONE ONLY;

10/21/81 cover all work - SIC C.B.E.

DATE SYSTEM APPROVED

10/21/81

INSPECTOR

Stephen A Kiel