

PERMIT

SEWAGE DISPOSAL SYSTEM

MARYLAND STATE DEPARTMENT OF HEALTH

HOWARD COUNTY

02-233770
INDEX

ELLICOTT CITY

DISTRICT 2nd

DATE 12/8/81

Approved 12/8/81
Stayed P 31752
A Repair

12/8/81
after 2:00 P.M.

Jack Fyock, Jr. IS PERMITTED TO INSTALL ALTER X

ADDRESS 13775 Triadelphia Road, Glenelg, Md. 21737 PHONE 988-9270

SUBDIVISION _____ ROAD 8644 Old Frederick Rd. LOT _____

PROPERTY OWNER Mrs. Mary S. Price

ADDRESS 8644 Old Frederick Rd, Ellicott City, Maryland 21043

SPECIFICATIONS

SEPTIC TANK CAPACITY _____ GALLONS

DRAIN FIELD _____ DEPTH _____ FEET, BOTTOM AREA _____ SQ. FT.

DEEP TRENCH _____ DEPTH _____ FEET, BOTTOM AREA _____ SQ. FT.

SEEPAGE PITS _____ ABSORBENT SIDE-WALL AREA _____ SQ. FT.

INLET PIPE _____ FT. BELOW ORIGINAL GRADE. MAXIMUM DEPTH _____ FT. BELOW ORIGINAL GRADE

EFFECTIVE DEPTH AT _____ FT. BELOW ORIGINAL GRADE.

LOCATE DISPOSAL AREA _____ FT. FROM _____ LOT LINE AND _____ FT. FROM _____ LOT LINE AS SEEN WHEN FACING LOT FROM

REPAIR - Call for inspection when ground is opened up so sanitarian can recommend repair.

New system - 1000 gal tanks, 50 ft trenches
1 1/2 ft deep, inlets 4 ft, 7 1/2 ft of stone

PLANS APPROVED BY Palmer F. Wine DATE December 3, 1981

COVER NO WORK UNTIL INSPECTED AND APPROVED.

NEITHER THE HOWARD COUNTY COUNCIL NOR THE HEALTH DEPARTMENT IS RESPONSIBLE FOR THE SUCCESSFUL OPERATION OF ANY SYSTEM.

NOTE: IF TRENCH IS USED CALL FOR INSPECTION BEFORE PLACING GRAVEL IN TRENCH.

NOTE: NO DRY WELL SHALL EXCEED 15 FOOT IN DIAMETER.


NOTE: ALL PIPE FROM HOUSE TO DISPOSAL AREA MUST BE CAST IRON.

PERMIT VOID AFTER THREE YEARS.

NOTE: INSTALL STAND PIPE ON SEPTIC TANK AND DRY WELL. STAND PIPES MUST BE 6 INCHES IN DIAMETER. CAST IRON, CONCRETE OR TERRA COTTA ACCEPTED.

*INSTALLER IS RESPONSIBLE FOR OBTAINING FINAL APPROVAL ON THIS PERMIT.

X P 31752

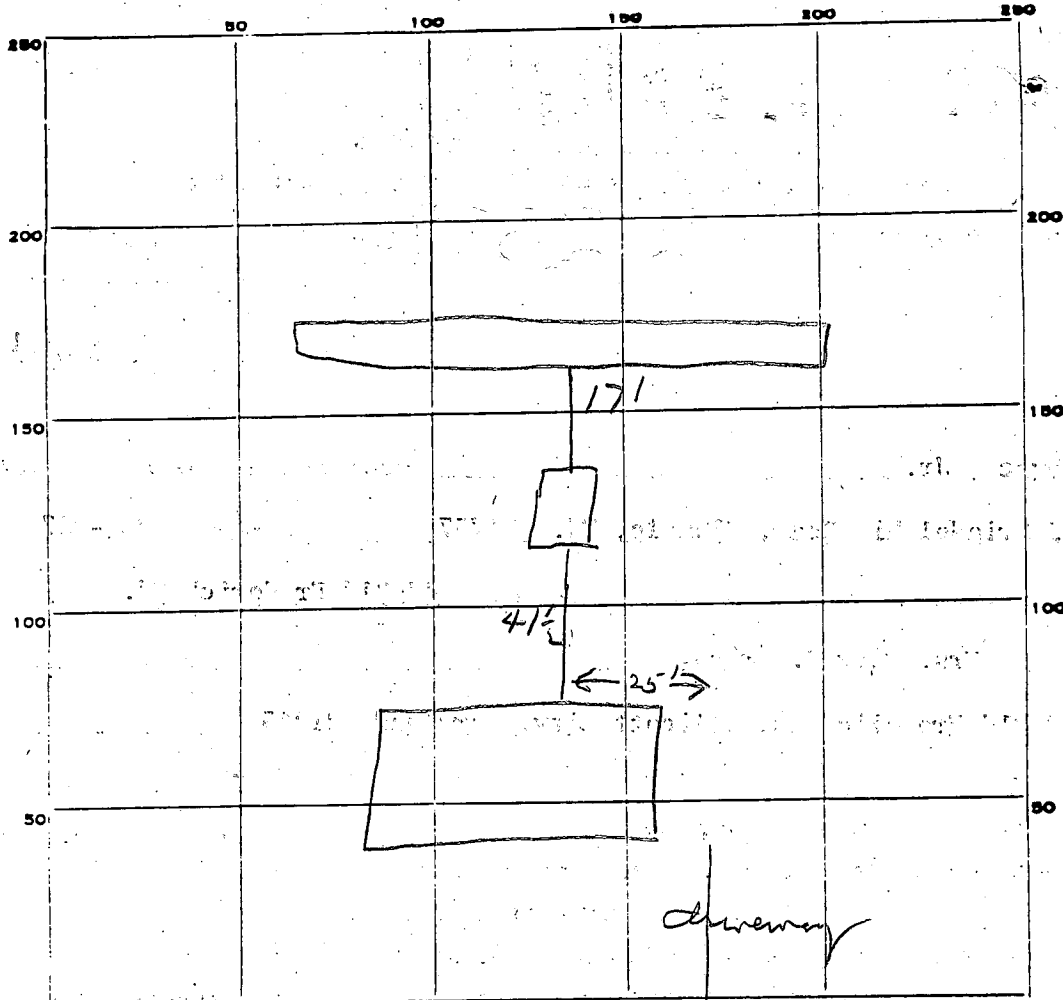

INDICATE NORTH. - NAME ADJOINING ROADWAY AS BASE LINE.

← Old Fred. Rd

PERMIT CARD _____

SEPTIC TANK, LEVEL _____ ✓

CLEANOUTS 5T

DISTRIBUTION BOX, LEVEL _____

TILE FIELD, DEPTH 11 1/2 FT. TRENCH WIDTH 2 FT.

GRAVEL DEPTH 7 1/2 IN. TOTAL LENGTH 52 FT.

NUMBER OF TRENCHES 1 TOTAL BOTTOM AREA _____

SEEPAGE PITS, INSIDE DIAMETER _____ FT. DEPTH BELOW INLET _____ FT.

ABSORBENT AREA _____ SQ. FT.

52
75
260
364
3900

REMARKS 12/8/81 OK to add stone in trench. js
12/8/81 OK to cover all work js

DATE SYSTEM APPROVED 12/8/81

INSPECTOR Stayer

Rec'd 12/23/81

FILE: Sewage Odor Nuisance

DATE REPORTED 11/17/81

PROPERTY OWNER Prices?

P.O. ADDRESS 8644 Old Fredrick Rd. TELEPHONE

DIRECTIONS TO PROPERTY near Daniels Road

INFORMANT (Please Keep Anonymus) Ronald Bridner home 465-4637 work 465-7459

8656 Old Fredrick Rd.

Ellicott City, Md.

informant states that in the last year his neighbor has altered the (cesspool) sewage disposal system on his lot and created an odor problem.

CONDITION FOUND 11/23/81 3:00-3:30 P.M. SPOKE WITH ONE OF OWNERS MRS. PRICE

@ SITE. NOTE NO OVERFLOW THIS DATE; NO ODORS OF A HEALTH NUISANCE OBSERVED THIS DATE. - HOWEVER

ON A MORE WINDY/HUMID DAY - ODOR MAY BE MORE NOTICEABLE - SEE OTHER SIDE - PLEASE, (LEFT CARD) PERSONAL SERV.

FOR RECOMMENDATIONS. [ON 12/23/81 AFTER FIELD CHECK - CHECK ON PUBLIC SEWER AVAILABILITY ALSO. SEC. 11/23/81 Write. C.B.S.]


ACTION TAKEN w/ bill "33" per D.T.O.V. - see 12/23/81 C.B.S.

Follow up - 12/28/81 - Repair completed on 12/8/81 and inspected and approved by Mr. Stages of Water & Sewer - Howard County Health Dept. C.B.S. program


FINAL DISPOSITION

{ PUBLIC WATER SERVES PROPERTY }
PER MRS. PRICE

VENT TO TOP OR SIDE

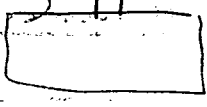

NEW BLOCK FOUNDATION

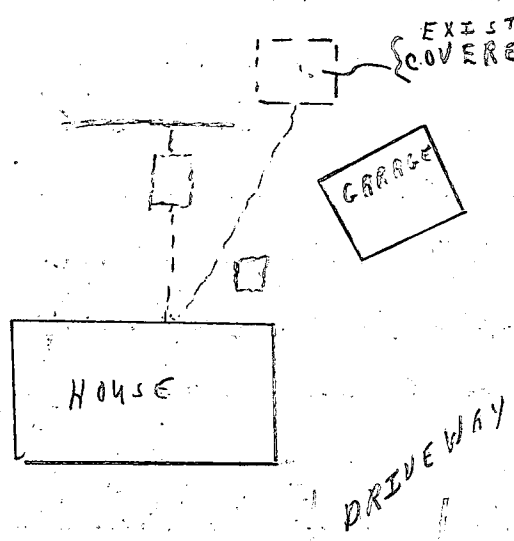

EXISTING COVERED HOLDING TANK } RECOMMEND NOT AIR TIGHT

- (1) WORK START TO PUT ANOTHER LAYER OF BLOCK AROUND LID & DR ROOF TO MAKE IT AIR TIGHT WITH A VENT. (SEE ABOVE)
- (2) SCREEN AREA WITH PINE TREES
- (3) CHECK ^{NOT AVAILABLE} _{1/25/81} PUBLIC SEWER AVAILABILITY
- (4) RECALL 12/23/81 AND CHECK PROGRESS. & OR FOR OVERFLOW OF SEWAGE
{ NOTE PIT 1'-2' FROM TOP - 11/23/81 c.b.d.