

7/25/84

Approved 7/25/84
Stayed
P 31754
A REPAIR

PERMIT

SEWAGE DISPOSAL SYSTEM

MARYLAND STATE DEPARTMENT OF HEALTH*

HOWARD COUNTY

OS-364523

ELLICOTT CITY

DISTRICT _____

INDEX

DATE 12/8/81

~~Bob Orndorff~~ Jack Fyock IS PERMITTED TO INSTALL _____ ALTER

ADDRESS ~~7469 Flamewood Dr.~~ PHONE 776-0444

SUBDIVISION _____ ROAD 7701 Pendell Sch. Rd. LOT _____
(between Wayneridge & ...)

PROPERTY OWNER Maple Lawn Farms, Inc.

ADDRESS 7701 Pendell School Road, Fulton, Maryland

SPECIFICATIONS

SEPTIC TANK CAPACITY _____ GALLONS

DRAIN FIELD _____ DEPTH _____ FEET, BOTTOM AREA _____ SQ. FT.

DEEP TRENCH _____ DEPTH _____ FEET, BOTTOM AREA _____ SQ. FT.

SEEPAGE PITS _____ ABSORBENT SIDE-WALL AREA _____ SQ. FT.

INLET PIPE _____ FT. BELOW ORIGINAL GRADE. MAXIMUM DEPTH _____ FT. BELOW ORIGINAL GRADE

EFFECTIVE DEPTH AT _____ FT. BELOW ORIGINAL GRADE.

LOCATE DISPOSAL AREA _____ FT. FROM _____ LOT LINE AND _____ FT. FROM _____ LOT LINE AS SEEN WHEN FACING LOT FROM


REPAIR - CALL FOR INSPECTION WHEN GROUND IS OPENED UP SO SANITARIAN CAN RECOMMEND REPAIR.

PLANS APPROVED BY Palmer F. Wine DATE December 8, 1981

- COVER NO WORK UNTIL INSPECTED AND APPROVED.
- NEITHER THE HOWARD COUNTY COUNCIL NOR THE HEALTH DEPARTMENT IS RESPONSIBLE FOR THE SUCCESSFUL OPERATION OF ANY SYSTEM.
- NOTE: IF TRENCH IS USED CALL FOR INSPECTION BEFORE PLACING GRAVEL IN TRENCH.
- NOTE: NO DRY WELL SHALL EXCEED 15 FOOT IN DIAMETER.
- NOTE: ALL PIPE FROM HOUSE TO DISPOSAL AREA MUST BE CAST IRON.
- PERMIT VOID AFTER THREE YEARS.
- NOTE: INSTALL STAND PIPE ON SEPTIC TANK AND DRY WELL. STAND PIPES MUST BE 6 INCHES IN DIAMETER. CAST IRON, CONCRETE OR TERRAZO ACCEPTED.

*INSTALLER IS RESPONSIBLE FOR OBTAINING FINAL APPROVAL ON THIS PERMIT.

A 31754

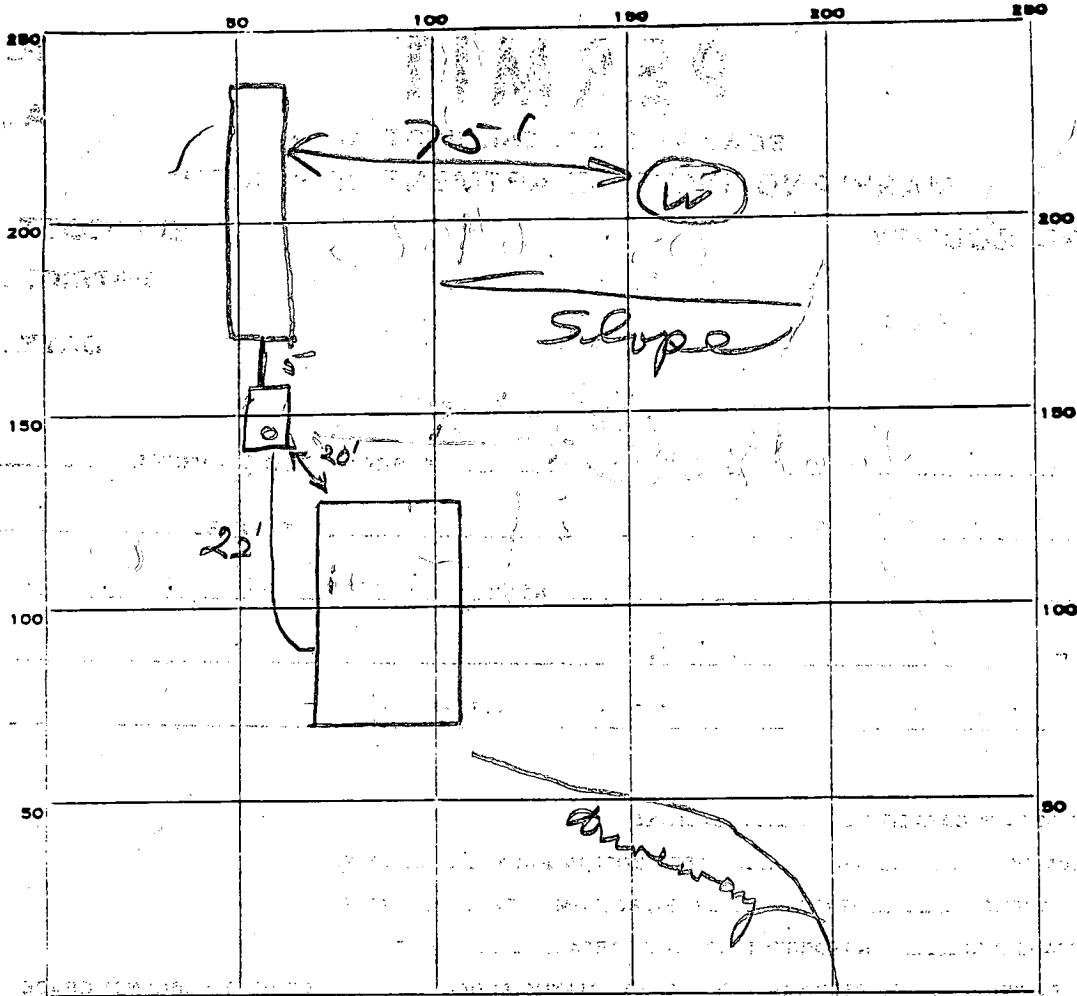

INDICATE NORTH. - NAME ADJOINING ROADWAY AS BASE LINE.

Purdell School Rd.

PERMIT CARD

SEPTIC TANK, LEVEL 1000 gal CLEANOUTS 5T

DISTRIBUTION BOX, LEVEL _____

TILE FIELD, DEPTH 4 1/2 FT. TRENCH WIDTH 8 FT.

GRAVEL DEPTH 2 IN. TOTAL LENGTH 65 FT.

NUMBER OF TRENCHES 1 TOTAL BOTTOM AREA 520

SEEPAGE PITS, INSIDE DIAMETER _____ FT. DEPTH BELOW INLET _____ FT.

ABSORBENT AREA 520 SQ. FT.

REMARKS 7/25/84 water at 9 ft.
OK to cover all work. JS

DATE SYSTEM APPROVED 7/25/84 INSPECTOR Stayer