

8/10/81
Settle
1:00 P.M.

Approved 8/10/81

AG Kiel

P 31069

A Repair

PERMIT

SEWAGE DISPOSAL SYSTEM

MARYLAND STATE DEPARTMENT OF HEALTH

HOWARD COUNTY

02-252341

ELLICOTT CITY

DISTRICT 2nd

INDEX

DATE _____

Olen Ketterman IS PERMITTED TO INSTALL _____ ALTER X

ADDRESS 14960 Frederick Road, Woodbine, Md. 21797 PHONE 442-1336

SUBDIVISION _____ ROAD 3952 Cook's Lane LOT _____

PROPERTY OWNER Wilhide's Florist

ADDRESS Cook's Lane, Ellicott City, Maryland 21043

SPECIFICATIONS

SEPTIC TANK CAPACITY _____ GALLONS

DRAIN FIELD _____ DEPTH _____ FEET, BOTTOM AREA _____ SQ. FT.

DEEP TRENCH _____ DEPTH _____ FEET, BOTTOM AREA _____ SQ. FT.

SEEPAGE PITS _____ ABSORBENT SIDE-WALL AREA _____ SQ. FT.

INLET PIPE _____ FT. BELOW ORIGINAL GRADE. MAXIMUM DEPTH _____ FT. BELOW ORIGINAL GRADE

EFFECTIVE DEPTH AT _____ FT. BELOW ORIGINAL GRADE.

LOCATE DISPOSAL AREA _____ FT. FROM _____ LOT LINE AND _____ FT. FROM _____ LOT LINE AS SEEN WHEN FACING LOT FROM

REPAIR - Call for an appointment when ground is opened up and Sanitarian will recommend the repair system.

8/10/81 one trench, 30' long inlet at 3', Max depth 11'
8' stone below pipe - sk

PLANS APPROVED BY Palmer F. Wine DATE 12/1/80

COVER NO WORK UNTIL INSPECTED AND APPROVED.

NEITHER THE HOWARD COUNTY COUNCIL NOR THE HEALTH DEPARTMENT IS RESPONSIBLE FOR THE SUCCESSFUL OPERATION OF ANY SYSTEM.

NOTE: IF TRENCH IS USED CALL FOR INSPECTION BEFORE PLACING GRAVEL IN TRENCH.

NOTE: NO DRY WELL SHALL EXCEED 15 FOOT IN DIAMETER.

NOTE: ALL PIPE FROM HOUSE TO DISPOSAL AREA MUST BE CAST IRON.

PERMIT VOID AFTER THREE YEARS.


NOTE: INSTALL STAND PIPE ON SEPTIC TANK AND DRY WELL. STAND PIPES MUST BE 6 INCHES IN DIAMETER. CAST IRON, CONCRETE OR TERRA COTTA ACCEPTED.

BUDG. PERMIT SIGNED AND RETURNED 11/22/88

Serial # 22568 -
Master Bath Suite

***INSTALLER IS RESPONSIBLE FOR OBTAINING FINAL APPROVAL ON THIS PERMIT.**

AP31069

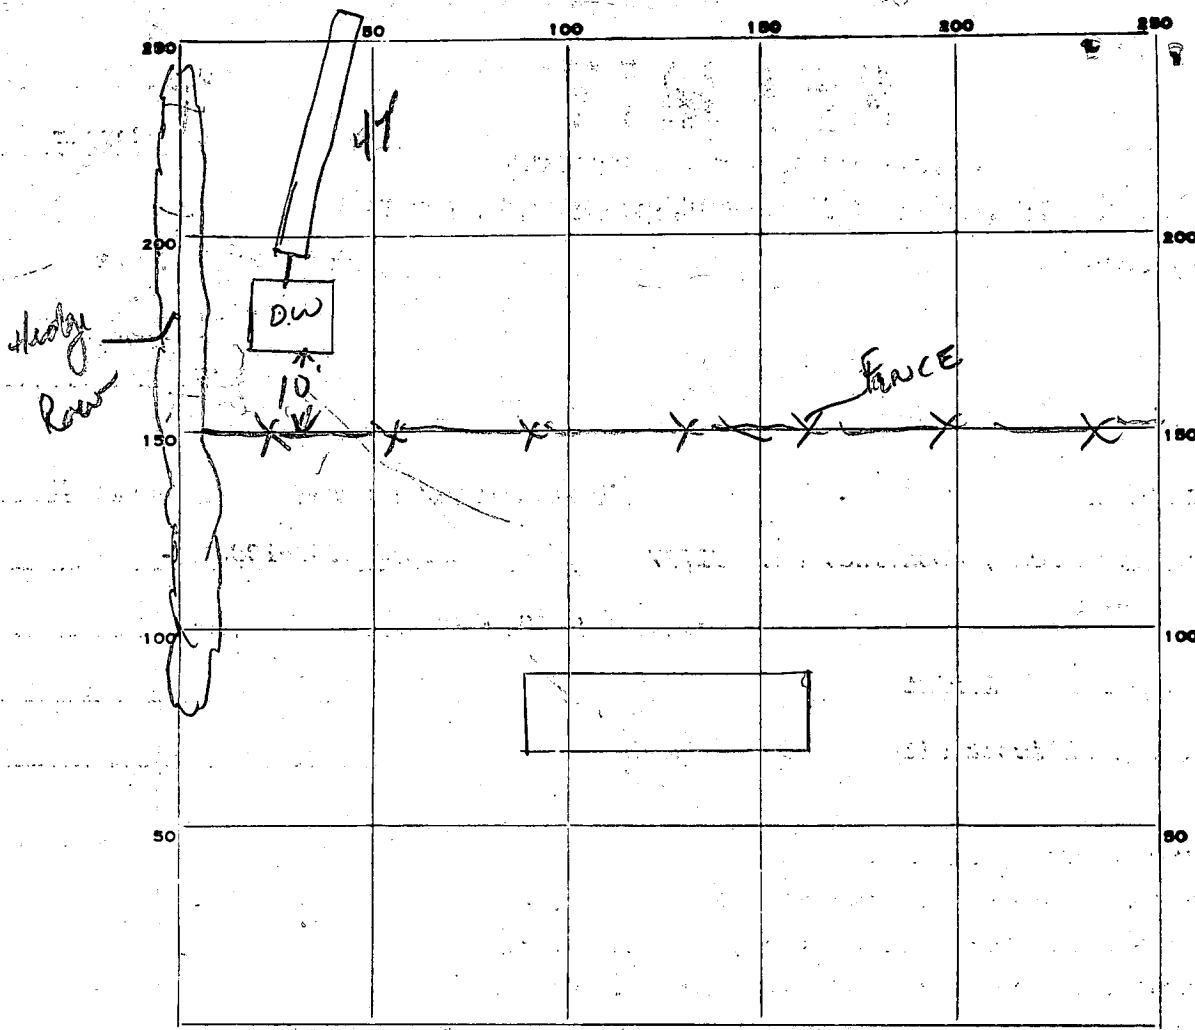

INDICATE NORTH. - NAME ADJOINING ROADWAY AS BASE LINE.

LOOKS LAKE

PERMIT CARD No

SEPTIC TANK, LEVEL NA

CLEANOUTS NA

DISTRIBUTION BOX, LEVEL _____

TILE FIELD, DEPTH 11' FT. TRENCH WIDTH 2 FT.

GRAVEL DEPTH 8' IN. TOTAL LENGTH 17' FT.

NUMBER OF TRENCHES 1 1/2 SIDEWALL TOTAL BOTTOM AREA 376 \neq

SEEPAGE PITS, INSIDE DIAMETER _____ FT. DEPTH BELOW INLET _____ FT.



ABSORBENT AREA _____ SQ. FT.

REMARKS 8/10/81 OK to add gravel to Trench, SK - 8/10/81
Cover all work SK

DATE SYSTEM APPROVED 8/10/81

INSPECTOR Stephen G. Paul


HOWARD
HEALTH
12 13 15 03 AM '80
PUBLIC
ENVIRONMENTAL
HEALTH

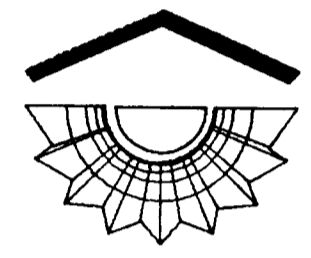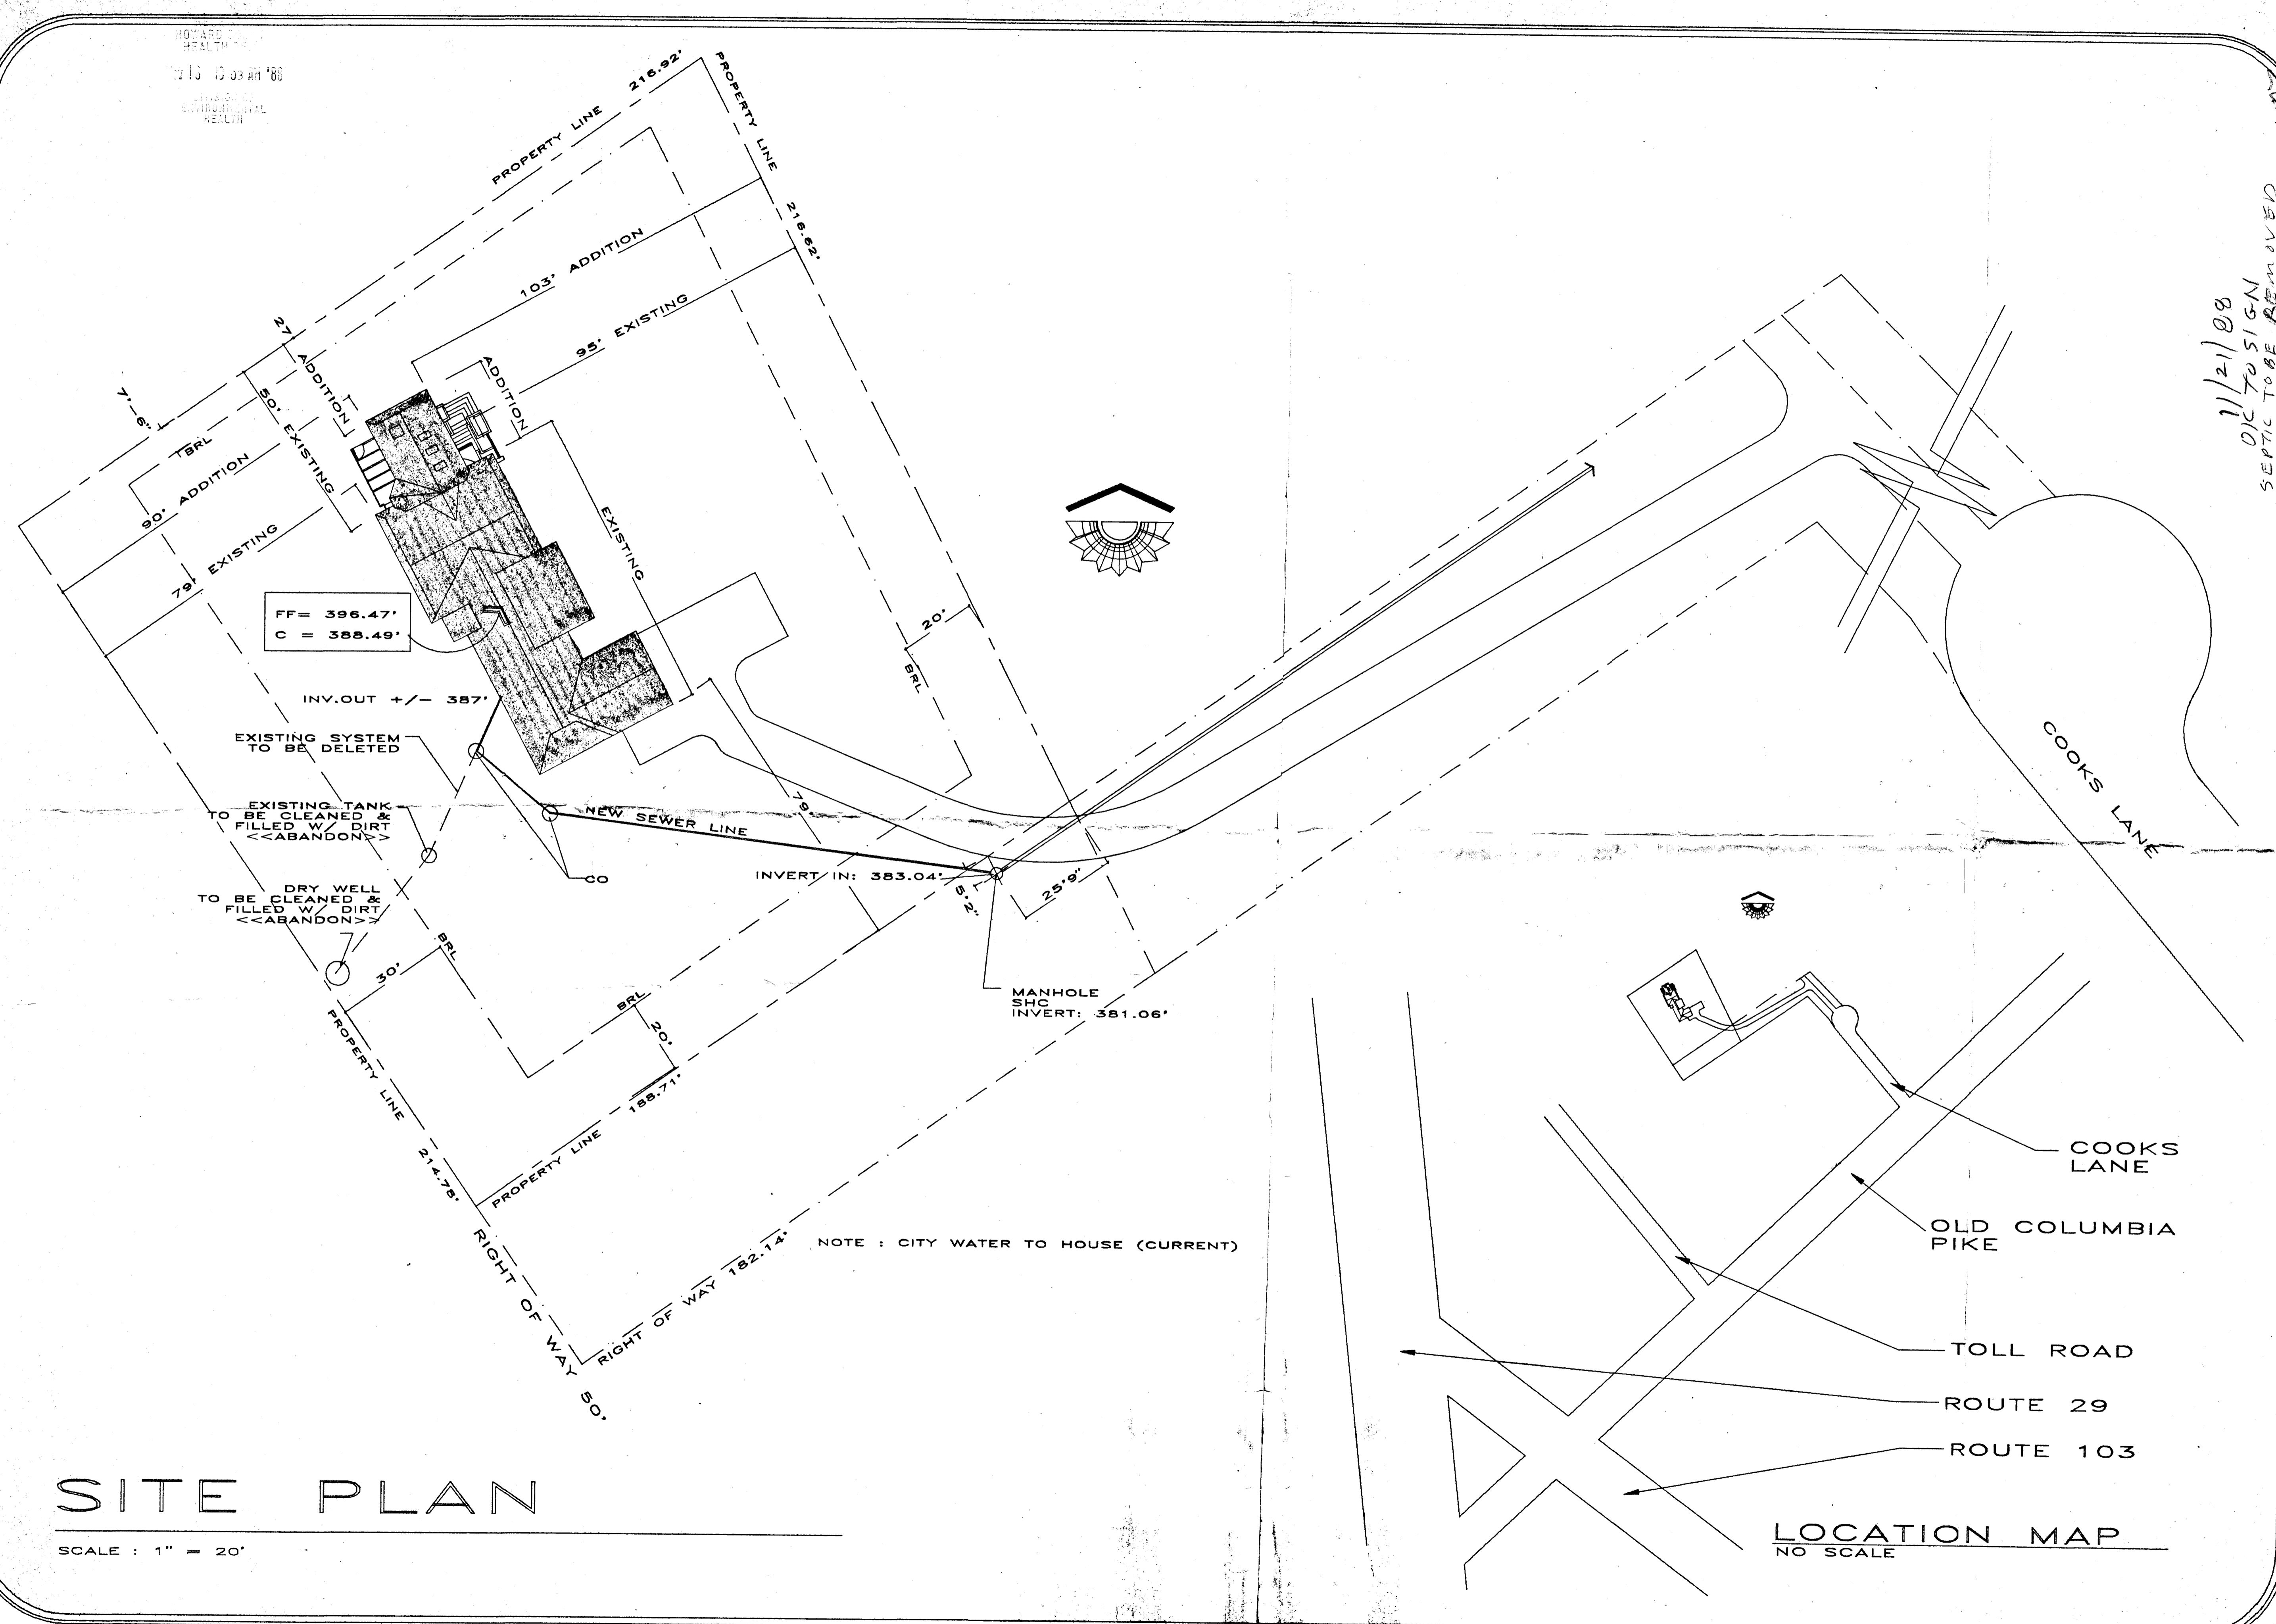

1/21/88
D/C TO SIGN
SEPTIC TO BE REMOVED
& NOT REAR ADDITION A.M.M.

SITE PLAN

SCALE : 1" = 20'

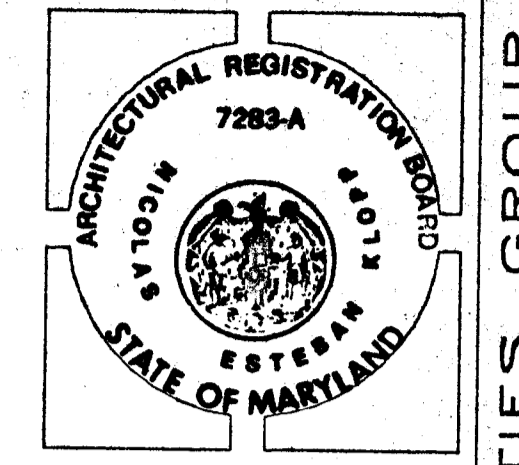

SITE PLAN

LEON E. WILHIDE JR. & BEVERLY L. WILHIDE

3952 COOKS LANE / ELLICOTT CITY / HO.CO ADDITION NOV. 4 '88

301-792-8099

KoppDesign/CM NATIONAL FACILITIES GROUP

