

12/5/81
9:30 A.M.
3/1/82
3:15 p.m.
Please

approved
Stayed
3/1/82
P 31772
A REPAIR

PERMIT

SEWAGE DISPOSAL SYSTEM

MARYLAND STATE DEPARTMENT OF HEALTH

HOWARD COUNTY

02-212870

ELLICOTT CITY

DISTRICT ^{2nd.}

DATE 12/28/81

INDEX

Jeff Mathema

IS PERMITTED TO INSTALL ALTER X

ADDRESS 10218 Davis Avenue, Woodstock, Md. 21163 PHONE 328-2265

SUBDIVISION Brittany ROAD 8498 Roberts Road LOT

PROPERTY OWNER Jim Graham

ADDRESS 8498 Roberts Road

SPECIFICATIONS 1st left stone crest wells
1st shut w right - 7

SEPTIC TANK CAPACITY _____ GALLONS

DRAIN FIELD _____ DEPTH _____ FEET, BOTTOM AREA _____ SQ. FT.

DEEP TRENCH _____ DEPTH _____ FEET, BOTTOM AREA _____ SQ. FT.

SEEPAGE PITS _____ ABSORBENT SIDE-WALL AREA _____ SQ. FT.

INLET PIPE _____ FT. BELOW ORIGINAL GRADE. MAXIMUM DEPTH _____ FT. BELOW ORIGINAL GRADE

EFFECTIVE DEPTH AT _____ FT. BELOW ORIGINAL GRADE.

LOCATE DISPOSAL AREA _____ FT. FROM _____ LOT LINE AND _____ FT. FROM _____ LOT LINE AS SEEN WHEN

FACING LOT FROM

REPAIR - CALL FOR INSPECTION WHEN GROUND IS OPENED UP SO SANITARIAN CAN RECOMMEND REPAIR.

New dry well in front yard center, 25 ft from
Roberts Rd. Dry well to be 10 deep, inlet at 2 ft
Dist. box to be used to connect old & new dry wells.

PLANS APPROVED BY Palmer F. Wine DATE 12/28/81

COVER NO WORK UNTIL INSPECTED AND APPROVED.

NEITHER THE HOWARD COUNTY COUNCIL NOR THE HEALTH DEPARTMENT IS RESPONSIBLE FOR THE SUCCESSFUL OPERATION OF ANY SYSTEM.

NOTE: IF TRENCH IS USED CALL FOR INSPECTION BEFORE PLACING GRAVEL IN TRENCH.

NOTE: NO DRY WELL SHALL EXCEED 15 FOOT IN DIAMETER.


NOTE: ALL PIPE FROM HOUSE TO DISPOSAL AREA MUST BE CAST IRON.

PERMIT VOID AFTER THREE YEARS.

NOTE: INSTALL STAND PIPE ON SEPTIC TANK AND DRY WELL. STAND PIPES MUST BE 6 INCHES IN DIAMETER. CAST IRON, CONCRETE OR TERRA COTTA ACCEPTED.

***INSTALLER IS RESPONSIBLE FOR OBTAINING FINAL APPROVAL ON THIS PERMIT.**

X P 31772

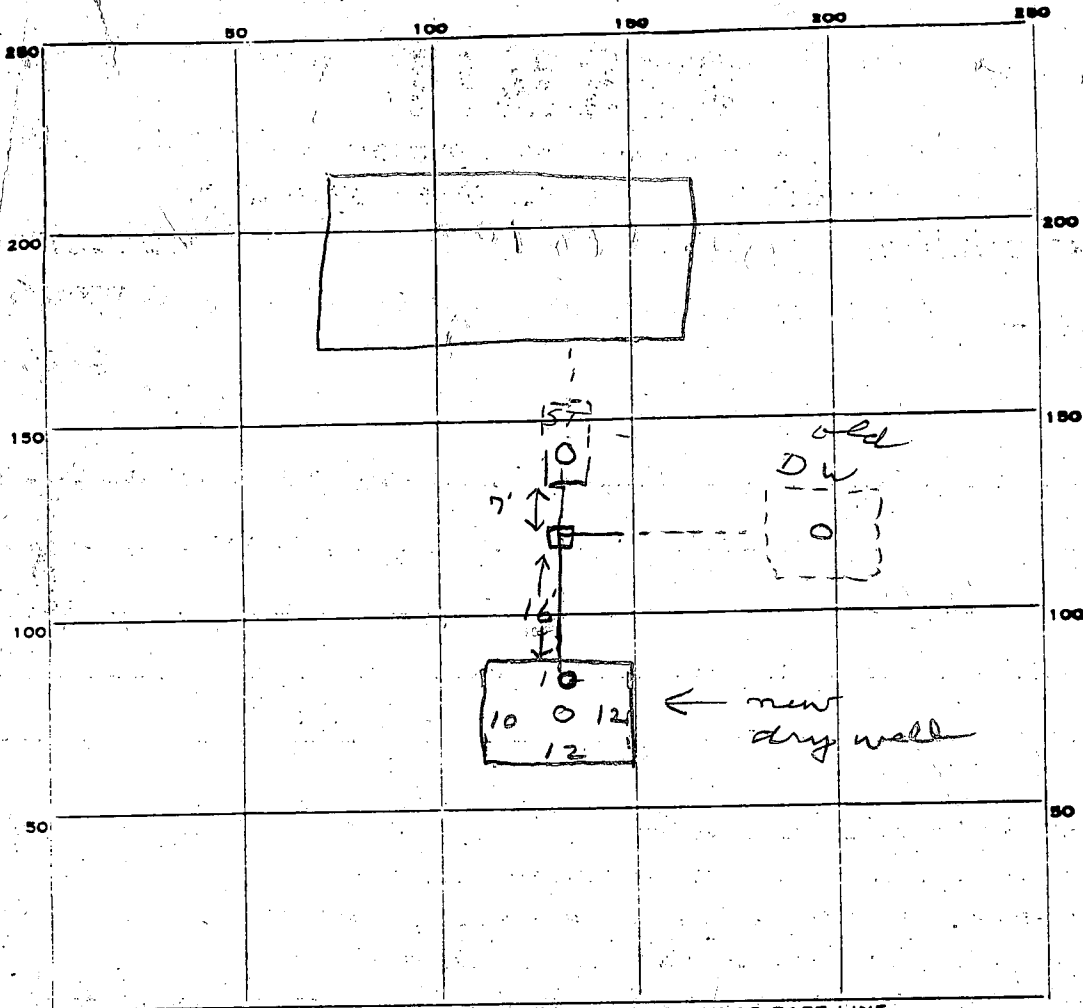

INDICATE NORTH - NAME ADJOINING ROADWAY AS BASE LINE.

Roberts Rd

PERMIT CARD _____

SEPTIC TANK, LEVEL _____

CLEANOUTS _____ *DW*

DISTRIBUTION BOX, LEVEL

TILE FIELD, DEPTH _____ FT. TRENCH WIDTH _____ FT.

GRAVEL DEPTH _____ IN. TOTAL LENGTH _____ FT.

NUMBER OF TRENCHES _____ TOTAL BOTTOM AREA _____

SEEPAGE PITS, INSIDE DIAMETER *44* FT. DEPTH BELOW INLET *8* FT.

ABSORBENT AREA *352* SQ. FT.

REMARKS *12/29/81 Hole dug 13 ft deep, 1 ft clay loam at top then sandy loam. JS*
3/1/82 OK to cover all work. JS

DATE SYSTEM APPROVED *3/1/82*

INSPECTOR *Stayer*