

4/12/82
9:30 A.M.

approved 4/1/82
stayed P 3/830
A Repair

PERMIT

SEWAGE DISPOSAL SYSTEM

MARYLAND STATE DEPARTMENT OF HEALTH

HOWARD COUNTY

05-367520

ELLICOTT CITY

INDEX

DISTRICT 5th

DATE 3/10/82

Jack Fyock

IS PERMITTED TO INSTALL _____ ALTER X

ADDRESS 13775 Triadelphia Road, Glenelg, Md. 21737

PHONE 988-9270

SUBDIVISION Greenwood Farms

ROAD 7533 Greenwood Drive

LOT 47, Sec 3

PROPERTY OWNER Walter B. Parish

ADDRESS 7533 Greenwood Drive, Highland, Maryland 20777

Phone: 596-9246

SPECIFICATIONS

SEPTIC TANK CAPACITY _____ GALLONS

DRAIN FIELD _____ DEPTH _____ FEET, BOTTOM AREA _____ SQ. FT.

DEEP TRENCH _____ DEPTH _____ FEET, BOTTOM AREA _____ SQ. FT.

SEEPAGE PITS _____ ABSORBENT SIDE-WALL AREA _____ SQ. FT.

INLET PIPE _____ FT. BELOW ORIGINAL GRADE. MAXIMUM DEPTH _____ FT. BELOW ORIGINAL GRADE

EFFECTIVE DEPTH AT _____ FT. BELOW ORIGINAL GRADE.

LOCATE DISPOSAL AREA _____ FT. FROM _____ LOT LINE AND _____ FT. FROM _____ LOT LINE AS SEEN WHEN

FACING LOT FROM

REPAIR - Call for an appointment when ground is opened up and Sanitarian will

recommend the repair system.

Trench, 60 ft long. Inlets at 3 ft max depth 10 ft with 7 ft of stone

PLANS APPROVED BY Palmer F. Wine

DATE 3/10/82

COVER NO WORK UNTIL INSPECTED AND APPROVED.

NEITHER THE HOWARD COUNTY COUNCIL NOR THE HEALTH DEPARTMENT IS RESPONSIBLE FOR THE SUCCESSFUL OPERATION OF ANY SYSTEM.

NOTE: IF TRENCH IS USED CALL FOR INSPECTION BEFORE PLACING GRAVEL IN TRENCH.

NOTE: NO DRY WELL SHALL EXCEED 15 FOOT IN DIAMETER.

NOTE: ALL PIPE FROM HOUSE TO DISPOSAL AREA MUST BE CAST IRON.

PERMIT VOID AFTER THREE YEARS.

NOTE: INSTALL STAND PIPE ON SEPTIC TANK AND DRY WELL. STAND PIPES MUST BE 6 INCHES IN DIAMETER. CAST IRON, CONCRETE OR TERRA COTTA ACCEPTED.

***INSTALLER IS RESPONSIBLE FOR OBTAINING FINAL APPROVAL ON THIS PERMIT.**


BLDG. PERMIT SIGNED

AND RETURNED 8/1/83

Serial # 53723

P.M.

3/830

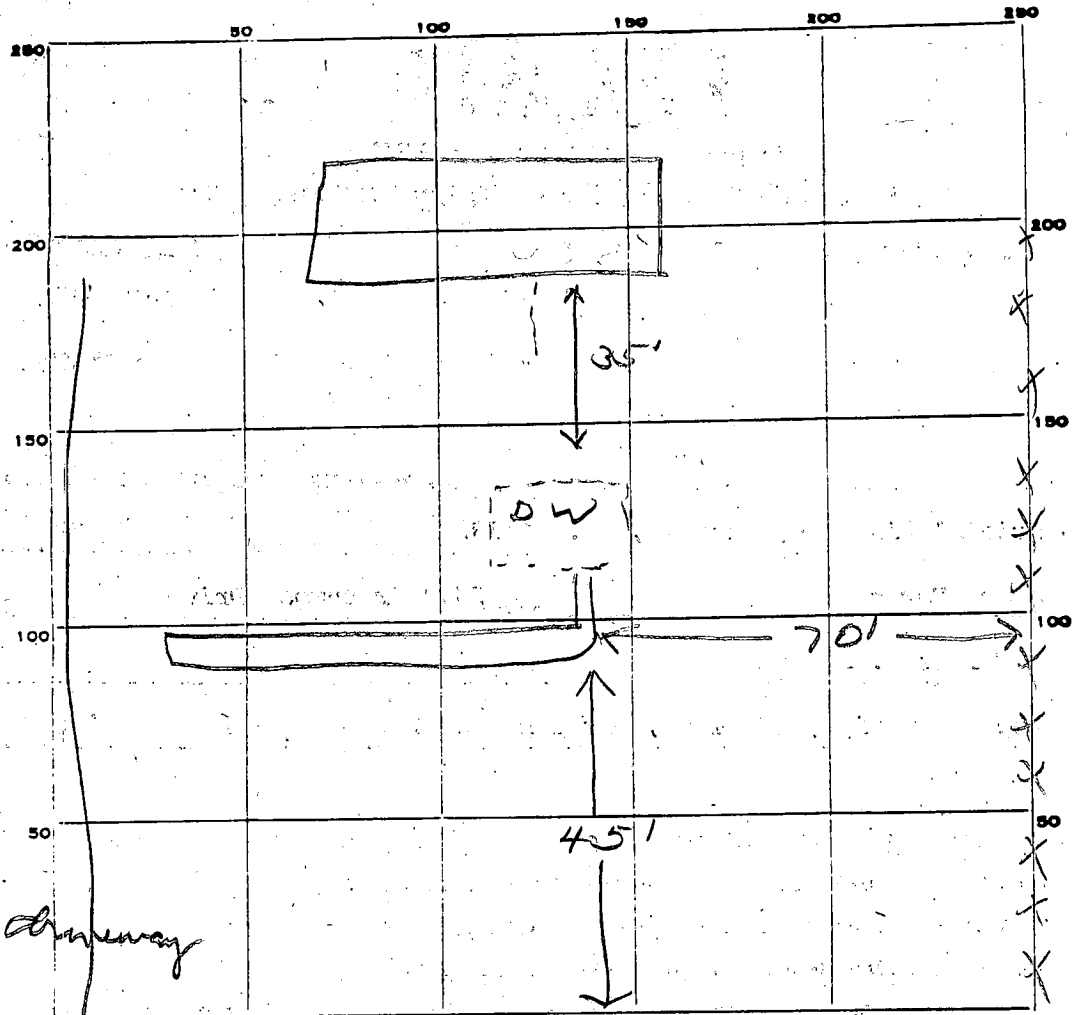

INDICATE NORTH. - NAME ADJOINING ROADWAY AS BASE LINE.

Greenwood Dr.

PERMIT CARD _____

SEPTIC TANK, LEVEL _____

CLEANOUTS _____

DISTRIBUTION BOX, LEVEL _____

TILE FIELD, DEPTH 10 FT. TRENCH WIDTH 2 FT.

GRAVEL DEPTH 7 IN. TOTAL LENGTH 60 FT.

NUMBER OF TRENCHES 1 TOTAL BOTTOM AREA 420

SEEPAGE PITS, INSIDE DIAMETER _____ FT. DEPTH BELOW INLET _____ FT.

ABSORBENT AREA 420 SQ. FT.

REMARKS 4/1/82 OK to add stone in trenches. jf
4/1/82 OK to cover all work jf

DATE SYSTEM APPROVED 4/1/82 INSPECTOR Stayer

PERMIT

SEWAGE DISPOSAL SYSTEM

MARYLAND STATE DEPARTMENT OF HEALTH

HOWARD COUNTY

ELLICOTT CITY

DISTRICT 5

DATE 11/25/69

P 14985

A 11110

*app 12/19/69
R. Tamm*

*12/8/69
11/19/69*

INDEXED

Jack Fyock IS PERMITTED TO INSTALL ALTER

ADDRESS Ten Oak Road, Glenelg, Maryland PHONE 286#2939

A SEWAGE DISPOSAL SYSTEM LOCATED AT _____

SUBDIVISION Greenwood Farms ROAD Greenwood Dr. LOT 47, Sec. 3

PROPERTY OWNER Walter B. Parish

ADDRESS _____

SPECIFICATIONS - 3 bedrooms

DRAIN FIELD _____ DEPTH _____ FEET, BOTTOM AREA _____ SQ. FT.

SEEPAGE PITS _____ ABSORBENT SIDE-WALL AREA _____ SQ. FT.

SEPTIC TANK CAPACITY 750 GALLONS

FOR GARBAGE GRINDER, INCREASE DISPOSAL AREA 22% & TANK CAPACITY 50%.

OTHER Dry well 12 ft. in dia. by 8 ft. deep below the inlet located 43 ft. from the front property line and 68 ft. off the right side property line as seen when facing the lot from Greenwood Drive. Locate inlet pipe 3ft. to 4 ft. below original grade.

NOTE: ALL PIPE FROM HOUSE TO SEPTIC TANK MUST BE CAST IRON.
PERMIT VOID AFTER THREE YEARS.


PLANS APPROVED BY J. Hennigan DATE 11/3/65

FILL SEPTIC TANK AND DISTRIBUTION BOX WITH WATER BEFORE CALLING FOR AN INSPECTION. COVER NO WORK UNTIL INSPECTED AND APPROVED.

NEITHER THE HOWARD COUNTY COMMISSIONERS NOR THE HEALTH DEPARTMENT IS RESPONSIBLE FOR THE SUCCESSFUL OPERATION OF ANY SYSTEM.

NOTIFY THE HEALTH DEPARTMENT 48 HOURS BEFORE EXCAVATIONS ARE TO BE BACK FILLED.

11110

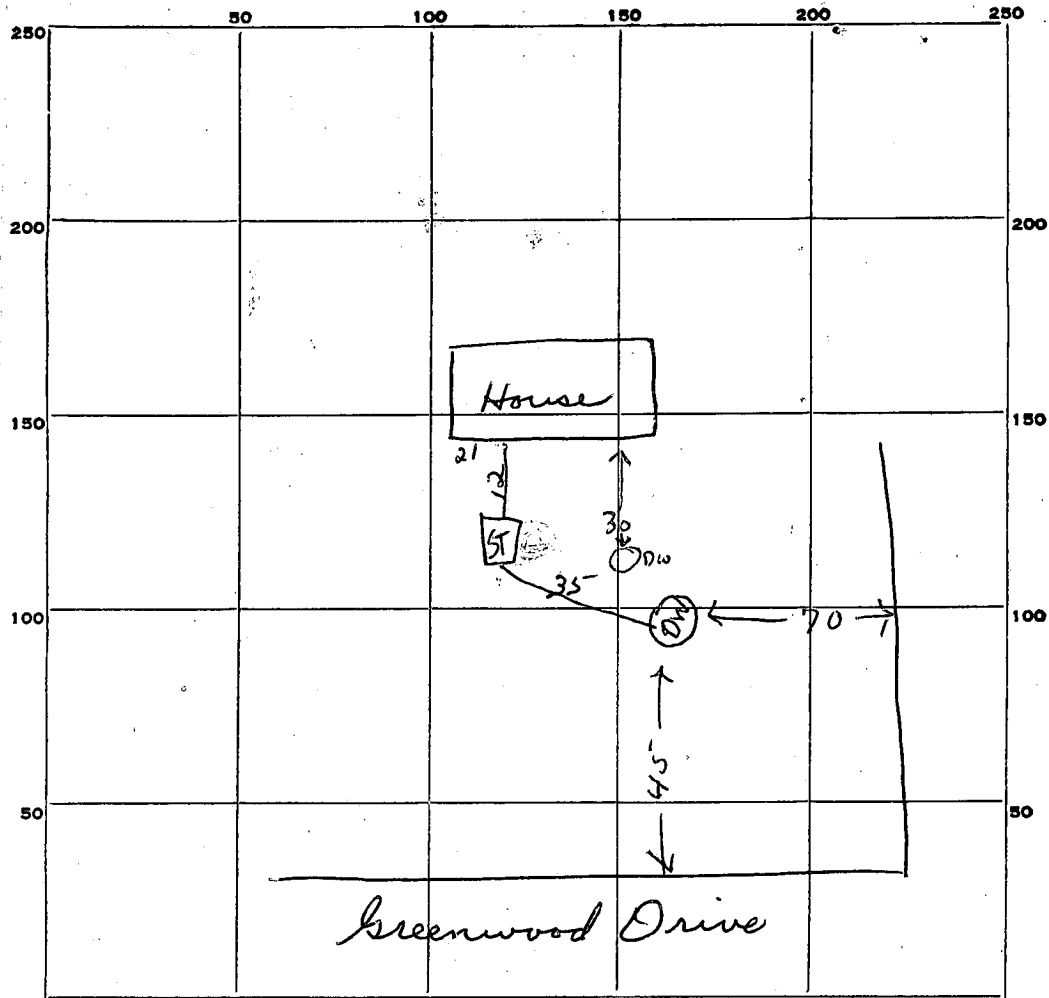

INDICATE NORTH. - NAME ADJOINING ROADWAY AS BASE LINE.

123
364
288

PERMIT CARD _____

SEPTIC TANK, LEVEL 750

CLEANOUTS OK

DISTRIBUTION BOX, LEVEL _____

TILE FIELD, DEPTH _____ FT. TRENCH WIDTH _____ FT.

GRAVEL DEPTH _____ IN. TOTAL LENGTH _____ FT.

NUMBER OF TRENCHES _____ TOTAL BOTTOM AREA _____

SEEPAGE PITS, ^{outside} ~~INSIDE~~ DIAMETER 12 FT. DEPTH BELOW INLET 8 FT.

ABSORBENT AREA 288 SQ. FT.

REMARKS INV 4182

OWNER STATES - (MRS PARR USA)

NEW DRYWELL APRIL 11, 82, POSSIBLY NEW TANK, 8-1-83 CW

DATE SYSTEM APPROVED 12/9/69

INSPECTOR R. Tone

APPLICATION

A 11110

SEWAGE DISPOSAL TESTING

P _____

MARYLAND STATE DEPARTMENT OF HEALTH

HOWARD COUNTY

ELLCOTT CITY

750 gal. septic Tank.

DISTRICT 5

Dry well 12 ft. in dia. by 8 ft. deep below the inlet located 43 ft. from the front property line and 68 ft. off the right side property line as seen when facing the lot from Greenwood Drive. Total inlet pipe 3-1/2 FT. TO 4 FT. below original grade.

DATE 10/28/65

TO: THE COUNTY HEALTH OFFICER
ELLCOTT CITY, MARYLAND

I, HEREBY, APPLY FOR THE NECESSARY TESTS IN ORDER TO CONSTRUCT (OR RECONSTRUCT) A SEWAGE DISPOSAL SYSTEM.

PROPERTY OWNER Lester Patton

ADDRESS 17209 Emerson Drive, Silver Spring, Md1 PHONE 384-6547

PROPERTY LOCATION:

SUBDIVISION Greenwood Farms LOT NO. Lot 47; Sec. 3

ROAD AND DESCRIPTION Greenwood Dr.

OCCUPANT _____ PHONE _____

PERSON TO CONSTRUCT SYSTEM _____

ADDRESS _____ PHONE _____

SIZE OF LOT 1 acre TYPE BLDG. 3 NUMBER OF BEDROOMS

IF NOT SINGLE RESIDENCE DESCRIBE _____

SIGNATURE OF APPLICANT [Signature]


APPROVED BY [Signature] FOR Dry Well DATE 11-3-65
(KIND OF SYSTEM)

REJECTED BY _____ FOR _____ DATE _____
(KIND OF SYSTEM)

HOLD PENDING FURTHER TESTS _____ DATE _____

REASONS FOR REJECTION OR HOLDING _____

THIS IS NOT A PERMIT

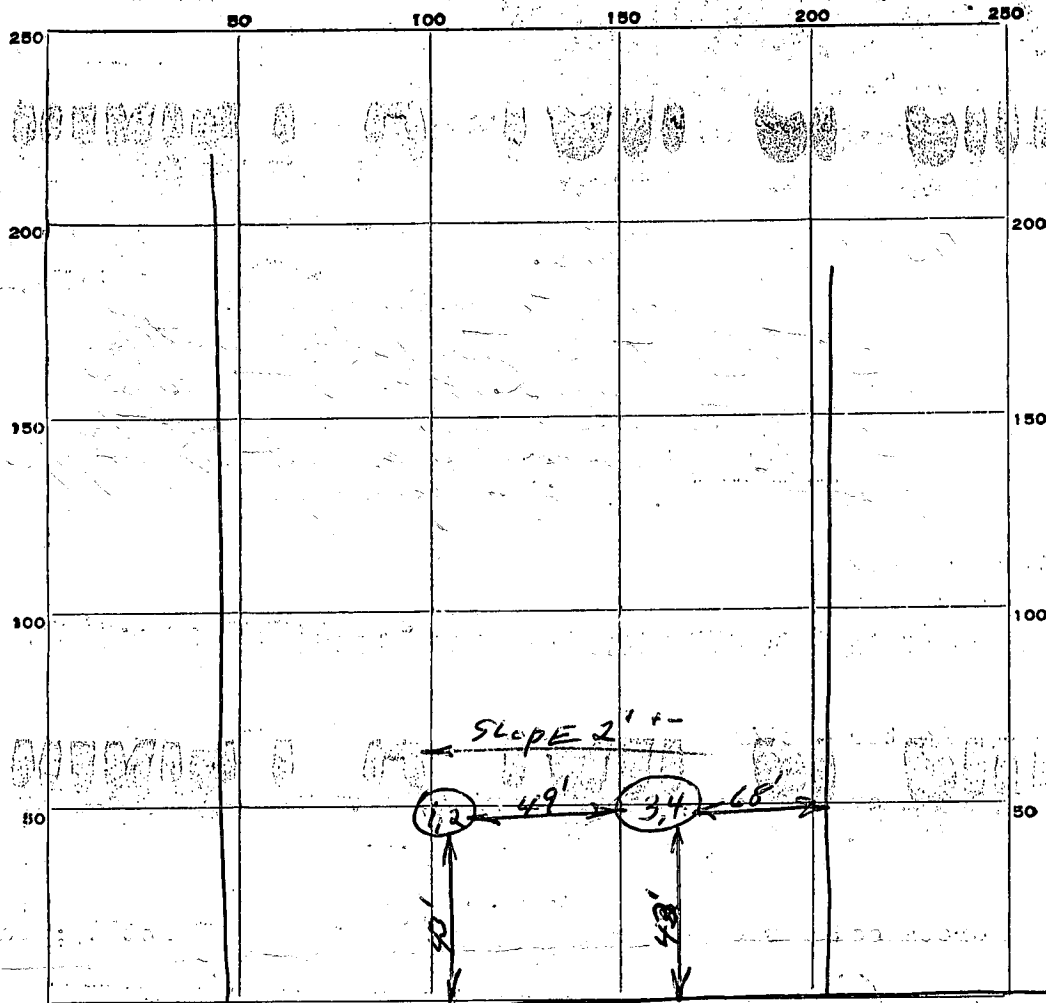

INDICATE NORTH. NAME ADJOINING ROADWAY AS BASE LINE.

GREENWOOD DRIVE

DATE	TEST NO.	DEPTH	PRE-WET		TEST - 1" DROP		TIME
			START	STOP	START	STOP	
11-3-65	1 Same	10'	10:06	10:07	10:07	10:09	2 min
	2 Pit	4 1/2'	10:08	10:10	10:10	10:13	3 min
	3 Same	9 1/2'	10:20	10:22	10:22	10:26	4 min
	4 Pit	4 1/2'	10:22	10:23	10:23	10:24	1 min


SOIL AUGER FINDING *Excellent soil - Use pit 3, 4*

TESTED BY *J.H.*

REMARKS *11-3-65 David Scogg*

1 FAMILY DWELING
GREENWOOD FARMS
HIGHLAND, MD.

WALTER B. PARISH
PH. 498 2415

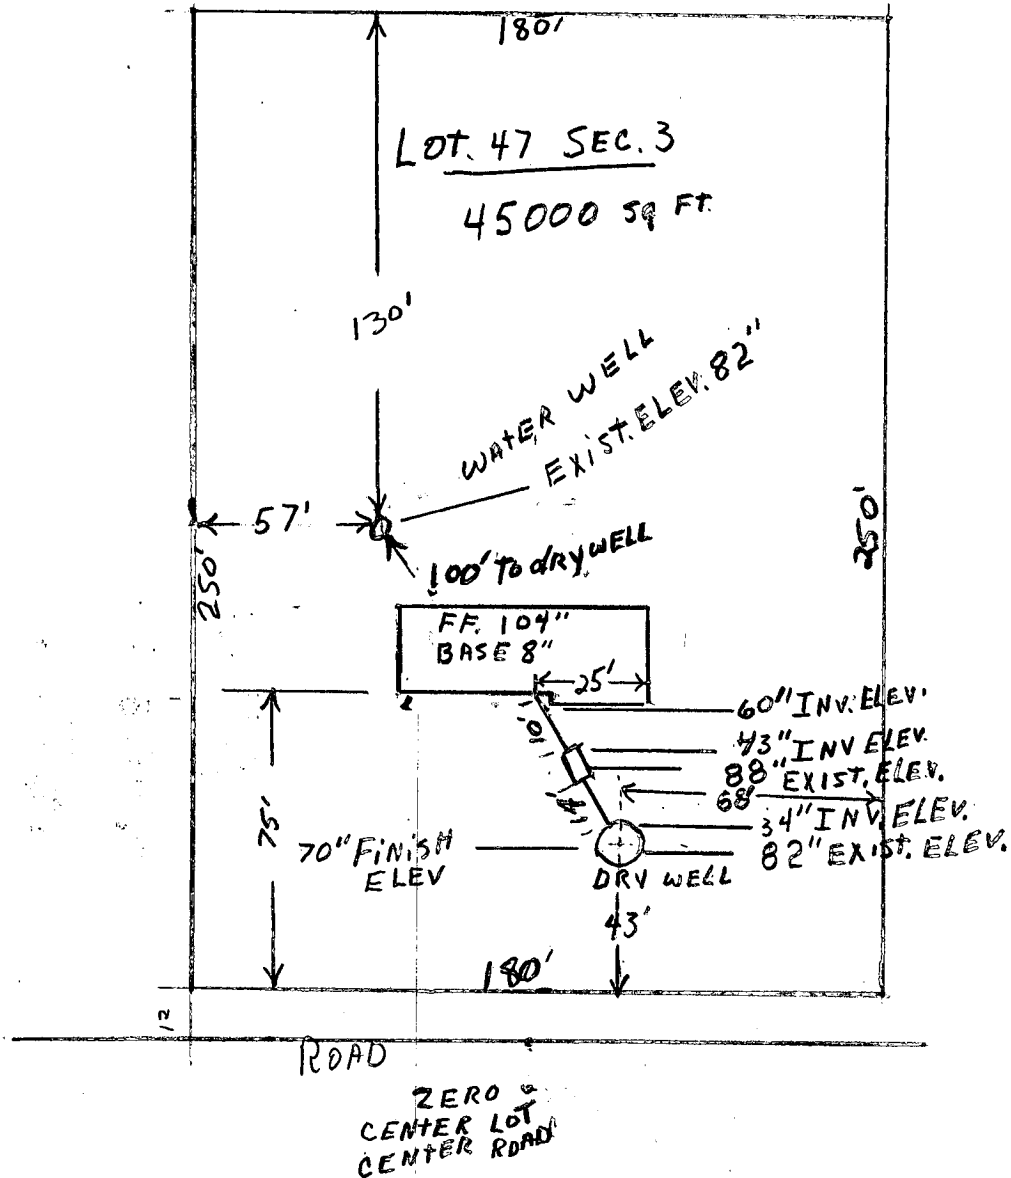

OK
DWM
9/3/69

B 1 5225 SEQUENCE NO. (DWR USE ONLY)

STATE OF MARYLAND
DEPARTMENT OF WATER RESOURCES
STATE OFFICE BLDG., ANNAPOLIS, MARYLAND 21401
APPLICATION FOR PERMIT TO DRILL WELL

APPLICATION MUST BE SUBMITTED AND PERMIT RECEIVED BEFORE DRILLING IS STARTED.
 FILL IN THIS FORM COMPLETELY

B 13 DATE RECEIVED (DWR USE ONLY)

OWNER: Parish, Walter COL 15 LAST NAME FIRST NAME COL 34
Greenwood Drive COL 36 STREET OR RFD HO-70-0108 COL 55
Highland MD COL 57 POST OFFICE COL 80

B 2 DRILLER INFORMATION

1 2 3 (SEQ. NO.) 6
Harry Green COL 8 FIRST NAME DRILLER COL 27 LAST NAME COL 29 IDENTITY NUMBER COL 32
18401 BETHCHARD COL 34 STREET OR RFD COL 53
DUMMERS MD COL 55 POST OFFICE COL 80
25 NOV 1969 COL 57 DATE OF APPLICATION COL 80 ZIP CODE

B 4 LOCATION OF WELL

1 2 3 (SEQ. NO.) 6
Howard COL 8 COUNTY (DO NOT ABBREVIATE COUNTY NAME) COL 21
Greenwood Friends COL 23 SUBDIVISION COL 42
3 COL 44 SECTION COL 46 LOT 47 COL 50
Highland COL 52 NEAREST TOWN COL 80
2 COL 73 MILES FROM TOWN (ENTER 0 IF INTOWN) COL 76-77-78

B 3 WELL INFORMATION

1 2 3 (SEQ. NO.) 6
5 COL 8 MAXIMUM PUMPING RATE (GALLONS PER MINUTE) COL 12
100 COL 14 AVERAGE DAILY QUANTITY NEEDED (GALLONS PER DAY) COL 20

B 5 DIRECTION FROM TOWN (CIRCLE APPROPRIATE BOX)

N NORTH E EAST NE NORTHEAST SE SOUTHEAST
 S SOUTH W WEST NW NORTHWEST SW SOUTHWEST

NEAR WHAT ROAD: Greenwood Dr COL 11 NORTH SOUTH EAST WEST COL 30
 ON WHICH SIDE OF ROAD (CIRCLE APPROPRIATE BOX) N S E W COL 32
 DISTANCE FROM ROAD (ENTER DISTANCE AND CIRCLE APPROPRIATE BOX) 150 COL 34 FT MI COL 37-38-39

USE FOR WATER (CIRCLE APPROPRIATE BOX)

D DOMESTIC, HOME (SINGLE OR DOUBLE HOUSEHOLD UNIT ONLY)
 F FARMING, AGRICULTURE, IRRIGATION.
 I INDUSTRIAL, COMMERCIAL, STATE AND FEDERAL GOVERNMENT.
 M MUNICIPAL WATER SUPPLY } MUST HAVE STATE HEALTH DEPT. APPROVAL
 P PRIVATE WATER COMPANY }
 T TEST

APPROXIMATE DEPTH OF WELL 130 FEET

METHOD OF DRILLING USED (CIRCLE APPROPRIATE METHOD)


BORED (OR AUGERED) JETTED DRIVEN
 30-37 AIR-ROTARY AIR-RECURSION ROTARY (HYDRAULIC ROTARY)
 CABLE REVERSE ROTARY

REPLACEMENT OR DEEPEMED WELLS (CIRCLE APPROPRIATE BOX)

N THIS WELL WILL NOT REPLACE AN EXISTING WELL
 Y THIS WELL WILL REPLACE A WELL THAT WILL BE ABANDONED AND SEALED
 S THIS WELL WILL REPLACE A WELL THAT WILL BE USED AS A STANDBY
 D THIS WELL WILL DEEPEM AN EXISTING WELL PERMIT NUMBER OF WELL TO BE REPLACED OR DEEPEMED (IF AVAILABLE)

NOT TO BE FILLED IN BY DRILLER (DWR USE ONLY)

APPROPRIATION PERMIT NUMBER 54 COL 54-63
 ENGINEER REVIEW (WRITE DISTRICT NO. IN BOX) COL 65 FORCE COL 67-68 WRITE INITIALS IN BOX
 CONDITIONS A E N S G W Q COL 70-71-72-73-74-75-76-77-78-79

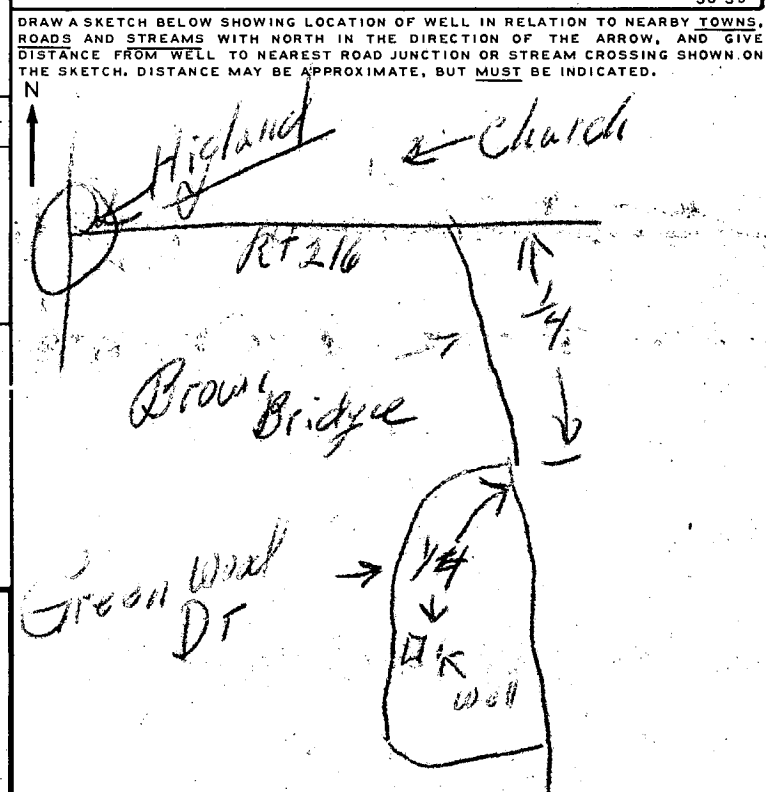

B 5 CONTINUED HEALTH DEPARTMENT APPROVAL (NOT TO BE FILLED IN BY DRILLER)

1 2 3 (SEQ. NO.) 6
 41 S STATE DEPARTMENT OF HEALTH (CIRCLE BOX IF STATE HEALTH)
 DATE 11 26 69 COL 43-48 APPROVED BY Palmer F. Wine COL 49-54 DIRECTOR, Environmental Health COL 55-60
 COUNTY DEPT. OF HEALTH Howard COL 50-51 DEGREE 9 09 40 COL 52-54 MIN 0 7 65 6 50 COL 55-57 SEC 0 4 80 COL 58-60 ELEVATION AT WELL HEAD (FEET) COL 61-62-63-64-65-66-67-68

B 6 SPECIAL CONDITIONS 8-63 (DWR USE ONLY)

1 2 3 (SEQ. NO.) 6

C 1 **3567** SEQUENCE NO. (DWR USE ONLY)

1 2 3 (THIS NUMBER IS TO BE PUNCHED IN COLUMNS 3-6 ON ALL CARDS)

STATE OF MARYLAND
 DEPARTMENT OF WATER RESOURCES
 STATE OFFICE BLDG. ANNAPOLIS, MARYLAND 21401

WELL COMPLETION REPORT

THIS REPORT MUST BE SUBMITTED WITHIN 30 DAYS AFTER COMPLETION OF THE WELL

FILL IN THIS FORM COMPLETELY

DATE RECEIVED (DWR USE ONLY) _____

DATE WELL COMPLETED Jan 1970

DEPTH OF WELL 85 (TO NEAREST FOOT) 22 26

PERMIT NO. FROM PERMIT TO DRILL WELL 40-70-0108 28 29 30 31 32 33 34 35 36 37

DRILLERS IDENTIFICATION NO. 1

OWNER Parish, Walter LAST NAME FIRST NAME

STREET OR RFD Green Wood Dr. 179-9 Maryland OFFICE MD

WELL LOG

STATE THE KIND OF FORMATIONS PENETRATED, THEIR COLOR, DEPTH, THICKNESS AND IF WATER BEARING

DESCRIPTION (USE ADDITIONAL SHEETS IF NECESSARY)	FEET		CHECK IF WATER BEARING
	FROM	TO	
	0	30	
	50		
	60		
	80	85	

GROUTING RECORD

WELL HAS BEEN GROUTED TO 3 ft (CIRCLE APPROPRIATE) Y N

YES NO 46 46

DEPTH OF GROUT SEAL (TO NEAREST FOOT)

FROM 0 FT. TO 20+ FT. 48 54 58

(ENTER 0 IF FROM SURFACE) 6

CASING RECORD

CASING TYPES (INSERT APPROPRIATE CODE BELOW)

S STEEL C CONCRETE

P PLASTIC O OTHER

MAIN CASING TYPE S T

NOMINAL DIAMETER TOP (MAIN) CASING (NEAREST INCH) 6

TOTAL DEPTH OF MAIN CASING (NEAREST FOOT) 33

OTHER CASING (IF USED)

EACH CASING	DIAMETER (INCH)		DEPTH (FEET)	
	FROM	TO	FROM	TO

SCREEN RECORD

SCREEN TYPE OR OPEN HOLE (INSERT APPROPRIATE CODE BELOW)

S STEEL B BRASS OR BRONZE H OPEN HOLE

P PLASTIC O OTHER

DEPTH (NEAREST WHOLE FOOT)

EACH SCREEN	FROM		TO	
	8	9	15	21
1				
2				
3				
4				

SLOTSIZE 1, 2, 3, 4

PUMPING TEST

1 2 3 (SEQ. NO.) 6

HOURS PUMPED (TO NEAREST HOUR) 8 8 9

PUMPING RATE (GALLONS PER MINUTE TO NEAREST GALLON) 12 11 15

METHOD USED TO MEASURE PUMPING RATE Ballpot

WATER LEVEL: (DISTANCE FROM LAND SURFACE)

BEFORE PUMPING 50 (NEAREST FOOT) 17 20

WHEN PUMPING 80 (NEAREST FOOT) 22 25

TYPE OF PUMPED USED (CIRCLE APPROPRIATE BOX)

A AR P PISTON T TURBINE

C CENTRIFUGAL R ROTARY O OTHER (DESCRIBE BELOW)

J JET S SUBMERSIBLE

PUMP INSTALLED

TYPE OF PUMP (WRITE APPROPRIATE LETTER IN BOX - SEE ABOVE: A, C, J, P, R, S, T, O)

29

CAPACITY: GALLONS PER MINUTE (TO NEAREST GALLON) _____ 31 35


PUMP HORSE POWER _____ 37 41

PUMP COLUMN LENGTH (NEAREST FOOT) _____ 43 47

CASING HEIGHT (CIRCLE APPROPRIATE BOX AND ENTER CASING HEIGHT)

+ ABOVE } LAND SURFACE (NEAREST FOOT) 2

- BELOW } 49 50 51

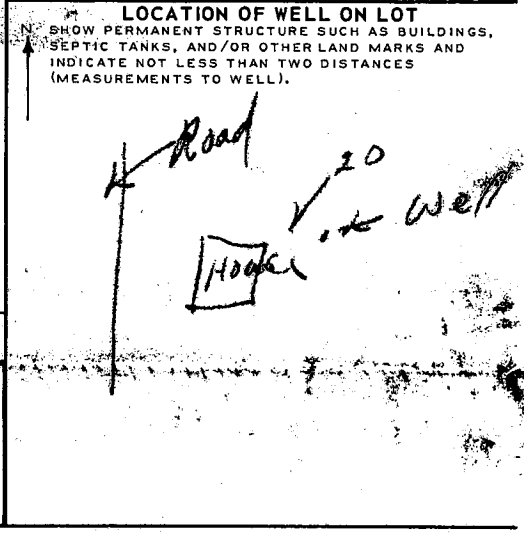

CIRCLE APPROPRIATE BOXES

A A WELL WAS ABANDONED AND SEALED WHEN THIS WELL WAS COMPLETED

E ELECTRIC LOG OBTAINED

C COPY OF ELECTRIC LOG ATTACHED

I HEREBY CERTIFY THAT I HAVE COMPLIED WITH ALL CONDITIONS STATED ON THE ABOVE-CAPTIONED "PERMIT TO DRILL WELL", AND THAT INFORMATION CONTAINED IN THIS REPORT IS TRUE, ACCURATE, AND COMPLETE TO THE BEST OF MY KNOWLEDGE, INFORMATION AND BELIEF.

DRILLERS NAME: Harry Green

(PLEASE PRINT) SIGNATURE Harry Green

IF WELL DRILLED WAS A FLOWING WELL CIRCLE BOX F

DWR USE ONLY (NOT TO BE FILLED IN BY DRILLER)

T TELESCOPE CASING LOG INDICATOR

70 72

W Q OTHER DATA AVAILABLE 74 75 76


LOT 47 SECTION THREE

GREENWOOD FARMS

PLAT BOOK NO. 5 FOLIO 88

Lot 48

Lot 49

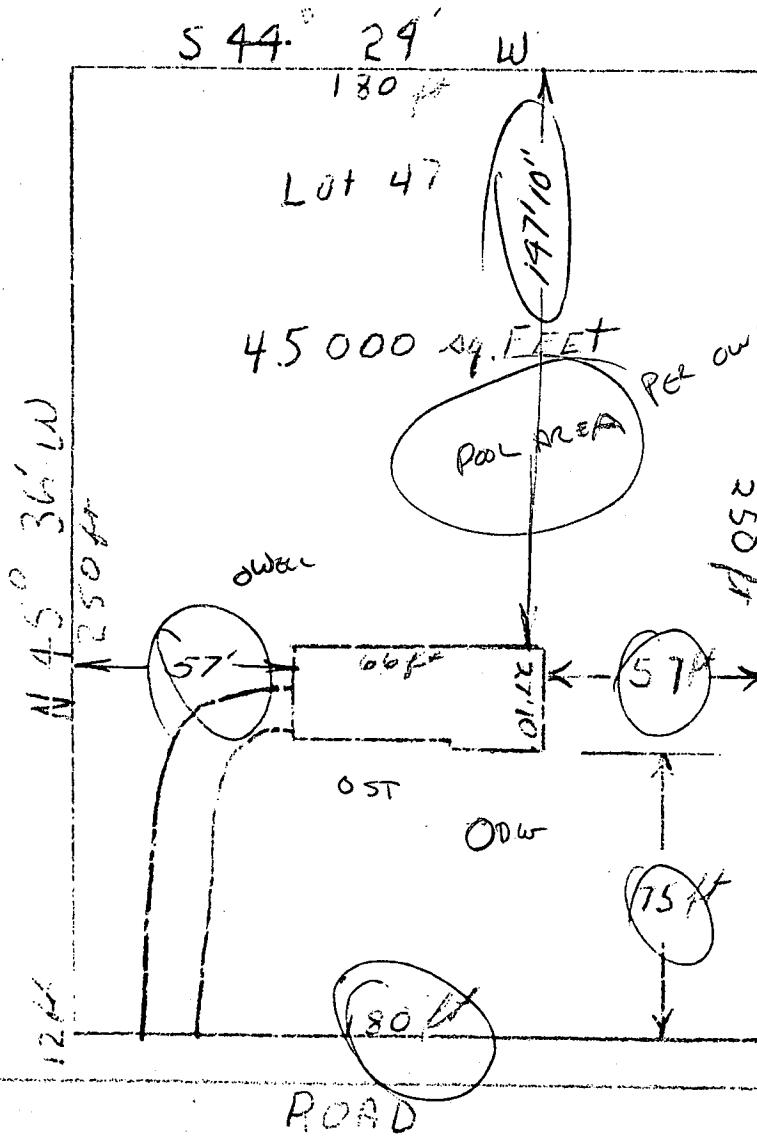

PER OWNERS STATEMENT
8-1-83
OK TO PROCEED
C. Williams