

# APPLICATION

A 01135

SEWAGE DISPOSAL TESTING

PA1259

MARYLAND STATE DEPARTMENT OF HEALTH

HOWARD COUNTY

ELLICOTT CITY

DISTRICT 2

DATE 6/12/59

*750 gallon tank  
Dry Well - 300 sq ft  
sidewall area below 10' - 3" depth  
Place the tile field about 10' - 3" depth in Lot # 1 in the front part of the lot*

TO: THE COUNTY HEALTH OFFICER  
ELLICOTT CITY, MARYLAND

I, HEREBY, APPLY FOR THE NECESSARY TESTS IN ORDER TO CONSTRUCT OR RECONSTRUCT A SEWAGE DISPOSAL SYSTEM. *unless dry well shows a better per cent*

PROPERTY OWNER Garard Andrew Philbrick

ADDRESS 4327 Glenmore Ave. Balto. 6

PHONE Ha. 6-5845 phone dis connect

PROPERTY LOCATION:

SUBDIVISION

LOT NO. 1

ROAD AND DESCRIPTION Cooks Lane Off of Columbia Pike

OCCUPANT

PHONE

PERSON TO CONSTRUCT SYSTEM

ADDRESS

PHONE

SIZE OF LOT 1/2 acre

TYPE BLDG. 3 bedrooms

NUMBER OF BEDROOMS

IF NOT SINGLE RESIDENCE DESCRIBE

SIGNATURE OF APPLICANT *Garard Andrew Philbrick*

APPROVED BY *Raymond Bodge*

FOR

(KIND OF SYSTEM)

DATE 9/23/59

REJECTED BY

FOR

(KIND OF SYSTEM)


DATE

HOLD PENDING FURTHER TESTS *1/27/59*

DATE 8/15/59

REASONS FOR REJECTION OR HOLDING

# THIS IS NOT A PERMIT

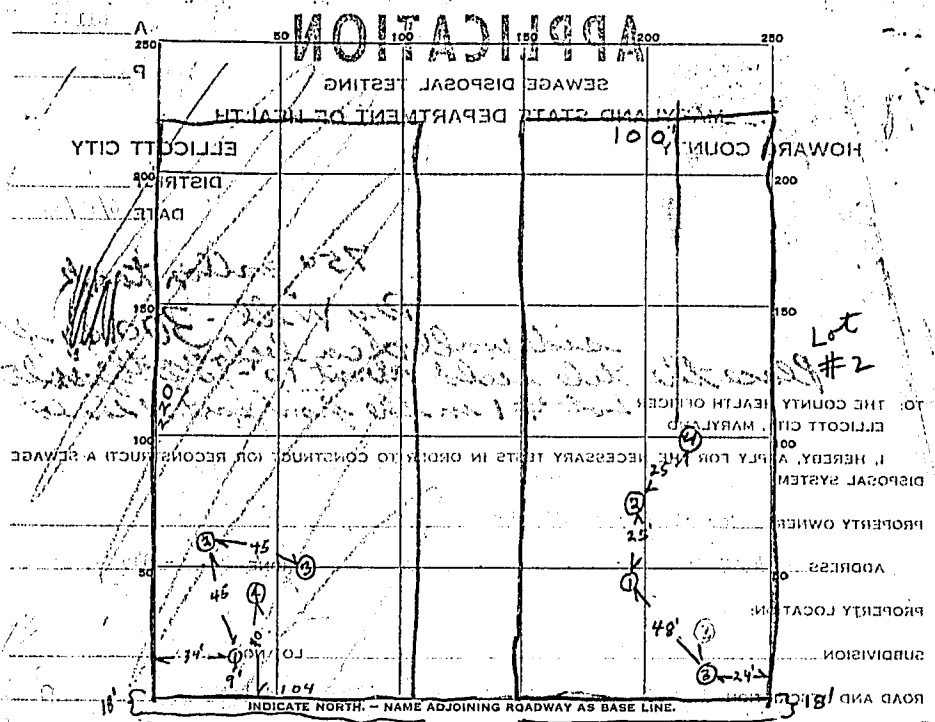


DATE	TEST NO.	DEPTH	PRE-WET		TEST - 1" DROP		TIME	OCCUPANT	
			START	STOP	START	STOP			
8/25/59	1	4	1 50	2 30	no perc	40 min	Lot #2	PERSONS	
	2	4	1 52	2 30	little perc	38 min			
	3	3	1 56	2 33	little perc	37 min			
	4	8	2 04	2 30	2 30	3 14			44 min
9/15/59	1	4	11 27	12 10	little perc	43 min	Lot #1	SIGNATURE	
	2	4	11 28	12 10	12 10	1 50			little perc
	3	3	11 30	12 11	little perc	41 min			
	4	4	11 34	12 14	little perc	40 min			
	5	8	12 30	12 49	little perc	19 min			
9/17/59	6	9	10 24	11 05	little perc	41 min	APPROVED REFLECTED	SIGNATURE	
	7	10	11 43	12 03	little perc	20 min			

SOIL AUGER FINDING

TESTED BY Raymond Hodges

REMARKS: APPROVED A PERMIT  
 ALSO PRESENT: William J. Hodges LOT NO. 9115159  
9/15/59 9/17/59 Clarna H. Gork

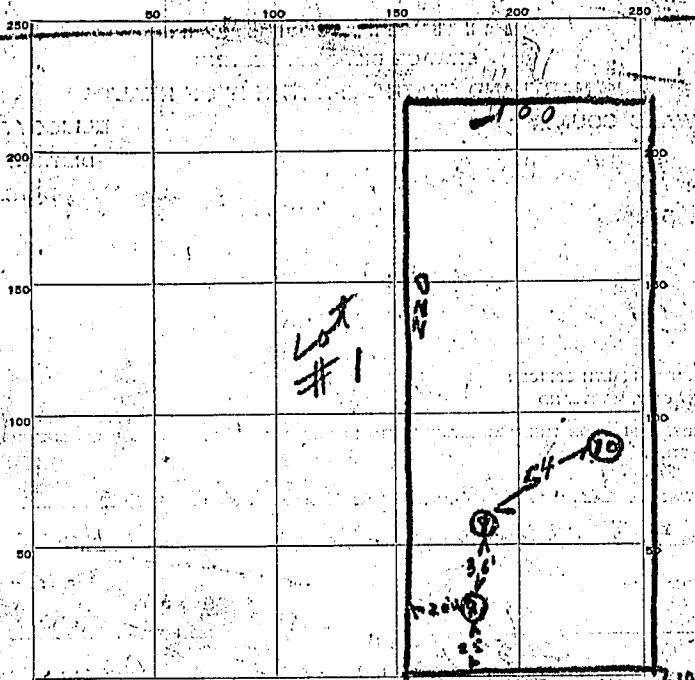

COOKS LANE

DATE	TEST NO.	DEPTH	PRE-WET		TEST - 1" DROP		TIME
			START	STOP	START	STOP	
9/21/59	8	3	1254	1255	1255	1256	1 min
	9	3	104	105	105	108	3 min
	10	3	111	115	115	123	8 min

SOIL AUGER FINDING \_\_\_\_\_

TESTED BY Raymond Hodger

REMARKS \_\_\_\_\_

ALSO PRESENT J. Sawyer

LOT NO. 2