

PUB. SEWER STATUS VERIFIED BY _____

ISSUE DATE: 1/14/2010

PERMIT

P ~~42003~~ 532499

APPROVAL DATE: 1/14/2010 # 5392705

A REPAIR #31573

ON-SITE SEWAGE DISPOSAL SYSTEM
HOWARD COUNTY HEALTH DEPARTMENT
BUREAU OF ENVIRONMENTAL HEALTH

*In Pat
Trac*

Minor Septic Repair

Jenkins Brothers IS PERMITTED TO INSTALL ALTER

ADDRESS: _____ PHONE NUMBER: _____

SUBDIVISION: La Isla LOT NUMBER: 9

ADDRESS: 6645 Corina Court PROPERTY OWNER: Roger Lewis

SEPTIC TANK CAPACITY (GALLONS): N/A

PUMP CHAMBER CAPACITY (GALLONS): _____

NUMBER OF BEDROOMS: 4

SQUARE FEET OF HOUSE: _____

LINEAR FEET OF TRENCH REQUIRED: _____


TRENCHES:	
LOCATION:	Replace clogged line between house and tank.
PURPOSE:	

PLANS APPROVED: Brian Baker DATE: 1/14/10

- NOTE: PERMIT VOID AFTER 2 YEARS
- NOTE: CONTRACTOR RESPONSIBLE FOR SCHEDULING A PRE-CONSTRUCTION INSPECTION FOR ALL INSTALLATIONS
- NOTE: WATERTIGHT SEPTIC TANKS REQUIRED
- NOTE: ALL PARTS OF SEPTIC SYSTEM SHALL BE 100 FEET FROM ANY WATER WELL
- NOTE: MANHOLE RISERS REQUIRED ON ALL SEPTIC TANKS AND PUMP CHAMBERS

NEITHER THE HOWARD COUNTY COUNCIL OR THE HEALTH DEPARTMENT IS RESPONSIBLE FOR THE SUCCESSFUL OPERATION OF ANY SYSTEM PERMITTEE RESPONSIBLE FOR OBTAINING FINAL APPROVAL ON THIS PERMIT CALL 410-313-1771 FOR INSPECTION OF SEPTIC SYSTEM

NOT TO SCALE

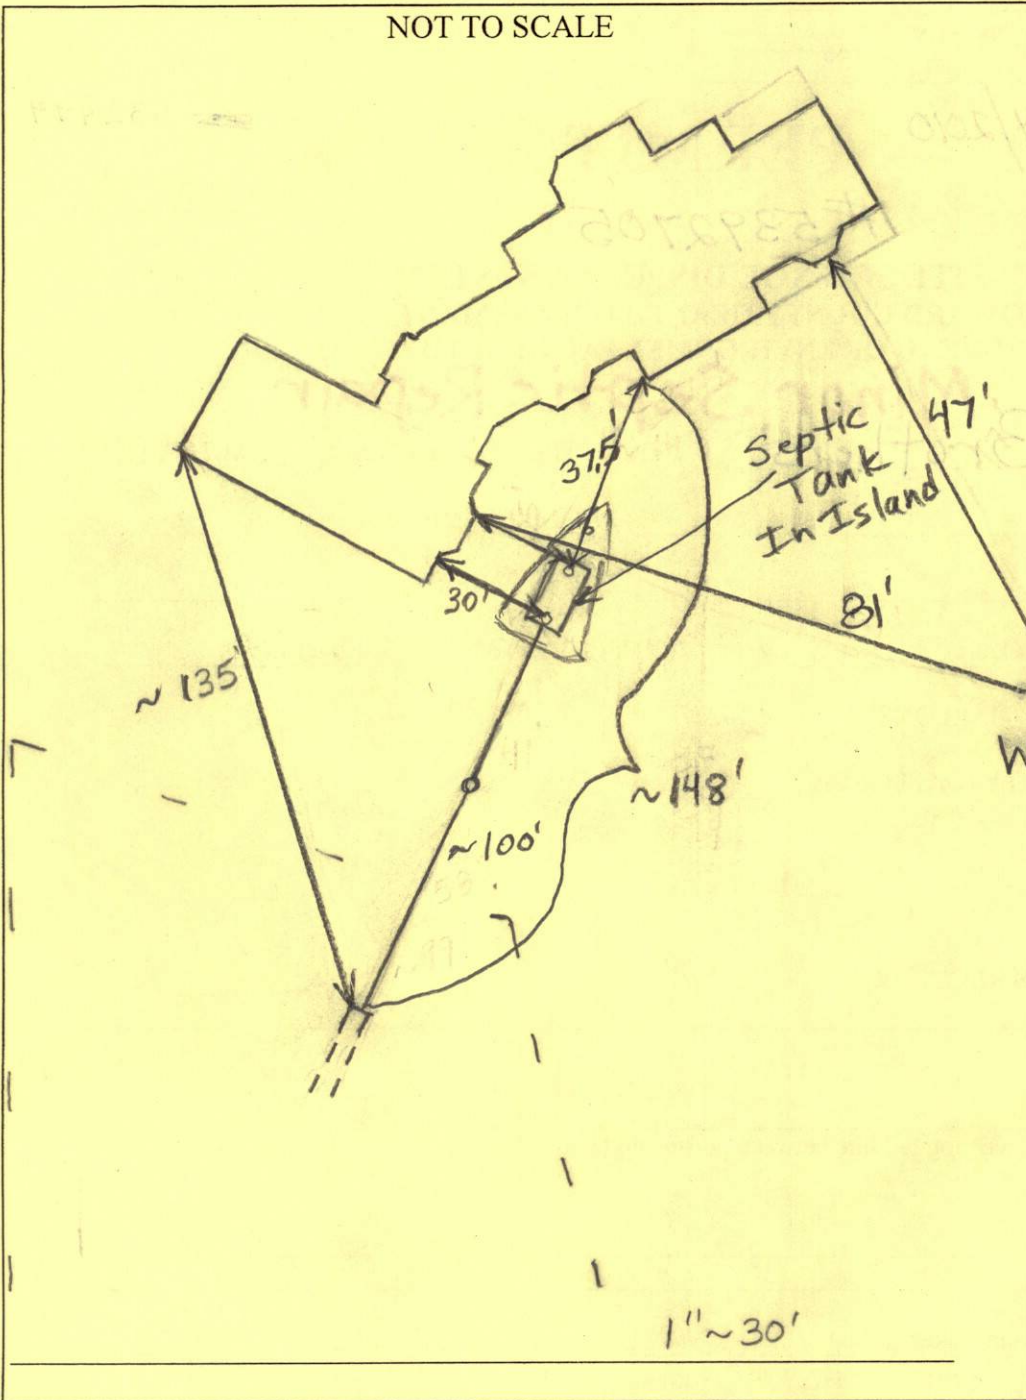

TRENCH/DRAINFIELD DATA

WIDTH _____ INLET _____ BOTTOM _____

NUMBER OF TRENCHES _____

TOTAL LENGTH _____

ABSORPTION AREA _____

DISTRIBUTION BOX LEVEL _____

DISTRIBUTION BOX BAFFLE _____

DISTRIBUTION BOX PORT _____

SEPTIC TANK DATA

SEPTIC TANK 1 LEVEL Yes

MANUFACTURER ?

CAPACITY 2000 GAL

SEAM LOC Midseam

TANK LID DEPTH 1.5-2'

BAFFLES Yes

BAFFLE FILTER No

MANHOLE LOC None

6" PORT LOC Front+Rear

WATERTIGHT TEST No

SLOTTED No

PUMP/SEPTIC TANK LEVEL N/A

MANUFACTURER _____

CAPACITY _____ GAL

SEAM LOC _____

TANK LID DEPTH _____

BAFFLES _____

BAFFLE FILTER _____

MANHOLE LOC _____

6" PORT LOC _____


WATERTIGHT TEST _____

SLOTTED _____

PRE-CONSTRUCTION

INSTALLATION: 1/14/2010 Line from tank to trench or trenches is clogged. Line replaced. Backhoe operator said that there was no distribution box. He said the piping was going directly to 1 trench. We dug on both sides of discovered trench but couldn't find another trench. Trench not full. (BB)

FINAL INSPECTOR B. Baker DATE OF APPROVAL 1/14/2010

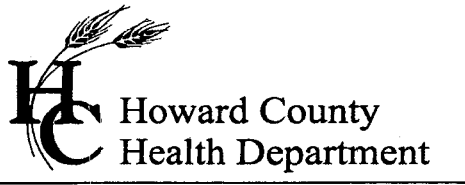

7178 Columbia Gateway Drive, Columbia MD 21046
(410) 313-2640 Fax (410) 313-2648
TDD (410) 313-2323 Toll Free 1-866-313-6300
website: www.hchealth.org

Peter L. Beilenson, M.D., M.P.H., Health Officer

INFORMATION FORM - SEPTIC SYSTEM REPAIR / UPGRADE

Minor Repair

Reason for Request:

- A. Failing System (includes surface discharge or inadequate treatment zone)
B. System relocation for proposed addition for setback compliance *
C. To replace a collapsed septic tank
D. To replace a collapsed drywell

Has the contractor verified through excavation/pumping evaluation that there are no pipe blockages?

**For REPAIRS, are the owners proposing, or do they plan to add in the future, any additions or modifications to the property, i.e. pools, living space additions, garages etc? This information must be disclosed at the time of this application. The Health Department will not be able to accommodate requests in the field for property modifications unrelated to the repair request. Such requests may require an additional fee, additional testing, and submittal of a Percolation Certification Plan, if the property does not meet current Code and Regulation.

Septic Contractor: Jenkins Bros
Contractor's Address: 7670 Smiths Private Rd, Sykesville, MD 21784
Contactor's Phone #: 410 465-6646
Property Address: 6645 Cowan Ct
Property (Subdivision) & Lot #:
County file #, if known:
Owner's Name and Phone #: Mr + Mrs Lewis
Is public sewer available/nearby: NO
If public sewer may be close, mention further research will be performed to verify availability
Names of any previous owners:
Year House Built:
of Existing Bedrooms: 5
of Bedrooms after completion of addition:
Has this request been discussed previously with another Sanitarian: [checked] Name: Brian

A Sanitarian will be in contact within three business days depending upon the urgency of the situation to coordinate the scheduling/review of the repair or upgrade.

Print out a copy of the Real Property Data via Dept. of Taxation website Indexed file found

*Prior to scheduling inspections, scaled plans should be submitted to clarify the nature of the addition.

If public sewer may be nearby, verify whether the sewer is technically "available" (defined as abutting or within the property), through the Bureau of Engineering (x2414).
If sewer is available, verify whether the property is within the Metropolitan District (Finance x2061).
If sewer is available, and property is within the Metropolitan District, connection to sewer is required. If owner believes reasons for exemptions exist, owner should justify request in writing.

If soil/site conditions are limiting and sewer and/or Metro District status not conducive to connection, Sanitarian may recommend pursuit of Emergency Sewer Extension or Emergency Metro District Inclusion. Owner should contact Charlotte Dryden, x4419, for further detail.

No permit is to be issued nor inspection to be scheduled without prior fee collection at the office unless an emergency situation exists. Contractor is to notify office of the emergency situation as soon as possible.