

285-2800
2pm

PERMIT

108

P 21573

A 20176

SEWAGE DISPOSAL SYSTEM

MARYLAND STATE DEPARTMENT OF HEALTH

HOWARD COUNTY

INDEXED

file

ELLICOTT CITY

DISTRICT 6th

DATE 5/29/75

Vermeer Sales and Service, Inc. (*Branham*) IS PERMITTED TO INSTALL ALTER

ADDRESS 7281 Washington Boulevard, Baltimore, Md. 21227 PHONE ~~796-5431~~
498-5200

A SEWAGE DISPOSAL SYSTEM LOCATED AT _____

SUBDIVISION _____ ROAD *Edw* Cooney Lane - off Route 32 ⁴ _{TOT}

PROPERTY OWNER Vermeer Sales & Service, Inc.

ADDRESS 7281 Washington Boulevard, Baltimore, Md. 21227

SPECIFICATIONS

DRAIN FIELD _____ DEPTH _____ FEET, BOTTOM AREA _____ SQ. FT.

SEEPAGE PITS _____ ABSORBENT SIDE-WALL AREA _____ SQ. FT.

SEPTIC TANK CAPACITY 1000 GALLONS

FOR GARBAGE GRINDER, INCREASE DISPOSAL AREA 22% & TANK CAPACITY 50%.

OTHER DRY WELL - Dig pit 14 feet square - set block and top for 12 ft. diameter and fill in rest of pit with gravel. Maximum depth of dry well to be 16 ft. below original grade. Inlet to dry well to be 4 ft. below original grade. Place dry well 236 ft. from light green plastic standpipe in front of lot and ~~120~~ 20 ft. from white pipe near right sideline.

NOTE: ALL PIPE FROM HOUSE TO DISPOSAL AREA MUST BE CAST IRON.

PERMIT VOID AFTER THREE YEARS.

NOTE: INSTALL STAND PIPE ON SEPTIC TANK AND DRY WELL. STAND PIPES MUST BE 6 INCHES IN DIAMETER. CAST IRON, CONCRETE OR TERRA COTTA ACCEPTED.


PLANS APPROVED BY Donald W. Monaghan DATE 11/1/74

FILL SEPTIC TANK AND DISTRIBUTION BOX WITH WATER BEFORE CALLING FOR AN INSPECTION. COVER NO WORK UNTIL INSPECTED AND APPROVED.

NEITHER THE HOWARD COUNTY COMMISSIONERS NOR THE HEALTH DEPARTMENT IS RESPONSIBLE FOR THE SUCCESSFUL OPERATION OF ANY SYSTEM.

A 20176

A 20176

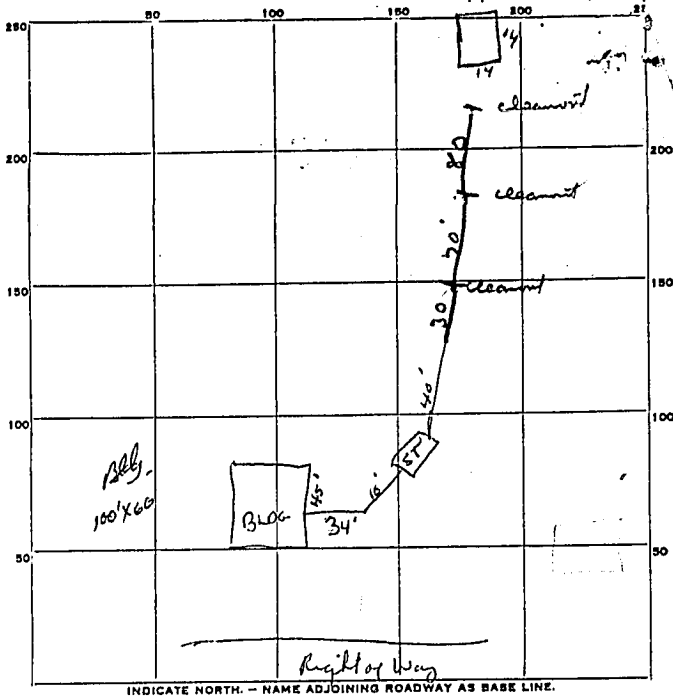

INDICATE NORTH. - NAME ADJOINING ROADWAY AS BASE LINE.

PERMIT CARD _____

SEPTIC TANK, LEVEL 1000 gal.

CLEANOUTS OK

DISTRIBUTION BOX, LEVEL _____

TILE FIELD, DEPTH _____ FT. TRENCH WIDTH _____ FT.

GRAVEL DEPTH _____ IN. TOTAL LENGTH _____ FT.

NUMBER OF TRENCHES _____ TOTAL BOTTOM AREA _____

SEEPAGE PITS, INSIDE DIAMETER _____ FT. DEPTH BELOW INLET _____ FT.

ABSORBENT AREA _____ SQ. FT.

REMARKS 6/20/75 - 16 ft. deep 14 ft. square.

8/1/75 - System connected with Voss, owner of Bldg,
told him we would need statement from architect as to how
much stone has been installed - and a statement from Voss
that he is completely satisfied with work.

9/75 - Talked with Mrs. Waring, her statement was consistent
(This property cannot be transferred without) from plan.

DATE SYSTEM APPROVED _____ INSPECTOR _____