

PRELIMINARY

APPLICATION

18858

SEWAGE DISPOSAL TESTING

P _____

STATE OF MARYLAND · DEPARTMENT OF HEALTH AND MENTAL HYGIENE

HOWARD COUNTY HEALTH DEPARTMENT
ENVIRONMENTAL HEALTH SERVICES
P. O. BOX 476, ELLICOTT CITY, MARYLAND 21043
TELEPHONE: 468-8000, EXT. 386

DISTRICT 5th

DATE 8/7/73

TO: THE COUNTY HEALTH OFFICER
ELLICOTT CITY, MARYLAND

I, HEREBY, APPLY FOR THE NECESSARY TEST IN ORDER TO CONSTRUCT (OR RECONSTRUCT) A SEWAGE DISPOSAL SYSTEM.

PROPERTY OWNER V. L. Vinella

ADDRESS 12631 Circle Drive, Glen Hills, Rockville, Md. PHONE 762-3007

PROPERTY LOCATION:

SUBDIVISION Green Hill Manor LOT NO. 9, Blk. C, Sec. 3

ROAD AND DESCRIPTION Cortina Drive

SIZE OF LOT 45,521 sq. ft. TYPE BLDG. 3 or 4 bedrooms
NUMBER OF BEDROOMS _____

IF NOT SINGLE RESIDENCE DESCRIBE _____

THE SYSTEM INSTALLED UNDER THIS APPLICATION IS ACCEPTABLE ONLY UNTIL PUBLIC FACILITIES BECOME AVAILABLE.

SIGNATURE OF APPLICANT /s/ V. L. Vinella

APPROVED BY _____ FOR _____ DATE _____
(KIND OF SYSTEM)

REJECTED BY _____ FOR _____ DATE _____
(KIND OF SYSTEM)


HOLD PENDING FURTHER TESTS _____ DATE _____

REASONS FOR REJECTION OR HOLDING _____

THIS IS NOT A PERMIT

MOITAD 1199A

YVANI 1000017

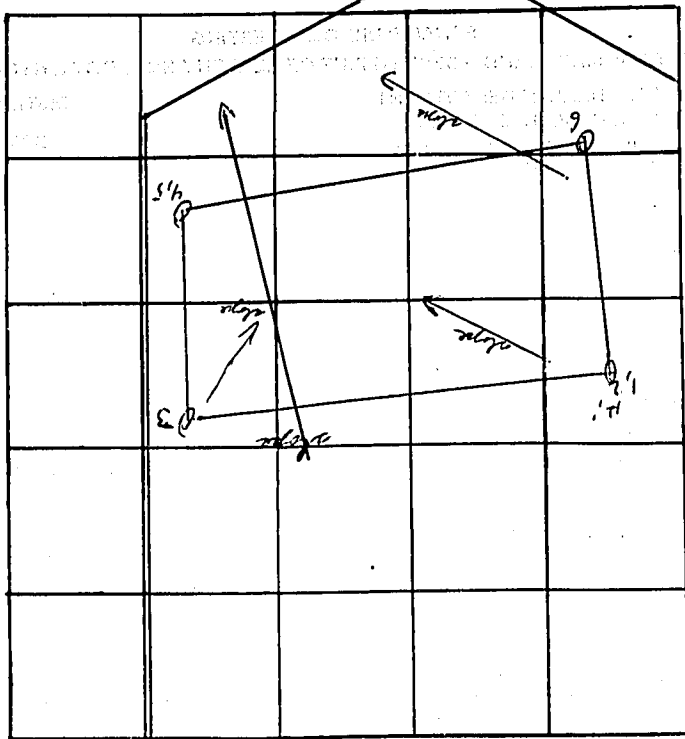

Lot 9

INDICATE NORTH. - NAME ADJOINING ROADWAY AS BASE LINE

Cortina Drive

Inlet @ 3 feet
Absorbant Sidewall Area begins at 3 1/2 feet
Use #1, 2 for system

DATE	TEST NO.	DEPTH	PRE-WET		TEST - 1" DROP		TIME
			START	STOP	START	STOP	
9/13	1	3 1/2	11:42	11:43	11:43	11:45	2
	2	11	11:42	11:44	11:44	11:47	3
	3	11	V's same as next				
	4	3	11:49	11:45	11:45	11:49	4
	5	11 1/2	11:44	11:45	11:45	11:52	7
✓	6	11	V's red-brown loam				

Site 1:

3

6

4 min

REMARKS red-brown loam RZ

TYPE OF SOIL _____