

12/30/99  
Site 10 + wpt system

# PERMIT

## SEWAGE DISPOSAL SYSTEM

### DEPARTMENT OF HEALTH AND MENTAL HYGIENE

P 512783

A 50463-D

# INDEXED

DISTRICT \_\_\_\_\_

HOWARD COUNTY HEALTH DEPARTMENT

DATE 10/28/99

BUREAU OF ENVIRONMENTAL HEALTH  
~~XXXXXX~~ 410-313-2640

# 360516

DATE SYSTEM APPROVED 12/30/99

INSPECTOR S.R.K.

Walter W. King Plumbing & Heating IS PERMITTED TO INSTALL  ALTER \_\_\_\_\_

ADDRESS 5305 King's Court, Frederick, MD 21703 PHONE 301-662-6990

SUBDIVISION Riggs Property LOT 33 ROAD 2004 Meadow Tree Court

PROPERTY OWNER Ryan Homes

ADDRESS \_\_\_\_\_

SEPTIC TANK CAPACITY 1250 GALLONS

NUMBER OF BEDROOMS 4

240 SQUARE FEET PER BEDROOM

LINEAR FEET OF TRENCH REQUIRED 320

TRENCHES - Trench to be 3 feet wide. Inlet 3.5 feet below original grade. Bottom maximum depth 5.5 feet below original grade. Effective area begins at 3.5 feet below original grade. 2.0 feet of stone below distribution pipe.

LOCATION - Place the distribution box 180 feet down the right 375.00' lot line and 35 feet off the same lot line as viewed from Meadow Tree Court. Run trenches on contour towards the left lot line.

NOTES - No trench to exceed 100 feet in length. Provide 6" - 8" diameter cleanout and cap to grade or above on septic tank. 10/29/99 O.K. BB

PLANS APPROVED BY Ronald J. Pinkley DATE 10-13-99

COVER NO WORK UNTIL INSPECTED AND APPROVED

NEITHER THE HOWARD COUNTY COUNCIL NOR THE HEALTH DEPARTMENT IS RESPONSIBLE FOR THE SUCCESSFUL OPERATION OF ANY SYSTEM

NOTE: CLEANOUT REQUIRED EVERY 70 FEET OF SEWER LINE AND/OR AT 90° SWEEPS IN LINES FROM HOUSE TO DRAIN FIELDS. 90° ELBOWS NOT ACCEPTABLE.

NOTE: ALL PARTS OF SEPTIC SYSTEMS (I.E. TANK, DISTRIBUTION BOX TRENCHES) TO BE 100 FEET FROM WELL (UNLESS OTHERWISE SPECIFICALLY AUTHORIZED)

NOTE: IF DEEP TRENCH(ES) ARE USED CALL FOR INSPECTION BEFORE AND AFTER PLACING GRAVEL IN TRENCH(ES)

NOTE: NO DRY WELL SHALL EXCEED 15 FOOT IN DIAMETER NO ABSORPTION TRENCH TO EXCEED 100 FEET IN LENGTH

NOTE: ALL PIPE FROM HOUSE TO SEPTIC TANK MUST BE CAST IRON OR SCHEDULE 35/40 PVC OR ABS


PERMIT VOID AFTER TWO YEARS

NOTE: INSTALL STAND PIPE ON SEPTIC TANK AND DRY WELL STAND PIPES MUST BE 6 INCHES IN DIAMETER CAST IRON, CONCRETE OR TERRA COTTA OR PVA OR ABS ACCEPTED. IF TOP OF SEPTIC TANK IS DEEPER THAN 3 FEET, MANHOLE TO GRADE REQUIRED.

NOTE: DISTRIBUTION BOXES MUST HAVE BAFFLES

**\*INSTALLER IS RESPONSIBLE FOR OBTAINING FINAL APPROVAL ON THIS PERMIT**

50463-D

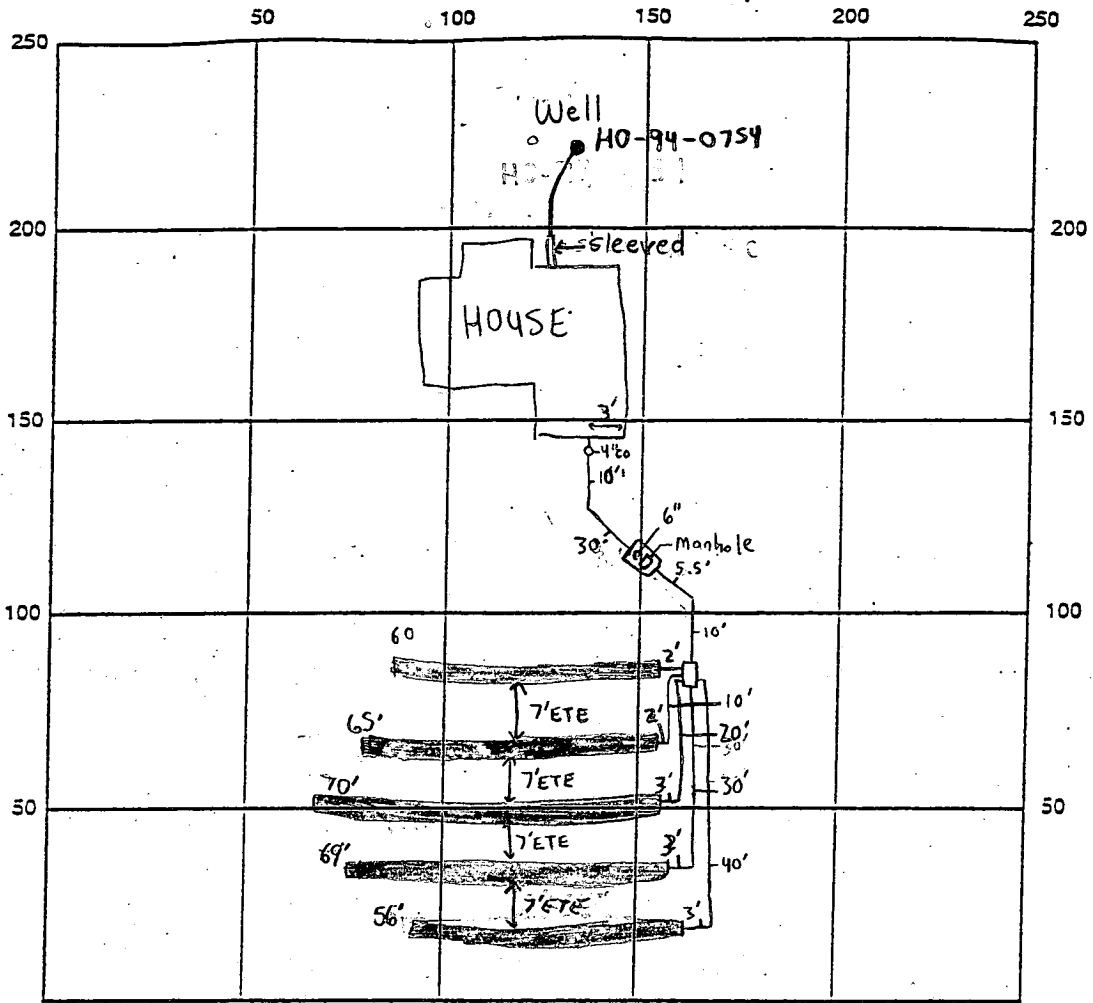

INDICATE NORTH - NAME ADJOINING ROADWAY AS BASE LINE  
MEADOW TREE COURT

SEPTIC TANK LEVEL 1250 gallon midseam tank CLEANOUTS 4" at house, 6" at tank, Manhole at tank

DISTRIBUTION BOX LEVEL ✓ Baffle is in

DRAIN FIELD/TITLE DEPTH 5.5 FT. TRENCH WIDTH 3 FT. INLET DEPTH 3.5 FT.

EFFECTIVE GRAVEL DEPTH 2 FT. TOTAL LENGTH 320 FT.

NUMBER OF TRENCHES 5 ONE-SIDEWALL/BOTTOM AREA 320 SQ. FT.

DRYWALL INSIDE DIAMETER N/A FT. EFFECTIVE DEPTH BELOW INLET N/A FT.

ABSORBENT AREA N/A SQ. FT.

REMARKS: 12/30/99 - OK TO COVER ALL WORK - (SRK)

DATE SYSTEM APPROVED 12/30/99

INSPECTOR Steven R. Krieg

# APPLICATION

50463-B

A 50368

## PERCOLATION TESTING

P \_\_\_\_\_

HOWARD COUNTY HEALTH DEPARTMENT  
BUREAU OF ENVIRONMENTAL HEALTH  
PO BOX 476 ELLICOTT CITY, MARYLAND 21043  
TELEPHONE 461-9933

DISTRICT 4th

DATE 9/30/94

TO: THE COUNTY HEALTH OFFICER  
ELLICOTT CITY, MARYLAND

I, HEREBY, APPLY FOR THE NECESSARY TEST IN ORDER TO CONSTRUCT (OR RECONSTRUCT) A SEWAGE DISPOSAL SYSTEM

PROPERTY OWNER Amelia Riggs, c/o SDC Group, Inc. RYAN HAYNES  
8480 N Baltimore - National Pk  
ADDRESS PO. BOX 417, Ellicott City, MD 21041 PHONE (410) 465-6105

PROSPECTIVE BUYER \_\_\_\_\_  
ADDRESS \_\_\_\_\_ PHONE \_\_\_\_\_

### PROPERTY LOCATION:

SUBDIVISION Riggs Property LOT NO. Grd. 1 3L 33  
ROAD AND DESCRIPTION Located @ SW Corner of the intersection of  
2004 MEADOW TREE COURT  
Roxbury Mill (Rte. 97) & Frederick Rd (Rte 144)

TAX MAP 0814 PARCEL # 96  
SIZE OF LOT 55000 ± S.F. TYPE BLDG Single Family Dwelling  
(SINGLE FAMILY DWELLING OR COMMERCIAL)  
Serial # BTD 120447

**EDL PERMIT SIGNED**  
**AND RETURNED 10-13-99**

THE SYSTEM INSTALLED UNDER THIS APPLICATION IS ACCEPTABLE ONLY UNTIL PUBLIC FACILITIES BECOME AVAILABLE. I FULLY UNDERSTAND THE  
FEE CONNECTED WITH THE FILING OF THIS PERC TEST APPLICATION IS NON-REFUNDABLE UNDER ANY CIRCUMSTANCES. I ALSO AGREE TO COMPLY  
WITH ALL M.O.S.H.A. REQUIREMENTS IN TESTING THIS LOT. \_\_\_\_\_  
James R. Morley, III V. Pos.  
(SIGNATURE OF APPLICANT)

APPROVED BY \_\_\_\_\_ FOR \_\_\_\_\_ DATE \_\_\_\_\_

REJECTED BY \_\_\_\_\_ FOR \_\_\_\_\_ DATE \_\_\_\_\_

HOLD PENDING FURTHER TESTS \_\_\_\_\_ DATE \_\_\_\_\_

REASONS FOR REJECTION OR HOLDING \_\_\_\_\_

# THIS IS NOT A PERMIT

COUNTY #

SOIL PROFILE  
457 458

0' orange brown clay  
5' mottling below clay layer  
5.5' pink Sasilm very friable and dry

470

3' brn clay  
reddish orange cl silm

5


tan orange silm very dry

12

488

5' topsoil  
bright orange silm  
4' orange tan silm strong structure

11

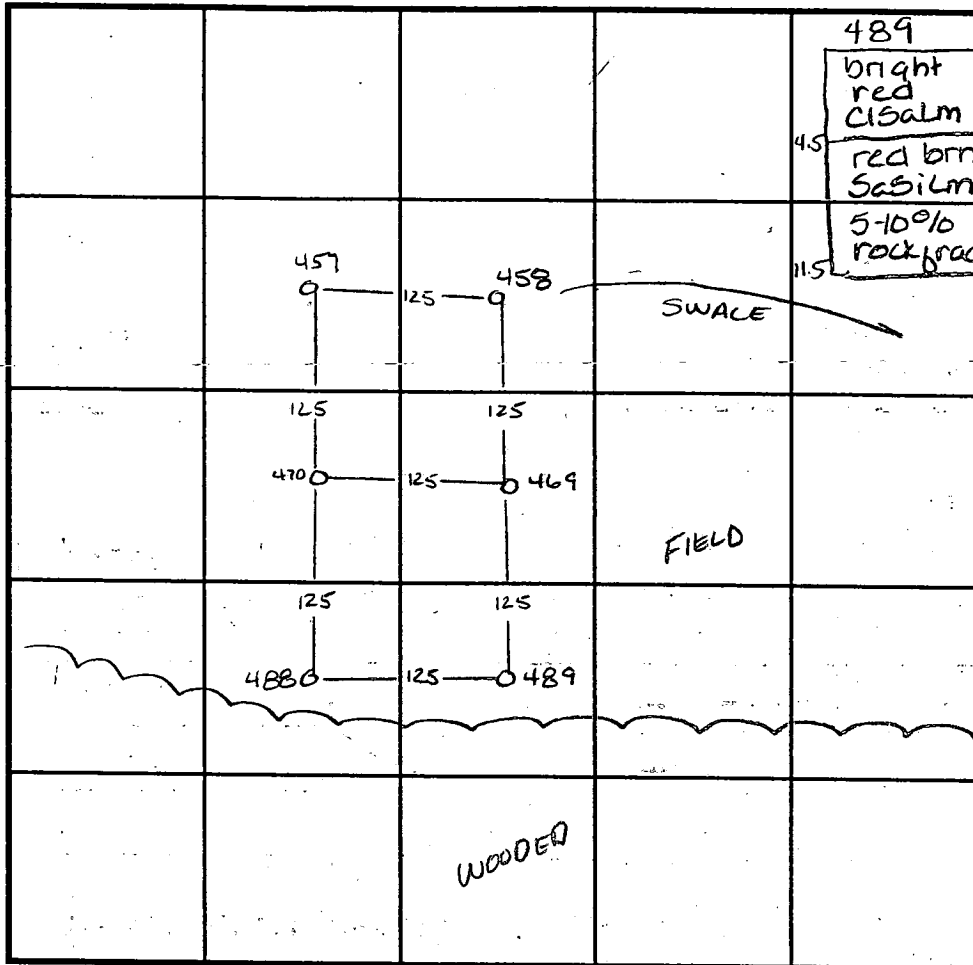

INDICATE NORTH - NAME ADJOINING ROADWAY AS BASE LINE.

489

bright red cl silm  
4.5' red brn Sasilm  
11.5' 5-10% rock frags

SOIL PROFILE  
458

0' bright orange red cl silm  
4' mottling below clay layer  
4.5' orange tan Sasilm very dry strong structure evidence of mottling at 9'

469

3.0' lgt tan cl silm  
reddish orange cl silm  
4.5' pink Sasilm strong structure  
12

DATE	TEST NO.	DEPTH	PRE-WET		TEST - 1" DROP		TIME
			START	STOP	START	STOP	
11-3-94	457	Visual	to 11.5	- see profile			OK
	470	4.5 / VII.0	9:11	9:12 <sup>30</sup>	9:12 <sup>30</sup>	9:15	2 1/2 min
	488	4.5 / VII.0	6:42 <sup>45</sup>	6:51 <sup>30</sup>	6:51 <sup>30</sup>	7:05	13 1/2 min
	458	4.5 / VII.0	7:00 <sup>15</sup>	7:01 <sup>30</sup>	7:01 <sup>30</sup>	7:03 <sup>45</sup>	27/4 min
	469	4.5 / VII.2	6:54 <sup>15</sup>	6:58 <sup>30</sup>	6:58 <sup>30</sup>	7:07 <sup>30</sup>	9 min
11-2-94	489	4.5 / VII.5	9:10 <sup>15</sup>	9:12	9:12	9:15 <sup>30</sup>	3 1/4 min

REMARKS \_\_\_\_\_  
 TYPE OF SOIL \_\_\_\_\_  
 TESTED BY Amy McMiller ALSO PRESENT \_\_\_\_\_  
 TRENCH DESIGN DATA: AVERAGE PERCOLATION TIME 9 min use TRENCH WIDTH 3 sec  
 INLET DEPTH 3 1/2 MAXIMUM BOTTOM DEPTH 5 1/2 SQ. FT./BEDROOM 210 11/15/99

LOT 14  
40,991 SQ. FT.  
0.94 Acres

SCENIC DRIVE

MATCH LINE

MEADOW COURT TREE

20' LANDSCAPE EDGE (TYP)

*Reggs Meadows  
Copy from  
signed Robin Plan  
P-96-20*

SEE SHEET 2


LOT 37  
59,478 SQ. FT.  
1.37 Acres

LOT 38  
46,856 SQ. FT.  
1.07 Acres

LANDSCAPE LEGEND*	
DESCRIPTION	
TREES TO BE PROVIDED BY THE DEVELOPER INCORPORATED ON FINAL PLANS.	(Symbol: Circle with cross)
TREES IN SWM AREAS TO BE PROVIDED BY DEVELOPER AND INCORPORATED ON PLANS.	(Symbol: Circle with dot)
TREES ALONG LANDSCAPE EDGE TO BE PROVIDED BY THE BUILDER AND INCORPORATED ON PLOT PLAN.	(Symbol: Circle with plus)
TREES IN SWM AREAS TO BE PROVIDED BY DEVELOPER AND INCORPORATED ON PLANS.	(Symbol: Circle with asterisk)

FOR PLANTING REQUIREMENTS

TOP/O BULK PARCEL 1

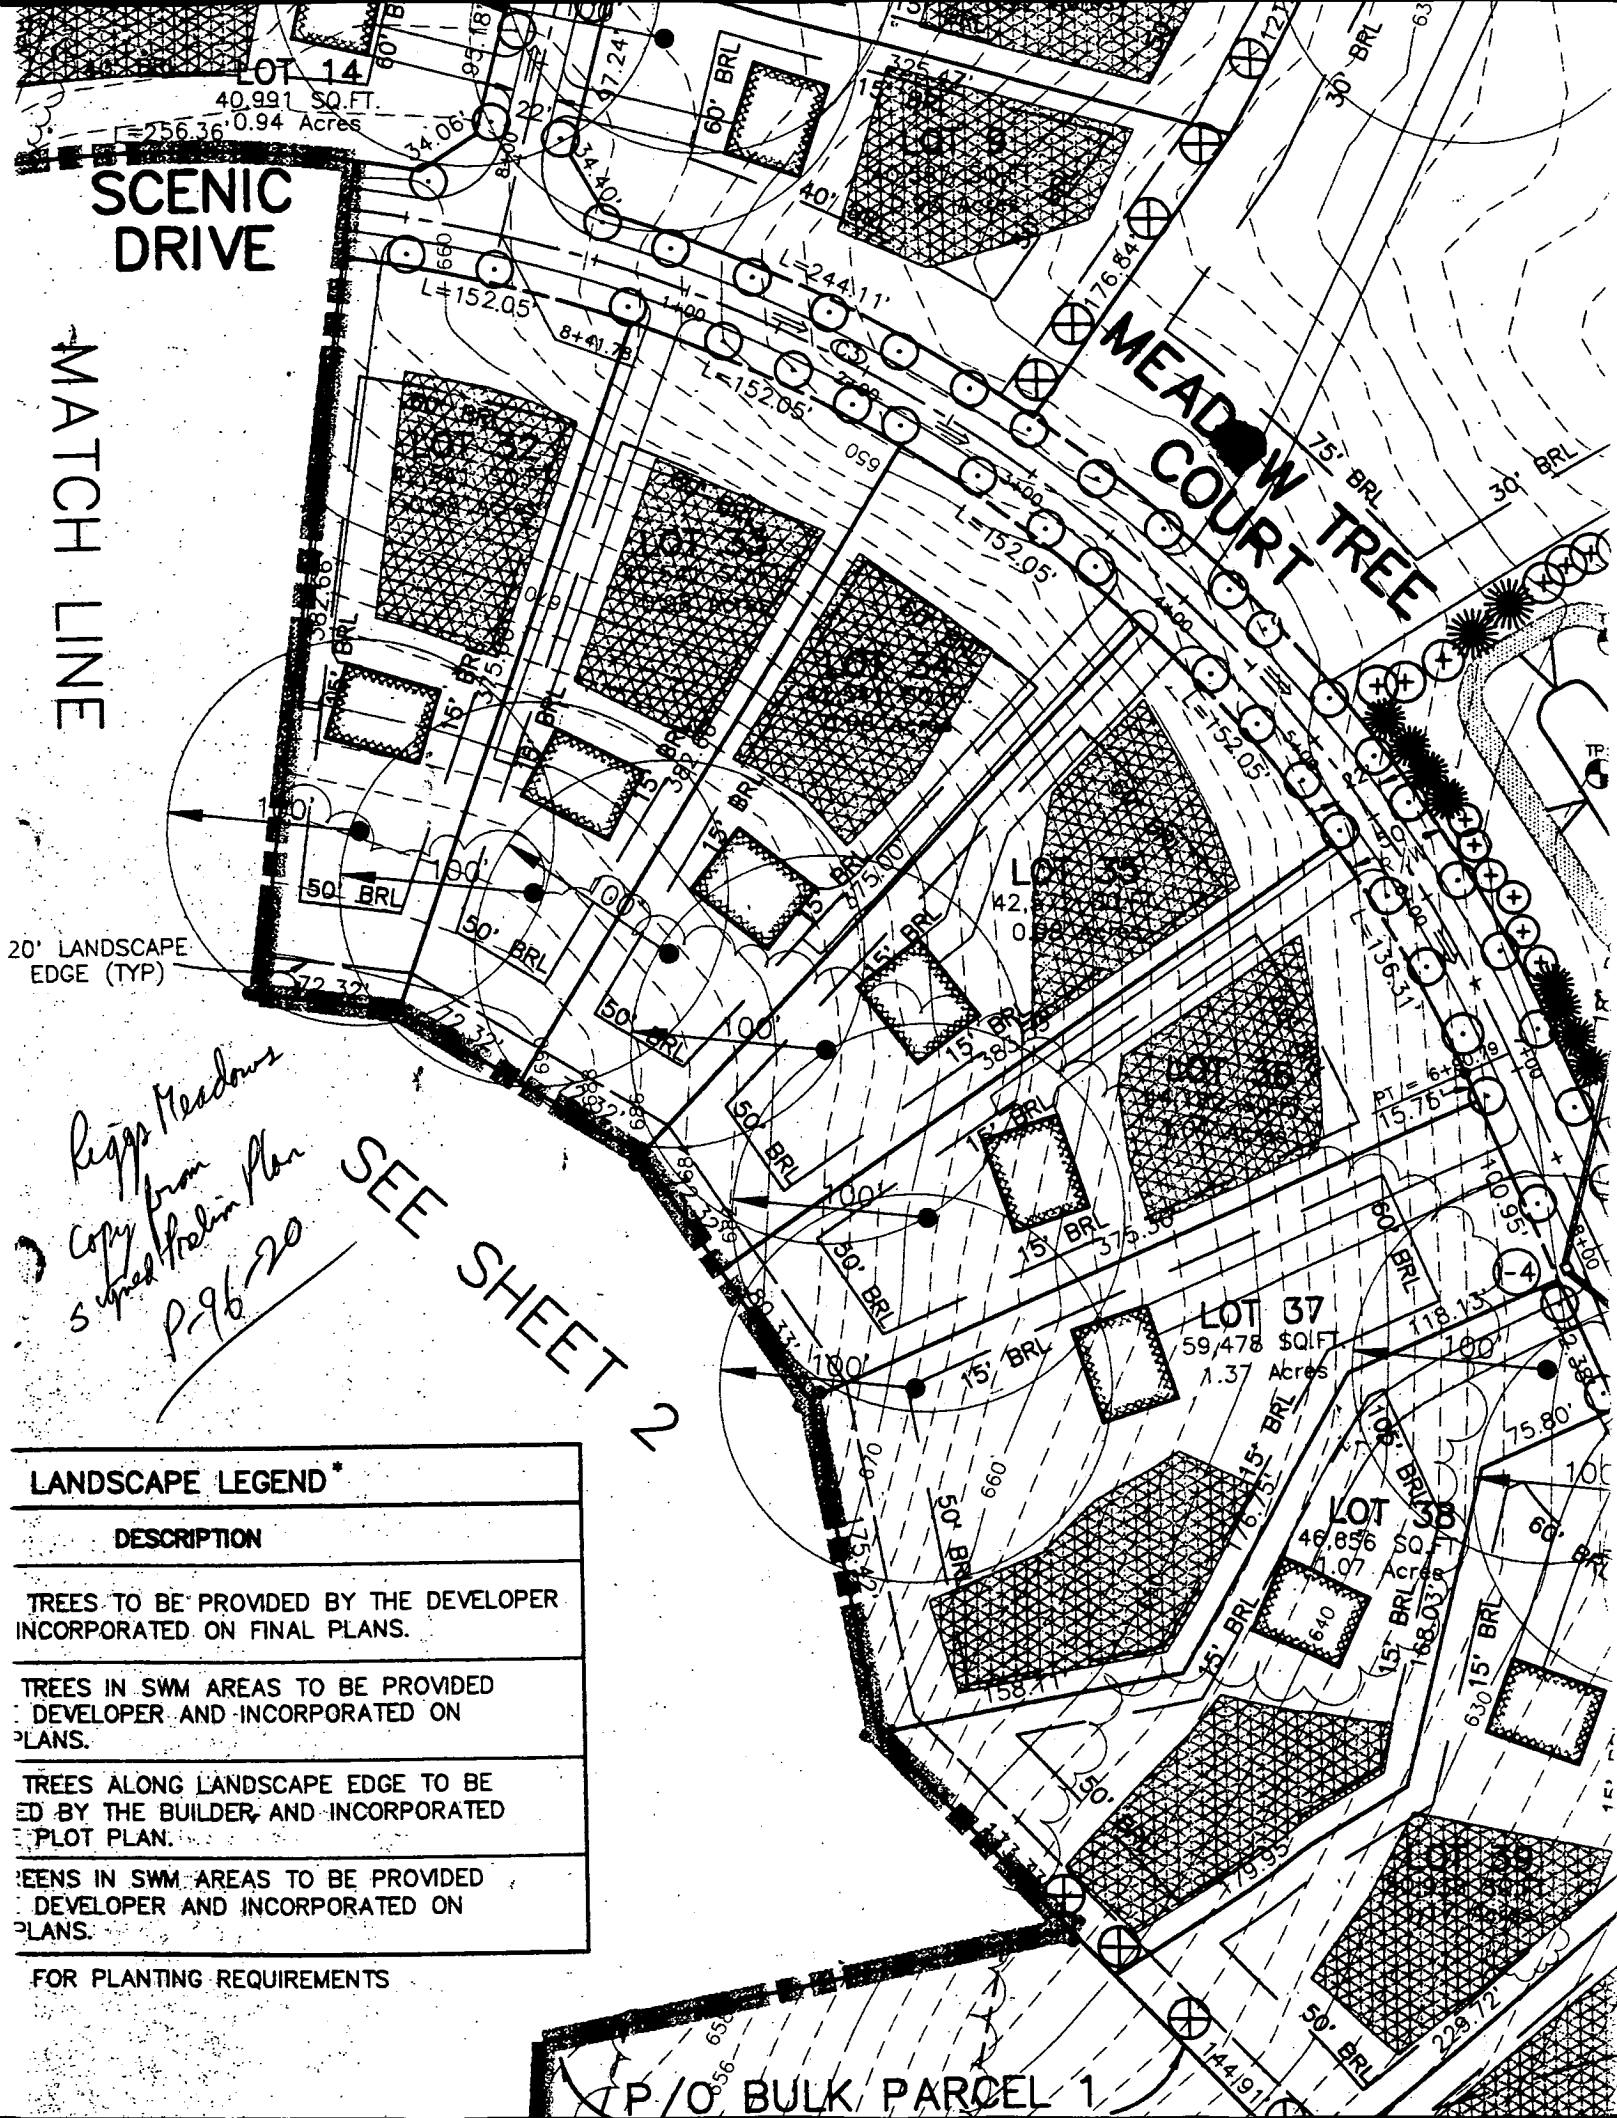



APRIL 30 AND FROM AUGUST 15  
 DUSHELS PER ACRE OF ANNUAL RYE  
 Y 1 THROUGH AUGUST 14, SEED  
 SS (.07 LBS/1000 SQ FT) FOR  
 Y 28, PROTECT SITE BY  
 DRED STRAW MULCH AND SEED AS  
 SOC.

ACRE (70 TO 90 LBS/1000 SQ FT)  
 ELY AFTER SEEDING. ANCHOR  
 G MULCH ANCHORING TOOL OR  
 ) OF EMULSIFIED ASPHALT ON  
 USE 348 GALLONS PER ACRE

AND SPECIFICATIONS FOR SOIL  
 AND METHODS NOT COVERED

**PREPARATION**

REE INCHES OF SOIL BY RAKING.  
 RE SEEDING, IF NOT PREVIOUSLY

ECOMMENDATIONS, USE ON OF

ACRE DOLOMITIC LIMESTONE (92  
 PER ACRE 10-10-10 FERTILIZER  
 EDING HARROW OR DISC INTC  
 TIME OF SEEDING, APPLY 40C  
 RV FERTILIZER (9 LBS/1000 SQ

ACRE DOLOMITIC LIMESTONE  
 LBS PER ACRE 10-10-10  
 BEFORE SEEDING. HARROW OR  
 OF SOIL.

IGH APRIL 30 AND AUGUST 1  
 R ACRE (1.4 LBS/1000 SQ FT)  
 O 2 LBS PER ACRE (.05  
 DURING THE PERIOD OF OCTOBER  
 OPTION (1) 2 TONS PER ACRE  
 AS SOON AS POSSIBLE IN THE  
 ED WITH 60 LBS PER ACRE  
 WITH 2 TONS PER ACRE OF WELL

ACRE (70 TO 90 LBS/1000 SQ FT)  
 ELY AFTER SEEDING. ANCHOR  
 G MULCH ANCHORING TOOL OR  
 OF EMULSIFIED ASPHALT ON  
 USE 348 GALLONS PER ACRE

AND MAKE NEEDED REPAIRS.

**CONTROL NOTES**

BE GIVEN TO THE HOWARD COUNTY  
 NTS SEDIMENT CONTROL DIVISION PRIOR

TICES ARE TO BE INSTALLED ACCORDING  
 ARE TO BE IN CONFORMANCE WITH THE  
 FICATIONS FOR SOIL EROSION AND SEDIMENT


REDISTURBANCE. PERMANENT OR  
 MPLETED WITHIN: A) 7 CALENDAR DAYS  
 STRUCTURES DIKES, PERIMETER SLOPES  
 14 DAYS AS TO ALL OTHER DISTURBED

ST BE FENCED AND WARNING SIGNS POSTEI  
 CE WITH VOL 1, CHAPTER 12, OF THE  
 M DRAINAGE.


ED WITHIN THE TIME PERIOD SPECIFED  
 MARYLAND STANDARDS AND SPECIFICATION  
 20. FOR PERMANENT SEEDINGS (SEC 51),  
 C. 50) AND MULCHING (SEC 52  
 ALONE CAN ONLY BE DONE WHEN  
 ALLOW FOR PROPER GERMINATION AN

TO REMAIN IN PLACE AND ARE TO BE  
 TIL PERMISION FOR THEIR REMOVAL HAS  
 NTY SEDIMENT CONTROL INSPECTOR

- UNLESS OTHERWISE SHOWN, NO WELLS OR SEWERAGE EASEMENTS ARE LOCATED WITHIN 100 FEET OF THE PROPERTY.
- TOPOGRAPHY SHOWN HEREON IS TAKEN FROM F-87-41 BENCH MAP PREPARED BY THE TSA GROUP, INC.
- EXACT LENGTH OF SEPTIC TRENCHES TO BE DETERMINED BY THE HEALTH DEPARTMENT AT THE TIME OF PERMIT ISSUANCE.

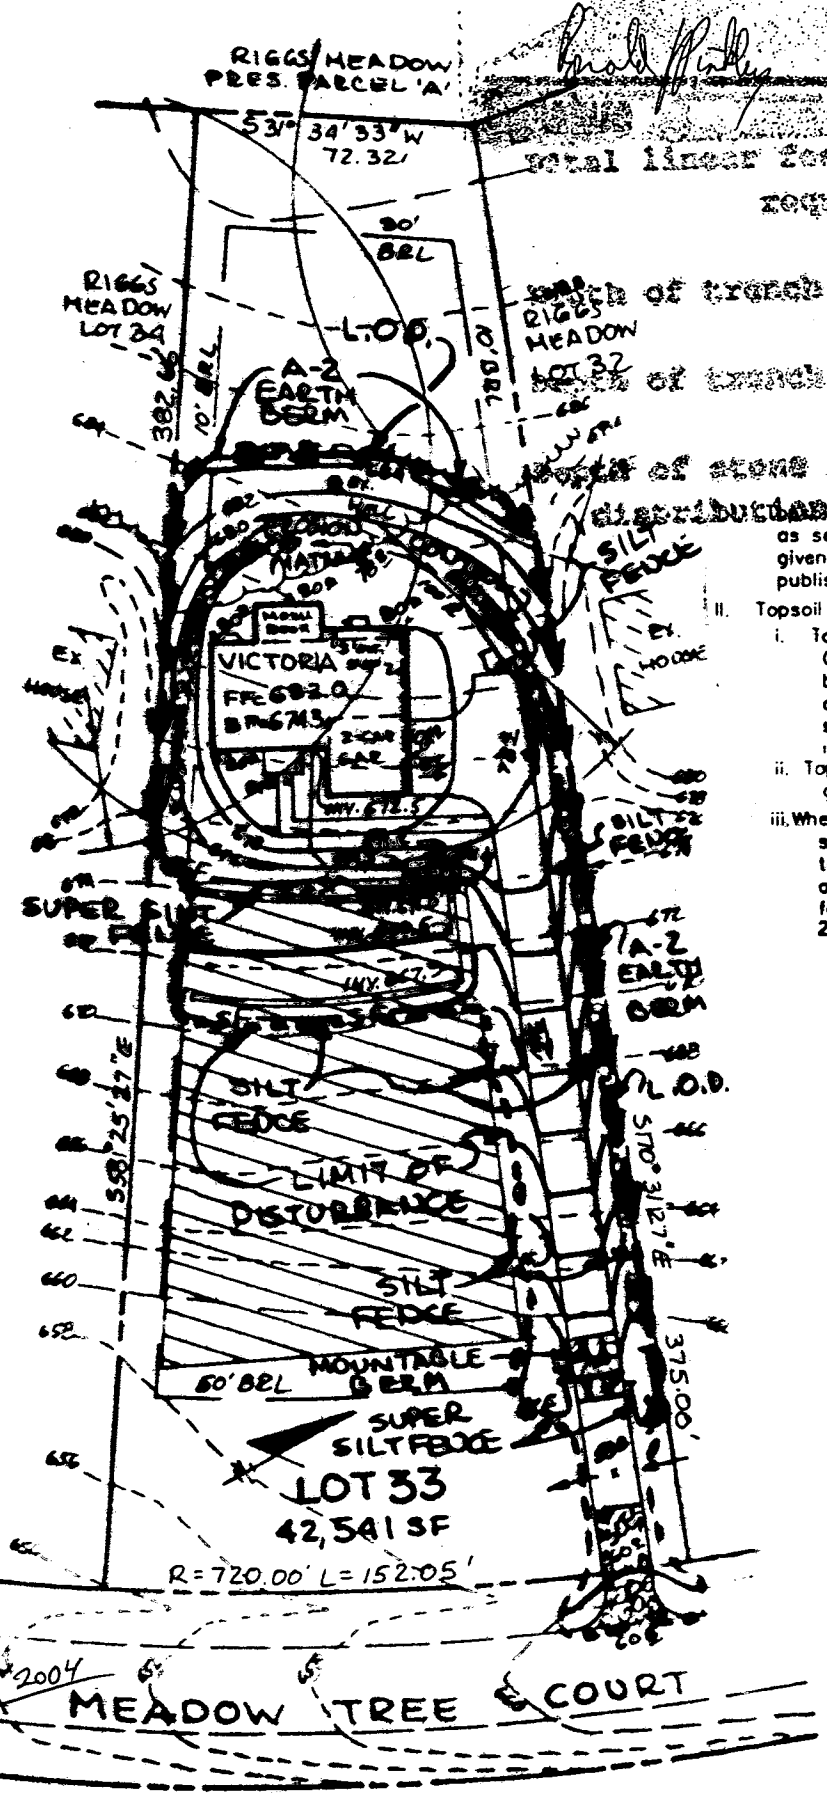


*Handwritten notes:*  
 Total linear feet of trench required 320 feet  
 Length of trench(es) 3 feet  
 Width of trench(es) 5.5 feet  
 Amount of stone required 260 cubic feet  
 Distribution sign from the existing site may be set forth in these specifications.

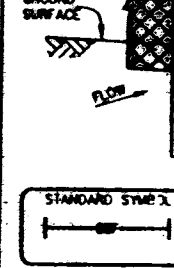

U.S. DEPARTMENT OF AGRICULTURE  
 SOIL CONSERVATION SERVICE

- TOPSOIL STANDARDS AND SPECIFICATIONS**
- Topsoil shall be a loam, sandy loam, clay loam, or silty loam. Other soils may be used if recommended by the appropriate approval authority. Contrasting textured subsoils and shall slogs, coarse fragments, gravel, sticks, or roots in diameter.
- ii. Topsoil must be free of plants or plant parts, grass, nutsedge, poison ivy, thistle, or other weeds.
- iii. Where the subsoil is either highly acidic or alkaline, it shall be spread at the rate of 4-8 tons per acre to the placement of topsoil. Lime shall be applied and worked into the soil in conjunction with the topsoil following procedures. Place topsoil (if required) in accordance with Section 12.0.0 Vegetative Stabilization - Section 12.0.0.

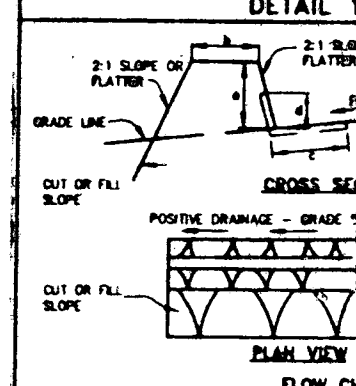

- Seed and cover with straw mulch.
- Seed and cover with Erosion Control Blanket.
- 4" - 7" stone or respaced concrete.
- All temporary earth dikes shall have a 2:1 slope or flatter. Spot elevations may be necessary for construction.
- Runoff diverted from a disturbed area to a non-erosive area.
- Runoff diverted from an undisturbed area to a non-erosive area.
- All trees, brush, stumps, obstructions and debris shall be removed or disposed of so as not to interfere with the functioning of the device.
- The dikes shall be excavated or shaped to meet the criteria specified herein. Irregularities which will impede normal flow shall be corrected.
- All earth removed and not needed for construction shall be disposed of so as not to interfere with the functioning of the device.
- Inspection and maintenance must be performed as specified.

U.S. DEPARTMENT OF AGRICULTURE  
 SOIL CONSERVATION SERVICE

0.98	ACRES
0.44	ACRES
0.12	ACRES
0.82	ACRES
970	CU YDS
497	CU YDS

**PLAN**  
 SCALE: 1" = 50'

DETAIL 24 - STABILIZED CONSTRUCTION ENTRANCE

C1 4191

SEQUENCE NO. (MDE USE ONLY)

STATE OF MARYLAND WELL COMPLETION REPORT

THIS REPORT MUST BE SUBMITTED WITHIN 45 DAYS AFTER WELL IS COMPLETED.

(THIS NUMBER IS TO BE PUNCHED IN COLS. 3-6 ON ALL CARDS)

FILL IN THIS FORM COMPLETELY PLEASE PRINT OR TYPE

COUNTY NUMBER A50463-B

ST/CO USE ONLY DATE RECEIVED

DATE WELL COMPLETED 050396

Depth of Well 345 (TO NEAREST FOOT)

PERMIT NO. FROM "PERMIT TO DRILL WELL" 10-94-0754

OWNER SDC STREET OR RFD TOWN COOKSVILLE SUBDIVISION 121495 PROPERTY SECTION 7 LOT 33

WELL LOG table with columns: DESCRIPTION, FEET (FROM, TO), check if water bearing. Includes entries for Brown Shale, Yellow Clay, Brown Shale, and Gray Micaceous Rock.

GROUTING RECORD: WELL HAS BEEN GROUTED (Y), TYPE OF GROUTING MATERIAL (CM, BC), NO. OF BAGS (27), NO. OF POUNDS (2538), DEPTH OF GROUT SEAL (60).

CASING RECORD: casing types insert appropriate code below (ST, CO, PL, OT).

MAIN CASING TYPE: ST, Nominal diameter top (main) casing (6), Total depth of main casing (66).

OTHER CASING (if used) table with diameter and depth columns.

SCREEN RECORD: screen type or open hole (ST, BR, HO, PL, OT).

NUMBER OF UNSUCCESSFUL WELLS: 0, WELL HYDROFRACTURED (Y).

CIRCLE APPROPRIATE LETTER: A (abandoned), E (electric log), P (test well converted).

I HEREBY CERTIFY THAT THIS WELL HAS BEEN CONSTRUCTED IN ACCORDANCE WITH COMAR 26.04.04 "WELL CONSTRUCTION" AND IN CONFORMANCE WITH ALL CONDITIONS STATED IN THE ABOVE CAPTIONED PERMIT...

TYPE: MWD/MSD/MGD 24, DRILLERS LIC. NO. [signature]

DRILLERS SIGNATURE [signature], LIC. NO. 27, [signature]

SITE SUPERVISOR (sign. of driller or journeyman responsible for sitework if different from permittee)


DEPTH (nearest ft.) table with rows for casing height and slot size. Includes handwritten values 65 and 345.

GRAVEL PACK IF WELL DRILLED WAS FLOWING WELL INSERT F IN BOX 68

MDE USE ONLY (NOT TO BE FILLED IN BY DRILLER) T, W Q, TELESCOPE CASING, LOG INDICATOR, OTHER DATA

PUMPING TEST: HOURS PUMPED (3), PUMPING RATE (004), METHOD USED TO MEASURE PUMPING RATE (Bucket), WATER LEVEL (42), BEFORE PUMPING (755), WHEN PUMPING (755), TYPE OF PUMP USED (S).

PUMP INSTALLED: DRILLER WILL INSTALL PUMP (NO), TYPE OF PUMP INSTALLED PLACE (A,C,J,P,R,S,T,O) IN BOX 29, CAPACITY: GALLONS PER MINUTE (to nearest gallon), PUMP HORSE POWER, PUMP COLUMN LENGTH (nearest ft.), CASING HEIGHT (+ above, - below), LAND SURFACE (nearest foot).

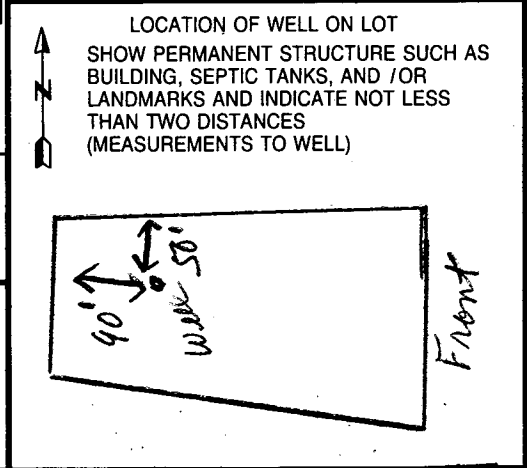

B 1 **3031** SEQUENCE NO. (MDE USE ONLY)

(THIS NUMBER IS TO BE PUNCHED IN COLS. 3-6 ON ALL CARDS)

STATE OF MARYLAND  
PERMIT TO DRILL WELL  
please print or type

STATE PERMIT NUMBER  
**HO-94-0754**  
fill in this form completely

Date Received (APA) **040996**

**OWNER INFORMATION**

**SDC** 15 Last Name Owner First Name 34

**BOXH17** 36 Street or RFD 55

**ELLICOTT CITY MD 21041** 57 Town 70 State 72 Zip 76

B 3 LOCATION OF WELL

**HOWARD** 8 COUNTY

**RIGGS PROPERTY** 23 SUBDIVISION 42

SECTION  44  46 LOT **33** 48 50

**COORSVILLE** 52 NEAREST TOWN 71

MILES FROM TOWN (enter 0 if in town) **1** 73 **M** 76 **I** 77 **I** 78

**DRILLER INFORMATION** CIRCLE: MSD/MGD/MWD

**Joseph L. Mayne** 77 License No. **24**

**Joseph L. Mayne Well Drilling** Firm Name

**5512 Ridge Rd. Mt Airy 21771** Address

**Joseph L. Mayne 4/9/96** Signature Date

B 4 DIRECTION OF WELL FROM TOWN (CIRCLE BOX)

**Road B South** 11 NEAR WHAT ROAD 30

ON WHICH SIDE OF ROAD (CIRCLE APPROPRIATE BOX)

**300** 34 DISTANCE FROM ROAD 37

ENTER FT OR MI **FT** 38 39

TAX MAP: **14** BLK: \_\_\_\_\_ PARCEL **96**

B 2 WELL INFORMATION

APPROX. PUMPING RATE (GAL. PER MIN.) **5** 8 12

AVERAGE DAILY QUANTITY NEEDED (GAL. PER DAY) **500** 14 20

USE FOR WATER (CIRCLE APPROPRIATE BOX)

D HOME (SINGLE OR DOUBLE HOUSEHOLD UNIT ONLY)

F FARMING (LIVESTOCK WATERING & AGRICULTURAL IRRIGATION)

I INDUSTRIAL, COMMERCIAL, STATE AND FEDERAL GOV. OTHER (REQUIRES APPROPRIATION PERMIT)

P PUBLIC OR PRIVATE WATER COMPANY (REQUIRES APPROPRIATION PERMIT AND STATE HEALTH DEPARTMENT APPROVAL)

T TEST, OBSERVATION, MONITORING (MAY REQUIRE APPROPRIATION PERMIT)

NOT TO BE FILLED IN BY DRILLER HEALTH DEPARTMENT APPROVAL

**HOWARD COUNTY** COUNTY NAME

**A 50463-B** COUNTY NO.

STATE SIGNATURE \_\_\_\_\_ INSERT S  41

DATE ISSUED **04/11/96** **A. McMullen** 4/11/97

43 CO SIGNATURE 48 EXP. DATE

NORTH GRID **540000** 50 55 EAST GRID **0788000** 57 63

APPROXIMATE DEPTH OF WELL **180** 24 FEET 28

APPROXIMATE DIAMETER OF WELL **6** NEAREST INCH

METHOD OF DRILLING (circle one)

BORED (or Augered)  JETTED  Jetted & DRIVEN

AIR-ROTARY  AIR-PERCussion  ROTARY (Hydraulic Rotary)

CABLE  REVerse-ROTary  DRive-POINT

other \_\_\_\_\_

REPLACEMENT OR DEEPEMED WELLS (CIRCLE APPROPRIATE BOX)

N THIS WELL WILL NOT REPLACE AN EXISTING WELL

Y THIS WELL WILL REPLACE A WELL THAT WILL BE ABANDONED AND SEALED

S THIS WELL WILL REPLACE A WELL THAT WILL BE USED AS A STANDBY-CONTACT LOCAL APPROVING AUTHORITY FOR POLICY ON STANDBY WELLS

D THIS WELL WILL DEEPEAN AN EXISTING WELL

PERMIT NUMBER OF WELL TO BE REPLACED OR DEEPEMED (IF AVAILABLE) 41 \_\_\_\_\_ 52

Not to be filled in by driller (MDE OR COUNTY USE ONLY)

APPROX. PERMIT NUMBER \_\_\_\_\_ 54 **G A P** 63

FORCE **AM** WRITE INITIALS IN BOX 67 68 PERMIT No. **HO-94-0754** 70 71 72 73 74 75 76 77 78 79

SHOW MAJOR FEATURES OF BOX & LOCATE WELL WITH AN X

SOURCES OF DRILLING WATER

- WELL**
- 
- 

WRITE THE BOX NUMBER FROM THE MAP HERE

E **79088**

N **52040** 000 000

