

# APPLICATION

A 02994

P. 03183

SEWAGE DISPOSAL TESTING

MARYLAND STATE DEPARTMENT OF HEALTH

HOWARD COUNTY

ELLICOTT CITY

DISTRICT 2

DATE 9-26-60

*one 8 ft by 12 ft dry well below  
the inlet located 5 ft from the front  
property line and 30 ft off the right side  
property line as determined when passing  
100 ft from Avoca Ave.  
750 gal septic tank!*

TO: THE COUNTY HEALTH OFFICER  
ELLICOTT CITY, MARYLAND

I, HEREBY, APPLY FOR THE NECESSARY TESTS IN ORDER TO CONSTRUCT (OR RECONSTRUCT) A SEWAGE DISPOSAL SYSTEM.

PROPERTY OWNER Virgil Lough

ADDRESS Ellicott City PHONE How. 5-2324

PROPERTY LOCATION:

SUBDIVISION McHenry Sub. Div. LOT NO. 3

ROAD AND DESCRIPTION Avoca Ave - 300 ft. off Montgomery Rd.

OCCUPANT \_\_\_\_\_ PHONE \_\_\_\_\_

PERSON TO CONSTRUCT SYSTEM \_\_\_\_\_

ADDRESS \_\_\_\_\_ PHONE \_\_\_\_\_

SIZE OF LOT 3 ACRES TYPE BLDG. 3 NUMBER OF BEDROOMS \_\_\_\_\_

IF NOT SINGLE RESIDENCE DESCRIBE \_\_\_\_\_

SIGNATURE OF APPLICANT *Virgil Lough*


APPROVED BY *Hennessey* FOR *Dry Well* DATE 9-27-60

REJECTED BY \_\_\_\_\_ FOR \_\_\_\_\_ DATE \_\_\_\_\_

HOLD PENDING FURTHER TESTS \_\_\_\_\_ DATE \_\_\_\_\_

REASONS FOR REJECTION OR HOLDING \_\_\_\_\_

## THIS IS NOT A PERMIT

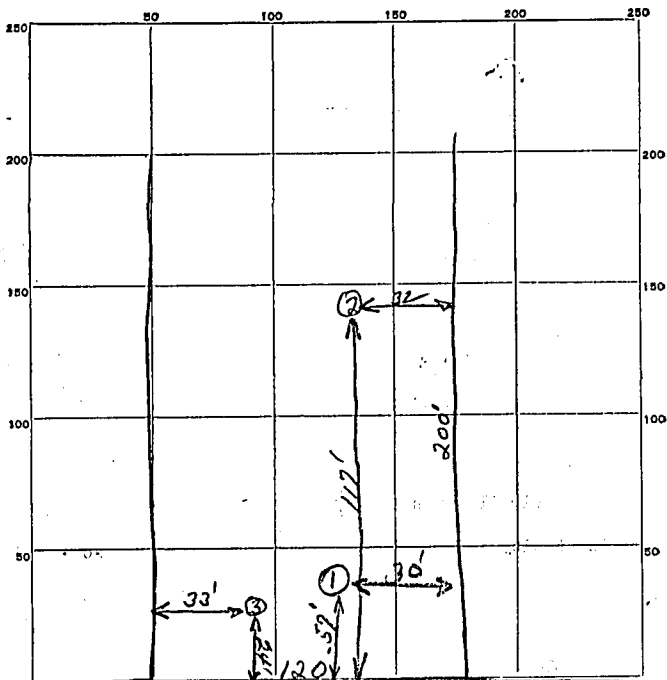

\* INDICATE NORTH - NAME ADJOINING ROADWAY AS BASE LINE.

DATE	TEST NO.	DEPTH	PRE-WET		TEST - 1" DROP		TIME
			START	STOP	START	STOP	
9-27-60	1	9FT	1:15	1:18	1:18	1:25	7 Minutes
11-18-60	2	9FT	2:06	Slow Perc.			
1-19-60	3	7FT	10:59	10:06	10:06	10:14	8 Minutes

1-19-60  
 O. S. Smith  
 11-18-60  
 O. S. Smith

SOIL AUGER FINDING \_\_\_\_\_  
 TESTED BY *J.H.*  
 REMARKS *Down soil hole*  
 9-27-60 *V. Sample*  
 ALSO PRESENT \_\_\_\_\_ LOT NO. *3*