

11/13/98
C.O. 11-80

PERMIT

SEWAGE DISPOSAL SYSTEM

DEPARTMENT OF HEALTH AND MENTAL HYGIENE

04-358503

P 5110313

A 50572-Q

DISTRICT 4th

DATE 10-8-98

DATE SYSTEM APPROVED 11/13/98

INSPECTOR DKS

HOWARD COUNTY HEALTH DEPARTMENT
BUREAU OF ENVIRONMENTAL HEALTH
~~XXXXXX~~ 410-313-2640

(INDEXED)

K & K Excavating IS PERMITTED TO INSTALL X ALTER

ADDRESS 14960 Rt. 144 Woodbine, MD 21797 PHONE (410)442-1336

SUBDIVISION Carriage Mill Farms LOT 23 ROAD 14762 Addison Way

PROPERTY OWNER Oak Hill Properties, Alison Lally

ADDRESS

SEPTIC TANK CAPACITY 1250 GALLONS

NUMBER OF BEDROOMS 4

180 SQUARE FEET PER BEDROOM

LINEAR FEET OF TRENCH REQUIRED 206 180

ADJ. PERMITS SHIPPED
AND RETURNED 6-9-99
Submittal 118547
check

TRENCHES - Trench to be 2 feet wide. Inlet ^{3.0} 3 1/2 feet below original grade. Bottom maximum depth 7 feet below original grade. Effective area begins at 3 1/2 feet below original grade. 3 1/2 feet of stone below distribution pipe. ^{3.0}

LOCATION - Place the distribution box 140 feet off rear lot line and 40 feet off left lot line as seen when facing the lot from Addison Way. Run trenches along contour towards the right lot line.

NOTES - No trench to exceed 100 feet in length. Provide 6" - 8" diameter cleanout and cap to grade or above on septic tank.

11/12/98 Spec change OK Au OK KM 8-29-98

PLANS APPROVED BY Keith Sykes/Donna K. Soe DATE 08/26/98

COVER NO WORK UNTIL INSPECTED AND APPROVED

NEITHER THE HOWARD COUNTY COUNCIL NOR THE HEALTH DEPARTMENT IS RESPONSIBLE FOR THE SUCCESSFUL OPERATION OF ANY SYSTEM

NOTE: CLEANOUT REQUIRED EVERY 70 FEET OF SEWER LINE AND/OR AT 90° SWEEPS IN LINES FROM HOUSE TO DRAIN FIELDS. 90° ELBOWS NOT ACCEPTABLE.

NOTE: ALL PARTS OF SEPTIC SYSTEMS (I.E. TANK, DISTRIBUTION BOX TRENCHES) TO BE 100 FEET FROM WELL (UNLESS OTHERWISE SPECIFICALLY AUTHORIZED)

NOTE: IF DEEP TRENCH(ES) ARE USED CALL FOR INSPECTION BEFORE AND AFTER PLACING GRAVEL IN TRENCH(ES)

NOTE: NO DRY WELL SHALL EXCEED 15 FOOT IN DIAMETER NO ABSORPTION TRENCH TO EXCEED 100 FEET IN LENGTH

NOTE: ALL PIPE FROM HOUSE TO SEPTIC TANK MUST BE CAST IRON OR SCHEDULE 35/40 PVC OR ABS


PERMIT VOID AFTER TWO YEARS

NOTE: INSTALL STAND PIPE ON SEPTIC TANK AND DRY WELL STAND PIPES MUST BE 6 INCHES IN DIAMETER CAST IRON, CONCRETE OR TERRA COTTA OR PVA OR ABS ACCEPTED. IF TOP OF SEPTIC TANK IS DEEPER THAN 3 FEET, MANHOLE TO GRADE REQUIRED.

NOTE: DISTRIBUTION BOXES MUST HAVE BAFFLES

***INSTALLER IS RESPONSIBLE FOR OBTAINING FINAL APPROVAL ON THIS PERMIT**

50572-Q

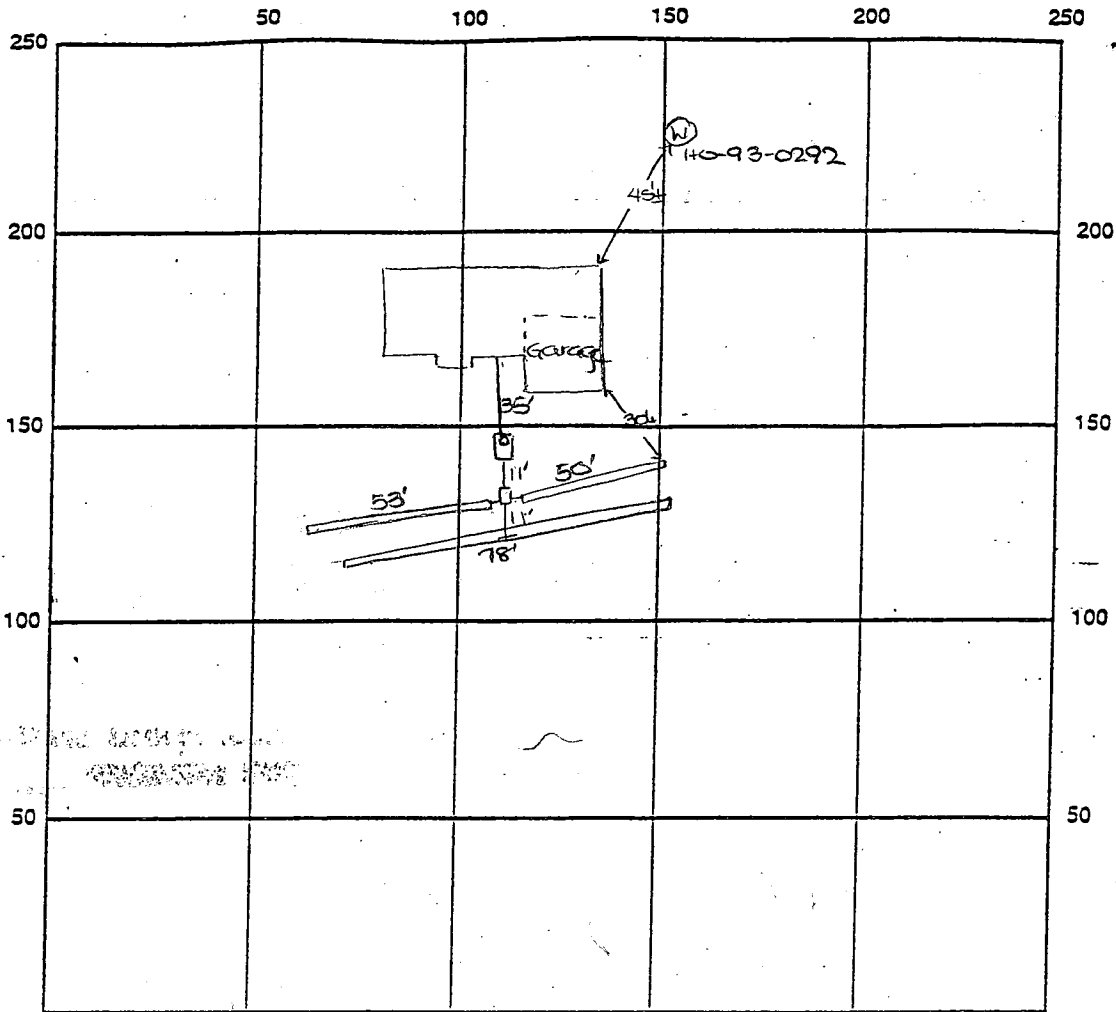

INDICATE NORTH - NAME ADJOINING ROADWAY AS BASE LINE

Addison Way

SEPTIC TANK LEVEL OK - 1250 gal CLEANOUTS one on sit.

DISTRIBUTION BOX LEVEL OK

DRAIN FIELD/TITLE DEPTH 7 FT. TRENCH WIDTH 2 FT. INLET DEPTH 3 FT.

EFFECTIVE GRAVEL DEPTH 4 FT. TOTAL LENGTH 181 FT. (with handwritten notes: 050 @ 78, 253)

NUMBER OF TRENCHES 3 ONE SIDEWALL/BOTTOM AREA 724 SQ. FT.

DRYWALL INSIDE DIAMETER — FT. EFFECTIVE DEPTH BELOW INLET — FT.

ABSORBENT AREA — SQ. FT.

REMARKS: 11/13/98 FINAL INSP - OK TO COVER ALL WORK AS completed - sufficient materials @ site. DKS

DATE SYSTEM APPROVED 11/13/98 INSPECTOR [Signature]

APPLICATION

PERCOLATION TESTING

A 50572 (Q)

P _____

HOWARD COUNTY HEALTH DEPARTMENT
BUREAU OF ENVIRONMENTAL HEALTH
3525-H ELLICOTT MILLS DRIVE/ELLICOTT CITY, MARYLAND 21043
TELEPHONE: 313-2640

DISTRICT 4

DATE March 6, 1995

TO: THE COUNTY HEALTH OFFICER
ELLICOTT CITY, MARYLAND

I HEREBY APPLY FOR THE NECESSARY TEST PRIOR TO APPLICATION FOR PERMIT TO CONSTRUCT (OR RECONSTRUCT) A SEWAGE DISPOSAL SYSTEM.

PROPERTY OWNER Oak Hill Properties, L.L.C.

ADDRESS 11501 Huff Court, North Bethesda, MD 20895 PHONE 301 816 9433

AGENT OR PROSPECTIVE BUYER Oak Hill Properties, L.L.C./ c/o Ralph E. Bice, III

ADDRESS Same as Above PHONE Same As Above

PROPERTY LOCATION:

SUBDIVISION Berkshire Estates LOT NO. 34 823

ROAD AND DESCRIPTION Property is located on the Northeast Side of the intersection of Route 144 and Old Frederick Road. (14762 Addison Way)

BLDG. PERMIT ~~AND RETURNED~~ 8-24-98
Send # 50113707

TAX MAP 8 PARCEL# 158 & 79

SIZE OF LOT Average size equals 60,000sq. Feet TYPE BLDG. Single Family Detached - 4 Brms
(SINGLE FAMILY DWELLING OR COMMERCIAL)

THE SYSTEM INSTALLED UNDER THIS APPLICATION IS ACCEPTABLE ONLY UNTIL PUBLIC FACILITIES BECOME AVAILABLE. I FULLY UNDERSTAND THE FEE CONNECTED WITH THE FILING OF THIS PERC TEST APPLICATION IS NON-REFUNDABLE UNDER ANY CIRCUMSTANCES. I ALSO AGREE TO COMPLY WITH ALL M.O.S.H.A. REQUIREMENTS IN TESTING THIS LOT.

Ralph E. Bice, III
(SIGNATURE OF APPLICANT)

APPROVED BY _____ FOR _____ DATE _____

DISAPPROVED BY _____ FOR _____ DATE _____

HOLD PENDING FURTHER TESTS _____

REASONS FOR REJECTION OR HOLDING _____

PERCOLATION TEST PLAT/PRELIMINARY PLAT - TITLE OR I.D. # _____ DATE _____


SITE DEVELOPMENT PLAN/FINAL PLAT - TITLE OR I.D. # _____ DATE _____

THIS IS NOT A PERMIT



AS0572 Q

COUNTY #

SOIL PROFILE

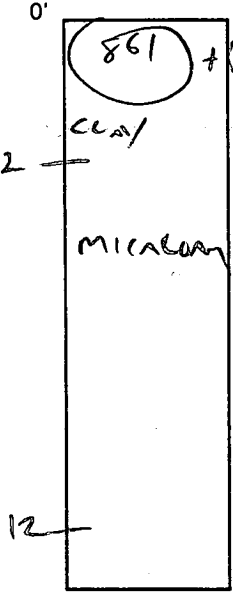

SOIL PROFILE

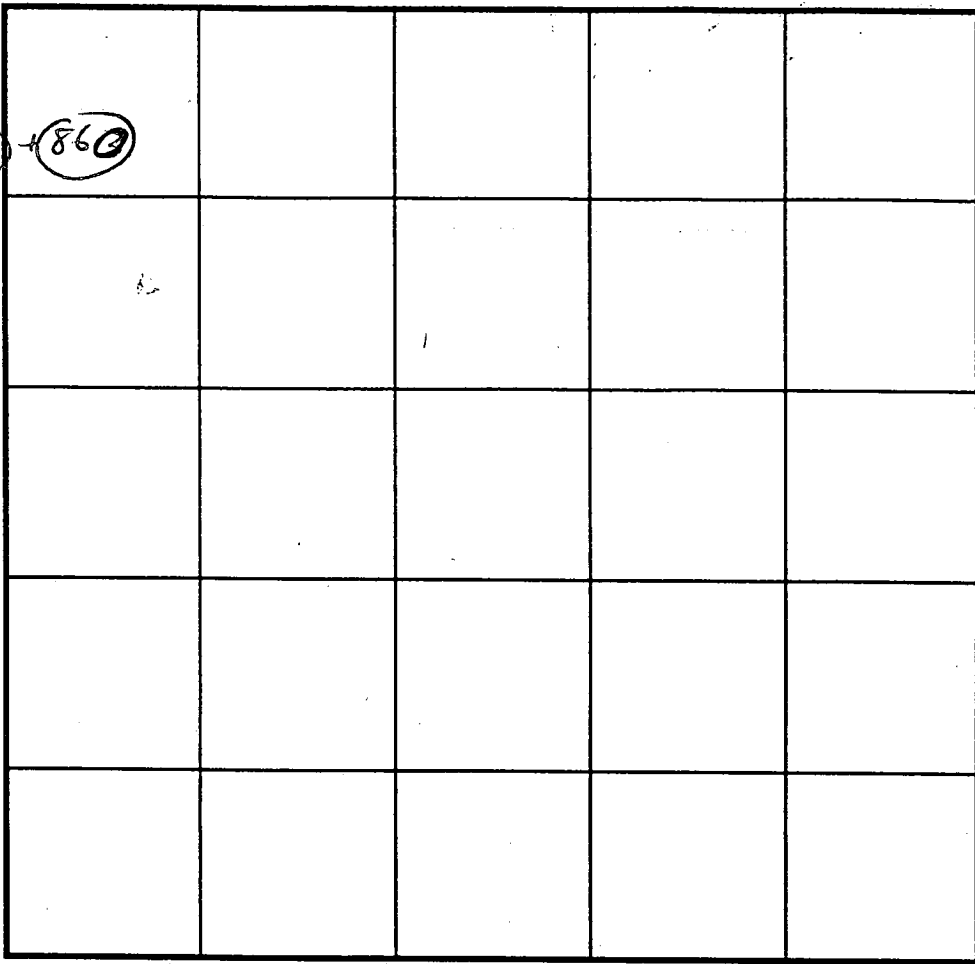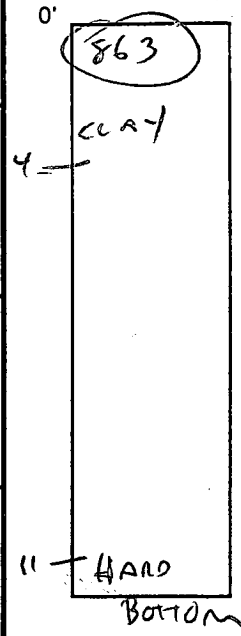

INDICATE NORTH - NAME ADJOINING ROADWAY AS BASE LINE.

DATE	TEST NO.	DEPTH	PRE-WET		TEST - 1" DROP		TIME
			START	STOP	START	STOP	
4/11/95	861	3	2:57	3:00	3:00	3:04	4 MIN
		8	2:56:30	2:57:30	2:57:30	2:59	1 1/2 MIN
		12					
	862	SAME	AS 861				
			VS OK 3' 12'				
	863	TRG					
	860						

REMARKS _____

TYPE OF SOIL _____


TESTED BY _____ ALSO PRESENT _____

TRENCH DESIGN DATA: AVERAGE PERCOLATION TIME 3 TRENCH WIDTH _____

INLET DEPTH 3 1/2 MAXIMUM BOTTOM DEPTH _____ SQ. FT./BEDROOM _____

NON-BUILDABLE BULK PARCEL "C"
PHASE ONE

NON-BUILDABLE BULK PARCEL "C"
PHASE ONE

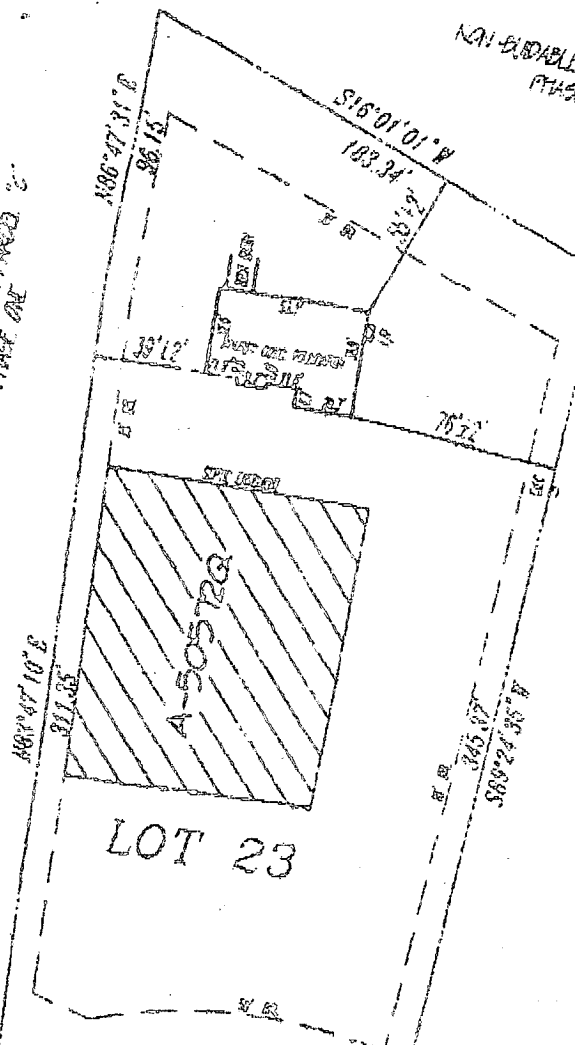

LOT 22

LOT 23

LEGEND

- F/P - FIREPLACE
- B/W - BAY WINDOW
- D/W - DRIVEWAY
- CONC - CONCRETE
- O/H - OVERHANG
- H/P - HEAT PUMP/AIR COND
- G/M - GAS METER
- E/M - ELECTRIC METER

ADDRESS No. 14703 ADDISON WAY
TOP OF WALL ELEV. = 832.8 FIRST FLOOR ELEV. =

NO BOUNDARY OR MONUMENTATION ESTABLISHED OR LOCATED.

THE LOCATION DRAWING IS OF BENEFIT TO THE CONSUMER ONLY INsofar AS IT IS REQUIRED BY A LENDER OR A TITLE INSURANCE COMPANY OR ITS AGENT IN CONNECTION WITH CONTINGENT TRANSFER, FINANCING OR REFINANCING.

THE LOCATION DRAWING IS NOT TO BE RELIED UPON FOR THE ESTABLISHMENT OR LOCATION OF FENCE, GARAGE, BUILDINGS, OR OTHER EXISTING OR FUTURE IMPROVEMENTS.

AND THE LOCATION DRAWING DOES NOT PROVIDE FOR THE ACCURATE IDENTIFICATION OF PROPERTY BOUNDARY LINES, BUT SUCH IDENTIFICATION MAY NOT BE REQUIRED FOR THE TRANSFER OF TITLE OR SECURING FINANCING OR REFINANCING.

FLOOD INSURANCE RATE MAP (FIRM) FLOOD ZONE "U"

AREA OF MINIMAL FLOODING

PLAT COMMUNITY PANEL NUMBER 24001+0002 B

FOR TITLE PURPOSES ONLY - NO TITLE REPORT FURNISHED

SUBJECT TO ALL EASEMENTS AND RIGHTS OF WAY OF RECORD

L=89.95
R=133.23
NOT 12' 47" E

REGER & DORRITY SERVICE
L 7-25 P 13

ADDISON WAY

LOT 23

CARRIAGE MILL FARMS
PHASE ONE

PLAT 12712
ELECTION DISTRICT No. 9
HOWARD COUNTY, MARYLAND

LOCATION DRAWING

FOUNDATION	DATE: 9/25/98
FINAL	DATE:
DRAWN BY: AWG	SCALE: 1"=50'
PROJECT No.:	95505.00




R.M. MOC-H GROUP, P.C.

P.O. Box 10
New Market, MD 21774-0010

10130 A Old National Pike
Hampden, MD 21754-9701

(301) 865-5800
Fax: (301) 865-8111

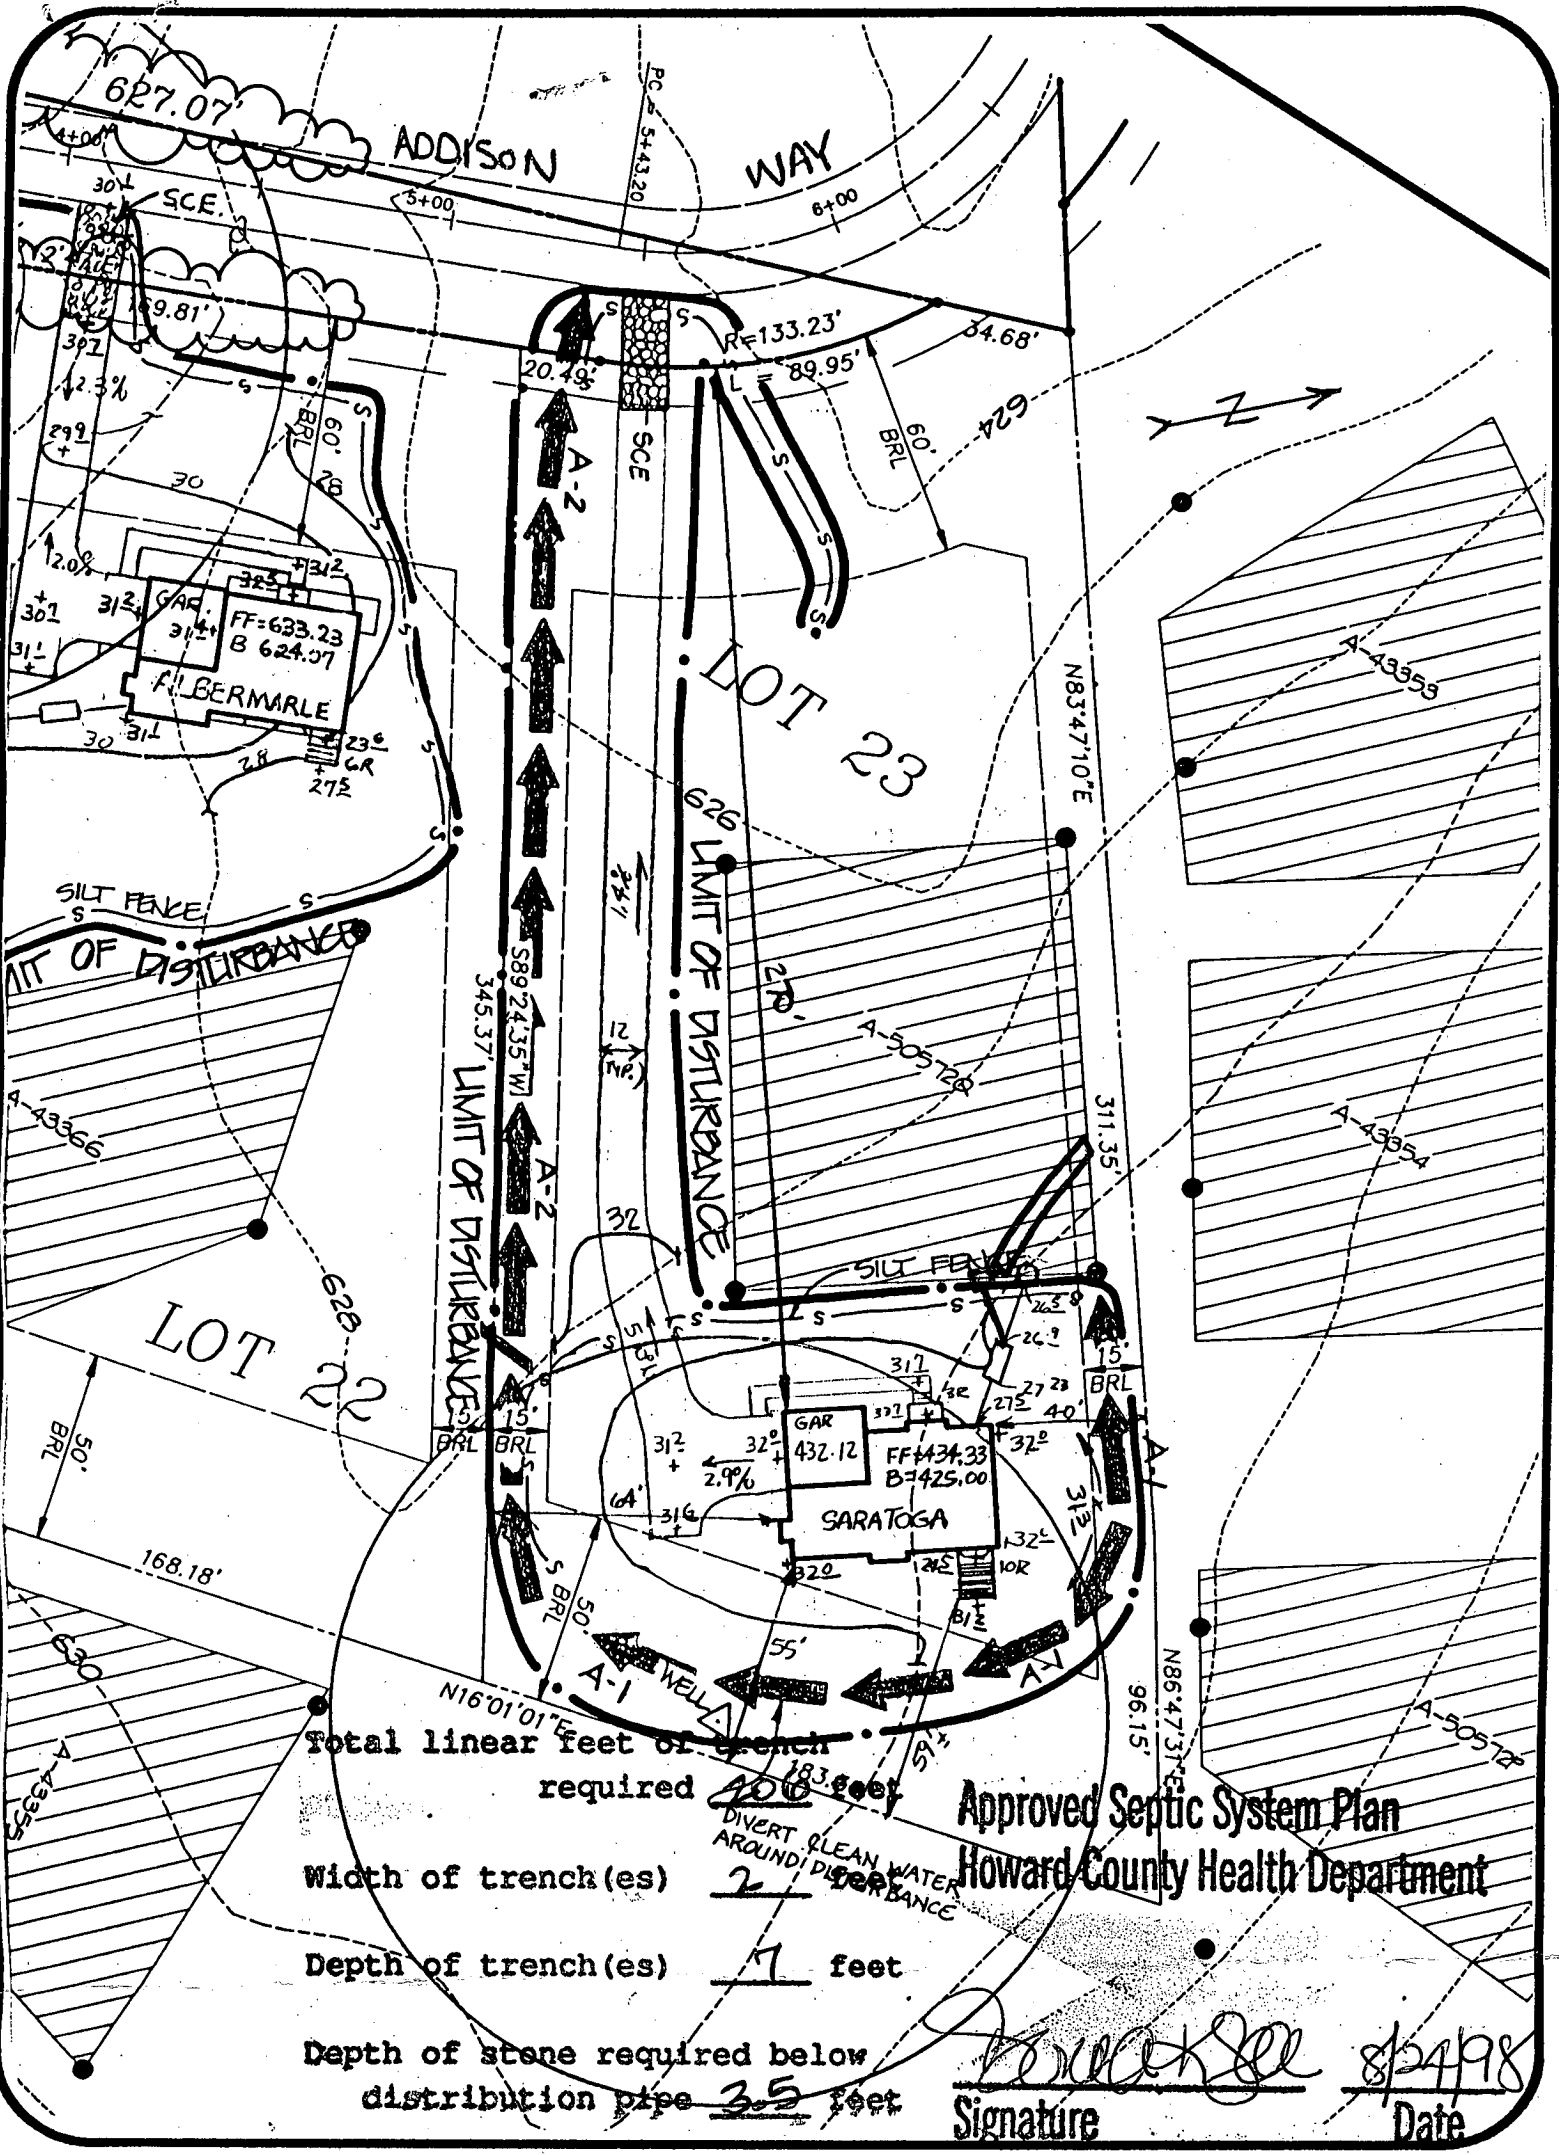

Total linear feet of trench required 100 feet

Width of trench (es) 2 feet

Depth of trench (es) 7 feet

Depth of stone required below distribution pipe 3.5 feet

CARRIAGE MILL FARMS

PHASE I
 LOT 23
 BUILDING PERMIT

DATE: 8/19/98 PROJECT NO.: 95005.22

DRAWN BY: P.F.B. SCALE: 1"=50'

SEPTIC DATA

INV. OUT OF HOUSE = 627.5
 INV. INTO SEPTIC TANK = 627.23
 INV. OUT SEPTIC TANK = 626.9
 INV. INTO DIST. BOX = 626.5
 EX. ELEV @ DIST. BOX = 630.0

GP-96167

R.M. MOCHI GROUP, P.C.

CIVIL ENGINEERS
 LAND SURVEYORS
 PLANNERS
 ENVIRONMENTAL

P.O. Box 10
 New Market, MD 21774-0010

10120 A Old National Pike
 ijamsville, MD 21754-9706

(301) 865-5858
 Fax: (301) 865-5111

12/16/98
 WPT - ok to cover
 below grade, casing 1' above grade
 P.A. 4" has 2pc cap! APPEAR Stewed out of house

HOWARD COUNTY HEALTH DEPARTMENT
 Bureau of Environmental Health
 3525-H Ellicott Mills Drive
 Ellicott City, MD 21043
 461-9933

APPLICATION FOR PITLESS ADAPTER, WELL PUMP AND PRESSURE TANK INSTALLATION

New Installation
 Replacement

Receipt # _____
 Date 12-14-98

Name of Installer Darren Wilson

Telephone 301-831-7057

License Number _____
 Certified Well Pump Installer Well Driller _____ Registered Plumber _____

Name of Property Owner Oak Hill Telephone 301-647-0929

Subdivision _____ Lot # 23 Well Tag # HO-93-0290

Site Address 14762 Admonway

Pump

- Type
 - Deep well jet _____
 - Shallow well jet _____
 - Submersible
- Make Grundfos
- Model # 50509422
- Capacity 5 GPM
- Pump exceeds well capacity Yes _____ No
- If Yes, is low pressure cutoff switch installed? Yes _____ No _____
- What methods are used to protect the pump and electrical wiring from vibrations? Torque arrestors _____ Cable guards Other _____

Motor

- Horsepower 1/2
- RPM 3400
- Voltage _____
 - 110 _____
 - 220

Pitless Adapter

- Make Martinson
- Model # B-10X
- Depth 3 1/2

Tank

- Capacity 32
- Pressure relief valve? yes

Piping

- Type PE
- Size 1"
- NSF and/or BOCA Code approved yes
- Depth of supply line 3 1/2

Well data

- Depth 300 ft.
- Yield 7 GPM
- Static water level _____ ft.
- Will water supply be disinfected by installer? yes

I understand that it is my responsibility to notify the Howard County Health Department when the installation is ready for inspection (otherwise this permit is null and void).

All information given above is true to the best of my knowledge.

Signature of Applicant: _____

Date: _____

Note: A sticker indicating approval/status of the installation will be placed on the well casing at the time of the inspection.

HOWARD COUNTY HEALTH DEPARTMENT
Bureau of Environmental Health
3525-H Ellicott Mills Drive
Ellicott City, MD 21043
461-9933

APPLICATION FOR PITLESS ADAPTER, WELL PUMP AND PRESSURE TANK INSTALLATION

New Installation
Replacement

Receipt #
Date 12-14-98

Name of Installer Darren Wilson

Telephone 301-831-7057

License Number _____

Certified Well Pump Installer

Well Driller _____

Registered Plumber _____

Name of Property Owner Oak Hill

Telephone 301-647-0929

Subdivision Carriage Mill Farms

Lot # 23

Well Tag # HO-93-0290

Site Address 14762 Adenway

Pump

- Type
 - Deep well jet _____
 - Shallow well jet _____
 - Submersible

Motor

- Horsepower 1/2
- RPM 3400
- Voltage _____
 - 110 _____
 - 220

Pitless Adapter

- Make Martinson
- Model # B-10X
- Depth 3 1/2

2. Make Goulds

3. Model # 50503422

4. Capacity 5 GPM

5. Pump exceeds well capacity Yes _____ No

6. If Yes, is low pressure cutoff switch installed? Yes _____ No _____

7. What methods are used to protect the pump and electrical wiring from vibrations? Torque arrestors _____ Cable guards Other _____

Tank

- Capacity 32
- Pressure relief valve? yes

Piping

- Type PE
- Size 1"
- NSF and/or BOCA Code approved yes
- Depth of supply line 3 1/2

Well data

- Depth 300 ft.
- Yield 7 GPM
- Static water level _____ ft.
- Will water supply be disinfected by installer? yes

I understand that it is my responsibility to notify the Howard County Health Department when the installation is ready for inspection (otherwise this permit is null and void).

All information given above is true to the best of my knowledge.

Signature of Applicant: Darren Wilson

Date: 12-16-98


Note: A sticker indicating approval/status of the installation will be placed on the well casing at the time of the inspection.

NON-DIVIDABLE BULK PARCEL "C"
PHASE ONE

NON-DIVIDABLE BULK PARCEL "C"
PHASE ONE

6/9/99
Shown deck
location will
have no impact
to ex well or
septic
A

LOT 22

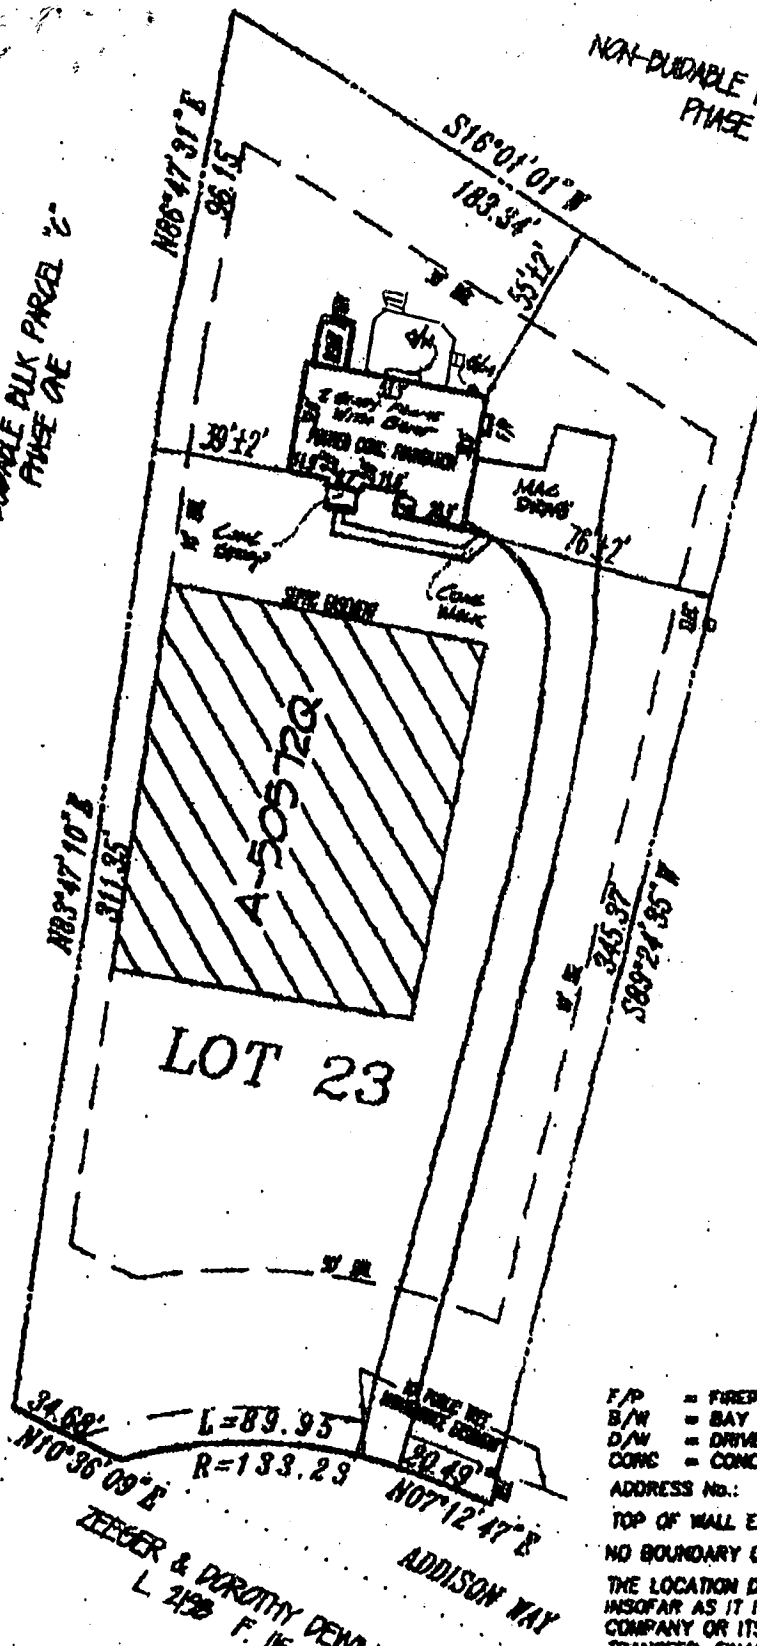

LEGEND

- F/P = FIREPLACE
- B/W = BAY WINDOW
- D/W = DRIVEWAY
- CONC = CONCRETE
- O/M = OVERHANG
- H/P = HEAT PUMP/AIR COND.
- G/M = GAS METER
- E/M = ELECTRIC METER

ADDRESS No.: 14782 ADDISON WAY
TOP OF WALL ELEV. = 632.8 FIRST FLOOR ELEV. =
NO BOUNDARY OR MONUMENTATION ESTABLISHED OR LOCATED.
THE LOCATION DRAWING IS OF BENEFIT TO THE CONSUMER ONLY
INsofar AS IT IS REQUIRED BY A LENDER OR A TITLE INSURANCE
COMPANY OR ITS AGENT IN CONNECTION WITH CONTEMPLATED
TRANSFER, FINANCING OR REFINANCING.
THE LOCATION DRAWING IS NOT TO BE RELIED UPON FOR THE ES-
TABLISHMENT OR LOCATION OF FENCES, GARAGES, BUILDINGS, OR
OTHER EXISTING OR FUTURE IMPROVEMENTS;
AND THE LOCATION DRAWING DOES NOT PROVIDE FOR THE
ACCURATE IDENTIFICATION OF PROPERTY BOUNDARY LINES, BUT
SUCH IDENTIFICATION MAY NOT BE REQUIRED FOR THE TRANSFER
OF TITLE OR SECURING FINANCING OR REFINANCING.
FLOOD INSURANCE RATE MAP (FIRM) FLOOD ZONE "C"
AREA OF MINIMAL FLOODING
PER COMMUNITY PANEL NUMBER 240041 0008 B
FOR TITLE PURPOSES ONLY - NO TITLE REPORT FURNISHED
SUBJECT TO ALL EASEMENTS AND RIGHTS OF WAY OF RECORD


LOT 23
CARRIAGE MILL FARMS
PHASE ONE

PLAT 12212
ELECTION DISTRICT No. 9
HOWARD COUNTY, MARYLAND

ADDISON WAY
ZESSER & PURDY DEVLDR
L 2128 F. 15

LOCATION DRAWING

FOUNDATION	DATE: 9/25/98
FINAL	DATE: 12/19/98
DRAWN BY: AWG	SCALE: 1"=50'
PROJECT No.: 95505.00	

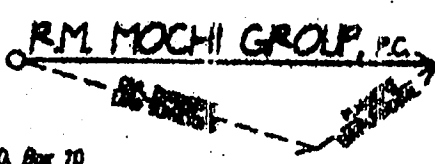

P.O. Box 70
New Market, MD 21774-0070
10120 A Old National Pike
Jamaica, MD 21754-9706
(301) 865-5858
Fax: (301) 865-5111

0200

SEQUENCE NO. (MDE USE ONLY)

STATE OF MARYLAND WELL COMPLETION REPORT

THIS REPORT MUST BE SUBMITTED WITHIN 45 DAYS AFTER WELL IS COMPLETED. COUNTY NUMBER A505720

ST/CO USE ONLY DATE RECEIVED

DATE WELL COMPLETED 032896

Depth of Well 300 (TO NEAREST FOOT)

PERMIT NO. FROM "PERMIT TO DRILL WELL" 110-93-0292

OWNER OAK HILL PROPERTIES last name first name TOWN COCKSVILLE SUBDIVISION CARRIAGE MILL SECTION LOT 23

WELL LOG table with columns: DESCRIPTION, FEET (FROM, TO), check if water bearing. Includes entries for Topsoil, Br. Shale, etc.

GROUTING RECORD. WELL HAS BEEN GROUTED (Y). TYPE OF GROUTING MATERIAL (CM). CEMENT BENTONITE CLAY (BC). NO. OF BAGS 22. NO. OF POUNDS 2200.

CASING RECORD. MAIN CASING TYPE (ST) STEEL. Nominal diameter 6 inch. Total depth of main casing 100 feet.

SCREEN RECORD. screen type or open hole (ST) STEEL. SLOT SIZE 1 2 3 DIAMETER OF SCREEN.

OTHER CASING (if used) diameter inch depth (feet).


WELL HYDROFRACTURED (Y). C 2. DEPTH (nearest ft.) 110 98 300.

GRAVEL PACK IF WELL DRILLED WAS FLOWING WELL INSERT. F IN BOX 68. MDE USE ONLY (NOT TO BE FILLED IN BY DRILLER).

TELESCOPE CASING LOG INDICATOR OTHER DATA.

PUMPING TEST. HOURS PUMPED (nearest hour) 3. PUMPING RATE (gal. per min.) 7.0. METHOD USED TO MEASURE PUMPING RATE Bucket. WATER LEVEL (distance from land surface) BEFORE PUMPING 31 ft. WHEN PUMPING 98 ft. TYPE OF PUMP USED (for test) S submersible.

PUMP INSTALLED. DRILLER WILL INSTALL PUMP (YES) NO. TYPE OF PUMP INSTALLED PLACE (A,C,J,P,R,S,T,O) IN BOX 29. CAPACITY: GALLONS PER MINUTE. PUMP HORSE POWER. PUMP COLUMN LENGTH (nearest ft.). CASING HEIGHT (circle appropriate box and enter casing height) + above. LAND SURFACE (nearest foot) 2.

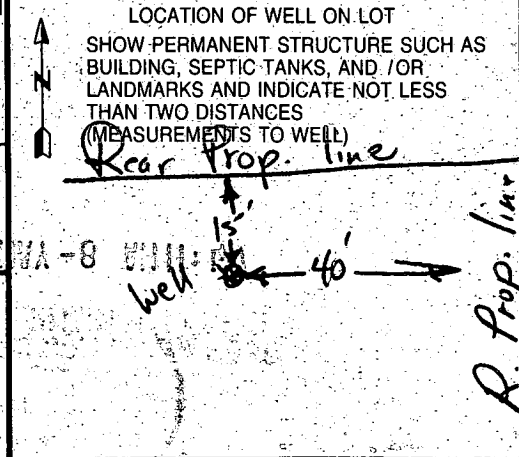

NUMBER OF UNSUCCESSFUL WELLS:

WELL HYDROFRACTURED (Y) (N)

CIRCLE APPROPRIATE LETTER. A A WELL WAS ABANDONED AND SEALED WHEN THIS WELL WAS COMPLETED. E ELECTRIC LOG OBTAINED. P TEST WELL CONVERTED TO PRODUCTION WELL.

I HEREBY CERTIFY THAT THIS WELL HAS BEEN CONSTRUCTED IN ACCORDANCE WITH COMAR 26.04.04 "WELL CONSTRUCTION" AND IN CONFORMANCE WITH ALL CONDITIONS STATED IN THE ABOVE CAPTIONED PERMIT AND THAT THE INFORMATION PRESENTED HEREIN IS ACCURATE AND COMPLETE TO THE BEST OF MY KNOWLEDGE.

TYPE MWD/MSD/MGD. DRILLERS LIC. NO. 40.

DRILLERS SIGNATURE (Gentry F. Eustead)

LIC. NO. 386.

SITE SUPERVISOR (sign. of driller or journeyman responsible for sitework if different from permittee).

1	3751	SEQUENCE NO. (MDE USE ONLY)	STATE OF MARYLAND PERMIT TO DRILL WELL please print or type	STATE PERMIT NUMBER				
(THIS NUMBER IS TO BE PUNCHED IN COLS. 3-6 ON ALL CARDS)				<table border="1" style="width:100%; border-collapse: collapse;"> <tr> <td style="width:25%; text-align: center;">40</td> <td style="width:25%; text-align: center;">93</td> <td style="width:25%; text-align: center;">02</td> <td style="width:25%; text-align: center;">92</td> </tr> </table> <small>fill in this form completely</small>	40	93	02	92
40	93	02	92					

OWNER INFORMATION

Date Received (APA) **02/16/96**

OAK HILL PROPERTIES
15 Last Name Owner First Name 34

22560 GLEN DRIVE S1114
36 Street or RFD 55

STERLING VA 20164
57 Town 70 State 72 Zip 76

LOCATION OF WELL

HOWARD
8 COUNTY 21

CARRIAGE MILL FARMS
23 SUBDIVISION 42

SECTION **44** LOT **23**
44 46 48 50

COOKSVILLE
52 NEAREST TOWN 71

MILES FROM TOWN (enter 0 if in town) **0** M I
73 76 77 78

DRILLER INFORMATION CIRCLE: MSD/MGD/MWD

George F. Easterday **40**
Driller's Name 77 License No. 80

L. Franklin Easterday, Inc.
Firm Name

9265 Brown Church Rd., MT. Airy, Md. 21771
Address

George F. Easterday 1-23-96
Signature Date

B 4

DIRECTION OF WELL FROM TOWN (CIRCLE BOX)

OLD FRED. RD
11 NEAR WHAT ROAD 30

ON WHICH SIDE OF ROAD (CIRCLE APPROPRIATE BOX):
 NORTH WEST EAST SOUTH

DISTANCE FROM ROAD **500**
34 37

ENTER FT OR MI **FT**
38 39

TAX MAP: _____ BLK: _____ PARCEL: _____

WELL INFORMATION

APPROX. PUMPING RATE (GAL. PER MIN.) **5**
8 12

AVERAGE DAILY QUANTITY NEEDED (GAL. PER DAY) **500**
14 20

USE FOR WATER (CIRCLE APPROPRIATE BOX)

HOME (SINGLE OR DOUBLE HOUSEHOLD UNIT ONLY)

FARMING (LIVESTOCK WATERING & AGRICULTURAL IRRIGATION)

INDUSTRIAL, COMMERCIAL, STATE AND FEDERAL GOV. OTHER (REQUIRES APPROPRIATION PERMIT)

PUBLIC OR PRIVATE WATER COMPANY (REQUIRES APPROPRIATION PERMIT AND STATE HEALTH DEPARTMENT APPROVAL)

TEST, OBSERVATION, MONITORING (MAY REQUIRE APPROPRIATION PERMIT)

NOT TO BE FILLED IN BY DRILLER HEALTH DEPARTMENT APPROVAL

HOWARD **A-505729**
COUNTY NAME COUNTY NO.

STATE SIGNATURE _____ DATE ISSUED _____ INSERT S _____
41

022996 *John Samp* **2/28/97**
43 48 CO SIGNATURE EXP. DATE

NORTH GRID **549000** EAST GRID **792000**
50 55 57 63

APPROXIMATE DEPTH OF WELL **300** FEET
24 28

APPROXIMATE DIAMETER OF WELL **6** INCH
NEAREST INCH

METHOD OF DRILLING (circle one)

BORED (or Augered) JETTED Jetted & DRIVEN

AIR-ROTARY AIR-PERcussion ROTARY (Hydraulic Rotary)

CABLE REVerse-ROTary DRive-POINT

other _____

REPLACEMENT OR DEEPEMED WELLS (CIRCLE APPROPRIATE BOX)

THIS WELL WILL NOT REPLACE AN EXISTING WELL

THIS WELL WILL REPLACE A WELL THAT WILL BE ABANDONED AND SEALED

THIS WELL WILL REPLACE A WELL THAT WILL BE USED AS A STANDBY -CONTACT LOCAL APPROVING AUTHORITY FOR POLICY ON STANDBY WELLS

THIS WELL WILL DEEPEEN AN EXISTING WELL

PERMIT NUMBER OF WELL TO BE REPLACED OR DEEPEMED (IF AVAILABLE) _____
41 52

SHOW MAJOR FEATURES OF BOX & LOCATE WELL WITH AN X

SOURCES OF DRILLING WATER

- Wells
-
-

WRITE THE BOX NUMBER FROM THE MAP HERE

7902
7902


5404
5404

DRAW A SKETCH BELOW SHOWING LOCATION OF WELL IN RELATION TO NEARBY TOWNS AND ROADS AND GIVE DISTANCE FROM WELL TO NEAREST ROAD JUNCTION

Not to be filled in by driller (MDE OR COUNTY USE ONLY)

APPROP. PERMIT NUMBER _____ GAP _____
54 63

FORCE **65** WRITE INITIALS IN BOX PERMIT No. **40-93-0292**
67 68 70 71 72 73 74 75 76 77 78 79

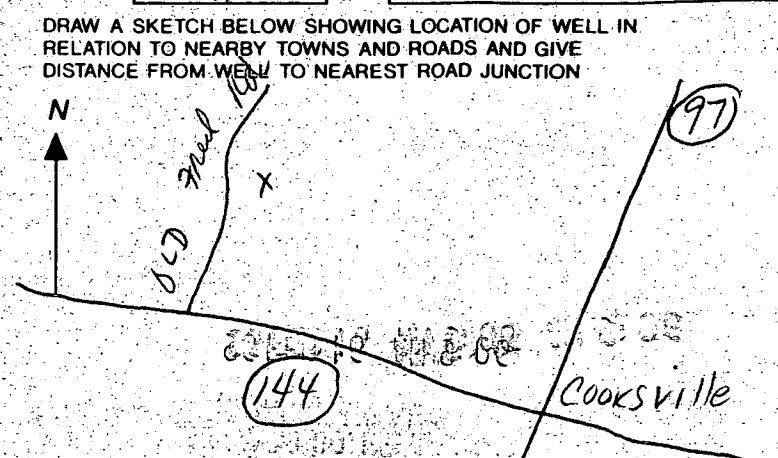

SPECIAL CONDITIONS
 NOTE - APPROVING AUTHORITIES SHOULD USE SEPARATE SHEET IF NEEDED -

COUNTY

JUSTIFIABLE LOT 8
 PLAT 2095
 Zoned RC-DEB

CURVE DATA
 STA. 7+05.35 TO STA. 8+89.30

Radius = 124.30'
 Length = 183.95'
 Tan = 113.48'
 Delta = 84°47'31"
 Chord = S40°23'27"E, 167.62'

CURVE DATA
 STA. 5+43.20 TO STA. 7+05.35

Radius = 103.23'
 Length = 162.15'
 Tan = 103.23'
 Delta = 90°00'00"
 Chord = N37°47'13"W, 145.99'

ZEEGER DENLDE &
 DOROTHY DENLDE
 LIBER 1198 FOLD 15
 Zoned RC-DEB

MATCH LINE
 See Sheet

5005-00\95005PS2

