



# APPLICATION

30, 31, 32, 33, 34

PERCOLATION TESTING

A 515/04-H

F \_\_\_\_\_

HOWARD COUNTY HEALTH DEPARTMENT  
BUREAU OF ENVIRONMENTAL HEALTH  
3525-H ELLICOTT MILLS DRIVE/ELLICOTT CITY, MARYLAND 21043  
TELEPHONE: 313-2640

DISTRICT 4TH

DATE 5/13/03

5/22/03

TO: THE COUNTY HEALTH OFFICER  
ELLICOTT CITY, MARYLAND

I HEREBY APPLY FOR THE NECESSARY TEST PRIOR TO APPLICATION FOR PERMIT TO CONSTRUCT (OR RECONSTRUCT) A SEWAGE DISPOSAL SYSTEM.

PROPERTY OWNER EDGEWOOD FARM, INC.

ADDRESS 14919 ROXBURY RD GLENELG MD 21737 PHONE \_\_\_\_\_

AGENT OR PROSPECTIVE BUYER TOLL BROTHERS, INC.

ADDRESS 7164 COLUMBIA GATEWAY DR SUITE 230  
COLUMBIA, MD 21046 PHONE (410) 872-9105

PROPERTY LOCATION:

SUBDIVISION EDGEWOOD FARM LOT NO. 910

ROAD AND DESCRIPTION ROXBURY RD

TAX MAP 21 PARCEL # 90

SIZE OF LOT 1 Ac ± TYPE BLDG. SINGLE FAMILY  
(SINGLE FAMILY DWELLING OR COMMERCIAL)

THE SYSTEM INSTALLED UNDER THIS APPLICATION IS ACCEPTABLE ONLY UNTIL PUBLIC FACILITIES BECOME AVAILABLE. I FULLY UNDERSTAND THE FEE CONNECTED WITH THE FILING OF THIS PERC TEST APPLICATION IS NON-REFUNDABLE UNDER ANY CIRCUMSTANCES. I ALSO AGREE TO COMPLY WITH ALL M.O.S.H.A. REQUIREMENTS IN TESTING THIS LOT.

Bruce R. Ouley  
BRUCE R. OULEY (SIGNATURE OF APPLICANT)

APPROVED BY \_\_\_\_\_ FOR \_\_\_\_\_ DATE \_\_\_\_\_

SAPPROVED BY \_\_\_\_\_ FOR \_\_\_\_\_ DATE \_\_\_\_\_

OULD PENDING FURTHER TESTS \_\_\_\_\_

ASONS FOR REJECTION OR HOLDING \_\_\_\_\_

PERCOLATION TEST PLAT/PRELIMINARY PLAT - TITLE OR I.D. # \_\_\_\_\_ DATE \_\_\_\_\_

DEVELOPMENT PLAN/FINAL PLAT - TITLE OR I.D. # \_\_\_\_\_ DATE \_\_\_\_\_

# THIS IS NOT A PERMIT

COUNTY #

SOIL PROFILE

0' **30**  
Brown loam  
1'  
Red Silty clay loam  
5'  
Red Silty loam  
25% rock  
13 1/2'

**32**


Strong brn CL Lm  
1 1/2'  
Wk Rd, Dense CL Lm Ribbons 2"  
5-5 1/2'

Sil Lm

6'  
Lm Sand  
Med grain size  
Bottom  
13 1/2'

**31**

1 1/2'  
Brown loam  
1 1/2'  
Yellow Brown Clay loam  
3'  
Red Silty loam  
5'  
Red Silty loam  
25% rock  
13'

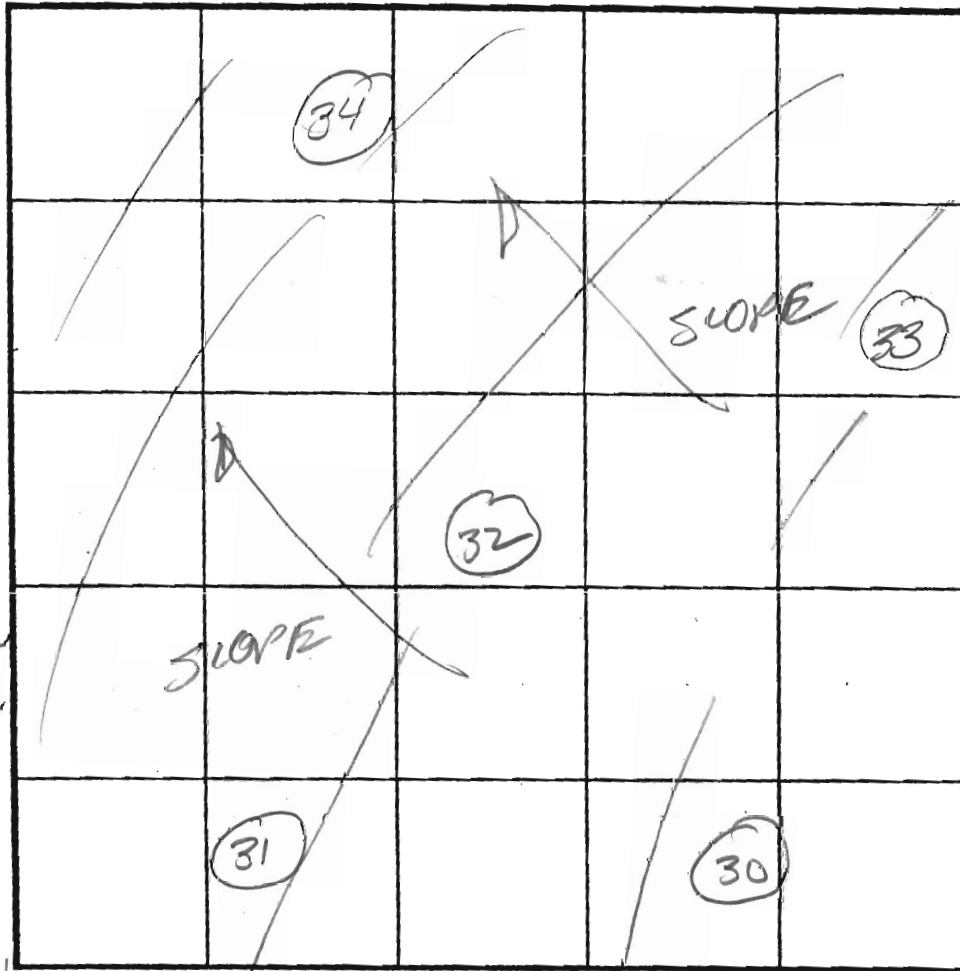

SOIL PROFILE

0' **33**  
Str brn CL Lm  
1 1/2'  
Str org brn hwy silty clay skins  
Trace Rx  
5'  
brn y brn Lm S med sized grains  
Trace Rx  
Bottom 14'

**34**

Brown loam  
8"  
Yellow clay loam  
1 1/2'  
Red Silty loam  
3"  
Yellow clay loam  
13'

INDICATE NORTH - NAME ADJOINING ROADWAY AS BASE LINE.

| DATE    | TEST NO. | DEPTH            | PRE-WET |       | TEST - 1" DROP |       | TIME    |
|---------|----------|------------------|---------|-------|----------------|-------|---------|
|         |          |                  | START   | STOP  | START          | STOP  |         |
| 7/11/67 | 30       | 7' / 13 1/2'     | 9:15    | 9:20  | 9:20           | 9:25  | 5 min P |
|         | 31       | 7' / 13'         | 9:22    | 9:34  | 9:34           | 9:41  | 7 min P |
|         | 32       | 6 1/2' / 13 1/2' | 9:38    | 9:43  | 9:43           | 9:48  | 5 min P |
|         | 33       | 6 1/2' / 14'     | 9:46    | 9:49  | 9:49           | 9:56  | 7 min P |
|         | 34       | 10' / 13 1/2'    | 10:13   | 10:12 | 10:12          | 10:22 | 5 min P |

REMARKS \_\_\_\_\_

TYPE OF SOIL \_\_\_\_\_

TESTED BY FA ALSO PRESENT Bob Shesley  
John Johnson

TRENCH DESIGN DATA: AVERAGE PERCOLATION TIME \_\_\_\_\_ TRENCH WIDTH \_\_\_\_\_

INLET DEPTH \_\_\_\_\_ MAXIMUM BOTTOM DEPTH \_\_\_\_\_ SQ. FT./BEDROOM \_\_\_\_\_

*Signed perc cert  
3/26/07 GIB2  
B*

PARCEL 28  
LEOW BUTLER & WIFE  
AND FRANCES B. DEVLIN  
5217412  
ZONED: RC-DEC

NON-BUILDABLE  
PRESERVATION PARCEL/A  
PRIVATELY OWNED  
HOWARD COUNTY EASEMENT HOLDER  
HOMEOWNERS ASSOCIATION EASEMENT HOLDER

AdB2  
C

