

HOWARD COUNTY
PERMIT APPLICATION

PERMIT NUMBER

B06007676

Building Address 3543 Countryside Dr.
Greenwood, MD 21738

Property Owner's Name Kevin P. & Kim S. Daly
Address 3543 Countryside Dr.

Suite/Apt. #: _____ SDP/WP/Petition #: _____

Census Tract _____ Subdivision Countryside

City Greenwood State MD Zip Code 21738

Section _____ Area 2 Lot 7

Home Phone 410-489-4783 Work Phone 301-674-1245

Tax Map 21 Parcel 48 Grid 3

Applicant's Name & Mailing Address, (if other than stated hereon):

Zoning _____ Map Coordinates _____ Lot size 3.26 ac

Phone _____ Fax 301-931-2294

Existing Use Primary Private Residence (SFH)

Contractor Company _____

Proposed Use same

Contact Person _____

Estimated Construction Cost \$ 25,000

Address _____

Description of Work Finish Basement

City _____ State _____ Zip Code _____

License No. _____

Phone _____ Fax _____

Occupant or Tenant _____

Engineer or Architect Company _____

Contact Name _____

Contact Person _____

Address _____

Address _____

City _____ State _____ Zip Code _____

City _____ State _____ Zip Code _____

Phone _____ Fax _____

Phone _____ Fax _____

BUILDING DESCRIPTION - COMMERCIAL

BUILDING DESCRIPTION - RESIDENTIAL

Building Characteristics

Utilities

Height: _____
No. of stories: _____
Gross area, sq. ft. per floor: _____
Use group: _____
Construction type:
 Reinforced Concrete
 Structural Steel
 Masonry
 Wood Frame
 State Certified Modular

Water Supply: _____
 Public
 Private
Sewage Disposal: _____
 Public
 Private
Electric Yes No
Gas Yes No
Heating System:
Electric Oil
Natural Gas
Propane Gas
Sprinkler system: N/A
 Full
 Partial
 Other Suppression
of Heads _____

Building Characteristics

Utilities

SF Dwelling SF Townhouse
Depth _____ Width _____
1st floor: _____
2nd floor: _____
Basement: _____
Finished Basement Unfinished Basement
Crawl space Slab on Grade
No. of Bedrooms 4
Height: _____
Multi-family dwellings:
No. of efficiency units: _____
No. of 1 BR units: _____
No. of 2 BR units: _____
No. of 3 BR units: _____
Other Structure: _____
Dimensions: _____
Footings: _____
Roof Height: _____
 State Certified Modular
 Manufactured Home

Water Supply: _____
 Public
 Private
Sewage Disposal: _____
 Public
 Private
Electric Yes No
Gas Yes No
Heating System:
Electric Oil
Natural Gas
Propane Gas
Sprinkler system: N/A
 NFPA #13D
 NFPA #13R
 Other:

THE UNDERSIGNED HEREBY CERTIFIES AND AGREES AS FOLLOWS: (1) THAT HE/SHE IS AUTHORIZED TO MAKE THIS APPLICATION; (2) THAT THE INFORMATION IS CORRECT; (3) THAT HE/SHE WILL COMPLY WITH ALL REGULATIONS OF HOWARD COUNTY WHICH ARE APPLICABLE THERETO; (4) THAT HE/SHE WILL PERFORM NO WORK ON THE ABOVE REFERENCED PROPERTY NOT SPECIFICALLY DESCRIBED IN THIS APPLICATION; (5) THAT HE/SHE GRANTS COUNTY OFFICIALS THE RIGHT TO ENTER ONTO THIS PROPERTY FOR THE PURPOSE OF INSPECTING THE WORK PERMITTED AND POSTING NOTICES.


[Signature]
Applicant's Signature
Owner
Title/Company

Kevin Daly
Print Name
11/16/06
Date

Checks payable to: **DIRECTOR OF FINANCE OF HOWARD COUNTY**
** PLEASE WRITE NEATLY AND LEGIBLY. **
- FOR OFFICE USE ONLY -


AGENCY	DATE	SIGNATURE APPROVAL	DPZ SETBACK INFORMATION	PROPERTY ID#
Land Development, DPZ			Front: _____	Filing fee \$: _____
State Highways			Rear: _____	Permit fee \$: _____
Building Official			Side: _____	Excise tax \$: _____
Dev. Engineering, DPZ	<u>11/16/06</u>	<u>[Signature]</u>	Side St.: _____	Add'l per. fee \$: _____
Health			All minimum setbacks met?	TOTAL FEES \$: _____
Fire Protection			YES <input type="checkbox"/> NO <input type="checkbox"/>	Sub-total paid \$: _____
Is Sediment Control approval required prior to issuance?			Is Entrance Permit required?	Balance due \$: _____
YES <input type="checkbox"/> NO <input type="checkbox"/>			YES <input type="checkbox"/> NO <input type="checkbox"/>	Check # _____
CONTINGENCY CONSTRUCTION START: <input type="checkbox"/>			Historic District?	Validation # _____
ONE STOP SHOP: <input type="checkbox"/>			YES <input type="checkbox"/> NO <input type="checkbox"/>	
Distribution of Copies -	White: Building Official	Green: LDD, DPZ	Lot Coverage for New Town Zone _____	Accepted by _____
T:\norma\PERMIT.FRM			SDP/Red-line approval date _____	
			Yellow: DEP, DPZ	Pink: Health
				Gold: SHA

S 47°25'44" E
220.00

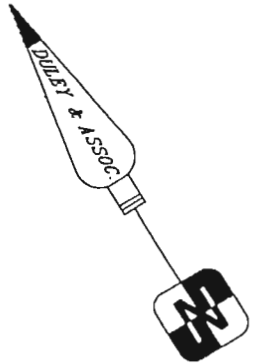

N 31°54'14" E
630.68

S 31°54'14" W
703.24

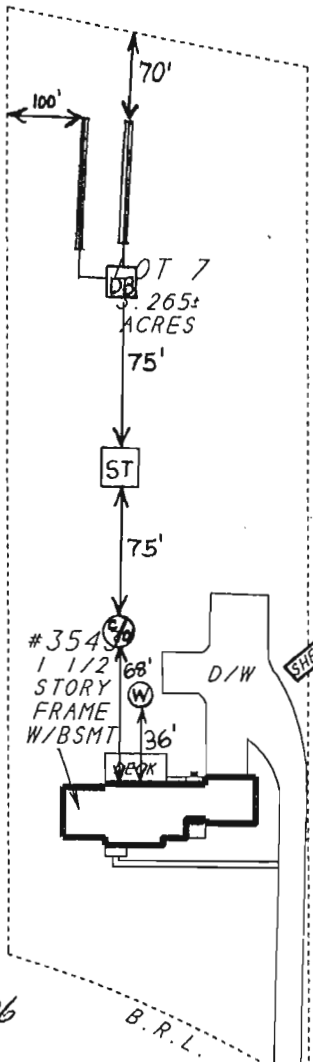

APPROVED

WALK-THRU BUILDING PERMIT

BP# B06007676 A# 28861

APP. SAN SFO DATE: 11/16/06

DESC. OF WORK: Finished

Basement

COUNTRYSIDE DRIVE
R : 625.00
L : 245.66

NOTE:
* ENCROACHMENTS MAY EXIST *
A BOUNDARY SURVEY IS RECOMMENDED
TO DETERMINE THE EXACT LOCATION
OF IMPROVEMENTS. PLEASE SIGN:

LOCATION DRAWING OF:
#3543 COUNTRYSIDE DRIVE

LOT 7
COUNTRYSIDE
PLAT BOOK NO. 4782
HOWARD COUNTY, MD

SCALE: 1"=100' DATE: 6-30-05

A LAND SURVEYING COMPANY



14604 ELM STREET
UPPER MARLBORO, MD. 20772

PHONE : 301-888-1111 FAX : 301-888-1114
PHONE : 1-888-88-DULEY FAX : 1-888-55-DULEY



CASE # 05D7950KR
ABIBA
FILE # 055073-174
DRAWN BY: ZB

SURVEYOR'S CERTIFICATE

I HEREBY STATE THAT THE EXISTING VISIBLE IMPROVEMENTS ON THE ABOVE DESCRIBED PROPERTY HAS BEEN CAREFULLY ESTABLISHED BY ACCEPTED METHODS AND THAT THE IMPROVEMENTS APPEAR TO LIE WITHIN FLOOD ZONE C. A FLOOD CERTIFICATION IS RECOMMENDED TO DETERMINE THE EXACT FLOOD ELEVATION AND FLOOD ZONE. THIS SURVEY IS NOT TO BE USED OR RELIED UPON FOR THE ESTABLISHMENT OF ANY FENCE, BUILDING, OR OTHER IMPROVEMENTS. THIS PLAT DOES NOT PROVIDE FOR THE ACCURATE IDENTIFICATION OF PROPERTY BOUNDARY LINES, BUT SUCH IDENTIFICATION MAY NOT BE REQUIRED FOR THE TRANSFER OF TITLE OR SECURING FINANCING OR REFINANCING. THIS PLAT IS OF BENEFIT TO A CONSUMER ONLY INsofar AS IT IS REQUIRED BY A LENDER OR A TITLE INSURANCE COMPANY OR ITS AGENT IN CONNECTION WITH THE CONTEMPLATED TRANSFER, FINANCING OR REFINANCING THE LEVEL OF ACCURACY FOR THIS DRAWING IS 1". NO TITLE REPORT WAS FURNISHED TO NOR DONE BY THIS COMPANY. SAID PROPERTY SUBJECT TO ALL NOTES, RESTRICTIONS AND EASEMENTS OF RECORD. BUILDING RESTRICTION LINES AND EASEMENTS MAY NOT BE SHOWN ON THIS SURVEY. IMPROVEMENTS WHICH IN THE SURVEYORS OPINION APPEAR TO BE IN A STATE OF DISREPAIR OR MAY BE CONSIDERED "TEMPORARY" MAY NOT BE SHOWN.

1/16 = 6.25 ft.

