

5/11/94
3:30 PM

PERMIT

SEWAGE DISPOSAL SYSTEM

DEPARTMENT OF HEALTH AND MENTAL HYGIENE

P 50049L

A REPAIR

DISTRICT 3RD

DATE 5/27/94

HOWARD COUNTY HEALTH DEPARTMENT

BUREAU OF ENVIRONMENTAL HEALTH

~~XXXXXXXX~~ 313-2640

03-281957

DATE SYSTEM APPROVED 5/11/94

INSPECTOR R. P. Kelly

INDEXED

Jack Fyock Septic Service IS PERMITTED TO INSTALL ALTER

ADDRESS _____ PHONE 988-9270

SUBDIVISION Everlea LOT 4, Blk. A ROAD 1542 Everlea Road

PROPERTY OWNER Challacombe

ADDRESS 1542 Everlea Road

ADDRESS Marriottsville, Maryland 21104

SEPTIC TANK CAPACITY ^{existing} 1000 GALLONS

NUMBER OF BEDROOMS 3

125 SQUARE FEET PER BEDROOM

LINEAR FEET OF TRENCH REQUIRED 60' (61' installed) <sup>125
x 3
375' min</sup> *nicelany soil below 2 ft*

REPAIR - PURPOSE - SEPTIC SYSTEM HAS FAILED

Call for inspection when ground is opened so sanitarian can recommend repair. 05/11/94

*Install one 60 ft long, 9 ft deep, 2 ft wide trench with in let at 2 ft, 7 ft gravel fill.
connected to existing Dry well*

PLANS APPROVED BY R. P. Kelly DATE 5/11/94

COVER NO WORK UNTIL INSPECTED AND APPROVED

NEITHER THE HOWARD COUNTY COUNCIL NOR THE HEALTH DEPARTMENT IS RESPONSIBLE FOR THE SUCCESSFUL OPERATION OF ANY SYSTEM

NOTE: CLEANOUT REQUIRED EVERY 70 FEET OF SEWER LINE AND/OR AT 90° SWEEPS IN LINES FROM HOUSE TO DRAIN FIELDS, 90° ELBOWS NOT ACCEPTABLE.

NOTE: ALL PARTS OF SEPTIC SYSTEMS (I.E. TANK, DISTRIBUTION BOX, TRENCHES) TO BE 100 FEET FROM WELL (UNLESS OTHERWISE SPECIFICALLY AUTHORIZED)

NOTE: IF DEEP TRENCH(ES) ARE USED CALL FOR INSPECTION BEFORE AND AFTER PLACING GRAVEL IN TRENCH(ES)

NOTE: NO DRY WELL SHALL EXCEED 15 FOOT IN DIAMETER NO ABSORPTION TRENCH TO EXCEED 100 FEET IN LENGTH

NOTE: ALL PIPE FROM HOUSE TO SEPTIC TANK MUST BE CAST IRON OR SCHEDULE 35/40 PVC OR ABS


PERMIT VOID AFTER TWO YEARS

NOTE: INSTALL STAND PIPE ON SEPTIC TANK AND DRY WELL STAND PIPES MUST BE 6 INCHES IN DIAMETER CAST IRON, CONCRETE OR TERRA COTTA OR PVA OR ABS ACCEPTED. IF TOP OF SEPTIC TANK IS DEEPER THAN 3 FEET. MANHOLE TO GRADE REQUIRED.

NOTE: DISTRIBUTION BOXES MUST HAVE BAFFLES

***INSTALLER IS RESPONSIBLE FOR OBTAINING FINAL APPROVAL ON THIS PERMIT**

P 50049L

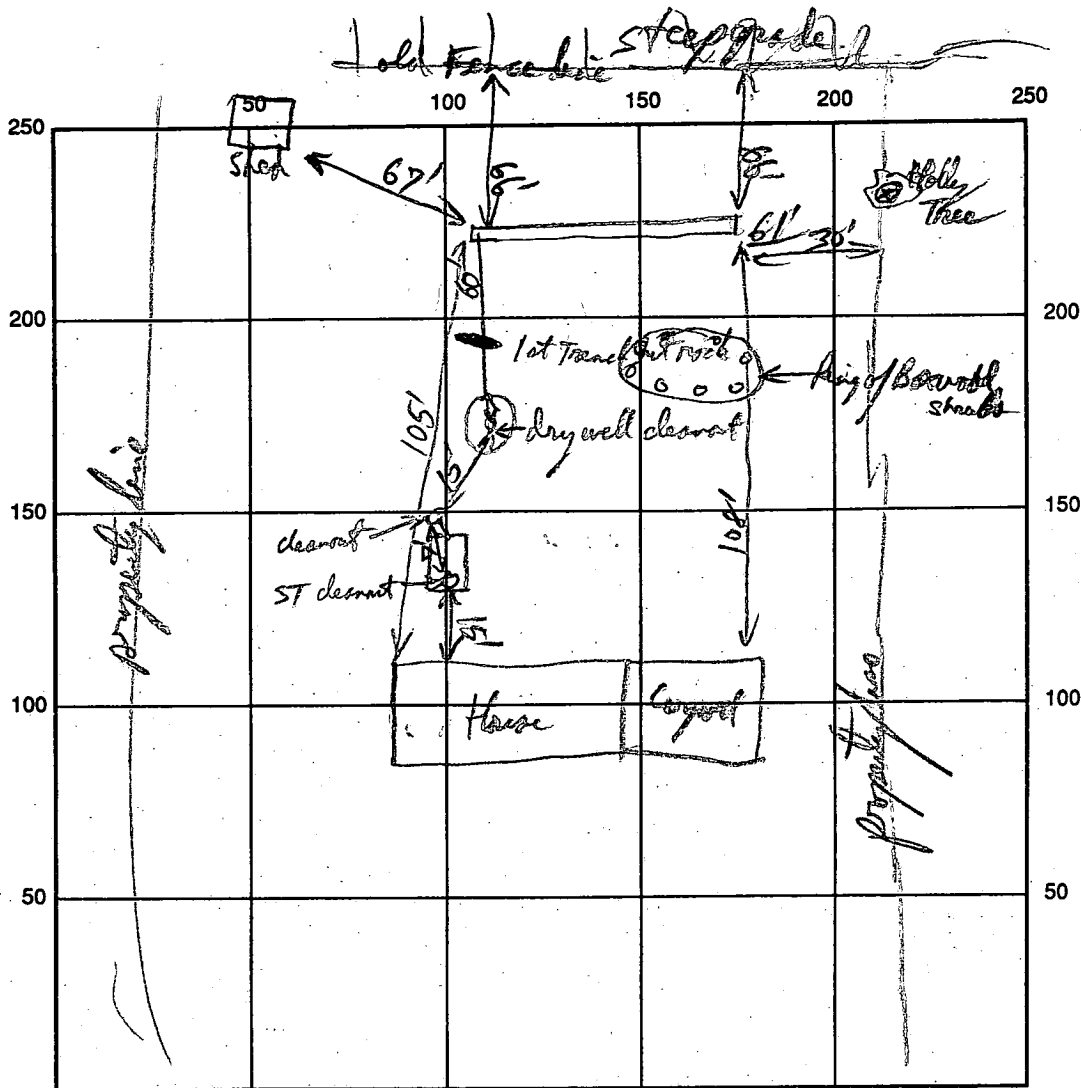

INDICATE NORTH - NAME ADJOINING ROADWAY AS BASE LINE

SEPTIC TANK LEVEL existing 1000gal? CLEANOUTS exist ST & Dry well
 DISTRIBUTION BOX LEVEL NA off existing dry well
 DRAIN FIELD/TITLE DEPTH 9 FT. TRENCH WIDTH 2 FT. INLET DEPTH 2 FT.
 EFFECTIVE GRAVEL DEPTH 7 FT. TOTAL LENGTH 61' FT.
 NUMBER OF TRENCHES 1 ONE SIDEWALL/BOTTOM AREA 427 SQ. FT.
 DRYWALL INSIDE DIAMETER Existing Failed FT. EFFECTIVE DEPTH BELOW INLET _____ FT.
 ABSORBENT AREA _____ SQ. FT.

REMARKS: OK to finish gravel Filing Trench Then Cover. RPP 5/11/94
old drywell seepage of surface via cleanout (lid of dry well 3' below grade)

DATE SYSTEM APPROVED 5/11/94 INSPECTOR [Signature]

5/13/74

PERMIT

Final
5/15/74
R.T.

P 19878
A 15782

SEWAGE DISPOSAL SYSTEM

MARYLAND STATE DEPARTMENT OF HEALTH

HOWARD COUNTY

ELLICOTT CITY

INDEXED
file

DISTRICT 3

DATE 4/30/74

Thomas Harris IS PERMITTED TO INSTALL ALTER

ADDRESS Box 6 - Monkton Road, Monkton, Maryland PHONE 472-4613

A SEWAGE DISPOSAL SYSTEM LOCATED AT

SUBDIVISION Everlea ROAD 1542 Everlea Rd. LOT 4, Blk. A, Sec. 2

PROPERTY OWNER Frank Barresi (Bldr.)

ADDRESS

SPECIFICATIONS - 3 bedrooms

DRAIN FIELD DEPTH FEET, BOTTOM AREA SQ. FT.

SEEPAGE PITS ABSORBENT SIDE-WALL AREA SQ. FT.

SEPTIC TANK CAPACITY 1,000 GALLONS

FOR GARBAGE GRINDER, INCREASE DISPOSAL AREA 22% & TANK CAPACITY 50%.

OTHER Dry well - 300 sq. ft. absorbent sidewall area below inlet pipe. Inlet pipe

to begin at 4 1/2 ft. below original grade and maximum depth of dry well 10 ft below original grade. Location 138 ft. from property line adjoining road A and 70 ft. from left property line as seen from front property line on Road A (Everlea Rd.)

NOTE: ALL PIPE FROM HOUSE TO DRY WELL MUST BE CAST IRON.

PERMIT VOID AFTER THREE YEARS.


PLANS APPROVED BY D. W. Monaghan/Streaker DATE 8/12/71

NOTE: INSTALL STAND PIPE ON SEPTIC TANK AND DRY WELL.

FILL SEPTIC TANK AND DISTRIBUTION BOX WITH WATER BEFORE CALLING FOR AN INSPECTION. COVER NO WORK UNTIL INSPECTED AND APPROVED.

NEITHER THE HOWARD COUNTY COMMISSIONERS NOR THE HEALTH DEPARTMENT IS RESPONSIBLE FOR THE SUCCESSFUL OPERATION OF ANY SYSTEM.

A 15782

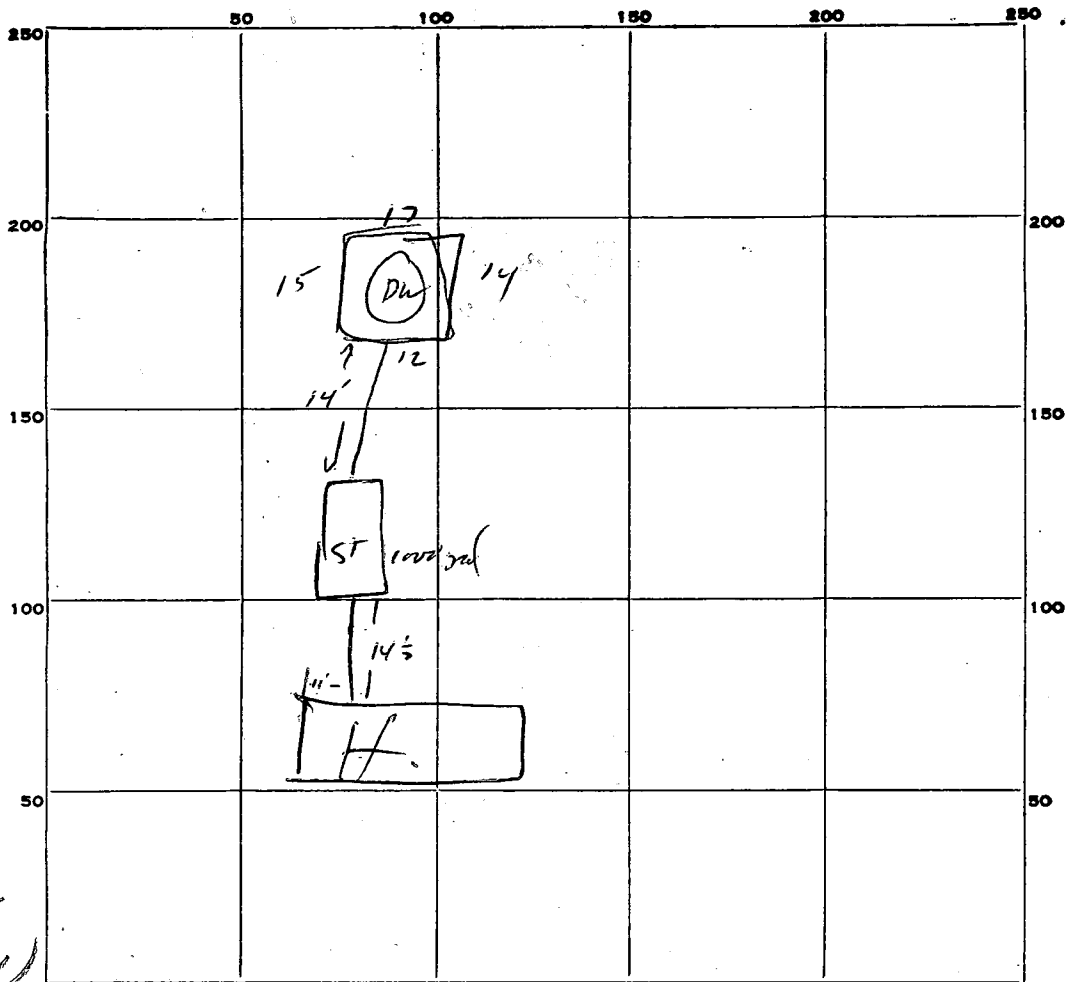

INDICATE NORTH. - NAME ADJOINING ROADWAY AS BASE LINE.

TO Kenyon Rd.

Everlea Rd

PERMIT CARD

no card

SEPTIC TANK, LEVEL

CLEANOUTS

DISTRIBUTION BOX, LEVEL

TILE FIELD, DEPTH _____ FT. TRENCH WIDTH _____ FT.

GRAVEL DEPTH _____ IN. TOTAL LENGTH _____ FT.

NUMBER OF TRENCHES _____ TOTAL BOTTOM AREA _____

SEEPAGE PITS, INSIDE DIAMETER 58 FT. DEPTH BELOW INLET 7 1/2 FT. *Un Known*

ABSORBENT AREA 435 SQ. FT.

REMARKS

5/13/74 inlet @ 4' below grade

- screw-on plug, unable to open RM

DATE SYSTEM APPROVED

5/14/74

INSPECTOR

R. M. [Signature]
R. Tom

APPLICATION

A 15782

SEWAGE DISPOSAL TESTING

P _____

MARYLAND STATE DEPARTMENT OF HEALTH

HOWARD COUNTY Septic Tank 1000 gallons ELLICOTT CITY

Dry well 300 sq. ft. absorbant well area below DISTRICT 3

inlet pipe. Inlet pipe to begin at 4 1/2' below original grade, and maximum depth of dry well 10 ft below original grade. Location 138 ft from property line and adjoining road P and 70 ft from left property line as seen from front property line on Road P. DATE 3/19/71

TO: THE COUNTY HEALTH OFFICER
ELLICOTT CITY, MARYLAND

I, HEREBY, APPLY FOR THE NECESSARY TESTS IN ORDER TO CONSTRUCT (OR RECONSTRUCT) A SEWAGE DISPOSAL SYSTEM.

PROPERTY OWNER Everett Ramsburg

ADDRESS 1450 Henryton Road, Marriottsville, Md. PHONE 286-2696

PROPERTY LOCATION:

SUBDIVISION Everlea LOT NO. 4, Blk. A, Sec. 2

ROAD AND DESCRIPTION Road "A"

OCCUPANT _____ PHONE _____

PERSON TO CONSTRUCT SYSTEM _____

ADDRESS _____ PHONE _____

SIZE OF LOT 40,000 sq. ft. TYPE BLDG. 3
NUMBER OF BEDROOMS

IF NOT SINGLE RESIDENCE DESCRIBE _____

SIGNATURE OF APPLICANT /s/ Everett Ramsburg


APPROVED BY H. W. Mosbaugh FOR dry well DATE 3/12/71
(KIND OF SYSTEM)

REJECTED BY _____ FOR _____ DATE _____
(KIND OF SYSTEM)

HOLD PENDING FURTHER TESTS _____ DATE _____

REASONS FOR REJECTION OR HOLDING _____

THIS IS NOT A PERMIT

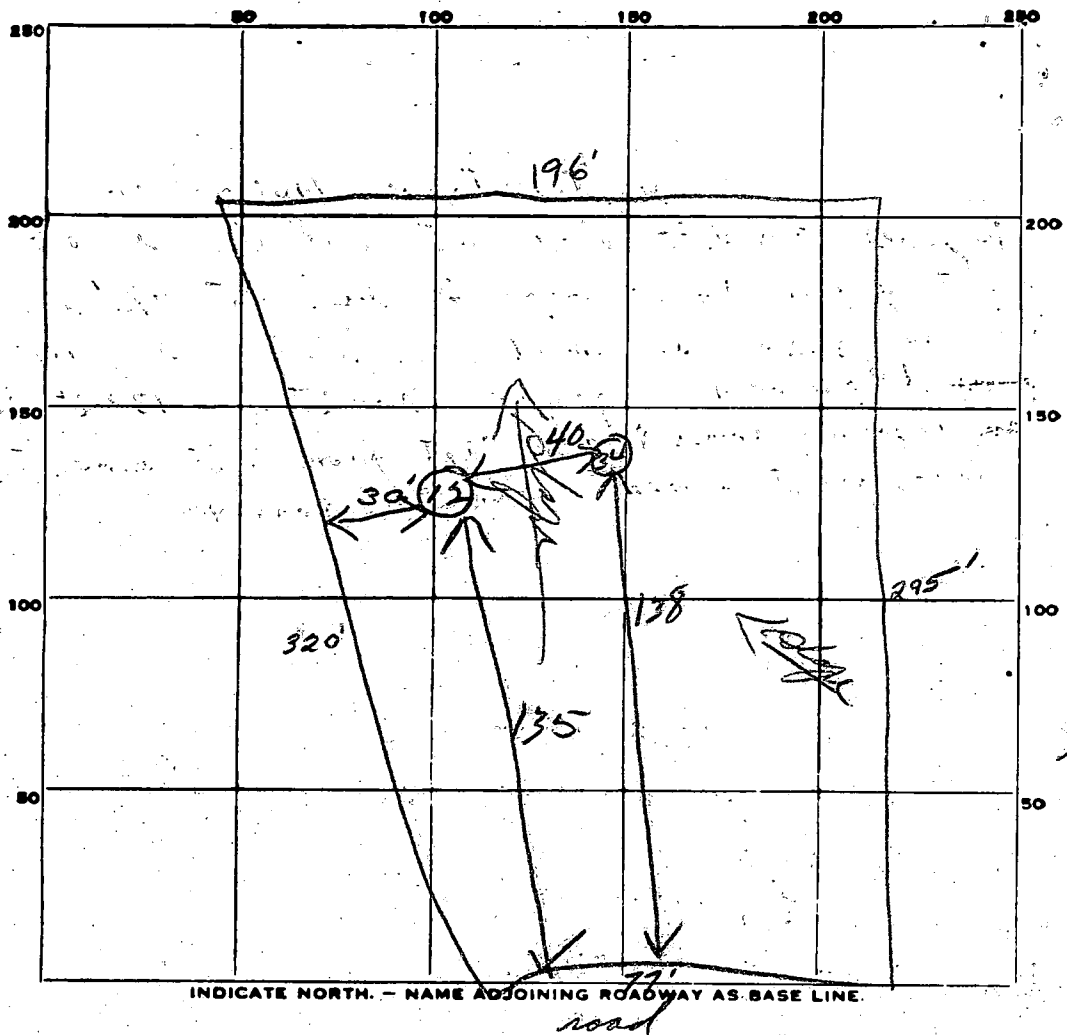

BT 4A

DATE	TEST NO.	DEPTH	PRE-WET		TEST - 1" DROP		TIME
			START	STOP	START	STOP	
3/24/71	1	12'	9:58	10:00	10:00	10:05	5 min
	2	5'	9:49	10:06	10:06	10:17	11 min
	3	10'	10:08	10:10	10:10	10:14	4 min
	4	6'	10:08	10:10	10:10	10:13	3 min

SOIL AUGER FINDING _____
 TESTED BY *[Signature]* _____
 REMARKS _____

APPLICATION

A 15782

SEWAGE DISPOSAL TESTING

P _____

MARYLAND STATE DEPARTMENT OF HEALTH

HOWARD COUNTY Septic Tank 1000 gallons ELLICOTT CITY

Dry well 300 sq. ft. absorbent wall area below DISTRICT 3

inlet pipes. Inlet pipe to begin at 4 1/2' below DATE 3/19/71

original grade and maximum depth of dry well 10 ft

below original grade. Location 13 1/2 ft from property line

adjoining road B and 20 ft from left property line as seen

from front property line to road B.

TO: THE COUNTY HEALTH OFFICER
ELLICOTT CITY, MARYLAND

I, HEREBY, APPLY FOR THE NECESSARY TESTS IN ORDER TO CONSTRUCT (OR RECONSTRUCT) A SEWAGE DISPOSAL SYSTEM.

PROPERTY OWNER Everett Ramsburg

ADDRESS 1450 Henryton Road, Marriottsville, Md. PHONE 286-2696

PROPERTY LOCATION:

SUBDIVISION Everlea LOT NO. 4, Blk. A, Sec. 2

ROAD AND DESCRIPTION Road "A"

OCCUPANT _____ PHONE _____

PERSON TO CONSTRUCT SYSTEM _____

ADDRESS _____ PHONE _____

SIZE OF LOT 40,000 sq. ft. TYPE BLDG. 3

NUMBER OF BEDROOMS

IF NOT SINGLE RESIDENCE DESCRIBE _____

SIGNATURE OF APPLICANT /s/ Everett Ramsburg


APPROVED BY _____ FOR _____ DATE _____
(KIND OF SYSTEM)

REJECTED BY _____ FOR _____ DATE _____
(KIND OF SYSTEM)

HOLD PENDING FURTHER TESTS _____ DATE _____

REASONS FOR REJECTION OR HOLDING _____

THIS IS NOT A PERMIT

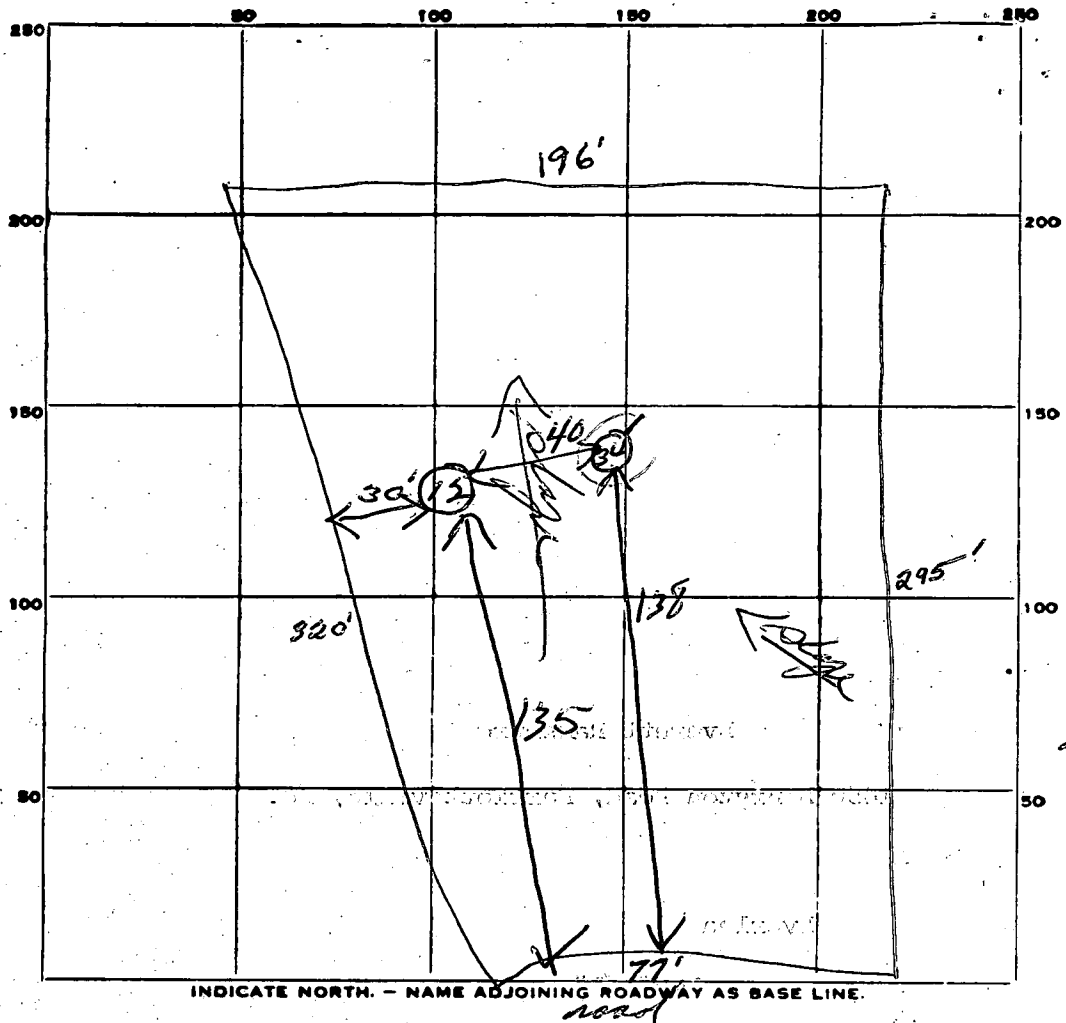

DATE	TEST NO.	DEPTH	PRE-WET		TEST - 1" DROP		TIME
			START	STOP	START	STOP	
3/27/71	1	12'	958	1002	1000	1005	5 min
	2	5'	949	1006	1006	1017	11 min
	3	10'	1008	1010	1010	1014	4 min
	4	6'	1008	1010	1010	1013	3 min


0.8
7 min

SOIL AUGER FINDING _____

TESTED BY _____

REMARKS _____

inlet 4 1/2 ft. use hole 3 & 4

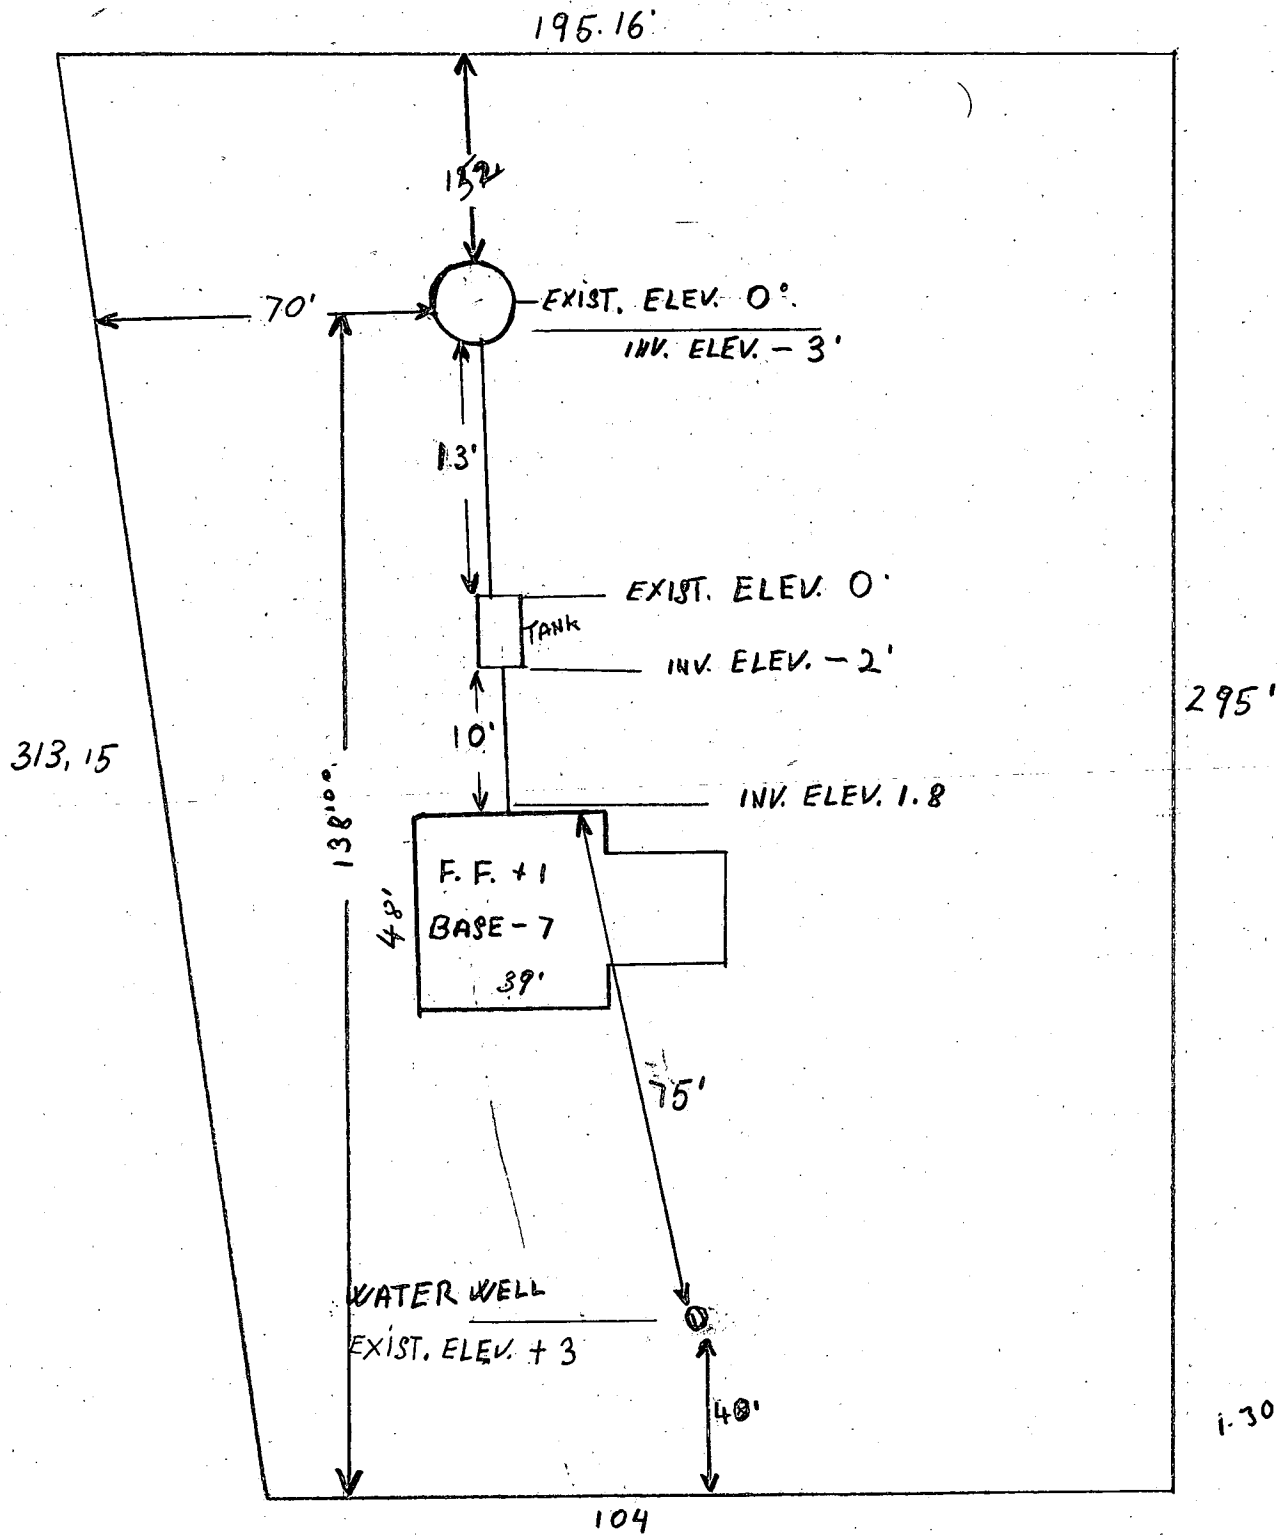

1-30-73
 OK
 JW

LOT NO 4. BLK. A, SEC. 2 EVERLEA RD

744 7479 - 744 7492

I CERTIFY THE ABOVE MEASUREMENTS
 AND ELEVATION DIFFERENCES ARE ACTUAL
 AND CORRECT FOR THIS PROPERTY

Frank Corresi

5/13/79

- 1.) no permit card
- 2.) cleanout plug in P.W. unable to be opened; must open for inspection
- 3.) can cover all work except dry well

R.M.

C 1 **3281** SEQUENCE NO. (WRA USE ONLY)

1 2 3 (SEQ. NO.) 6
 (THIS NUMBER IS TO BE PUNCHED IN COLUMNS 3-6 ON ALL CARDS)

STATE OF MARYLAND
WATER RESOURCES ADMINISTRATION
 TAWES STATE OFFICE BLDG., ANNAPOLIS, MD. 21401
WELL COMPLETION REPORT

THIS REPORT MUST BE SUBMITTED WITHIN 30 DAYS AFTER WELL COMPLETION

FILL IN THIS FORM COMPLETELY

COUNTY NUMBER

DATE RECEIVED (WRA USE ONLY)

DATE WELL COMPLETED 12/19/77

DEPTH OF WELL 100 (TO NEAREST FOOT)

PERMIT NO. FROM "PERMIT TO DRILL WELL" HAO-73-0678

DRILLERS IDENTIFICATION NO. 238

OWNER Challacombe LAST NAME Jack FIRST NAME

STREET OR RFD 141 Sprednick Ave POST OFFICE Catonville, Md.

WELL LOG

STATE THE KIND OF FORMATIONS PENETRATED, THEIR COLOR, DEPTH, THICKNESS AND IF WATER BEARING

DESCRIPTION (USE ADDITIONAL SHEETS IF NECESSARY)	FEET		CHECK IF WATER BEARING
	FROM	TO	
<u>Sand</u>	<u>0</u>	<u>28</u>	
<u>Wacka Rock</u>	<u>28</u>	<u>100</u>	

GROUTING RECORD

WELL HAS BEEN GROUTED (CIRCLE APPROPRIATE BOX) YES NO

TYPE OF GROUTING MATERIAL (CIRCLE BOX)

CEMENT BENTONITE CLAY

NO. OF BAGS 9 NO. OF POUNDS 846

GALLONS OF WATER 54

DEPTH OF GROUT SEAL (TO NEAREST FOOT)

FROM 0 FT. TO 25 FT.

CASING RECORD

INSERT APPROPRIATE CODE BELOW

STEEL CONCRETE

PLASTIC OTHER

MAIN CASING TYPE ST NOMINAL DIAMETER TOP MAIN CASING (NEAREST INCH) 6 TOTAL DEPTH OF MAIN CASING (NEAREST FOOT) 30

OTHER CASING (IF USED)

DIAMETER (INCH) DEPTH (FEET) FROM TO

SCREEN RECORD

INSERT APPROPRIATE CODE BELOW

STEEL BRASS OR BRONZE OPEN HOLE

PLASTIC OTHER

C 2 (SEQ. NO.) 6

DEPTH (NEAREST WHOLE FOOT)

FROM TO

1 100 FROM 28 TO 100

2

3

SLOT SIZE 1, 2, 3

DIAMETER OF SCREEN 56 (NEAREST INCH) FROM TO

GRAVEL PACK

IF WELL DRILLED WAS A FLOWING WELL CIRCLE BOX 68 F

WRA USE ONLY (NOT TO BE FILLED IN BY DRILLER)

T (E.R.O.S.) W Q

70 72 74 75 76 OTHER DATA AVAILABLE

C 3 (SEQ. NO.) 6

PUMPING TEST

HOURS PUMPED (TO NEAREST HOUR) 2

PUMPING RATE (GALLONS PER MINUTE TO NEAREST GALLON) 10

METHOD USED TO MEASURE PUMPING RATE Water

WATER LEVEL: (DISTANCE FROM LAND SURFACE)

BEFORE PUMPING 35 (NEAREST FOOT)

WHEN PUMPING 10 (NEAREST FOOT)

TYPE OF PUMP USED (CIRCLE APPROPRIATE BOX) (FOR PUMPING TEST)

A AIR P PISTON T TURBINE

C CENTRIFUGAL R ROTARY O OTHER (DESCRIBE BELOW)

J JET S SUBMERSIBLE

Water

PUMP INSTALLED

TYPE OF PUMP (WRITE APPROPRIATE LETTER IN BOX - SEE ABOVE: A, C, J, P, R, S, T, O)

DRILLER WILL INSTALL PUMP (CIRCLE APPROPRIATE BOX) YES NO

CAPACITY:

GALLONS PER MINUTE (TO NEAREST GALLON) 31 35

PUMP HORSE POWER 37 41

PUMP COLUMN LENGTH (NEAREST FOOT) 43 47

CASING HEIGHT (CIRCLE APPROPRIATE BOX AND ENTER CASING HEIGHT)

ABOVE BELOW

LAND SURFACE (NEAREST FOOT) 2

LOCATION OF WELL ON LOT

SHOW PERMANENT STRUCTURE SUCH AS BUILDINGS, SEPTIC TANKS, AND/OR OTHER LAND MARKS AND INDICATE NOT LESS THAN TWO DISTANCES (MEASUREMENTS TO WELL)

301

11/20/77

30

CIRCLE APPROPRIATE BOXES

A A WELL WAS ABANDONED AND SEALED WHEN THIS WELL WAS COMPLETED

E ELECTRIC LOG OBTAINED

P TEST WELL CONVERTED TO PRODUCTION WELL

I HEREBY CERTIFY THAT I HAVE COMPLIED WITH ALL CONDITIONS STATED ON THE ABOVE-CAPTIONED "PERMIT TO DRILL WELL", AND THAT INFORMATION CONTAINED IN THIS REPORT IS TRUE, ACCURATE, AND COMPLETE TO THE BEST OF MY KNOWLEDGE, INFORMATION AND BELIEF.

DRILLERS NAME Joseph Mayne

(PLEASE PRINT) Joseph Mayne

SIGNATURE Joseph Mayne