

8/23/94 Needs house connection ok 9/6/94 P.M.

2/7/94 9/6/94 JMG  
1038  
823-94 gm  
ASAP

# PERMIT

## SEWAGE DISPOSAL SYSTEM

### DEPARTMENT OF HEALTH AND MENTAL HYGIENE

P 50123

A REPAIR

DISTRICT \_\_\_\_\_

DATE 07/01/94

DATE SYSTEM APPROVED 9/5/94

INSPECTOR cd

# 343530

INDEXED

HOWARD COUNTY HEALTH DEPARTMENT  
BUREAU OF ENVIRONMENTAL HEALTH  
XXXXXXXX 313-2640

Herman SINK?  
SUP APPROVED IS PERMITTED TO INSTALL \_\_\_\_\_ ALTER

ADDRESS \_\_\_\_\_ PHONE \_\_\_\_\_

SUBDIVISION Florence Estates LOT 14 ROAD 2113 Florence Road

PROPERTY OWNER James Richards PHONE: H-831-5998/W-313-3200

ADDRESS 2113 Florence Road  
Mt. Airy, Maryland 21771

SEPTIC TANK CAPACITY 1000 GALLONS

*Pump Chamber 1000 gal  
Single Pump System.*

NUMBER OF BEDROOMS 3

BLDG. PERMIT SIGNED  
AND RETURNED 8/7/94  
*Serial # Bm 101989  
Shel-Puch-Trail-Eden's*

210 SQUARE FEET PER BEDROOM

LINEAR FEET OF TRENCH REQUIRED 210

REPAIR - PURPOSE - SEPTIC SYSTEM HAS FAILED. (Building Permit No. 54999 for addition - family room, library)

Call for inspection when ground is opened so sanitarian can recommend repair - 07/01/94

*Shallow system only - Max bottom depth 4 ft. Inlet at 2 1/2 ft, 3 ft wide trenches*

*Install two trenches 105 ft long each, install on ground*

*Dist Box at 170' off front lot line and 167' off right side line (Back)*

PLANS APPROVED BY RJ Pauley DATE 7/9/94

COVER NO WORK UNTIL INSPECTED AND APPROVED

NEITHER THE HOWARD COUNTY COUNCIL NOR THE HEALTH DEPARTMENT IS RESPONSIBLE FOR THE SUCCESSFUL OPERATION OF ANY SYSTEM

NOTE: CLEANOUT REQUIRED EVERY 70 FEET OF SEWER LINE AND/OR AT 90° SWEEPS IN LINES FROM HOUSE TO DRAIN FIELDS, 90° ELBOWS NOT ACCEPTABLE.

NOTE: ALL PARTS OF SEPTIC SYSTEMS (I.E. TANK, DISTRIBUTION BOX TRENCHES) TO BE 100 FEET FROM WELL (UNLESS OTHERWISE SPECIFICALLY AUTHORIZED)

NOTE: IF DEEP TRENCH(ES) ARE USED CALL FOR INSPECTION BEFORE AND AFTER PLACING GRAVEL IN TRENCH(ES)

NOTE: NO DRY WELL SHALL EXCEED 15 FOOT IN DIAMETER NO ABSORPTION TRENCH TO EXCEED 100 FEET IN LENGTH

NOTE: ALL PIPE FROM HOUSE TO SEPTIC TANK MUST BE CAST IRON OR SCHEDULE 35/40 PVC OR ABS

PERMIT VOID AFTER TWO YEARS


NOTE: INSTALL STAND PIPE ON SEPTIC TANK AND DRY WELL STAND PIPES MUST BE 6 INCHES IN DIAMETER CAST IRON. CONCRETE OR TERRA COTTA OR PVA OR ABS ACCEPTED. IF TOP OF SEPTIC TANK IS DEEPER THAN 3 FEET. MANHOLE TO GRADE REQUIRED.

NOTE: DISTRIBUTION BOXES MUST HAVE BAFFLES

**\*INSTALLER IS RESPONSIBLE FOR OBTAINING FINAL APPROVAL ON THIS PERMIT**

50123



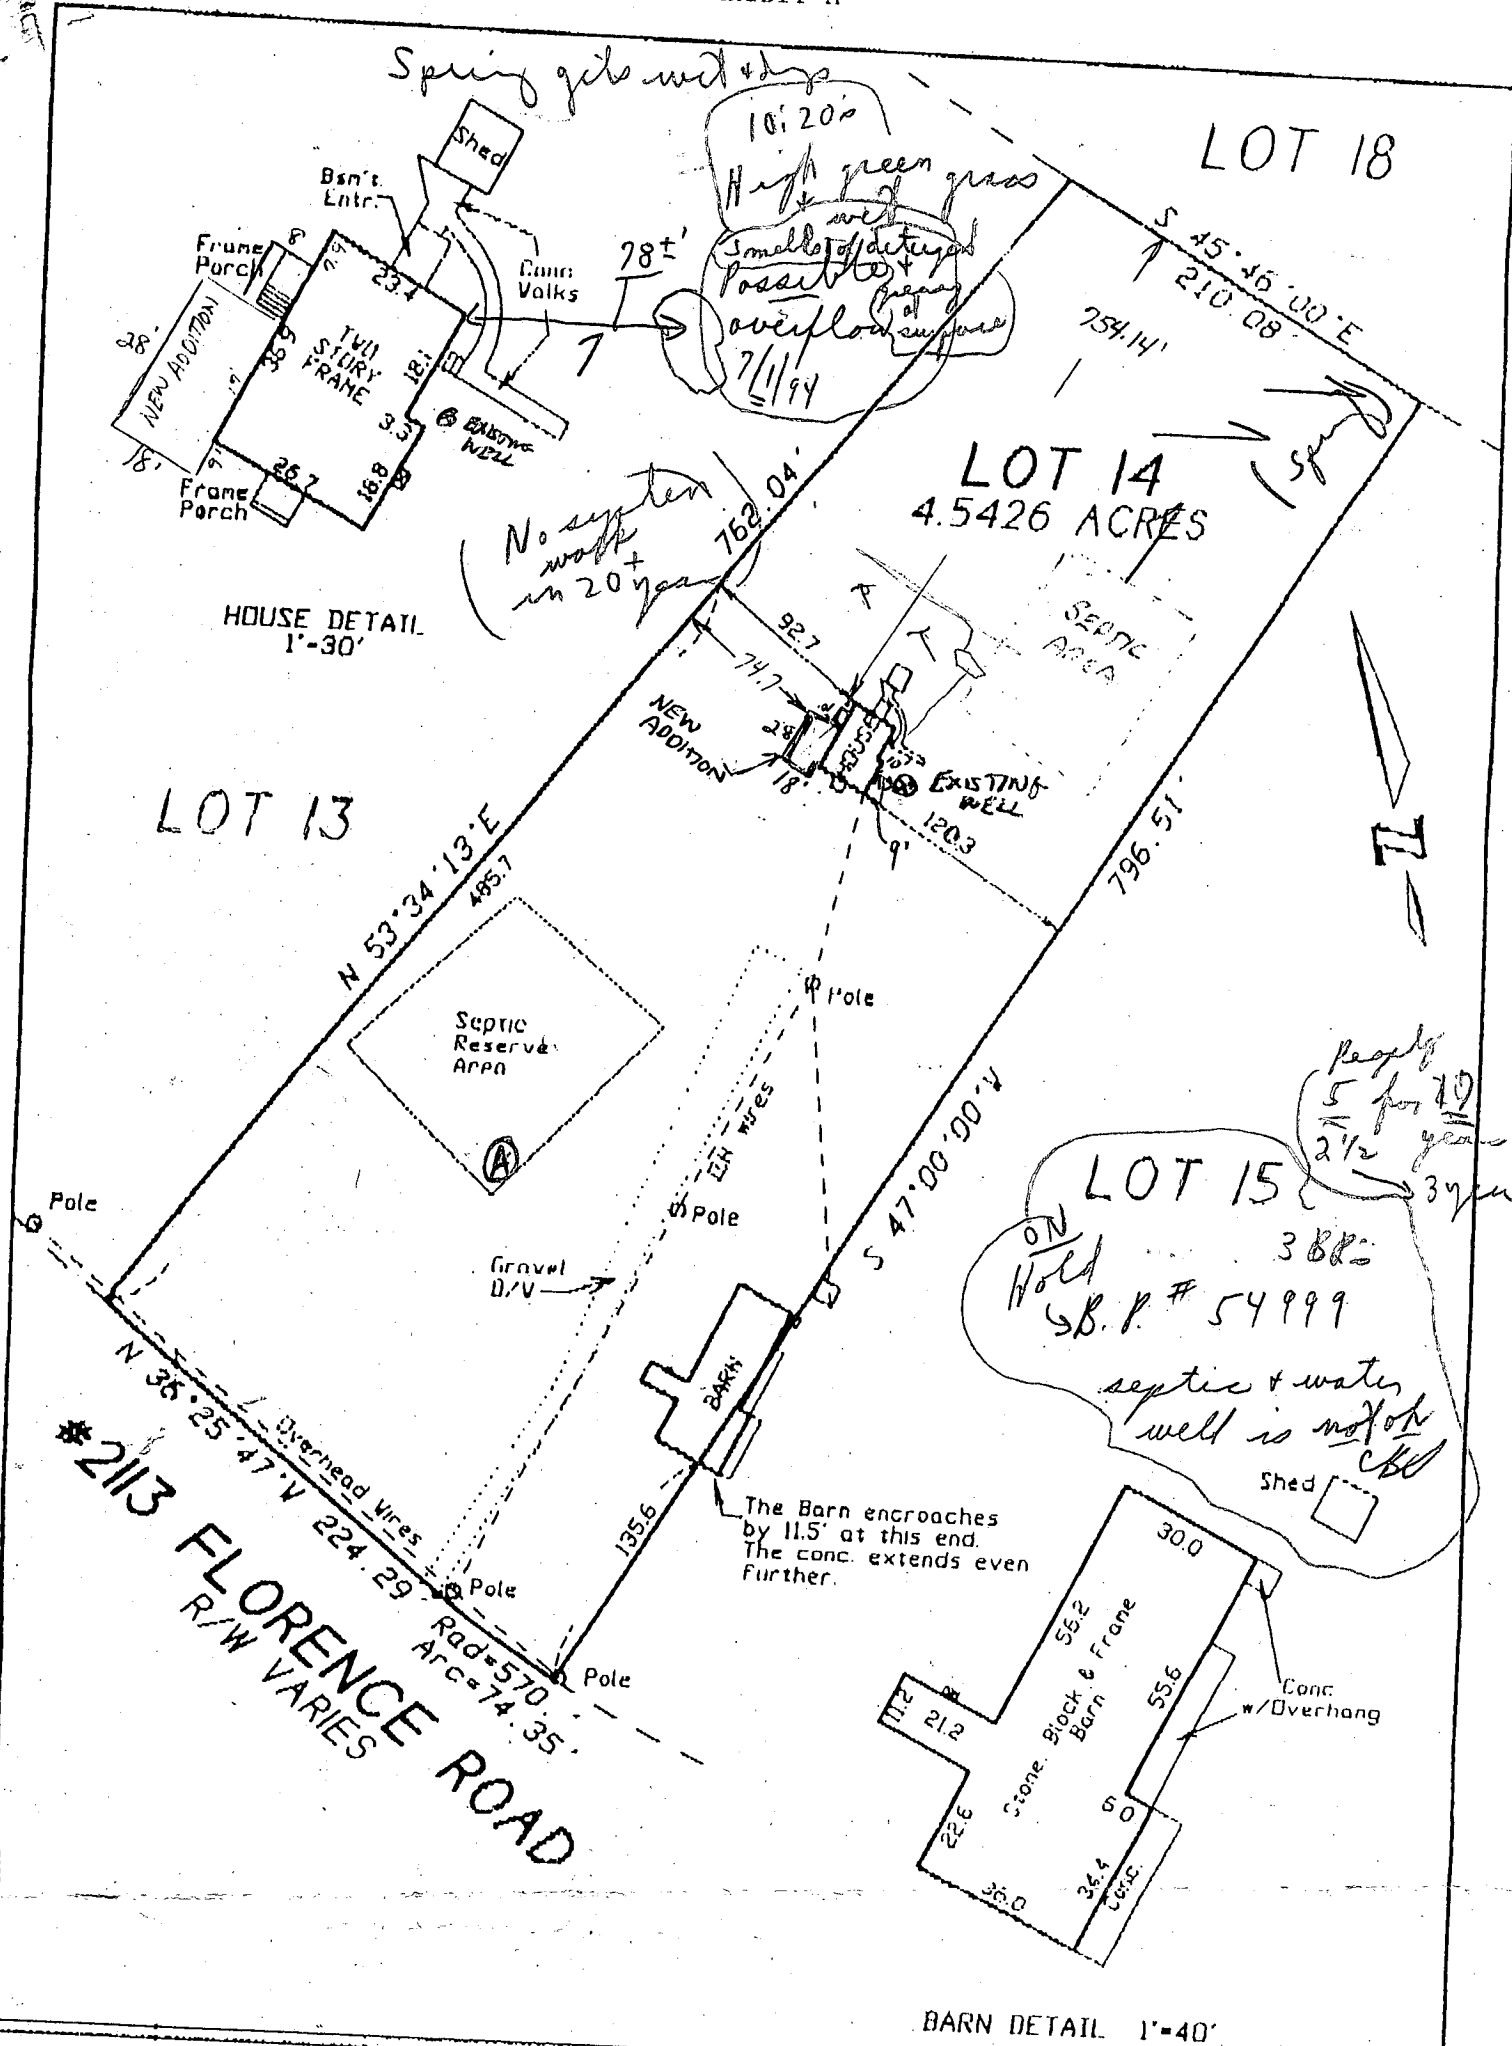

HOUSE LOCATION  
**LOT 14**  
 SECTION 2  
**FLORENCE ESTATES**  
 HOWARD COUNTY, MARYLAND

REFERENCE: PLAT 5899  
 DATE: 3-22-94  
 CLIENT: C & D SETTLEMENT 94-0071

I hereby certify to the client listed above that the information shown herein is correct in accordance with instruments of record that the locations of improvements have been located by accepted industry standards and that unless shown there are no visible encroachments.

This location has been prepared without the benefit of a title report and its only purpose is to depict the property configuration and improvement locations as of the date shown hereon. This location does not constitute a boundary survey and is not to be used in establishing property lines.

Steven F. Teets - Maryland Property Line Surveyor # 502

This lot falls within Zone C (Area of Minimal Flooding) per HUD. Panel No. 240044 0012 B

**TEETS POWELL & ASSOCIATES**

1780-D NORTH MARKET STREET  
 FREDERICK, MARYLAND 21701

FREDERICK PHONE: 301-662-5234  
 MONTICELLO PHONE: 301-831-4258  
 FAX: 301-620-7699


NOTES:

TPA JOB # 4059H

LAND SURVEYORS GPS CONSULTANTS

DECK 45.5' x 6'  
EQUIP. SHED 24' x 40' x 10'

EXHIBIT "A"

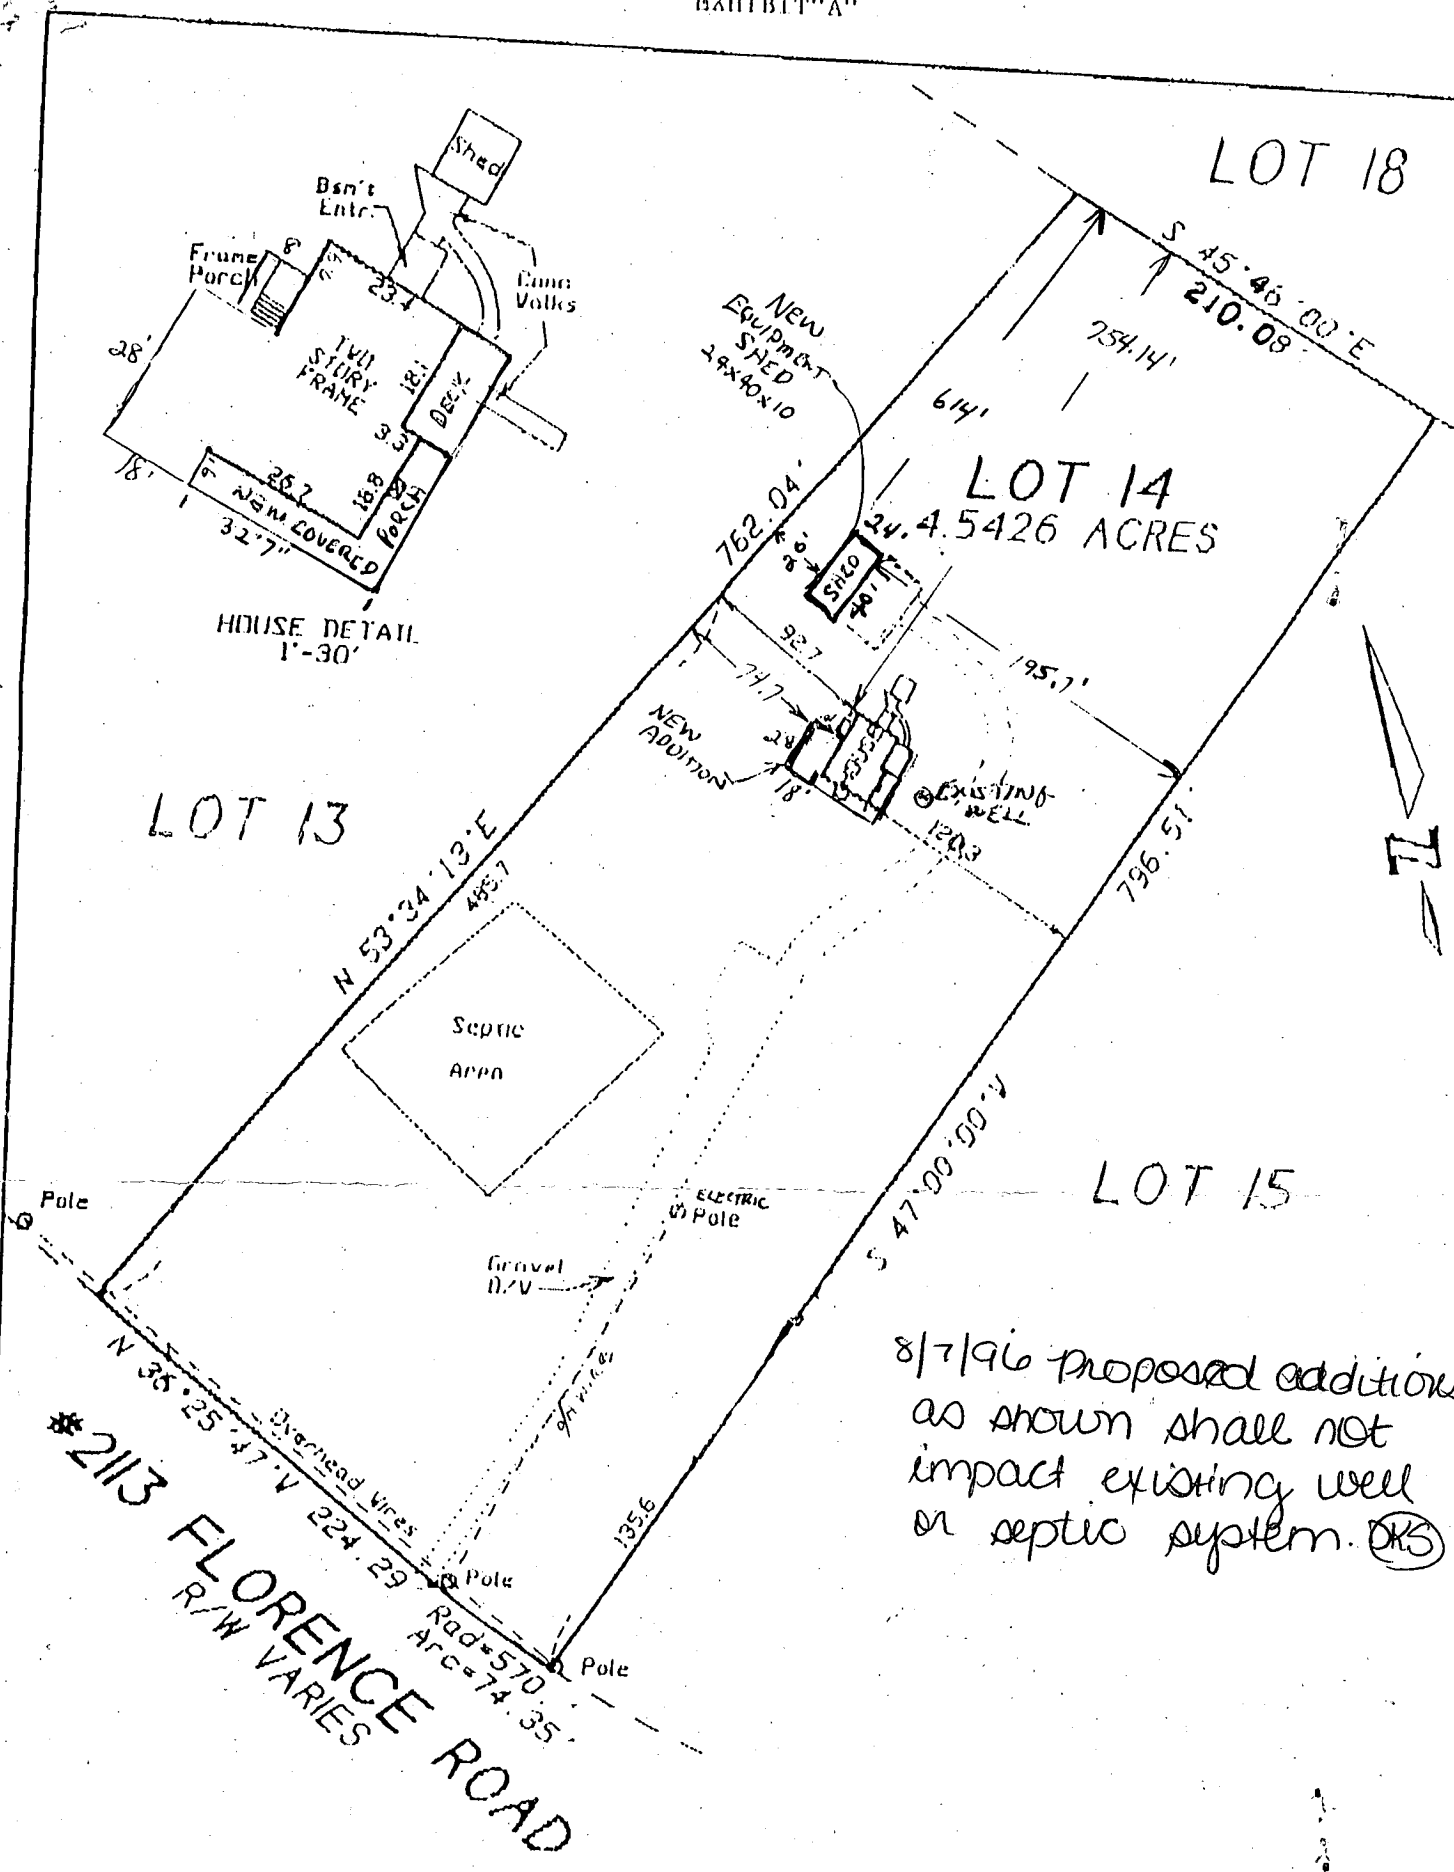

HOUSE LOCATION  
**LOT 14**  
 SECTION 2  
**FLORENCE ESTATES**  
 HOWARD COUNTY, MARYLAND

REFERENCE: PLAT 5899  
 DATE: 3-22-94 SCALE: 1" = 100'  
 CLIENT: C & P SETTLEMENT 94-0071

I hereby certify to the client that the information shown herein is correct in accordance with instruments of record that the locations of improvements have been located by accepted industry standards and that unless shown there are no visible encroachments.  
 This location has been prepared without the benefit of a title report and its only purpose is to depict the property construction and improvement locations as of the date thereof. This location does not constitute a boundary survey and is not to be used in establishing property lines.

This lot falls within Zone C (Area of Flooded) per HUD. Panel No. 1-00-44 002 B

NOTES:

**TESTS**  
**POWELL & ASSOCIATES**  
 LAND SURVEYORS GPS CONSULTANTS

TPA JTB # 4059H

*Steven F. Toole*  
 Steven F. Toole - Maryland Property Line Surveyor # 5102