

5/94
late pm

PERMIT

SEWAGE DISPOSAL SYSTEM
DEPARTMENT OF HEALTH AND MENTAL HYGIENE

50146B
A 13513

HOWARD COUNTY HEALTH DEPARTMENT
BUREAU OF ENVIRONMENTAL HEALTH
313-2640

DISTRICT 3rd

DATE 7/2/94

DATE SYSTEM APPROVED 2/15/94

INSPECTOR AM

INDEXED

Pogle's Septic Clean

IS PERMITTED TO INSTALL ALTER

ADDRESS 558 Obrecht Road, Sykeville, Maryland 21784 PHONE 793-5674

SUBDIVISION Winslow Property LOT 3 ROAD 11910 Emerald Court

PROPERTY OWNER Carroll L. Rojas MEAL & JANE SAPP

ADDRESS _____

SEPTIC TANK CAPACITY 1250 GALLONS

NUMBER OF BEDROOMS 4

180 SQUARE FEET PER BEDROOM

LINEAR FEET OF TRENCH REQUIRED 240

120
120
240
60020

TRENCHES - Trench to be 3 feet wide, Inlet 31 feet below original grade, Bottom minimum depth 51 feet below original grade. Effective area begins at 31 feet below original grade, 2 feet of stone below distribution pipe.

LOCATION - Place the distribution box 150 feet from the right (360°) lot line and 135 feet from the left lot line as seen when facing the property from Emerald Valley Court. Run trenches along contour toward the left lot line (360.79°).

NOTE - No trench to exceed 100 feet in length. Provide 6" - 8" diameter cleanout and cap to grade or above on septic tank. OK 7/8/94 BRJ

PLANS APPROVED BY C. Williams/A. McMillen REVISED DATE 06/13/94

COVER NO WORK UNTIL INSPECTED AND APPROVED

NEITHER THE HOWARD COUNTY COUNCIL NOR THE HEALTH DEPARTMENT IS RESPONSIBLE FOR THE SUCCESSFUL OPERATION OF ANY SYSTEM

NOTE: CLEANOUT REQUIRED EVERY 70 FEET OF SEWER LINE AND/OR AT 90° SWEEPS IN LINES FROM HOUSE TO DRAIN FIELDS, 90° ELBOWS NOT ACCEPTABLE.

NOTE: ALL PARTS OF SEPTIC SYSTEMS (I.E. TANK, DISTRIBUTION BOX, TRENCHES) TO BE 100 FEET FROM WELL (UNLESS OTHERWISE SPECIFICALLY AUTHORIZED).

NOTE: IF DEEP TRENCH(ES) ARE USED CALL FOR INSPECTION BEFORE AND AFTER PLACING GRAVEL IN TRENCH(ES)

NOTE: NO DRY WELL SHALL EXCEED 15 FOOT IN DIAMETER NO ABSORPTION TRENCH TO EXCEED 100 FEET IN LENGTH

NOTE: ALL PIPE FROM HOUSE TO SEPTIC TANK MUST BE CAST IRON OR SCHEDULE 3840 PVC OR ABS

PERMIT VOID AFTER TWO YEARS

NOTE: INSTALL STAND PIPE ON SEPTIC TANK AND DRY WELL STAND PIPES MUST BE 6 INCHES IN DIAMETER CAST IRON, CONCRETE OR TERRA COTTA OR PVA OR ABS ACCEPTED. IF TOP OF SEPTIC TANK IS DEEPER THAN 3 FEET, MANHOLE TO GRADE REQUIRED.

NOTE: DISTRIBUTION BOXES MUST HAVE BAFFLES

*INSTALLER IS RESPONSIBLE FOR OBTAINING FINAL APPROVAL ON THIS PERMIT

*CALL 461-6633 FOR INSPECTION OF SEPTIC SYSTEM.


HD-270(9-00)

SEWER PERMIT SIGNED
AND RETURNED 7-23-94
Serial # 21010 7115
check with [unclear]

13513

A 50146B

P E R M I T

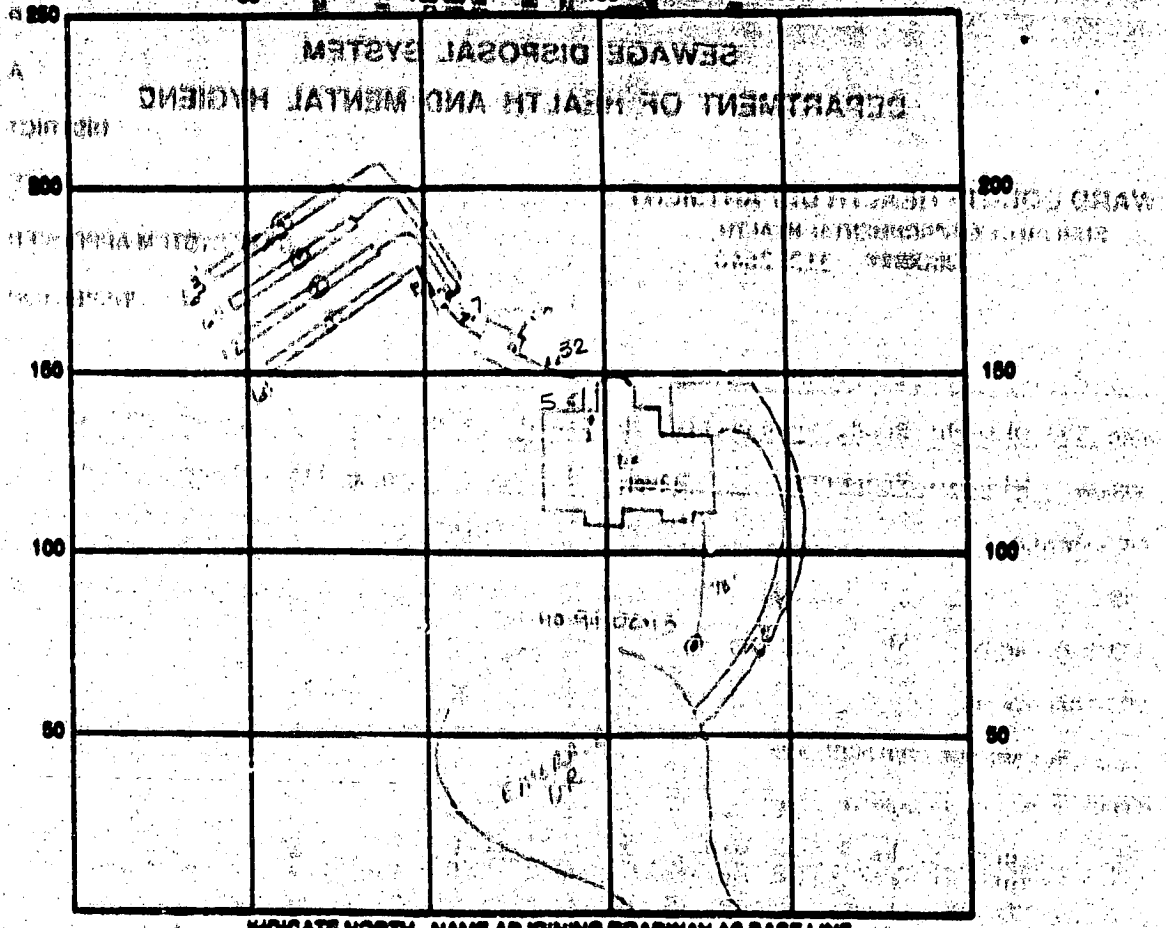

INDICATE NORTH - NAME ADJOINING ROADWAY AS BASE LINE

SEPTIC TANK LEVEL 150 CLEANOUTS OK

DISTRIBUTION BOX LEVEL OK

DRAIN FIELD/TITLE DEPTH 5-5 1/2 FT. TRENCH WIDTH 3 FT. INLET DEPTH 3-3 1/2 FT.

EFFECTIVE GRAVEL DEPTH 2 FT. TOTAL LENGTH 245 FT.

NUMBER OF TRENCHES 4 ONE SIDEWALL/BOTTOM AREA 735 SQ. FT.

DRYWALL INSIDE DIAMETER _____ FT. EFFECTIVE DEPTH BELOW INLET _____ FT.

ABSORBENT AREA _____ SQ. FT.

REMARKS: 4' x 4' Trenches 25' in cover. All work OK to cover - LINDA ALLEN

5/15/04

DATE SYSTEM APPROVED 5/15/04 INSPECTOR John M. Mullen

1 8763

SEQUENCE NO. (DENY USE ONLY)

STATE OF MARYLAND WELL COMPLETION REPORT

THIS REPORT MUST BE SUBMITTED WITHIN 45 DAYS AFTER WELL IS COMPLETED

THIS NUMBER IS TO BE PUNCHED IN COLUMNS 3-8 ON ALL CARDS

COUNTY NUMBER A15513

DATE RECEIVED

DATE WELL COMPLETED 032494

DEPTH OF WELL 250 (TO NEAREST FOOT)

PERMIT NO. W-24-0041

OWNER, STREET OR RFD, SUBDIVISION, SECTION, LOT

WELL LOG

Table with columns: DESCRIPTION, FEET (FROM, TO), Check water bearing. Rows include: Burden, Shale, etc.

ROUTING RECORD: WELL HAS BEEN GROUTED (Y) (N), TYPE OF GROUTING MATERIAL: CEMENT (CM), BENTONITE CLAY (BC), NO. OF BAGS, NO. OF POUNDS, GALLONS OF WATER, DEPTH OF GROUT SEAL

CASING RECORD: casing types insert appropriate code below: ST (STEEL), CO (CONCRETE), PL (PLASTIC), OT (OTHER)

MAIN CASING TYPE: Nominal diameter, Total depth

OTHER CASING (if used): diameter, depth

SCREEN RECORD: screen type of open hole insert appropriate code below: ST (STEEL), BR (BRASS), HO (OPEN HOLE), PL (PLASTIC), OT (OTHER)


Table for screen depth: DEPTH (nearest ft.), SLOT SIZE, DIAMETER OF SCREEN

GRAVEL PACK: IF WELL DRILLED WITH FLOWING WELL INSERT F IN BOX 68

TELESCOPE CASING, LOG INDICATOR, OTHER DIA.

SLUING TEST: HOURS PUMPED, PUMPING RATE, METHOD USED TO MEASURE PUMPING RATE, WATER LEVEL, BEFORE PUMPING, WHEN PUMPING, TYPE OF PUMP USED

PUMP INSTALLED: DRILLER WILL INSTALL PUMP (YES/NO), TYPE OF PUMP INSTALLED, CAPACITY, PUMP HORSE POWER, PUMP COLUMN LENGTH, CASING HEIGHT

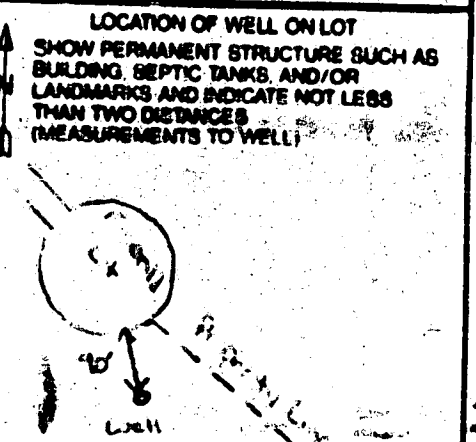

CIRCLE APPROPRIATE LETTER: A WELL WAS ABANDONED AND SEALED WHEN THIS WELL WAS COMPLETED

E ELECTRIC LOG OBTAINED

P TEST WELL CONVERTED TO PRODUCTION WELL

THE ENGINEER CERTIFIES THAT THIS WELL HAS BEEN CONSTRUCTED IN ACCORDANCE WITH COMAR 26.08.04

DRILLERS IDENT. NO.

DRILLERS SIGNATURE

DATE SUPERVISOR (sign. of driller or journeyman responsible for sitework if different from permittee)

7/24/97

Shown deck addition will have no impact to the existing well and septic. OK to continue

ALM

AT TIME OF PER
3. TOTAL NUMBER
4. REFERENCE P

EVERGREEN VALLEY SEC 4
T3S R10E S54

LOT 26

LOT 25

LOT 1

EVERGREEN VALLEY SEC 2
T3S R9E S12

190.00
N 35° 50' 09" W
243.53'

30' B.R.L.
20' 8'

157° 53' 51" E
190.00

LOT 3
3.032 AC

63° 58' 51" W

60' B.R.L.

30' B.R.L.

S 05° 33' 09" E

360.79'

241.23

EMERALD COL

LOT 4
WINSLOW PROPERTY

