

PERMIT

SEWAGE DISPOSAL SYSTEM

DEPARTMENT OF HEALTH AND MENTAL HYGIENE

P 50222
A 16664
A REPAIR

DISTRICT 4th

DATE 8/18/94

HOWARD COUNTY HEALTH DEPARTMENT

BUREAU OF ENVIRONMENTAL HEALTH

~~461-8838~~ 313-2640

DATE SYSTEM APPROVED _____

INSPECTOR _____

INDEXED

Gregg & Darlene McCarron IS PERMITTED TO INSTALL _____ ALTER X

ADDRESS 2490 Florence Road, Mt. Airy, Maryland 21771 PHONE 795-3028

SUBDIVISION _____ LOT _____ ROAD 2496 Florence Road

PROPERTY OWNER Greg & Darlene McCarron

ADDRESS 2496 Florence Road
Mt. Airy, Maryland 21771

SEPTIC TANK CAPACITY _____ GALLONS

NUMBER OF BEDROOMS _____

_____ SQUARE FEET PER BEDROOM

LINEAR FEET OF TRENCH REQUIRED _____

REPAIR - PURPOSE - TO AUTHORIZE HOUSE CONNECTION TO EXISTING SYSTEM.

Call for inspection when connection has been made so that a sanitarian can
approved the location and connection. 08/18/94

PLANS APPROVED BY _____ DATE _____

COVER NO WORK UNTIL INSPECTED AND APPROVED

NEITHER THE HOWARD COUNTY COUNCIL NOR THE HEALTH DEPARTMENT IS RESPONSIBLE FOR THE SUCCESSFUL OPERATION OF ANY SYSTEM

NOTE: CLEANOUT REQUIRED EVERY 70 FEET OF SEWER LINE AND/OR AT 90° SWEEPS IN LINES FROM HOUSE TO DRAIN FIELDS, 90° ELBOWS NOT ACCEPTABLE.

NOTE: ALL PARTS OF SEPTIC SYSTEMS (I.E. TANK, DISTRIBUTION BOX TRENCHES) TO BE 100 FEET FROM WELL (UNLESS OTHERWISE SPECIFICALLY AUTHORIZED)

NOTE: IF DEEP TRENCH(ES) ARE USED CALL FOR INSPECTION BEFORE AND AFTER PLACING GRAVEL IN TRENCH(ES)

NOTE: NO DRY WELL SHALL EXCEED 15 FOOT IN DIAMETER NO ABSORPTION TRENCH TO EXCEED 100 FEET IN LENGTH

NOTE: ALL PIPE FROM HOUSE TO SEPTIC TANK MUST BE CAST IRON OR SCHEDULE 35/40 PVC OR ABS


PERMIT VOID AFTER TWO YEARS

NOTE: INSTALL STAND PIPE ON SEPTIC TANK AND DRY WELL STAND PIPES MUST BE 6 INCHES IN DIAMETER CAST IRON. CONCRETE OR TERRA COTTA OR PVA OR ABS ACCEPTED. IF TOP OF SEPTIC TANK IS DEEPER THAN 3 FEET. MANHOLE TO GRADE REQUIRED.

NOTE: DISTRIBUTION BOXES MUST HAVE BAFFLES

***INSTALLER IS RESPONSIBLE FOR OBTAINING FINAL APPROVAL ON THIS PERMIT**

P 50222

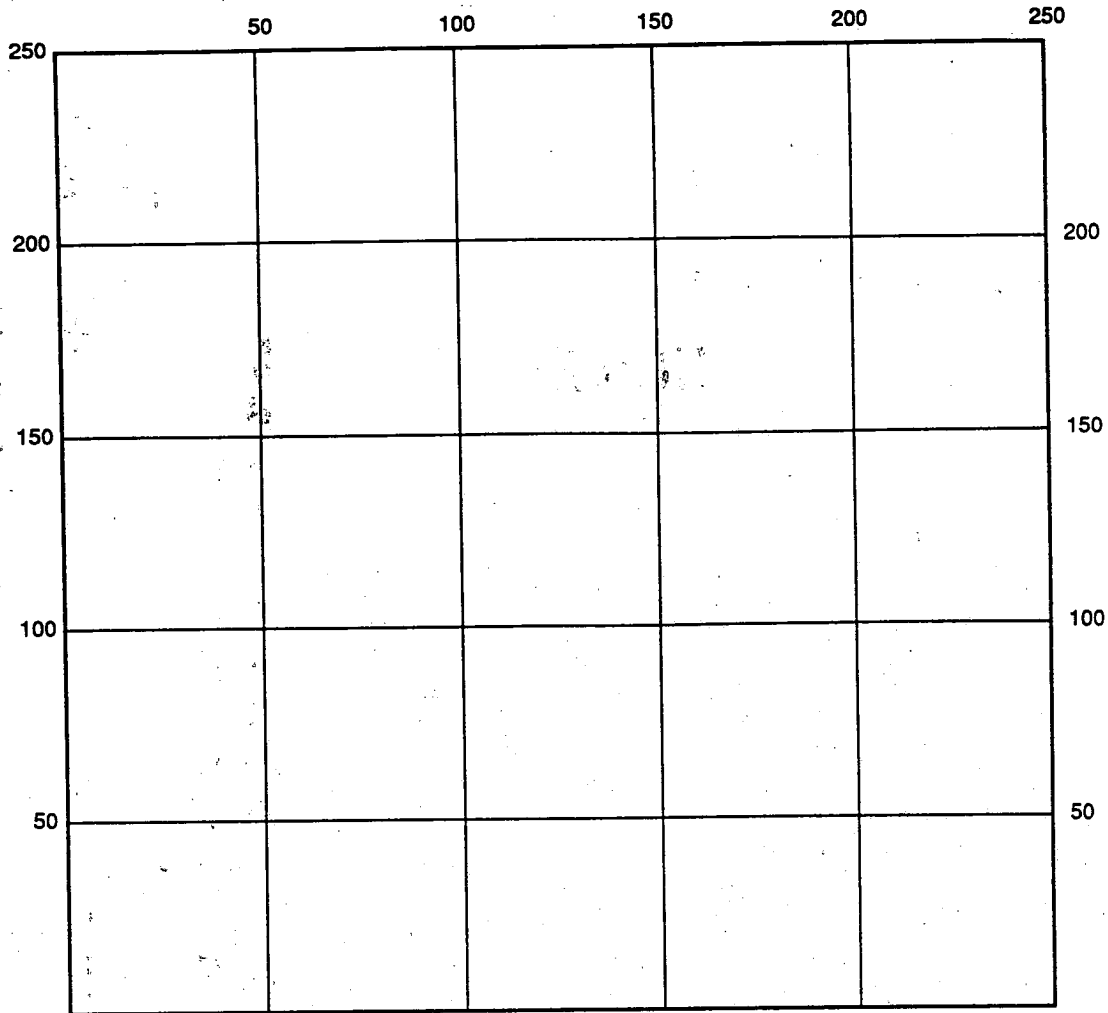

INDICATE NORTH - NAME ADJOINING ROADWAY AS BASE LINE

SEPTIC TANK LEVEL _____ CLEANOUTS _____

DISTRIBUTION BOX LEVEL _____

DRAIN FIELD/TITLE DEPTH _____ FT. TRENCH WIDTH _____ FT. INLET DEPTH _____ FT.

EFFECTIVE GRAVEL DEPTH _____ FT. TOTAL LENGTH _____ FT.

NUMBER OF TRENCHES _____ ONE SIDEWALL/BOTTOM AREA _____ SQ. FT.


DRYWALL INSIDE DIAMETER _____ FT. EFFECTIVE DEPTH BELOW INLET _____ FT.

ABSORBENT AREA _____ SQ. FT.



REMARKS: 2/10/99 Inspection on connection of trailer to the existing
septic system never done - Due to amt of time passed a confirmation
by driving by - the new trailer was put on property & no sewage on
ground - connection assumed to be completed. AMU


DATE SYSTEM APPROVED _____ INSPECTOR _____

96 acres

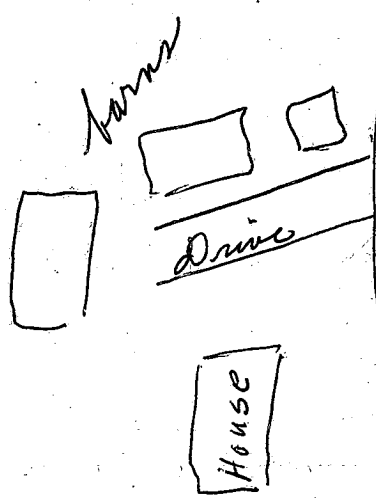

Gregg McCarroll

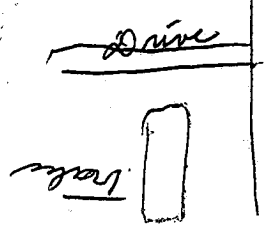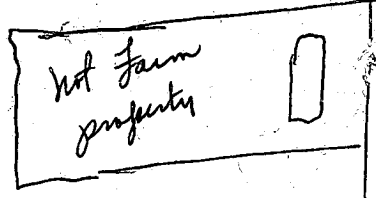

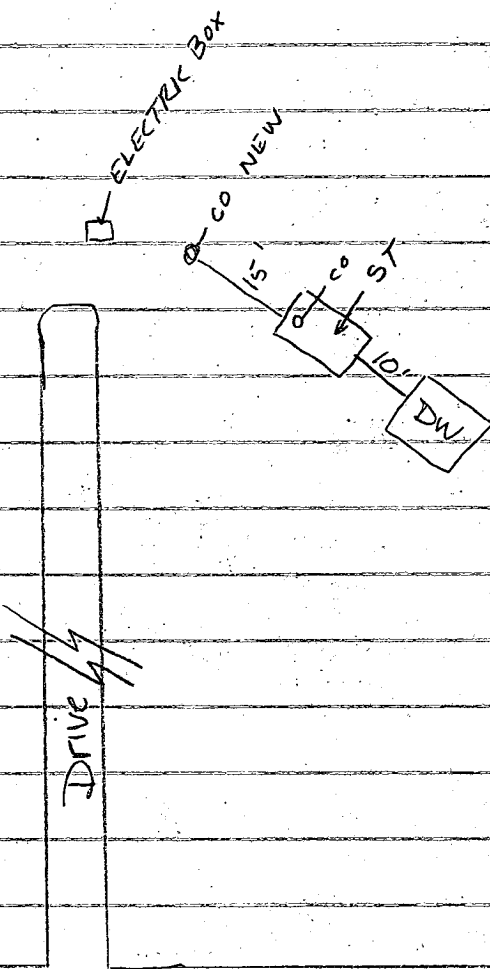


8/18/94

Field inspection for condition of existing septic system

Spoke with owner: ~~that~~ I suggested he get the septic tank pumped prior to u.s.o. The tank probably hasn't been pumped in the 20 yrs since it was initially installed. Tank was half full. New cleanouts were put on the septic tank and immediately outside where the house connection will go

Amy McMullen

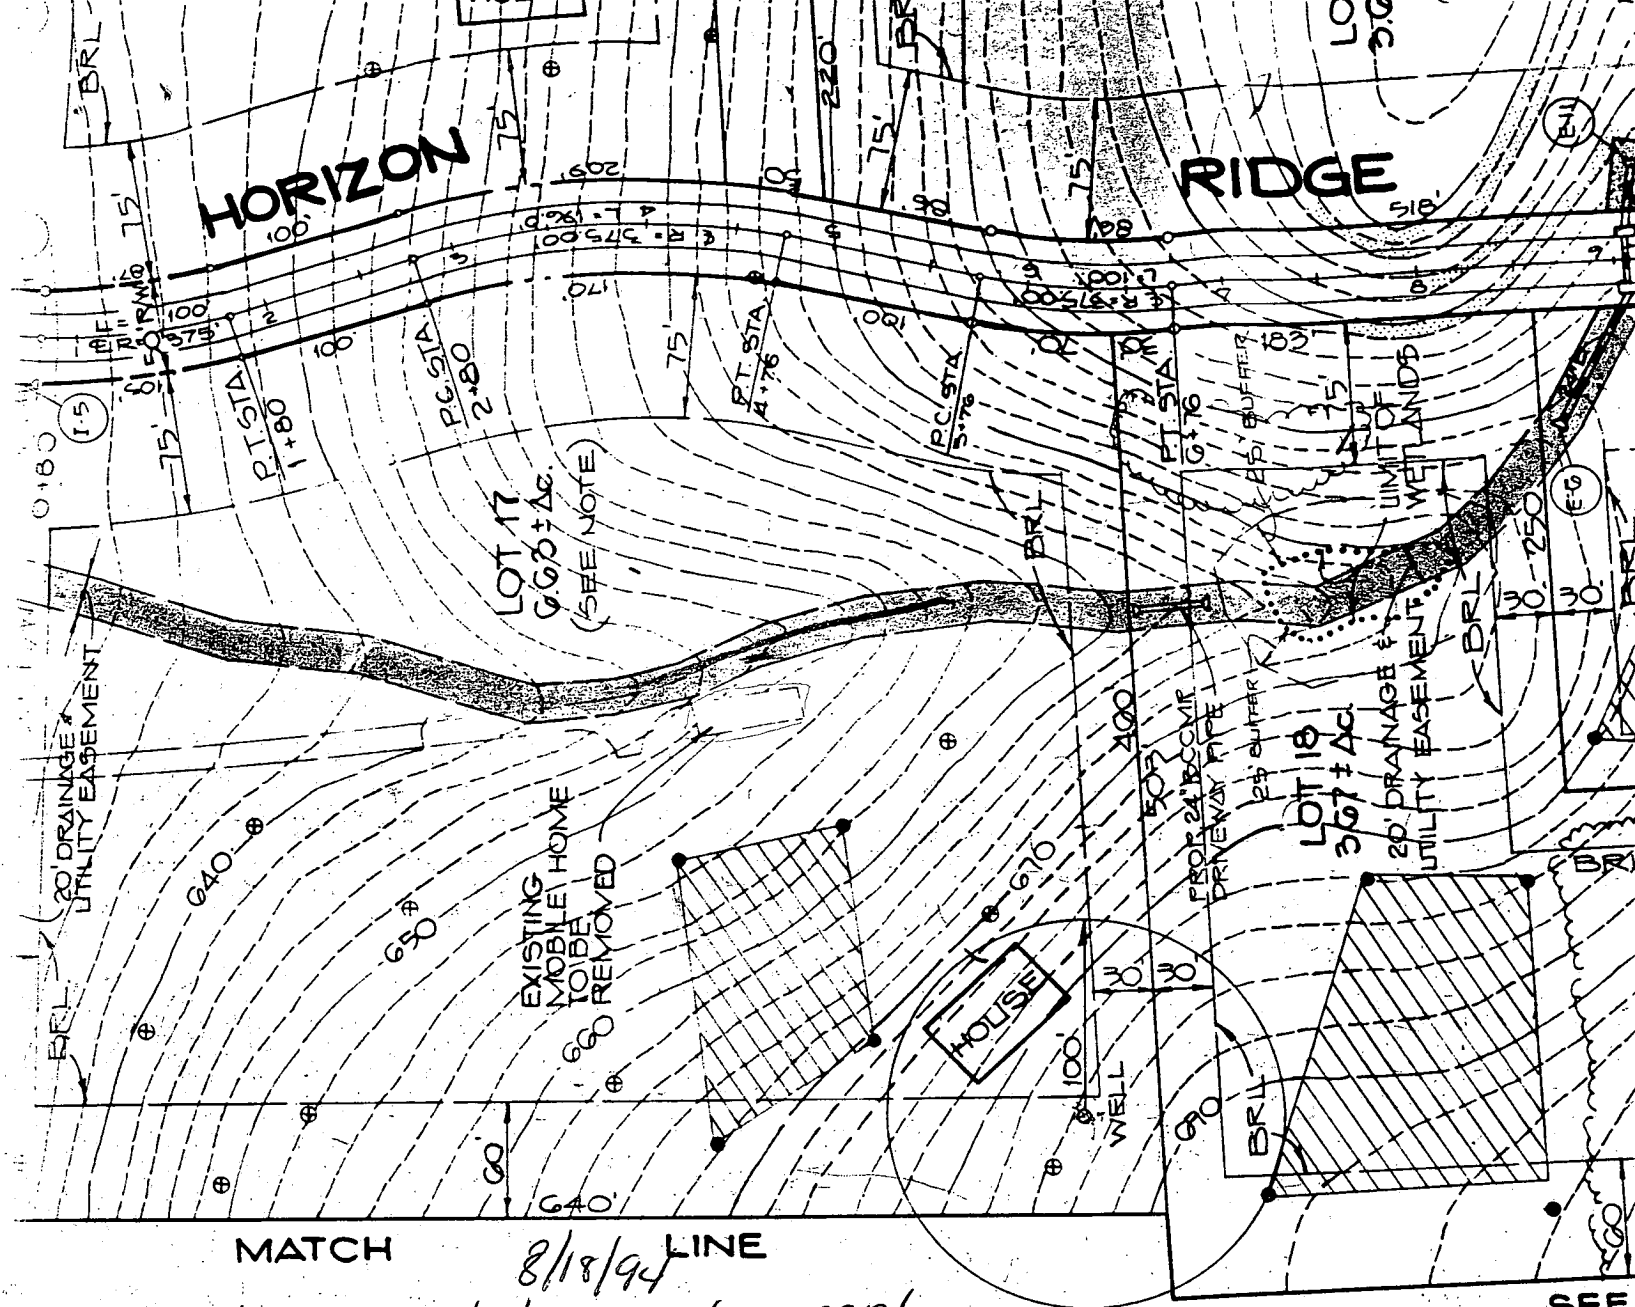

MATCH LINE 8/18/94

- Building permit for replacement trailer approved. ~~pending~~
 Agreed w/ owner to file a repair permit w/ this office (per CW)

Amy McMullen

005,075 N
 E 763.500

1-3
 FIN ON

SEE

APPLICATION

call cell, 795-3028

HOWARD COUNTY

PERMIT APPLICATION

DEPARTMENT OF INSPECTIONS, LICENSES & PERMIT
3430 COURT HOUSE DRIVE, ELLICOTT CITY, MARYLAND 21043

SERIAL NUMBER

55415

BUILDING ADDRESS (HOUSE NO., STREET, TOWN OR AREA)

2496 Florence Rd, Mt. Airy, Md 21771

GRADING/SEDIMENT CONTROL YES NO SDP #

DESCRIPTION OF WORK AUTHORIZED

placing a new 22' mobile home (tent) 12' x 22' trailer
exist curve

LOT NO.	PARCEL NO.	SEC.	AREA	BLOCK NO.	LIBER	FOLIO
N/A	25	N/A	N/A	24		

SUB DIVISION	ZONE	ZONE MAP	ELEC. DIST.	CENSUS TR.
N/A	R-C	6	4	6040

OWNER NAME AND ADDRESS
GREGG & CHARLENE McCARRON 110-795-3128
2490 Florence Rd, Mt. Airy, Md 21771

PHONE NO.

OCCUPANT'S NAME AND ADDRESS
Donna Ankergway
2496 Florence Rd, Mt. Airy, Md 21771

PHONE NO.

ARCHITECT OR ENGINEER'S NAME AND ADDRESS
None

PHONE NO.

CONTRACTOR'S NAME AND ADDRESS
owner

PHONE NO.

EXISTING USE	PROPOSED USE
vacant lot	single family mobile home
EST. CONSTRUCTION COST \$500.00	LICENSE NUMBER
	PERMIT FEE

SIZE OF BLDG.	FRONT	DEPTH	HEIGHT
1977			
MONI (Make)			
Style TL		class 6	

TYPE OF BLDG.	AREA	VOLUME	ROOF
B. ROOMS			
ROOMS			
BATHS			
FIREPLACES			

FOOTINGS	FOUNDATION	S. WALLS

UTILITIES					
<input checked="" type="checkbox"/>	<input checked="" type="checkbox"/>	<input checked="" type="checkbox"/>	<input checked="" type="checkbox"/>	<input checked="" type="checkbox"/>	<input checked="" type="checkbox"/>
WATERWELL	SEWER/SEPTIC	GAS	ELECTRICITY	TYPE OF HEAT	AC
				Flue	

I have carefully examined and read this application and know the same is true and correct, and that is doing this work, all provisions of Howard County Ordinances and the State Laws of Maryland will be complied with, whether specified or not; and I will notify the Department of Inspections, and Permits twenty-four hours in advance when I am ready for the inspections called for elsewhere in the application; and that no work will be covered up until such inspections have been complied with.

SIGNATURE: occupant
TITLE: occupant
DATE: 7.15.94

FOR OFFICE USE ONLY

DISTRICT IN FEET FROM R/W LINE TO FRONT BUILDING LINE _____

SIDE YARD (DISTANCE IN FEET FROM SIDE BLDG. LINE TO SIDE PROPERTY LINE) _____

TO SIDE BUILDING LINE DISTANCE IN FEET, REAR YD. REQUIRING SET _____

BACK (CORNER LOT ONLY) _____

SDP # _____

FUNCTION	DATE	SIGNATURE APPROVAL
ZONING/PLANNING	X	
SHA		
SEDIMENT/GRADING		
BUILDING OFFICIAL	X	
WATER & SEWER		
HEALTH DEPT.	8/18/94	Anny McMe
FIRE PROTECTION		
STORM WATER MGM.	X	

Check payable to: DIRECTOR OF FINANCE OF HOWARD COUNTY

CAUTION
To begin construction before a permit placard has been issued and displayed on the job is a violation of the law.
Use and occupancy permit must be applied for two weeks before it will be issued.

IMPORTANT: PLEASE SHOW ZIP CODES AND AREA CODES WHEREVER REQUIRED.

APPROVED

DATE

Distribution of Copies:
White - Building Official
Green - Planning & Zoning

Yellow - Engineering
Pink - Health Dept.
Gold - S.H.A.

app. 5-23-72
Down

5/19/72
Ready

PERMIT

P 16935

A 16664

SEWAGE DISPOSAL SYSTEM

MARYLAND STATE DEPARTMENT OF HEALTH

HOWARD COUNTY

ELLICOTT CITY

INDEXED

DISTRICT 4

DATE 4/18/72

Howard Pickett IS PERMITTED TO INSTALL ALTER

ADDRESS Watersville Road, Mt. Airy, Md. PHONE 829-0543

A SEWAGE DISPOSAL SYSTEM LOCATED AT _____

SUBDIVISION _____ ROAD 2484 Florence Rd. LOT _____
(see application for better directions)

PROPERTY OWNER Gregg McCarron

ADDRESS _____

SPECIFICATIONS - 2 bedroom trailer

DRAIN FIELD _____ DEPTH _____ FEET, BOTTOM AREA _____ SQ. FT.

SEEPAGE PITS _____ ABSORBENT SIDE-WALL AREA _____ SQ. FT.

SEPTIC TANK CAPACITY 1,000 GALLONS

FOR GARBAGE GRINDER, INCREASE DISPOSAL AREA 22% & TANK CAPACITY 50%.

OTHER Dry well 300 sq. ft. sidewall area below inlet with inlet no deeper than

5 ft. and bottom of dry well no deeper than 11 ft. Place the dry well 400 ft.

from edge of Florence Road and 75 ft. ^{uphill} from the ~~uphill~~ dirt driveway.

It maybe necessary to move trailer in order to utilize this area.

NOTE: ALL PIPE FROM TRAILER TO HOUSE MUST BE CAST IRON.

PERMIT VOID AFTER THREE YEARS.

NOTE: INSTALL STAND PIPE ON SEPTIC TANK AND DRY WELL.
PLANS APPROVED BY Raymond Hodges DATE 4/7/72


FILL SEPTIC TANK AND DISTRIBUTION BOX WITH WATER BEFORE CALLING FOR AN INSPECTION. COVER NO WORK UNTIL INSPECTED AND APPROVED.

NEITHER THE HOWARD COUNTY COMMISSIONERS NOR THE HEALTH DEPARTMENT IS RESPONSIBLE FOR THE SUCCESSFUL OPERATION OF ANY SYSTEM.

BLDG. PERMIT SIGNED
AND RETURNED 8/18/94

Serial # 53415
tenant hauls

A
16664

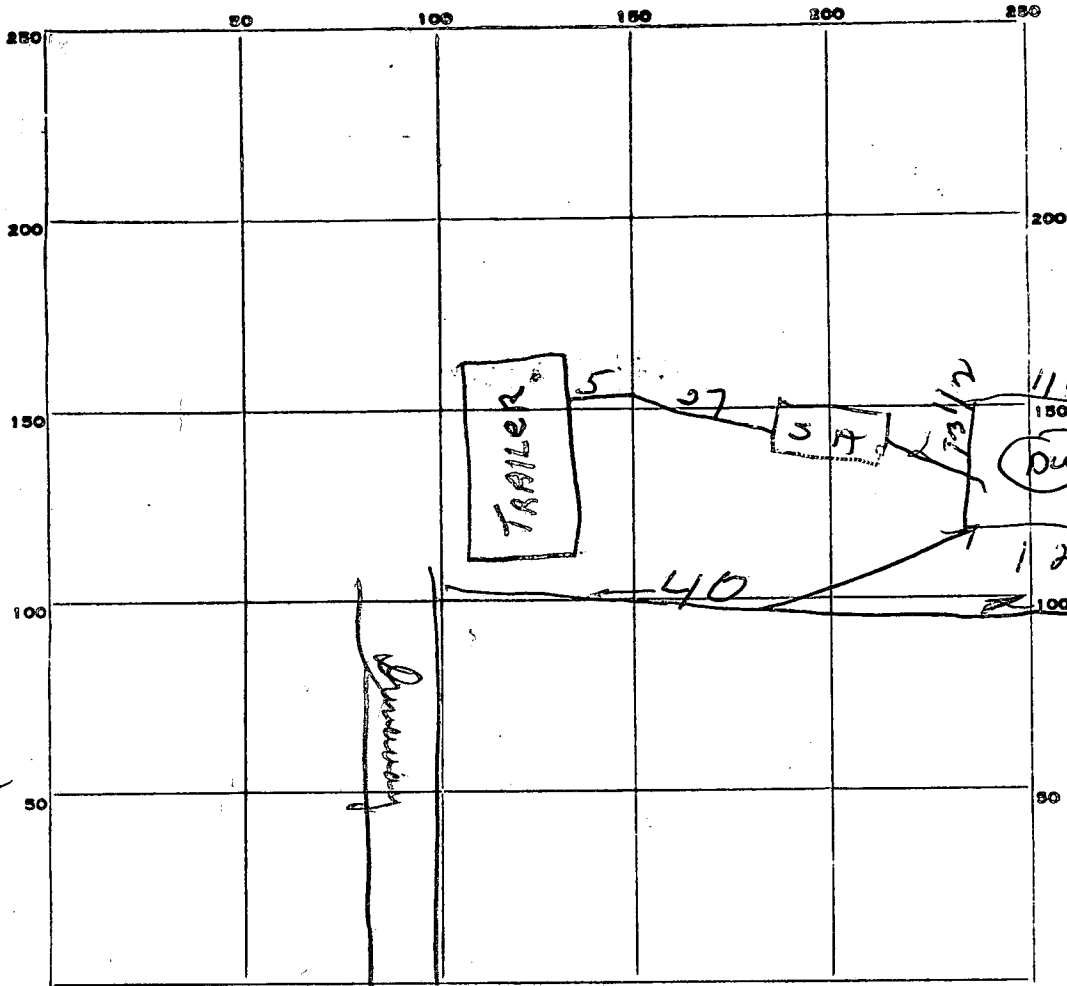

13 1/2
11 1/2
12
46

47 1/2
6 1/2
23
305

INDICATE NORTH. - NAME ADJOINING ROADWAY AS BASE LINE.

Florence Rd

PERMIT CARD OK

SEPTIC TANK, LEVEL OK

CLEANOUTS OK

DISTRIBUTION BOX, LEVEL _____

TILE FIELD, DEPTH _____ FT. TRENCH WIDTH _____ FT.

GRAVEL DEPTH _____ IN. TOTAL LENGTH _____ FT.

NUMBER OF TRENCHES _____ TOTAL BOTTOM AREA _____

SEEPAGE PITS, INSIDE DIAMETER Perimeter 47 FT. DEPTH BELOW INLET 6 1/2 effector FT.

ABSORBENT AREA 305 SQ. FT.

REMARKS 5/19/72 - dy well in wrong location - is only 40 ft from edge of dirt road instead of 75 ft. will need further tests SWM?

DATE SYSTEM APPROVED 5-23-72

INSPECTOR DW Monahan

2-12' holes

APPLICATION

A 16664

SEWAGE DISPOSAL TESTING

P _____

MARYLAND STATE DEPARTMENT OF HEALTH

HOWARD COUNTY

ELLICOTT CITY

DISTRICT 4

DATE 1/19/72

Recorded
3/1/72
4/2/72

Cancelled
ht water

2/25/72
4/1/72
4/30/72

Cancelled by R.W. due to rain

1000 Gal Tank
Dry Well 300 sq ft
below inlet with inlet no deeper than 5 FT
and bottom of dry well no deeper than 11 FT
Place the dry well 400 FT from edge
of Florence Rd and 75 FT from
dirt driveway. It may be
necessary to
move trailer in order
to utilize this area

TO: THE COUNTY HEALTH OFFICER
ELLICOTT CITY, MARYLAND

I, HEREBY, APPLY FOR THE NECESSARY TESTS IN ORDER TO CONSTRUCT (OR RECONSTRUCT) A SEWAGE DISPOSAL SYSTEM.

PROPERTY OWNER Gregg McCarron

ADDRESS 2484 Florence Road, Mt. Airy, Md.

PHONE 829-1797

PROPERTY LOCATION:

SUBDIVISION

LOT NO.

ROAD AND DESCRIPTION

2484 Florence Road - name on mail box - don't use Shaffer's Mill Road

(Use St. Michaels' Road end)

OCCUPANT

PHONE

PERSON TO CONSTRUCT SYSTEM

ADDRESS

PHONE

SIZE OF LOT

96 acres

TYPE BLDG.

Trailer

2

NUMBER OF BEDROOMS

IF NOT SINGLE RESIDENCE DESCRIBE

SIGNATURE OF APPLICANT

Gregg McCarron

APPROVED BY

Raymond Hodges

FOR

drywell

(KIND OF SYSTEM)

DATE

4/7/72

REJECTED BY

FOR

(KIND OF SYSTEM)

DATE

HOLD PENDING FURTHER TESTS

DATE

REASONS FOR REJECTION OR HOLDING

THIS IS NOT A PERMIT

APPLICATION

SEWAGE DISPOSAL TESTING

A 16664

P _____

MARYLAND STATE DEPARTMENT OF HEALTH

HOWARD COUNTY

ELLICOTT CITY

DISTRICT 4

DATE 1/19/72

TO: THE COUNTY HEALTH OFFICER
ELLICOTT CITY, MARYLAND

I, HEREBY, APPLY FOR THE NECESSARY TESTS IN ORDER TO CONSTRUCT (OR RECONSTRUCT) A SEWAGE DISPOSAL SYSTEM.

PROPERTY OWNER Gregg McCarron

ADDRESS 2484 Florence Road, Mt. Airy, Md. PHONE 829-1797

PROPERTY LOCATION:

SUBDIVISION _____ LOT NO. _____

ROAD AND DESCRIPTION 2484 Florence Road - name on mail box - don't use Shaffer's
Mill Road
(Use St. Michaels' Road end)

OCCUPANT _____ PHONE _____

PERSON TO CONSTRUCT SYSTEM _____

ADDRESS _____ PHONE _____

SIZE OF LOT 96 acres TYPE BLDG. Trailer
2

NUMBER OF BEDROOMS

IF NOT SINGLE RESIDENCE DESCRIBE _____

SIGNATURE OF APPLICANT Gregg McCarron

APPROVED BY _____ FOR _____ DATE _____
(KIND OF SYSTEM)

REJECTED BY _____ FOR _____ DATE _____
(KIND OF SYSTEM)

HOLD PENDING FURTHER TESTS _____ DATE _____

REASONS FOR REJECTION OR HOLDING _____

THIS IS NOT A PERMIT

