

8/19/97
2:30-3

PERMIT

SEWAGE DISPOSAL SYSTEM

DEPARTMENT OF HEALTH AND MENTAL HYGIENE

INDEXED

P 58914

A 35523 B

DISTRICT 4th

DATE 8/12/97

DATE SYSTEM APPROVED 8/19/97

INSPECTOR [Signature]

HOWARD COUNTY HEALTH DEPARTMENT

BUREAU OF ENVIRONMENTAL HEALTH

~~XX649933~~ 313-2640

Fogle's Septic Clean, Inc.

IS PERMITTED TO INSTALL X ALTER

ADDRESS 558 Obrecht Road Sykesville, MD 21784 PHONE (410) 795-5670

SUBDIVISION Country View LOT 7 ROAD 17531 Country View Way

PROPERTY OWNER Scott & Beth DeLise

ADDRESS _____

SEPTIC TANK CAPACITY 1250 GALLONS TOP SEAMED TANK

NUMBER OF BEDROOMS 4

210 SQUARE FEET PER BEDROOM

LINEAR FEET OF TRENCH REQUIRED 280

TRENCHES - Trench to be 3 feet wide. Inlet 3 feet below original grade. Bottom maximum depth 5 feet below original grade. Effective area begins at 3 feet below original grade. 2 feet of stone below distribution pipe.

LOCATION - Place the distribution box 220 feet down the left (301.65') lot line and 50 feet off this same lot line as seen when facing the lot from the pipestem off Country View Way. Run trenches on contour towards the left (301.65') lot line.

NOTES - No trench to exceed 100 feet in length. Provide 6" - 8" diameter cleanout and cap to grade or above on septic tank.

oil KM 5-21-97

PLANS APPROVED BY Glen Savage/Donna K. Soe REVISED DATE 04/11/97

COVER NO WORK UNTIL INSPECTED AND APPROVED

NEITHER THE HOWARD COUNTY COUNCIL NOR THE HEALTH DEPARTMENT IS RESPONSIBLE FOR THE SUCCESSFUL OPERATION OF ANY SYSTEM

NOTE: CLEANOUT REQUIRED EVERY 70 FEET OF SEWER LINE AND/OR AT 90° SWEEPS IN LINES FROM HOUSE TO DRAIN FIELDS, 90° ELBOWS NOT ACCEPTABLE.

NOTE: ALL PARTS OF SEPTIC SYSTEMS (I.E. TANK, DISTRIBUTION BOX TRENCHES) TO BE 100 FEET FROM WELL (UNLESS OTHERWISE SPECIFICALLY AUTHORIZED)

NOTE: IF DEEP TRENCH(ES) ARE USED CALL FOR INSPECTION BEFORE AND AFTER PLACING GRAVEL IN TRENCH(ES)

NOTE: NO DRY WELL SHALL EXCEED 15 FOOT IN DIAMETER NO ABSORPTION TRENCH TO EXCEED 100 FEET IN LENGTH

NOTE: ALL PIPE FROM HOUSE TO SEPTIC TANK MUST BE CAST IRON OR SCHEDULE 35/40 PVC OR ABS

PERMIT VOID AFTER TWO YEARS

NOTE: INSTALL STAND PIPE ON SEPTIC TANK AND DRY WELL STAND PIPES MUST BE 6 INCHES IN DIAMETER CAST IRON, CONCRETE OR TERRA COTTA OR PVA OR ABS ACCEPTED. IF TOP OF SEPTIC TANK IS DEEPER THAN 3 FEET. MANHOLE TO GRADE REQUIRED.

NOTE: DISTRIBUTION BOXES MUST HAVE BAFFLES

***INSTALLER IS RESPONSIBLE FOR OBTAINING FINAL APPROVAL ON THIS PERMIT**


HD-260(6-90)

*CALL 461-9933 FOR INSPECTION OF SEPTIC SYSTEM.

BLDG. PERMIT SIGNED
AND RETURNED 5-14-99
Serial # B1117544
curt + Interior alterations
Basement
300129712 - Pool
8/19/01

A 35523B

Lot 7 Country View

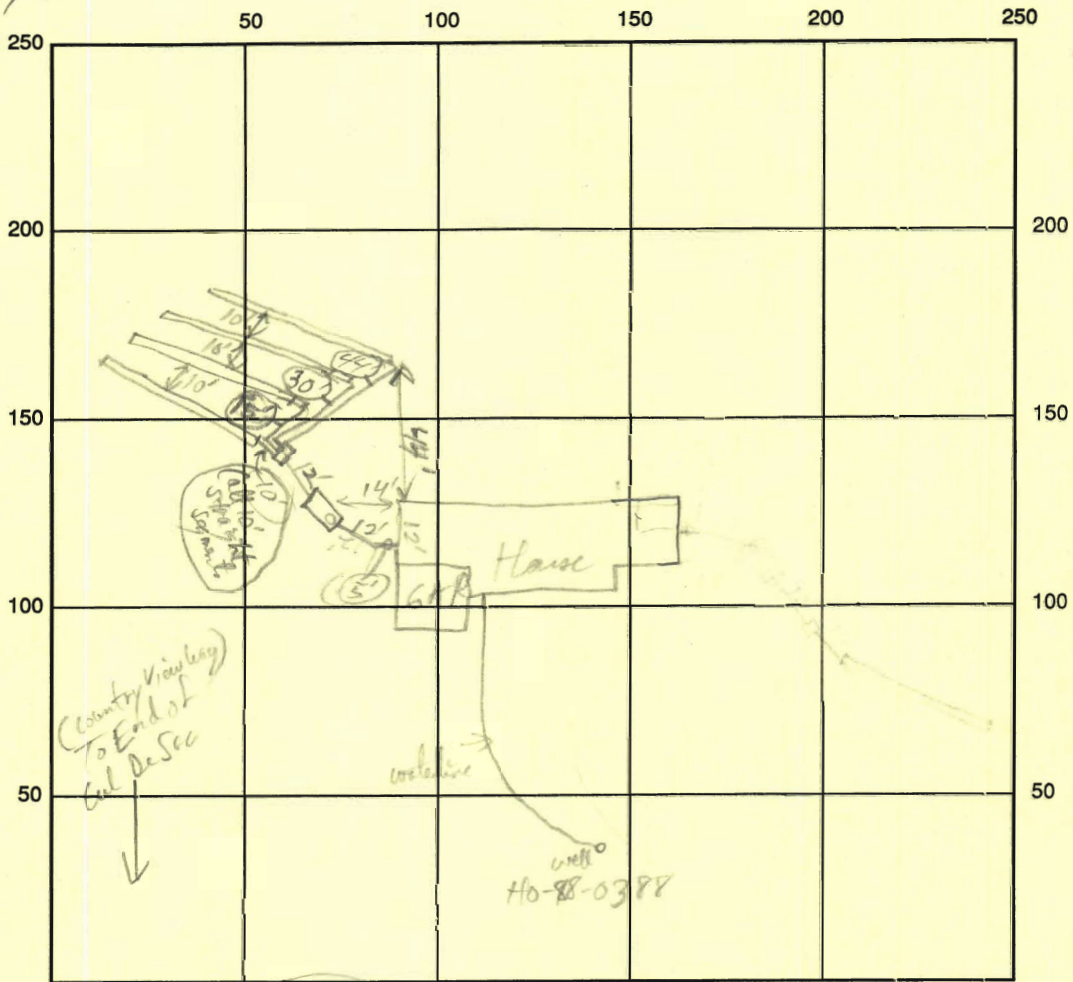

INDICATE NORTH - NAME ADJOINING ROADWAY AS BASE LINE

SEPTIC TANK LEVEL 1500 gal CLEANOUTS HSE + ST.

DISTRIBUTION BOX LEVEL OK to cover when concrete - using speed locks

DRAIN FIELD/TITLE DEPTH 5' FT. TRENCH WIDTH 3' FT. INLET DEPTH 3' FT.

EFFECTIVE GRAVEL DEPTH 2 FT. TOTAL LENGTH 70/70/70 FT. 70

NUMBER OF TRENCHES 4 ONE SIDEWALL/BOTTOM AREA 840 SQ. FT.

DRYWALL INSIDE DIAMETER _____ FT. EFFECTIVE DEPTH BELOW INLET _____ FT.

ABSORBENT AREA _____ SQ. FT.

REMARKS: Septic Tank, House Connection and Trenches and connecting pipes OK to cover (when finish)
OK to cover. Best for when pipes and lot parts are connected & leveled. HP 8/19/97

WPT - allow depth OK @ 4 ft, water line OK HP 8/19/97


DATE SYSTEM APPROVED 8/19/97 INSPECTOR [Signature]

Septic Elevations

- v. out of hse 748.4
- iv. into tank 748.1
- iv. out tank 747.8
- iv. into box 747.5
- x. elev. at box 750.5
- x. elev. at tank 752+

Scale - 1 inch = 100 ft.

- (W) proposed well
- (H) proposed house

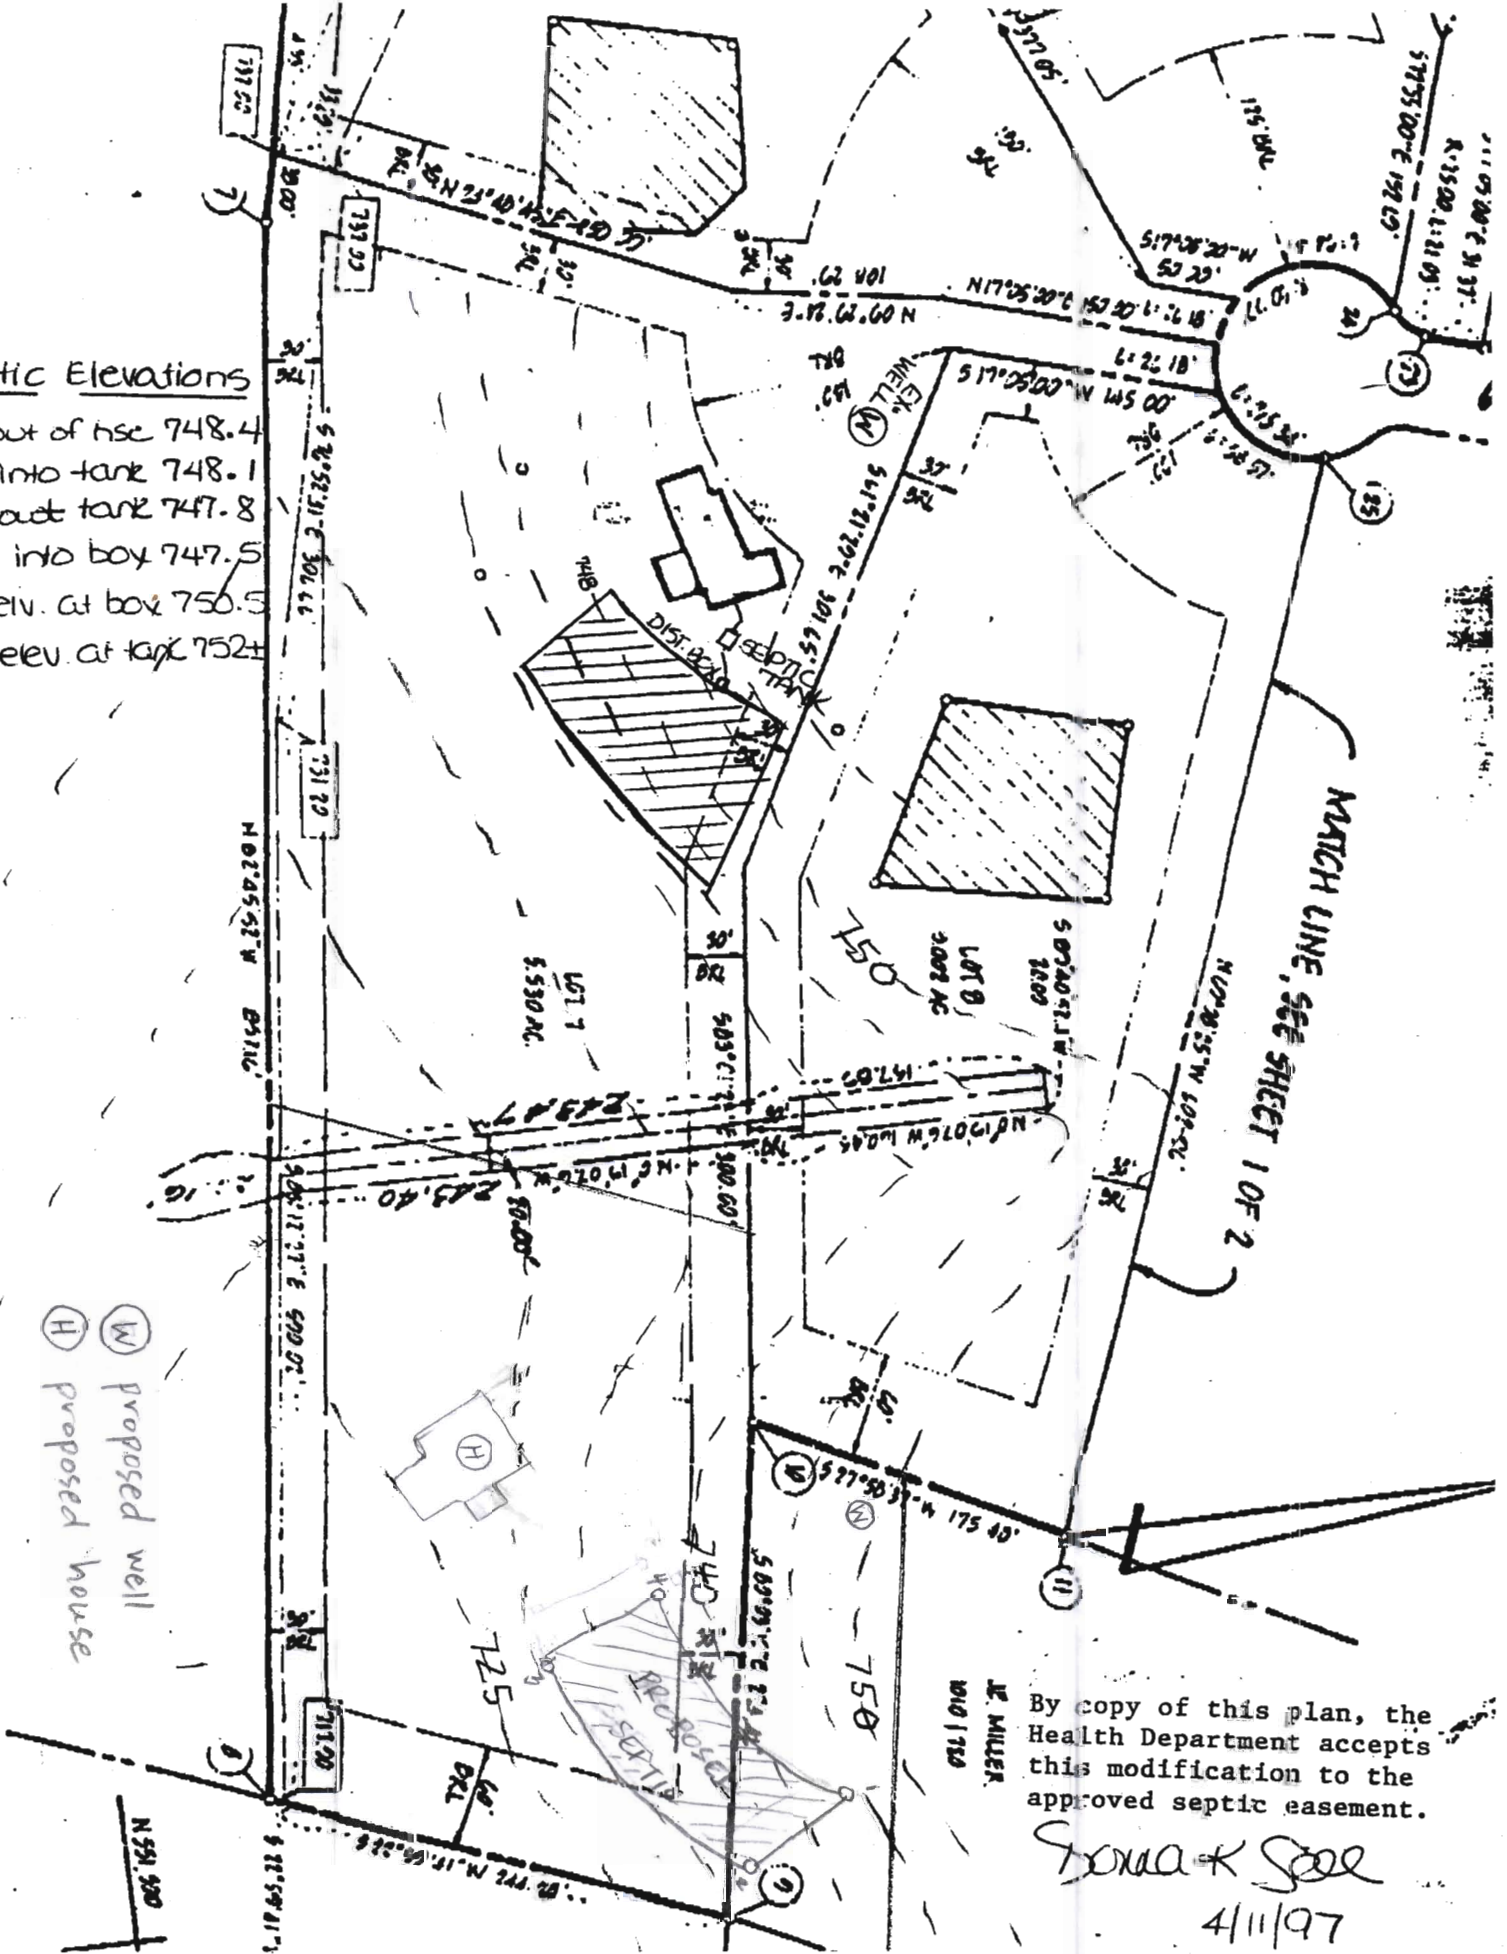

J. MILLER
DIO 1750

By copy of this plan, the Health Department accepts this modification to the approved septic easement.


Thomas K. Seel
4/11/97

Septic Elevations

- i. out of hse 748.4
- v. into tank 748.1
- v. out tank 747.8
- iv. into box 747.5
- x. elev. at box 750.5
- x. elev. at top 752+

EXISTING

- P** proposed new property line.
- H** proposed new house, *closest corner is 40 ft. from property line.
- W** proposed well

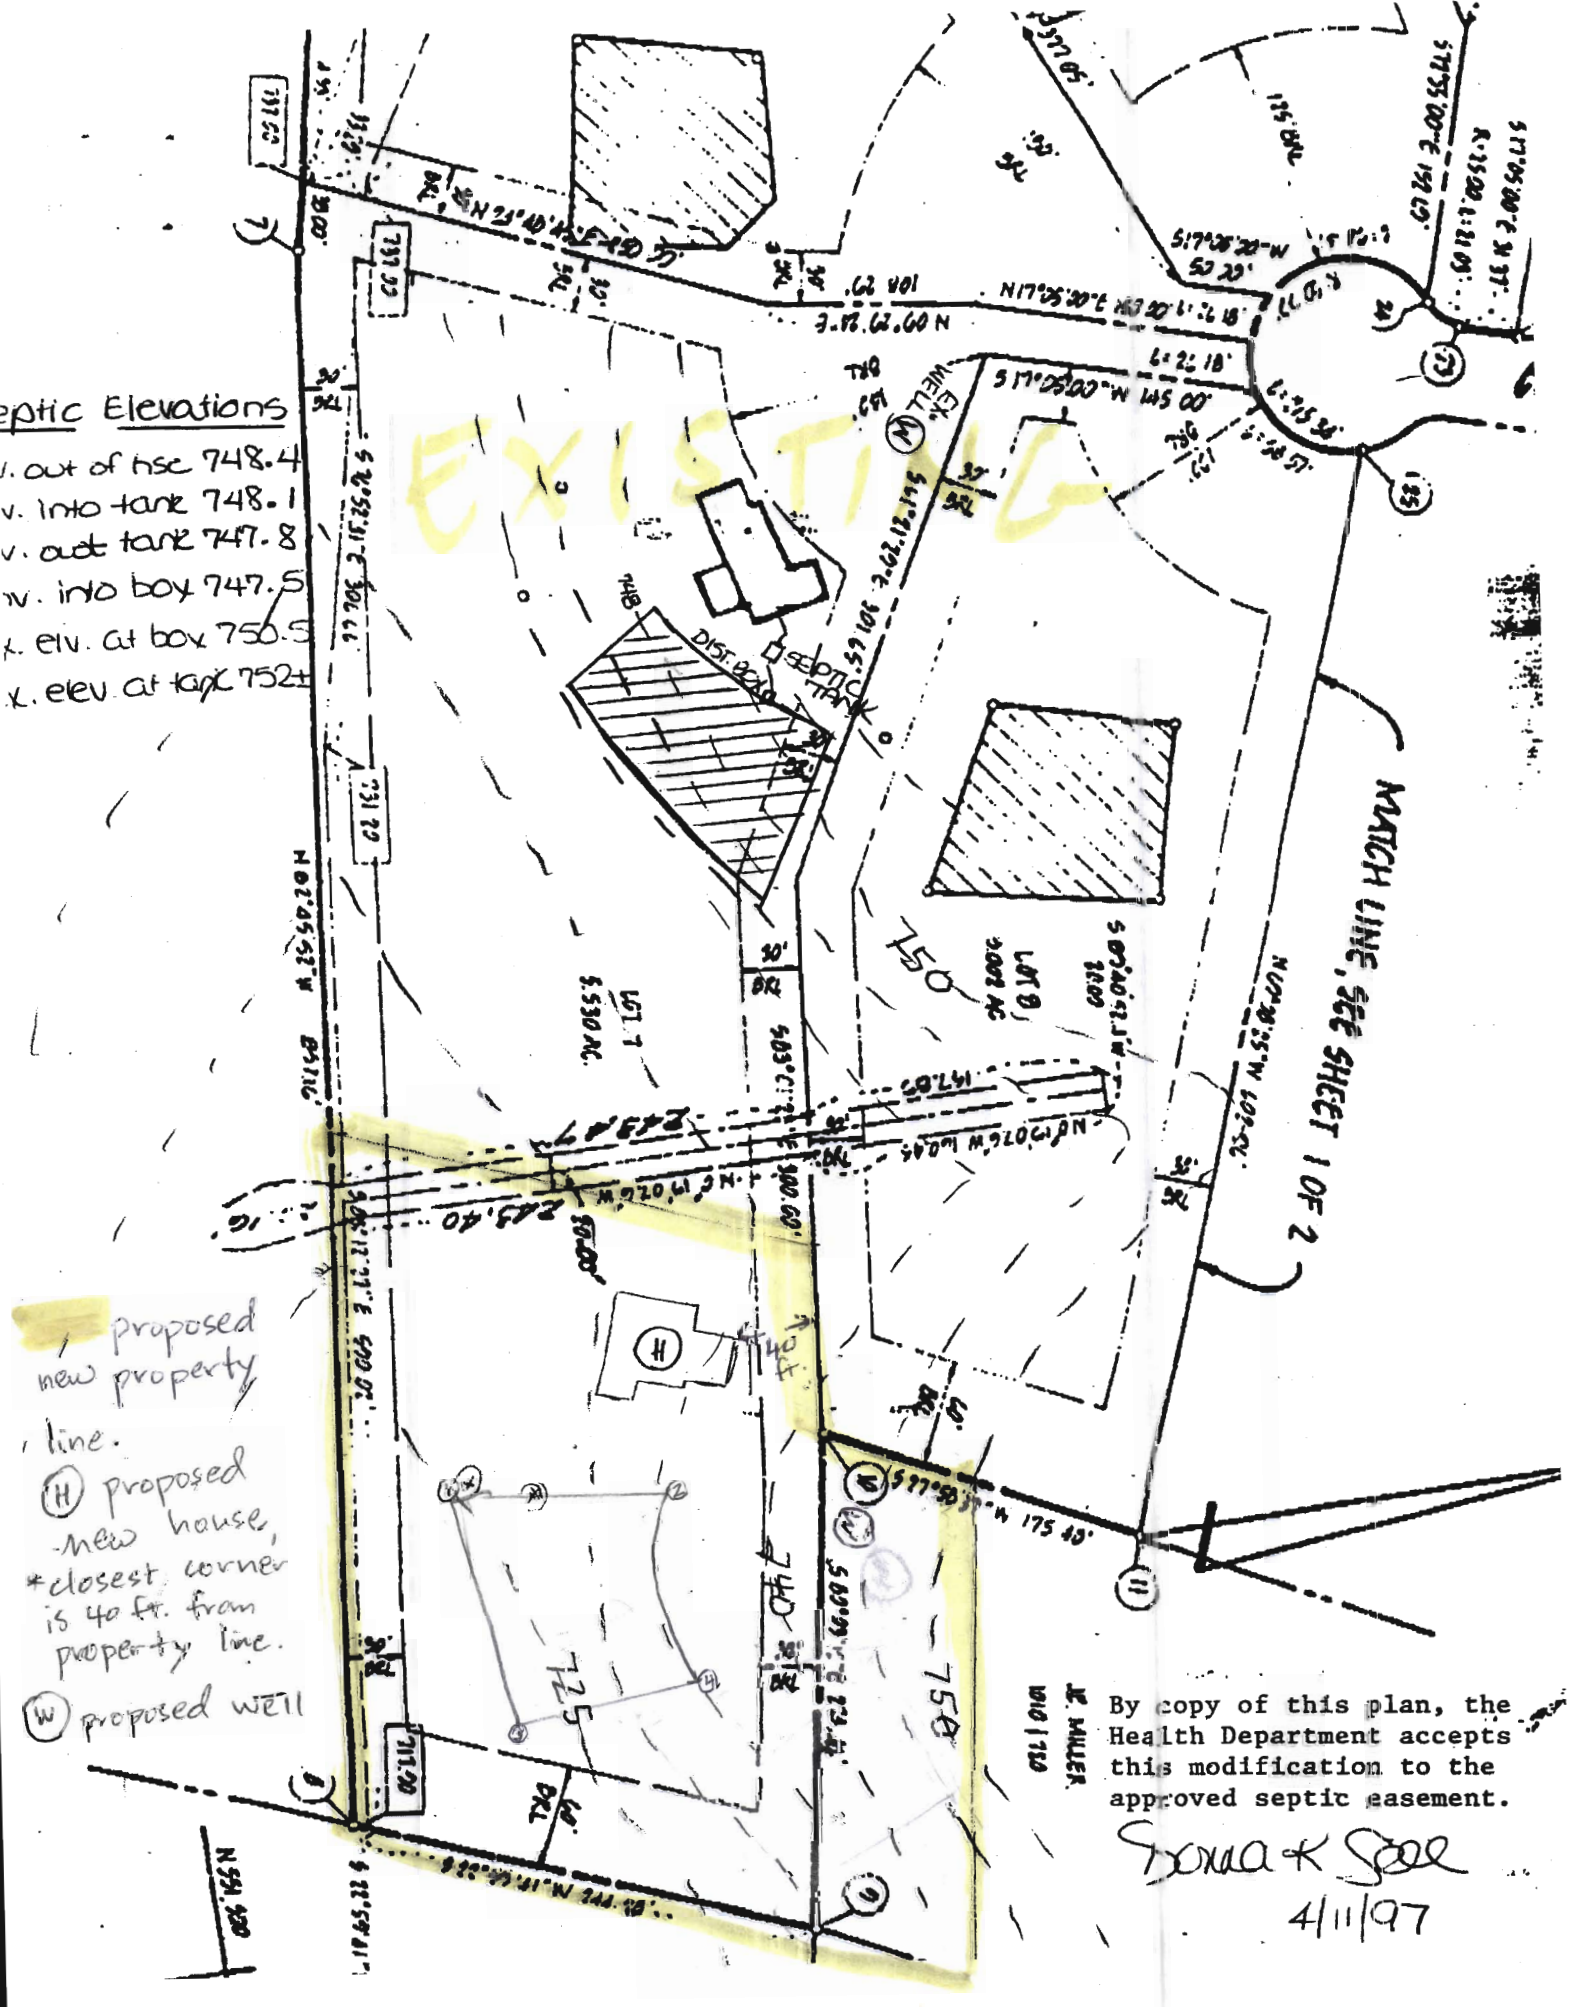

MATCH LINE, SEE SHEET 1 OF 2

By copy of this plan, the Health Department accepts this modification to the approved septic easement.

Stroma & Spool
4/11/97