

# APPLICATION

A 32936

SEWAGE DISPOSAL TESTING

STATE OF MARYLAND - DEPARTMENT OF HEALTH AND MENTAL HYGIENE

P \_\_\_\_\_

HOWARD COUNTY HEALTH DEPARTMENT  
ENVIRONMENTAL HEALTH SERVICES

P. O. BOX 476 ELLICOTT CITY, MARYLAND 21043  
TELEPHONE: 992-2330

DISTRICT \_\_\_\_\_

DATE July 5, 1983

*FEE FOR THIS LOT WHICH WAS NEVER PERC TESTED TRANSFERRED  
OVER TO HAWKES LANDING, LOT 8, ROUTE 32*

TO: THE COUNTY HEALTH OFFICER  
ELLICOTT CITY, MARYLAND

I, HEREBY, APPLY FOR THE NECESSARY TEST IN ORDER TO CONSTRUCT (OR RECONSTRUCT) A SEWAGE DISPOSAL SYSTEM.

PROPERTY OWNER Richard S. Ingle

ADDRESS 4427 Ebenezer Road PHONE \_\_\_\_\_

PROPERTY LOCATION:  
SUBDIVISION Triadelphia Woods Parcel 1 LOT NO. Lot 1 *Final Lot-4  
Sec-1*

ROAD AND DESCRIPTION Triadelphia Road

SIZE OF LOT 4.2 AC± TYPE BLDG. \_\_\_\_\_ (NUMBER OF BEDROOMS) \_\_\_\_\_

THE SYSTEM INSTALLED UNDER THIS APPLICATION IS ACCEPTABLE ONLY UNTIL PUBLIC FACILITIES BECOME AVAILABLE. I FULLY UNDERSTAND THE FEE CONNECTED WITH THE FILING OF THIS PERC TEST APPLICATION IS NON-REFUNDABLE UNDER ANY CIRCUMSTANCES. I ALSO AGREE TO COMPLY WITH ALL M.O.S.H.A. REQUIREMENTS IN TESTING THIS LOT.

*Bender Associates*  
(SIGNATURE OF APPLICANT)



APPROVED BY \_\_\_\_\_ FOR \_\_\_\_\_ DATE \_\_\_\_\_

REJECTED BY \_\_\_\_\_ FOR \_\_\_\_\_ DATE \_\_\_\_\_

HOLD PENDING FURTHER TESTS \_\_\_\_\_ DATE \_\_\_\_\_

REASONS FOR REJECTION OR HOLDING \_\_\_\_\_




# THIS IS NOT A PERMIT

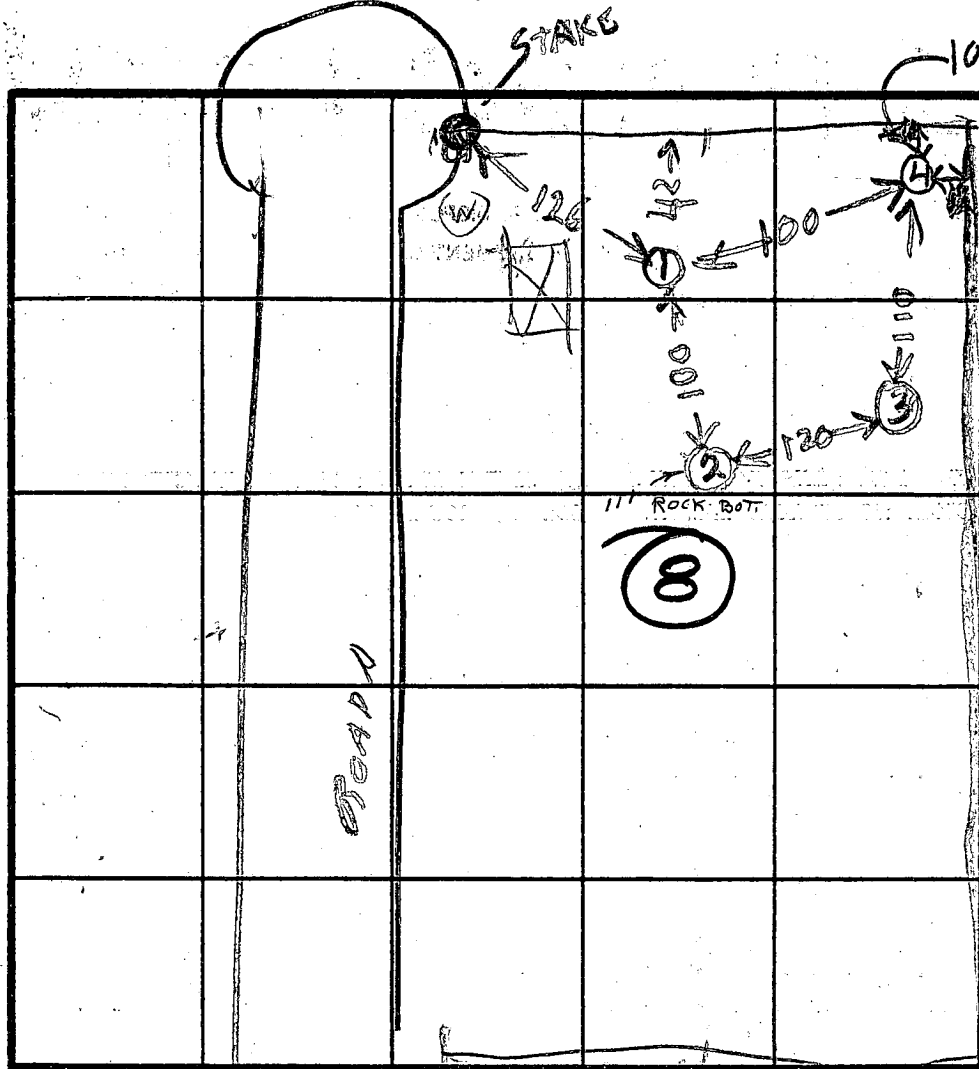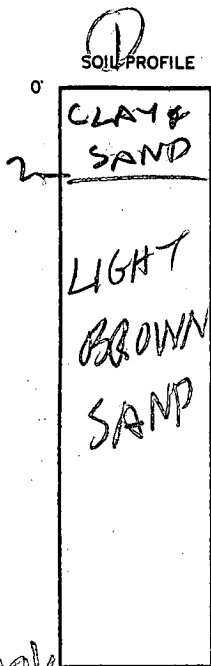

HOLE ELEVATION  
 ①④ = HIGHEST  
 ② = LOWEST  
 ③ = NEXT LOWEST  
 TRENCH BETWEEN ① & ④

$\bar{x}$  = 5 min  
 Inlet = 2.0 ft  
 Bottom = 4.0 ft  
 180 sqft/bdrm

INDICATE NORTH - NAME ADJOINING ROADWAY AS BASE LINE.

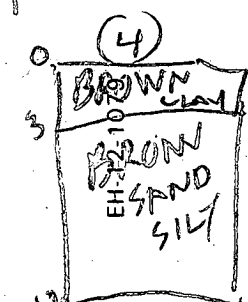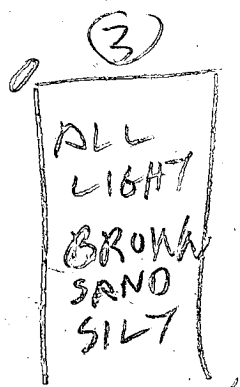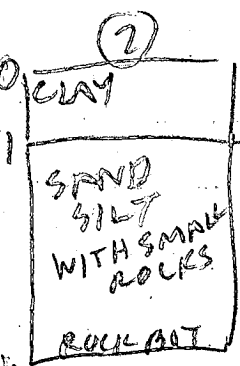

DATE	TEST NO.	DEPTH	PRE-WET		TEST - 1" DROP		TIME	
			START	STOP	START	STOP		
10/17/83	15	2 1/2	316	311	311	315	4	
	16	6	310	311	311	315	4	
10/17/83	14	12 1/2	LOOKS		OK			
	25	2	322	327	327	336	89	
	2	11	LOOKS OK EXCEPT FOR ROCK BOT.					
	35	4	330	331	337	332	1	
	3V	12	LOOKS OK					
	4V	12	LOOKS OK					

REMARKS HOLES NOT LOCATED PER PLATT TIGHT HOUSE  
 SITE POSSIBLE SYSTEM FIRST

TYPE OF SOIL \_\_\_\_\_  
 TESTED BY RHODES ALSO PRESENT FYOCK COMPANY

SCALE 1" = 100 FT