

P 50710 G

7/24/64

PERMIT

4/24/64
121

P. 0000
A. 0300

SEWAGE DISPOSAL SYSTEM

MARYLAND STATE DEPARTMENT OF HEALTH

HOWARD COUNTY

INDEXED INDEXED

ELLCOTT CITY

DISTRICT 6

DATE 7/2/64

IS PERMITTED TO INSTALL ALTER
ADDRESS Ladrol, Maryland PHONE 21 5-2211

A SEWAGE DISPOSAL SYSTEM LOCATED AT _____

SUBDIVISION Greenwood Farm ROAD 7500 Greenwood Drive 107 M. S. E. of
Woodridge Lane

PROPERTY OWNER Mr. & Mrs. Bob Stable

ADDRESS Greenwood Farm, Ellicott City, Maryland

SPECIFICATIONS 3 bedrooms - 750 gal. septic tank
1 bath - 1000 gal. septic tank
DRAIN FIELD _____ DEPTH _____ FEET. BOTTOM AREA _____ SQ. FT.

SEEPAGE RATE _____ ABSORBENT SIDE-WALL AREA _____ SQ. FT.

SEPTIC TANK CAPACITY _____ GALLONS

FOR GARBAGE BRINGER, INCREASE DISPOSAL AREA 25% & TANK CAPACITY 50%

OTHER 164 sq. ft. of tile field per bedroom located behind the house
that trenches are running across lot toward Greenwood Farm and
Woodridge Lane.

PLANS APPROVED BY J. Hamilton DATE 5/5/64

FILL SEPTIC TANK AND DISTRIBUTION BOX WITH WATER BEFORE CALLING FOR AN INSPECTION. COVER NO WORK UNTIL INSPECTED AND APPROVED.

NEITHER THE HOWARD COUNTY COMMISSIONERS NOR THE HEALTH DEPARTMENT IS RESPONSIBLE FOR THE SUCCESSFUL OPERATION OF ANY SYSTEM.

BLDG. PERMIT SIGNED
AND RETURNED 4/4/64
Serial # 53,341
prl-ctt. 42.000


BLDG. PERMIT SIGNED
AND RETURNED 3/24/64
Serial # 43067. decl

A 0300

P 50710-G

164
172
210
20

164
756

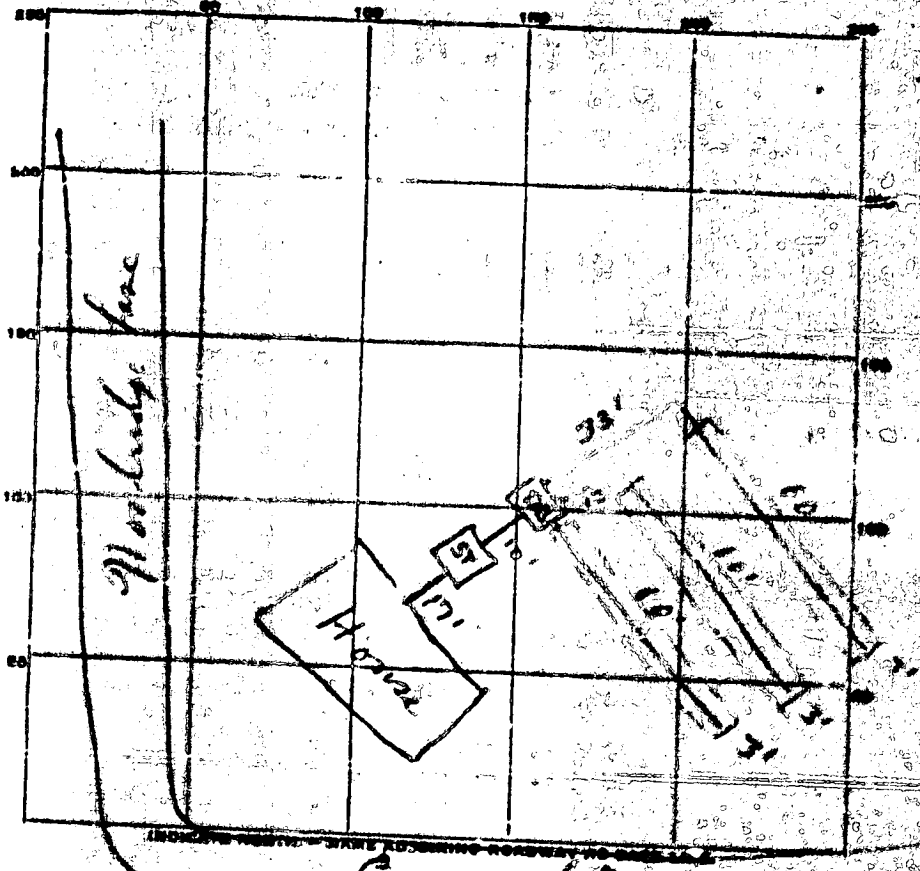

PERMIT CARD OK Crenwood Da.

SEPTIC TANK, LEVEL OK CLEANOUTS OK

DISTRIBUTION BOX, LEVEL OK

TILE FIELD, DEPTH 2 1/2 FT. TRENCH WIDTH 3 FT.

GRAVEL DEPTH 12 IN. TOTAL LENGTH 180 FT.

NUMBER OF TRENCHES 3 TOTAL BOTTOM AREA 540 sq. ft.

SEEPAGE PITS, INSIDE DIAMETER _____ FT. DEPTH BELOW INLET _____ FT.

ABSORBENT AREA _____ SQ. FT.

REMARKS _____

SYSTEM APPROVED 7/24/64 INSPECTOR K. P. [Signature]

(State Dept. of Health) A 03642

APPLICATION

A 03642
P _____

SEWAGE DISPOSAL TESTING

MARYLAND STATE DEPARTMENT OF HEALTH

HOWARD COUNTY

ELLICOTT CITY

DISTRICT 6

DATE 4-28-61

*164 sq. ft. of tile field for tile
located behind the house as
tile trenches are running across
lot toward Greenwood Drive and
Woodridge Lane.*

TO: THE COUNTY HEALTH OFFICER
ELLICOTT CITY, MARYLAND

*750 gal. - 3 bedrooms
1000 gal. - 4 bedrooms*

I HEREBY APPLY FOR THE NECESSARY TESTS IN ORDER TO CONSTRUCT OR RECONSTRUCT A SEWAGE DISPOSAL SYSTEM.

PROPERTY OWNER Greenwood Farms, Inc.

ADDRESS No. W. A. Benjamin, Cedar Lane, Ednor, Md. PHONE 4-4779

PROPERTY LOCATION _____

SUBDIVISION Greenwood Farms LOT NO. 24, Sec. 3

ROAD AND DESCRIPTION corner of Greenwood Drive and Woodridge Lane

OCCUPANT _____ PHONE _____

PERSON TO CONSTRUCT SYSTEM TEP PHONE _____

ADDRESS _____ PHONE _____

SIZE OF LOT 210 ft. square TYPE BLDG. UNKNOWN

IF NOT SINGLE RESIDENCE DESCRIBE _____

SIGNATURE OF APPLICANT Greenwood Farms Inc. by GWR Bacon


APPROVED BY J. Hennigan FOR Tile field DATE 5-3-61

REJECTED BY _____ FOR _____ DATE _____

HOLD PENDING FURTHER TESTS _____ DATE _____

REASONS FOR REJECTION OR HOLDING _____

THIS IS NOT A PERMIT

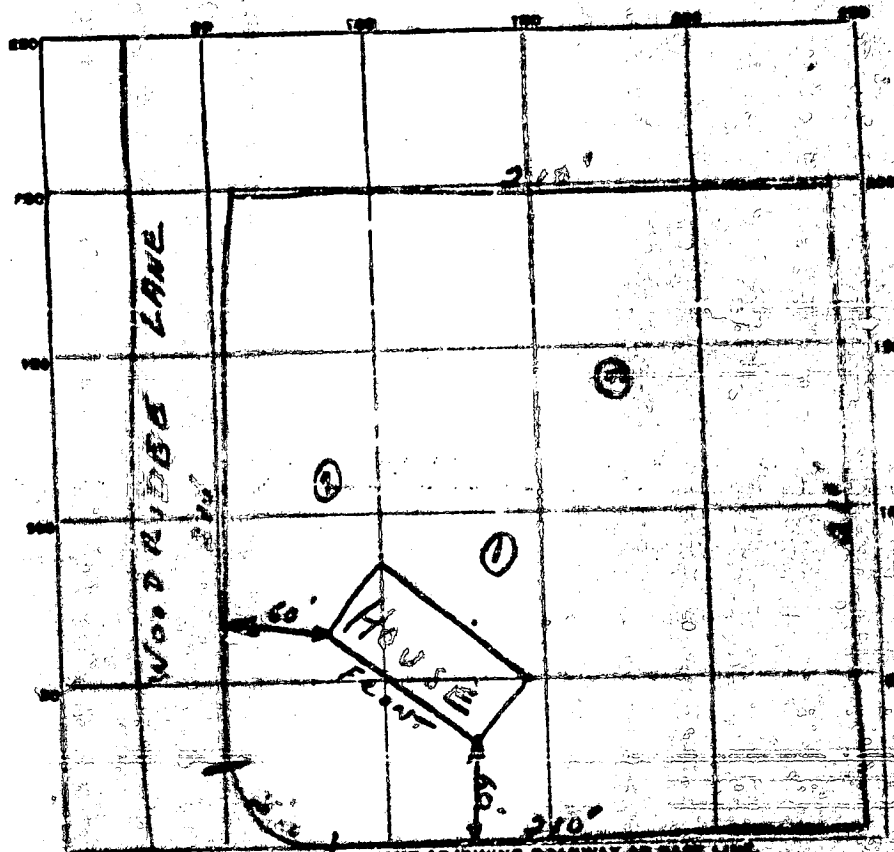

GREENWOOD DRIVE

DATE	TEST NO.	DEPTH	PRE-WAY		TEST - 1" DROP		TIME
			START	STOP	START	STOP	
5-3-61	1	3FT	9:57	10:24	10:24		overturn
	2		9:58	10:06	10:06	10:16	10 minutes
	3		10:12	10:33	10:33	11:02	29 minutes

SOIL AUGER FINDING

TESTED BY *J. Henry*

REMARKS
5-3-61 *W. B. Benjamin*

LOT NO. *H-See 3*

A03641

PLAT BOOK S NO. 88

7526 1 Story Brick w/ L.L.




LOCATION OF HOUSE
LOT 24 BLOCK
SECTION THREE

GREENWOOD FARMS

ELECTION DISTRICT
HOWARD COUNTY, MARYLAND

SP # 53241

Section Four
23
Plot Book 7, PNO. 3
Proposed addition
no impact to

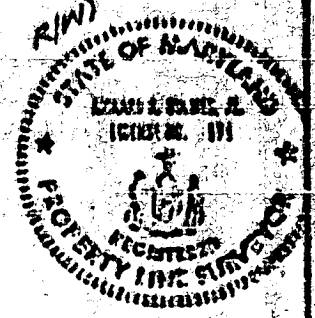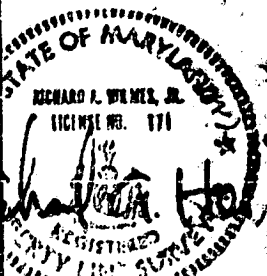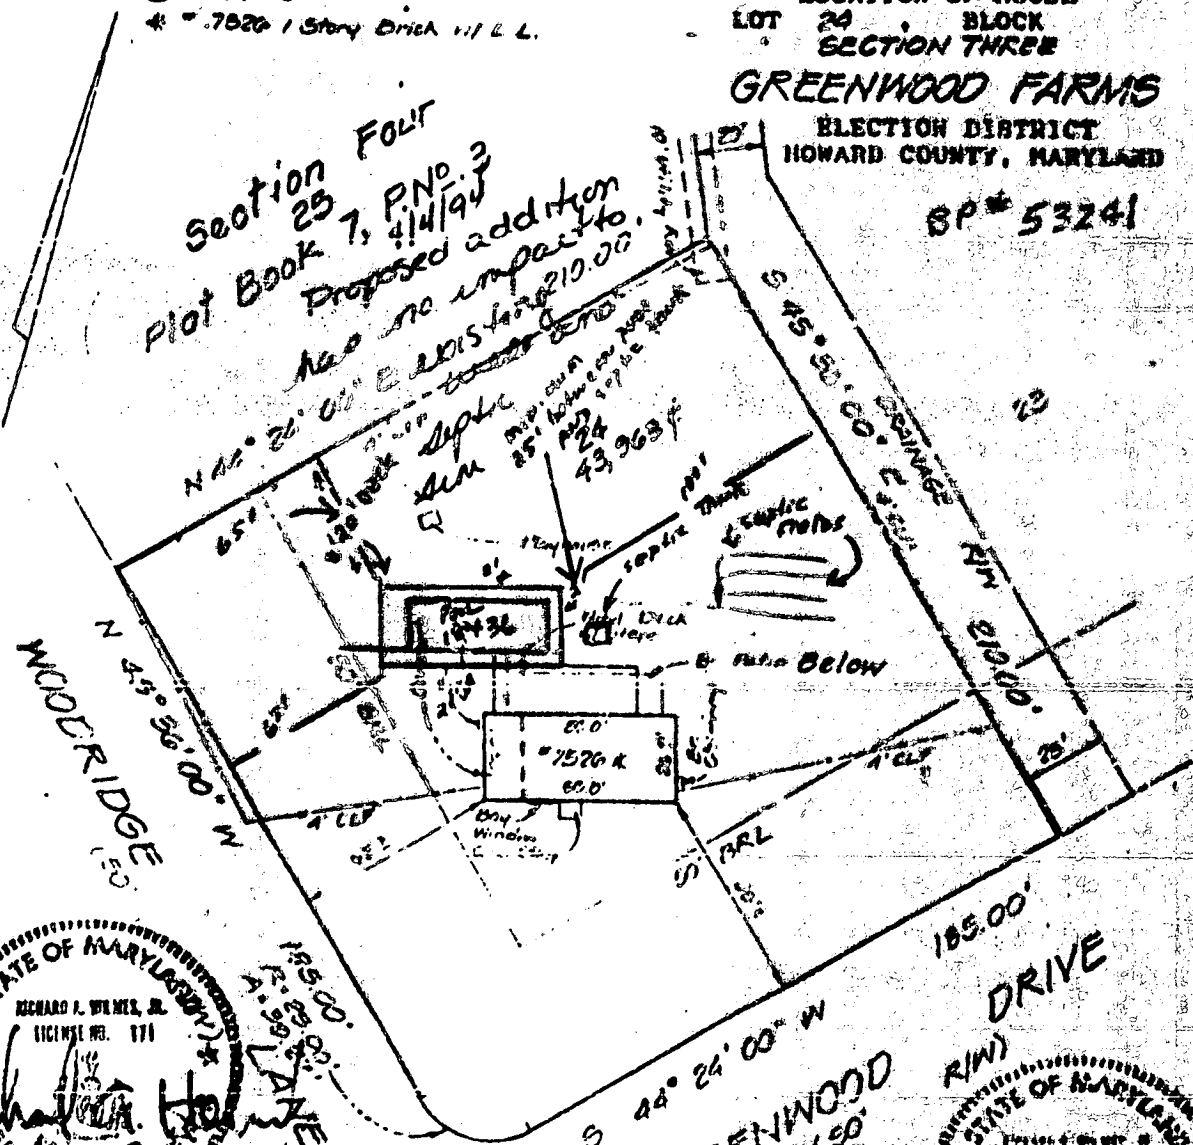

SURVEYOR'S CERTIFICATE
I HEREBY CERTIFY TO THE BEST OF MY INFORMATION, KNOWLEDGE
AND BELIEF THAT THE PLAN SHOWN HEREON IS CORRECT.
DATE: 11-9-93
RICHARD A. HOLMAN, JR.
REGISTERED PROFESSIONAL LAND SURVEYOR
MARYLAND NO. 171

NOTES
1. THIS PLAN WAS PREPARED WITHOUT THE BENEFIT OF A TITLE REPORT THAT MAY REVEAL ADDITIONAL CONVEYANCES, EASEMENTS, RIGHTS OF WAY AND/OR ENCUMBRANCES.
2. THIS PLAN IS NOT TO BE USED FOR DETERMINING PROPERTY LINES AND SHOULD NOT BE USED FOR LOCATING OR PLACING ADDITIONAL IMPROVEMENTS.
3. THE SITE DOES NOT LIE WITHIN A 100 YEAR FLOOD PLAIN, ACCORDING TO FLOOD INSURANCE RATE MAP, COMMUNITY PANEL NO. 240064 0037 B, MAP REVISED 10-4-83

PRECISION SURVEYING AND CONSULTING SERVICES
407 NIAGARA ROAD SUITE 107
COLLIER PARK, MARYLAND 20740-9906
(301) 474-8808 FAX (301) 474-8807

DRAWN BY RTA	CHECKED BY RAN	RECORD NO. F92013
SCALE 1"=50'		DWG NO. N-005-A
DATE Nov, 1993		NO. 4035

HOWARD COUNTY DEPARTMENT OF PLANNING AND ZONING
Division of Land Development

DATE: 8/24/00

P&Z File No. F-00-1860

Department of Planning and Zoning

- Transportation Planning
- Historic Preservation
- Comprehensive Planning and Zoning Administration
- Research
- Address Coordinator

- Agricultural Preservation
- Development Engineering Division
- Forest Conservation Planner
- File

Agencies

- Soil Conservation District
- Department of Inspections, Licenses & Permits
- Department of Fire and Rescue Services
- State Highway Administration
- Bureau of Environmental Health
- Board of Education
- Recreation and Parks

- Tax Assessment
- Bell Atlantic Telephone
- BG&E
- Cable TV
- Police
- MTA
- Finance
- DPW, Real Estate Services
- DPW, Construction and Inspection
- DPW, Bureau of Utilities

RE: Plat of Revision Greenwood Farms

ENCLOSED FOR YOUR THE ENCLOSED → Signature Approval Review & Comments Files
 → Original

<u>Plans</u>	<u># of Sheets</u>	<u>Supplemental Documents</u>
<input type="checkbox"/> Sketch Plan	<input type="checkbox"/>	<input type="checkbox"/> Wetlands Report
<input type="checkbox"/> Prel Equiv Sketch Plan	<input type="checkbox"/>	<input type="checkbox"/> Soils/Topo Map/Drain Area Map
<input type="checkbox"/> Preliminary Plan	<input type="checkbox"/>	<input type="checkbox"/> FSD/FCP/Worksheet and Application
<input type="checkbox"/> Final Plat	<input type="checkbox"/>	<input type="checkbox"/> Declaration of Intent
<input type="checkbox"/> Final Constr Plans (RDS)	<input type="checkbox"/>	<input type="checkbox"/> Drainage and/or Computation/Pond Safety Comps
<input type="checkbox"/> Final Development Plan	<input type="checkbox"/>	<input type="checkbox"/> Preliminary Road Profiles
<input type="checkbox"/> Site Development Plan	<input type="checkbox"/>	<input type="checkbox"/> APFO Roads Test/Mitigation Plan
<input type="checkbox"/> Landscape Plan	<input type="checkbox"/>	<input type="checkbox"/> Traffic Study/Noise Study
<input type="checkbox"/> Grading Plan	<input type="checkbox"/>	<input type="checkbox"/> Sight Distance Analysis
<input type="checkbox"/> House Type Revision Plan	<input type="checkbox"/>	<input type="checkbox"/> Floodplain Study
<input type="checkbox"/> Water and Sewer Plan	<input type="checkbox"/>	<input type="checkbox"/> Stormwater Management Comps.
Applications		<input type="checkbox"/> Industrial Waste Survey (DPW)
<input type="checkbox"/> Waiver Petition Applic/Exhibit	<input type="checkbox"/>	<input type="checkbox"/> Road Poster Form Letter
<input type="checkbox"/> Planning Board Applic	<input type="checkbox"/>	<input type="checkbox"/> Response Letter
<input type="checkbox"/> ASDP/CSDP Application	<input type="checkbox"/>	<input type="checkbox"/> Perc Plat
<input type="checkbox"/> DED Application/Checklist	<input type="checkbox"/>	<input type="checkbox"/> Scenic Road Exhibits
<input type="checkbox"/> DED Fee Receipt/Deeds/Cost Estimate	<input type="checkbox"/>	

WAS: Received Tentatively Approved Recorded
 Received and Revised Approved On 7/26/00

COMMENTS: _____ SRC/COMMENTS DUE BY: _____

Check, initial and return to the Department of Planning and Zoning if plan is approved with no comments.

COORDINATE TABLE

POINT No.	NORTH	EAST
1	11,828.0822	10,592.9618
2	11,681.1529	10,743.0010
3	11,548.9754	10,613.5633
4	11,548.6052	10,578.2099
5	11,678.0429	10,446.0325

COORDINATE DATUM PER "MAP OF GREENWOOD FARMS, SECTION FOUR" RECORD PLAT, RECORDED IN PLAT BOOK 7, PLAT No 3.

WE FURTHER CERTIFY THAT THE REQUIREMENTS OF SECTION 3-108, THE REAL PROPERTY ARTICLE, ANNOTATED CODE OF MARYLAND, 1988 REPLACEMENT VOLUME (AS SUPPLEMENTED) AS FAR AS THEY RELATE TO THE MAKING OF THIS PLAT AND THE SETTING OF MARKERS HAVE BEEN COMPLIED WITH.

Robert Strahle 6-20-2000
 ROBERT STRAHLE DATE

Pamela Strahle 6-20-2000
 PAMELA STRAHLE DATE

Richard A. Holmes, Jr. 6-20-2000
 RICHARD A. HOLMES, JR. DATE

AREA TABULATION

TOTAL NUMBER OF LOTS AND/OR PARCELS TO BE RECORDED = 1
 BUILDABLE = 1
 NON-BUILDABLE = 0
 OPEN SPACE = 0
 PRESERVATION PARCELS = 0

TOTAL AREA OF LOTS AND/OR PARCELS TO BE RECORDED
 = 43,966 SQUARE FEET OR 1.00932 ACRES
 BUILDABLE = 43,966 SQUARE FEET OR 1.00932 ACRES
 NON-BUILDABLE = 0
 OPEN SPACE = 0
 PRESERVATION PARCELS = 0

TOTAL AREA OF ROAD RIGHT-OF-WAY TO BE RECORDED INCLUDING WIDENING STRIPS = 0 SQUARE FEET OR 0.00000 ACRES

TOTAL AREA OF SUBDIVISION TO BE RECORDED
 = 43,966 SQUARE FEET OR 1.00932 ACRES

APPROVED: HOWARD COUNTY DEPARTMENT OF PLANNING AND ZONING

John P. ... 7/17/00
 Chief, Development Engineering Division Date

Joseph ... 7/29/00
 Director Date

APPROVED: FOR PRIVATE WATER AND PRIVATE SEWERAGE SYSTEMS

Dina ... 7/11/00
 Howard County Health Officer Date

OWNER'S CERTIFICATE

WE, ROBERT STRAHLE AND PAMELA STRAHLE, OWNERS OF THE PROPERTY SHOWN AND DESCRIBED HEREON, HEREBY ADOPT THIS PLAN OF SUBDIVISION, AND IN CONSIDERATION OF THE APPROVAL OF THIS PLAT BY THE DEPARTMENT OF PLANNING AND ZONING, ESTABLISH MINIMUM BUILDING RESTRICTION LINES. ALL EASEMENTS OR RIGHTS-OF-WAY AFFECTING THE PROPERTY ARE INCLUDED IN THIS PLAN OF SUBDIVISION.

WITNESS OUR HANDS THIS 20TH DAY OF JUNE, 2000.

Robert Strahle
 ROBERT STRAHLE

Pamela Strahle
 PAMELA STRAHLE

ENGINEER / SURVEYOR

PRECISION SURVEYING AND CONSULTING SERVICES, INC.

3033 NUTWOOD LANE, SUITE 102
 BOWIE, MARYLAND 20716
 TELEPHONE: (301) 390-5610
 TELECOPIER: (301) 249-9360

SURVEYOR'S CERTIFICATE

I HEREBY CERTIFY THAT THE FINAL PLAT SHOWN HEREON IS CORRECT; THAT IT IS A SUBDIVISION OF ALL OF THE LANDS CONVEYED BY KENNETH E. LADD AND JACQUELINE D. LADD, HIS WIFE, TO ROBERT STRAHLE AND PAMELA STRAHLE, HIS WIFE, BY DEED DATED SEPTEMBER 1, 1976, AND RECORDED AMONG THE LAND RECORDS OF HOWARD COUNTY, IN LIBER 791 AT FOLIO 568; AND THAT ALL MONUMENTS ARE IN PLACE OR WILL BE IN PLACE PRIOR TO THE ACCEPTANCE OF THE STREETS IN THE SUBDIVISION, BY HOWARD COUNTY, AS SHOWN, IN ACCORDANCE WITH THE ANNOTATED CODE OF MARYLAND, AS AMENDED.

JUNE 12, 2000
Richard A. Holmes, Jr.
 RICHARD A. HOLMES, JR.
 REGISTERED PROPERTY LINE SURVEYOR
 MARYLAND NO. 171


RECORDED AS PLAT NO. 14339
 ON 7-26-00, AMONG THE LAND RECORDS OF HOWARD COUNTY, MARYLAND

**PLAT OF REVISION
 GREENWOOD FARMS
 LOT 24, SECTION THREE**

TAX MAP 40, GRID 18, PARCEL 157
 5TH ELECTION DISTRICT
 HOWARD COUNTY, MARYLAND
 SCALE: 1" = 50' JUNE, 2000
 SHEET 1 OF 1

GENERAL NOTES

1. THE SUBJECT PROPERTY IS ZONED RRDEO, PER 10/18/93 COMPREHENSIVE ZONING PLAN.
 2. B.R.L. DESIGNATES BUILDING RESTRICTION LINE.
 3. NO CEMETERIES OR BURIAL SITES WERE OBSERVED ON THE SUBJECT LOT.
 4. THERE ARE NO HISTORIC SITES ON OR ADJACENT TO THE SUBJECT LOT.
 5. THE EXISTING DWELLING ON LOT 24 IS TO REMAIN.
 6. NO NEW BUILDINGS OR ADDITIONS TO THE EXISTING DWELLING ARE TO BE CONSTRUCTED AT A DISTANCE LESS THAN THE ZONING REGULATIONS ALLOW.
 7. NO FLOODPLAINS, WETLANDS OR STREAMS WERE OBSERVED ON THE SUBJECT LOT.
 8. DEED REFERENCE: LIBER 791 AT FOLIO 568.
 9. THIS PLAT WAS PREPARED WITHOUT THE BENEFIT OF A TITLE INSURANCE POLICY, TITLE INSURANCE COMMITMENT OR TITLE REPORT.
 10. THIS PLAT IS IN THE BEARING DATUM OF THE ORIGINAL PLAT OF SUBDIVISION RECORDED IN PLAT BOOK 5, AS PLAT NUMBER 88.
 11. IRON ROD OR IRON PIPE SHOWN THUS: —○—
 12. THIS PLAT IS BASED UPON A FIELD RUN, MONUMENTED SURVEY PERFORMED ON JUNE 8, 2000, BY PRECISION SURVEYING AND CONSULTING SERVICES, INC.
 13. THIS SUBDIVISION PLAT IS EXEMPT FROM THE REQUIREMENTS OF THE FOREST CONSERVATION ACT BECAUSE PLAT CORRECTIONS ARE EXEMPT PER SECTION 16.1202 (b) (1) (vii) OF THE HOWARD COUNTY CODE.
- THE PURPOSE OF THIS PLAT IS TO UPDATE THE BUILDING RESTRICTION LINES FOR LOT 24 IN ACCORDANCE WITH THE CURRENT ZONING ORDINANCE.

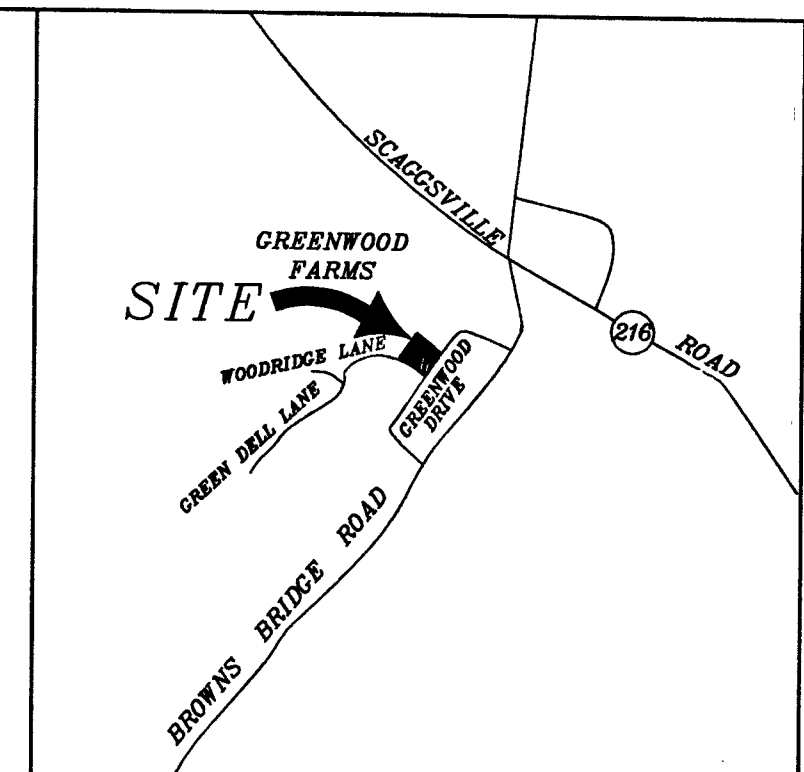

VICINITY MAP
 SCALE: 1" = 2000'

PLAT NO. 14339

OWNERS:


MR. AND MRS. ROBERT W. STRAHLE
#7526 GREENWOOD DRIVE
HIGHLAND, MARYLAND 20777-9562

EXISTING ABOVE-GROUND
POOL NOT SHOWN

SITE PLAN
LOT 24, SECTION THREE
GREENWOOD FARMS
5TH ELECTION DISTRICT
HOWARD COUNTY, MARYLAND

"GREENWOOD FARMS"
SECTION FOUR
PLAT BOOK 7, PLAT No 3
25

"GREENWOOD FARMS"
SECTION THREE
PLAT BOOK 5, PLAT No 88
23

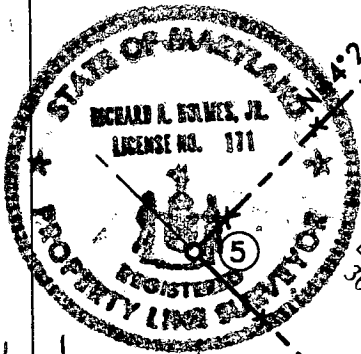

EXISTING 10' UTILITY RIGHT-OF-WAY
PLAT BOOK 5, PLAT No 88

EXISTING DRAINAGE RIGHT-OF-WAY
PLAT BOOK 5, PLAT No 88

LOT 24
23,966 SQ. FT.

EXISTING CHAIN LINK FENCE
210.00'
30' B.R.L.

EXISTING SEPTIC AREA

PROPOSED GARAGE

EXISTING WOOD DECK
WITH WOOD STEPS

EXISTING CARPORT
EXISTING 1 STORY BRICK
WITH LOWER LEVEL

EXISTING WELL

2/27/07 T/C w/OWNER
HE REPORTS
UNHEATED
LOFT OVER
GARAGE, AND
EX. CARPORT TO
REMAIN AS IS -
NO IMPACT TO WELL
OR SEPTIC

WOODRIDGE LANE
(30' PUBLIC RIGHT-OF-WAY)
PLAT BOOK 5, PLAT No 88

GREENWOOD DRIVE
(30' PUBLIC RIGHT-OF-WAY)
PLAT BOOK 5, PLAT No 88

PLAT BOOK 5, PLAT No. 88 DATUM

SURVEYOR'S CERTIFICATE

I HEREBY CERTIFY TO THE BEST OF MY INFORMATION,
KNOWLEDGE AND BELIEF THAT THE SURVEY SHOWN
HEREON IS CORRECT.

8-1-2000 *Richard G. Holm*

DATE RICHARD A. HOLMES, JR.
REGISTERED PROPERTY LINE SURVEYOR
MARYLAND NO. 171

1. THIS SURVEY WAS PREPARED WITHOUT THE BENEFIT OF A TITLE REPORT THAT MAY REVEAL ADDITIONAL CONVEYANCES, EASEMENTS, RIGHTS-OF-WAY, AND/OR ENCUMBRANCES.
2. THE SUBJECT PROPERTY IS ZONED RRDEO.
3. DEED REFERENCE: LIBER 791, FOLIO 568.
4. THIS SITE DOES NOT LIE WITHIN A 100-YEAR FLOOD PLAIN (ZONE A3), ACCORDING TO FLOOD INSURANCE RATE MAP, COMMUNITY - PANEL NO. 240044 0037 B, EFFECTIVE DATE: DECEMBER 4, 1986.

PRECISION SURVEYING AND CONSULTING SERVICES, INC.

3033 NUTWOOD LANE, SUITE 102, BOWIE, MARYLAND 20716
TELEPHONE #: (301) 390-5610 TELECOPIER #: (301) 249-9360

Building Address 1526 GREENWOOD DR.
Highland md. 20777
 Suite/Apt. #: _____ SDP/WP/Petition #: _____
 Gensus Tract 1111 Subdivision Greenwood Farms
 Section 3 Area _____ Lot 24
 Tax Map 10 Parcel 157 Grid 11
 Zoning R11 Map Coordinates _____ Lot size _____

Property Owner's Name ROBERT W. STRAHLE
 Address 7526 GREENWOOD DR.
 City Highland State MD Zip Code 20777
 Home Phone 301-854-2507 Work Phone 301-370-1976
 Applicant's Name & Mailing Address, (if other than stated hereon): _____
 Phone _____ Fax 301-854-2159

Existing Use Structure
 Proposed Use _____
 Estimated Construction Cost \$ 25,000.00
 Description of Work CONSTRUCT A TWO CAR ATTACHED GARAGE WITH LOFT.

Contractor Company OWNER
 Contact Person _____
 Address _____
 City _____ State _____ Zip Code _____
 License No. _____
 Phone _____ Fax _____

Occupant or Tenant Self employed Contractor
 Contact Name OWNER
 Address 1526 GREENWOOD DR
 City Highland State MD Zip Code 20777
 Phone 301-854-2507 Fax 301-854-2159

Engineer or Architect Company PRECISION SURVEYING
 Contact Person Richard Holmes
 Address 3033 MITCHELL LANE Suite 101
 City Bowie State MD Zip Code 20716
 Phone 301-390-5610 Fax 301-249-9360

BUILDING DESCRIPTION - COMMERCIAL

BUILDING DESCRIPTION - RESIDENTIAL

Building Characteristics	Utilities
Height: <u>20 FT</u>	Water Supply: _____ <input type="checkbox"/> Public <input checked="" type="checkbox"/> Private
No. of stories: <u>2</u>	Sewage Disposal: _____ <input checked="" type="checkbox"/> Public <input type="checkbox"/> Private
Gross area, sq. ft. per floor: <u>600</u>	Electric Yes <input checked="" type="checkbox"/> No <input type="checkbox"/> Gas Yes <input checked="" type="checkbox"/> No <input type="checkbox"/>
Use group: _____	Heating System: _____ <input type="checkbox"/> Electric <input type="checkbox"/> Oil <input checked="" type="checkbox"/> <input type="checkbox"/> Natural Gas <input type="checkbox"/> Propane Gas <input type="checkbox"/>
Construction type: <input checked="" type="checkbox"/> Reinforced Concrete <input checked="" type="checkbox"/> Structural Steel <input type="checkbox"/> Masonry <input checked="" type="checkbox"/> Wood Frame	Sprinkler system: <u>N/A</u> <input checked="" type="checkbox"/> <input type="checkbox"/> Full <input type="checkbox"/> Partial <input type="checkbox"/> Other Suppression <input type="checkbox"/> # of Heads
_____ State Certified Modular	

Building Characteristics	Utilities
SF Dwelling <input checked="" type="checkbox"/> SF Townhouse <input type="checkbox"/> Depth _____ Width _____	Water Supply: _____ <input type="checkbox"/> Public <input checked="" type="checkbox"/> Private
1st floor: <u>24x30</u> 2nd floor: " "	Sewage Disposal: _____ <input checked="" type="checkbox"/> Public <input type="checkbox"/> Private
Basement: _____ Finished Basement <input type="checkbox"/> Unfinished Basement <input type="checkbox"/> Crawlspace <input type="checkbox"/> Slab on Grade <input type="checkbox"/> No. of Bedrooms _____	Electric Yes <input checked="" type="checkbox"/> No <input type="checkbox"/> Gas Yes <input type="checkbox"/> No <input checked="" type="checkbox"/>
Multi-family dwellings: No. of efficiency units: _____ No. of 1 BR units: _____ No. of 2 BR units: _____ No. of 3 BR units: _____	Heating System: _____ <input type="checkbox"/> Electric <input type="checkbox"/> Oil <input checked="" type="checkbox"/> <input type="checkbox"/> Natural Gas <input type="checkbox"/> Propane Gas <input type="checkbox"/>
Other Structure: <u>GARAGE</u> Dimensions: _____ Footings: _____ Roof: _____	Sprinkler system: <u>N/A</u> <input checked="" type="checkbox"/> <input type="checkbox"/> NFPA #13D <input type="checkbox"/> NFPA #13R <input type="checkbox"/> Other:
_____ State Certified Modular Manufactured Home	

THE UNDERSIGNED HEREBY CERTIFIES AND AGREES AS FOLLOWS: (1) THAT HE/SHE IS AUTHORIZED TO MAKE THIS APPLICATION; (2) THAT THE INFORMATION IS CORRECT; (3) THAT HE/SHE WILL COMPLY WITH ALL REGULATIONS OF HOWARD COUNTY WHICH ARE APPLICABLE THERE TO; (4) THAT HE/SHE WILL PERFORM NO WORK ON THE ABOVE REFERENCED PROPERTY NOT SPECIFICALLY DESCRIBED IN THIS APPLICATION; (5) THAT HE/SHE GRANTS COUNTY OFFICIALS THE RIGHT TO ENTER ONTO HIS PROPERTY FOR THE PURPOSE OF INSPECTING THE WORK PERMITTED AND POSTING NOTICES.

Robert W. Strahle
 Applicant's Signature

ROBERT W. STRAHLE
 Print Name

 Title/Company

2/14/2001
 Date

Checks payable to: **DIRECTOR OF FINANCE OF HOWARD COUNTY**
 ** PLEASE WRITE NEATLY AND LEGIBLY. **
 - FOR OFFICE USE ONLY -

AGENCY	DATE	SIGNATURE APPROVAL
<input checked="" type="checkbox"/> Land Development, DPZ		
<input type="checkbox"/> State Highways		
<input type="checkbox"/> Building Official		
<input checked="" type="checkbox"/> Dev. Engineering, DPZ	<u>2/27/01</u>	<u>[Signature]</u>
<input type="checkbox"/> Health		
<input type="checkbox"/> Fire Protection		
Is Sediment Control approval required prior to issuance? YES <input type="checkbox"/> NO <input type="checkbox"/>		
CONTINGENCY CONSTRUCTION START: <input type="checkbox"/>		
ONE STOP SHOP: <input type="checkbox"/>		

DPZ SETBACK INFORMATION

Front: _____
 Rear: _____
 Side: _____
 Side St.: _____

All minimum setbacks met?
 YES NO

Is Entrance Permit required?
 YES NO

Historic District?
 YES NO

Lot Coverage for New Town Zone _____
 SDP/Red-line approval date _____

PROPERTY ID# 9769

Filing fee \$ 25
 Permit fee \$ _____
 Excise tax \$ _____
 Add'l per. fee \$ _____
 TOTAL FEES \$ _____
 Sub-total paid \$ _____
 Balance due \$ _____
 Checkbook # _____
 Validation # 36301

Accepted by [Signature]